

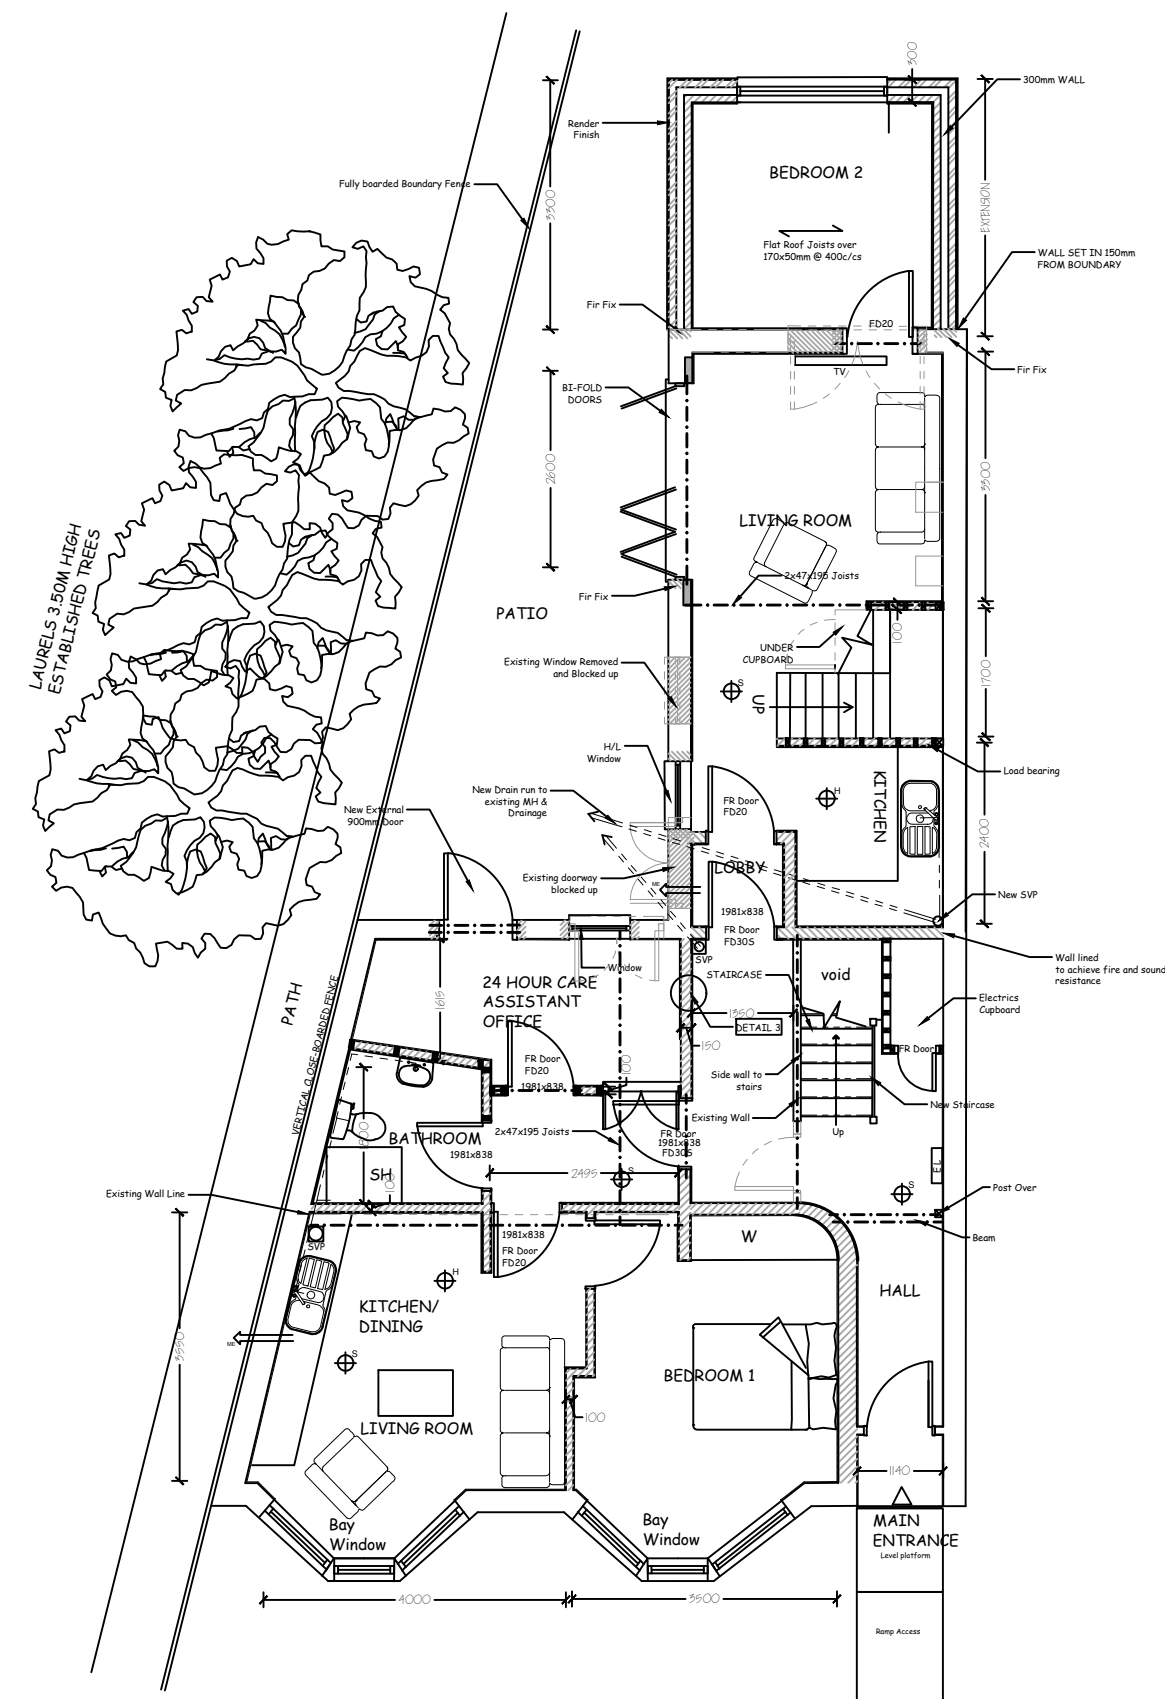



THE DRAWINGS ON THIS PROJECT MUST NOT BE SCALED, ONLY STATED DIMENSIONS TO BE USED. ALL DIMENSIONS INDICATED ARE STRUCTURAL DIMENSIONS, i.e. EXCLUSIVE OF PLASTER / RENDER, EXCEPT STUD PARTITION WALLS WHERE THEY INCLUDE PLASTERBOARDS / SOUNDBOARDS. CONTRACTOR TO CHECK ALL DIMENSIONS ON SITE & ANY VARIATION TO BE BROUGHT TO THE ATTENTION OF THE ARCHITECTURAL CONSULTANT FOR HIS COMMENTS BEFORE WORK IS PUT TO HAND. ARCHITECTURAL CONSULTANT OF THE PROJECT TO BE CONSULTED FOR ANY FURTHER DIMENSIONS REQUIRED. IN ACCORDANCE WITH GUIDELINES AND PROCEDURES OUTLINE IN THE PARTY WALL ETC ACT 1996, ADJOINING NEIGHBOUR/S TO BE CONSULTED REGARDING PROPOSED WORK BEFORE STARTING THE WORK ON SITE.

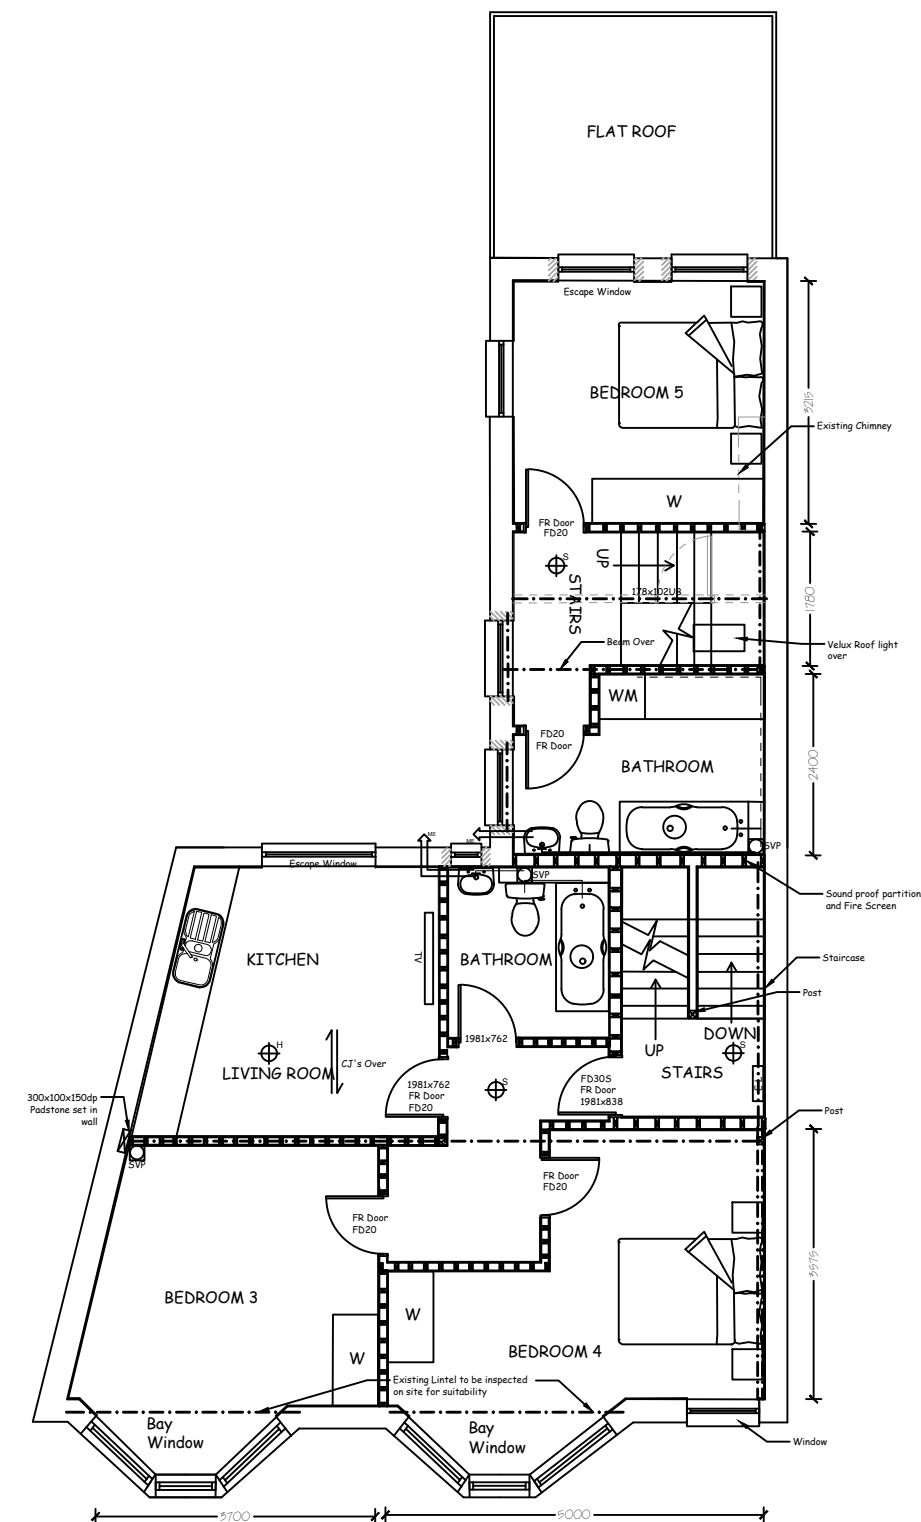

GROUND FLOOR PLAN

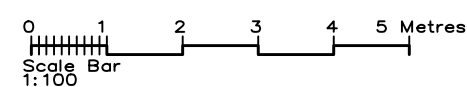

FIRST FLOOR PLAN

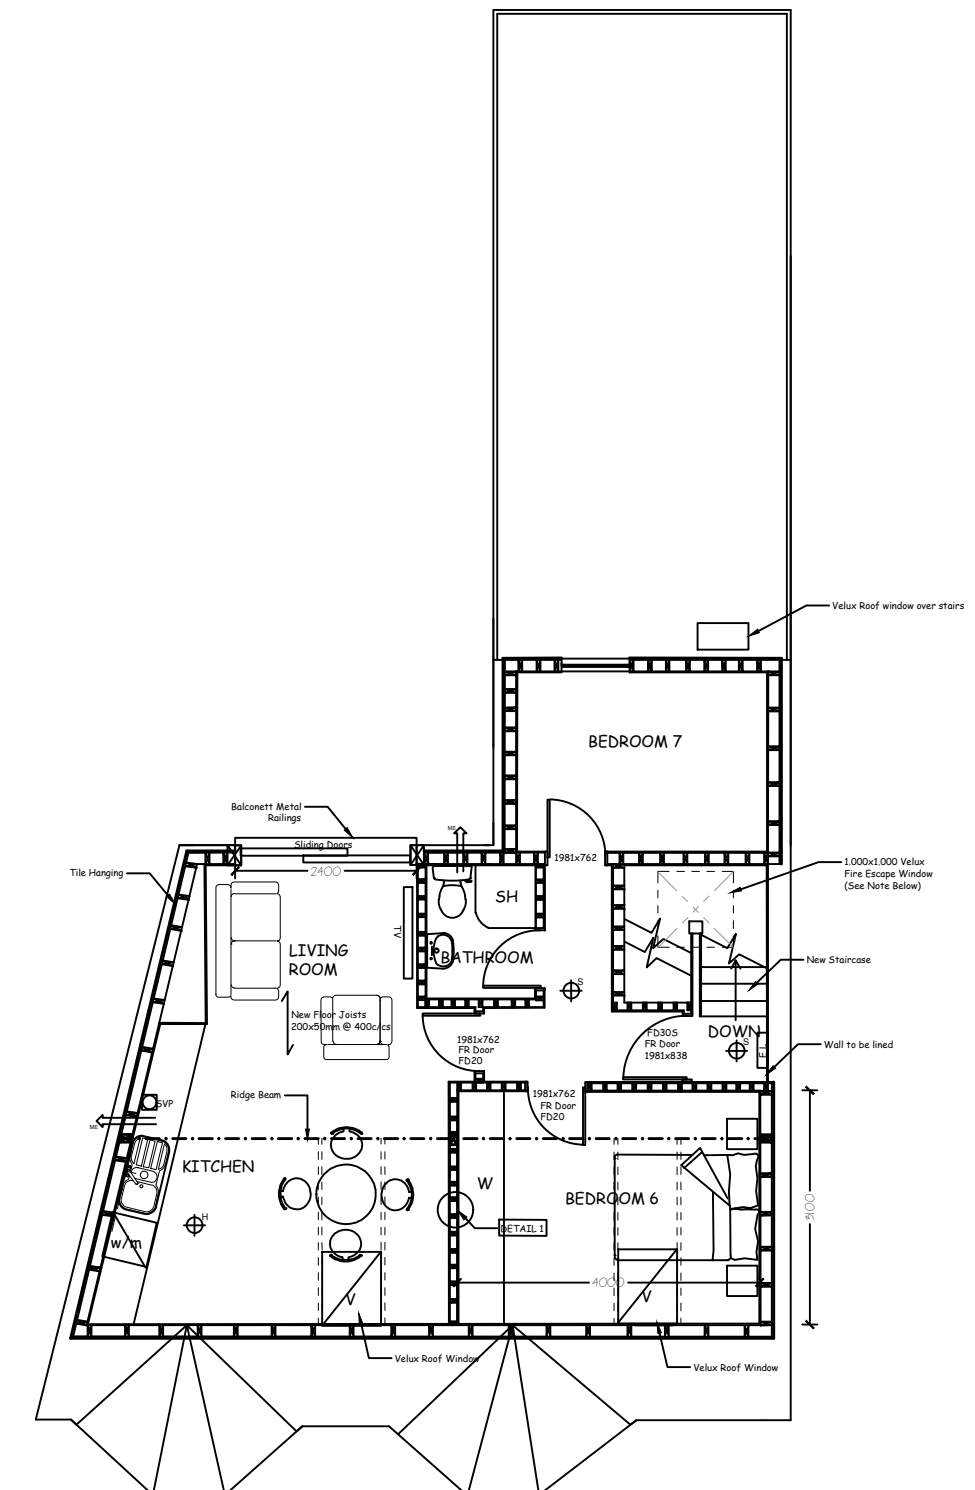

SECOND FLOOR PLAN

THIS DRAWING IS COPYRIGHT OF THE ARCHITECTURAL CONSULTANT ©

PROJECT:
PROPOSED CONVERSIONS
28 EASTERN ROAD
WOOD GREEN

TITLE:

FLOOR PLANS AS BUILT

D.J.W
ARCHITECTURAL DESIGNS LTD

Oakwood House,
22 Holloway Road,
Maldon, Essex
CM9 4SG

Tel: 01621 840 851

Email: djwalkerdesigns@hotmail.com

SCALE: 1:100 @A2

DRAWING: 2333/2

REV:

