



ROOF PLAN

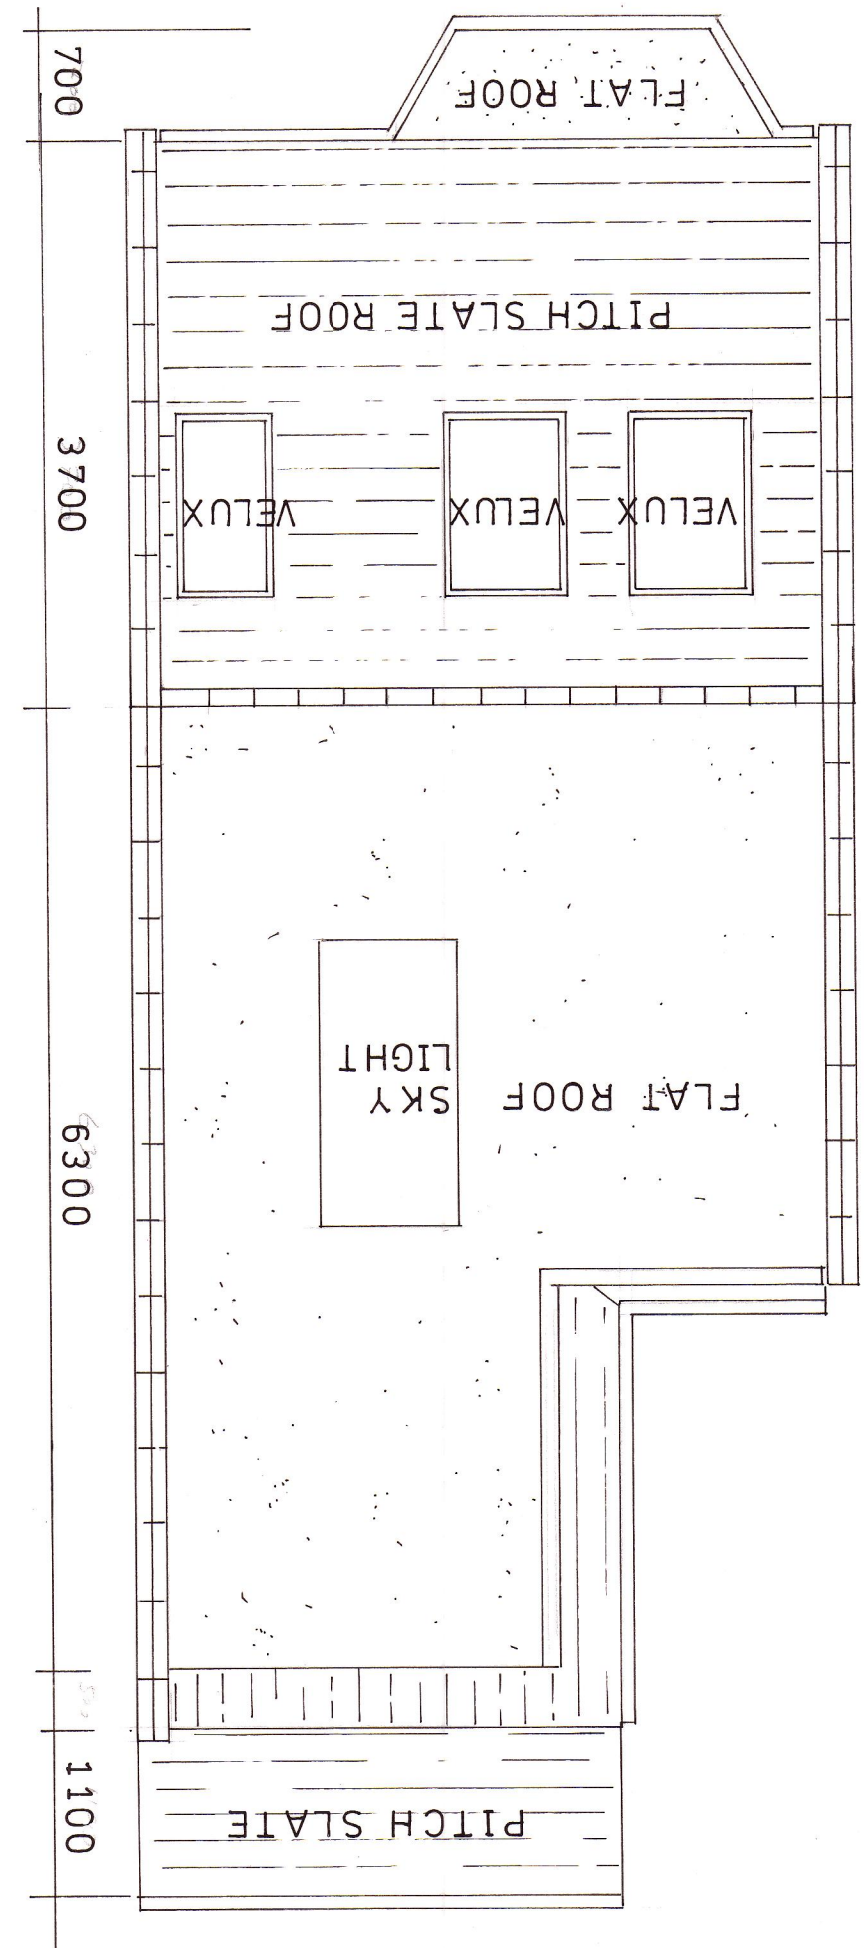


BLOCK PLAN SCALE 1:1250

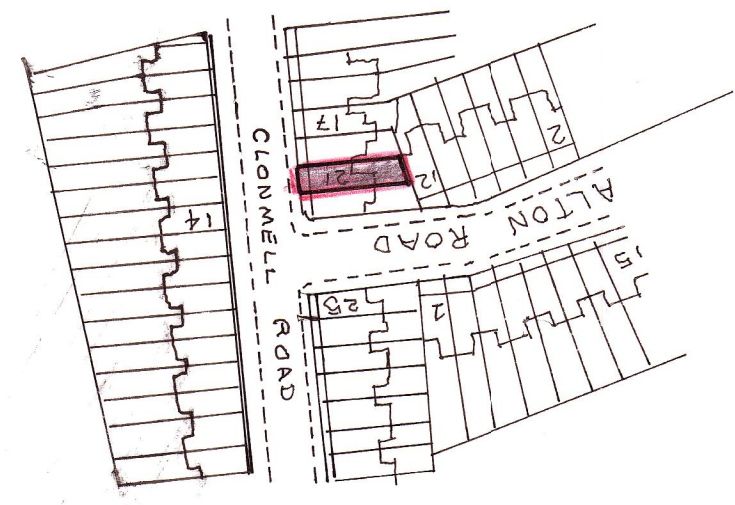


NORTH



LOFT FLOOR PLAN
(floor area 32 m²)

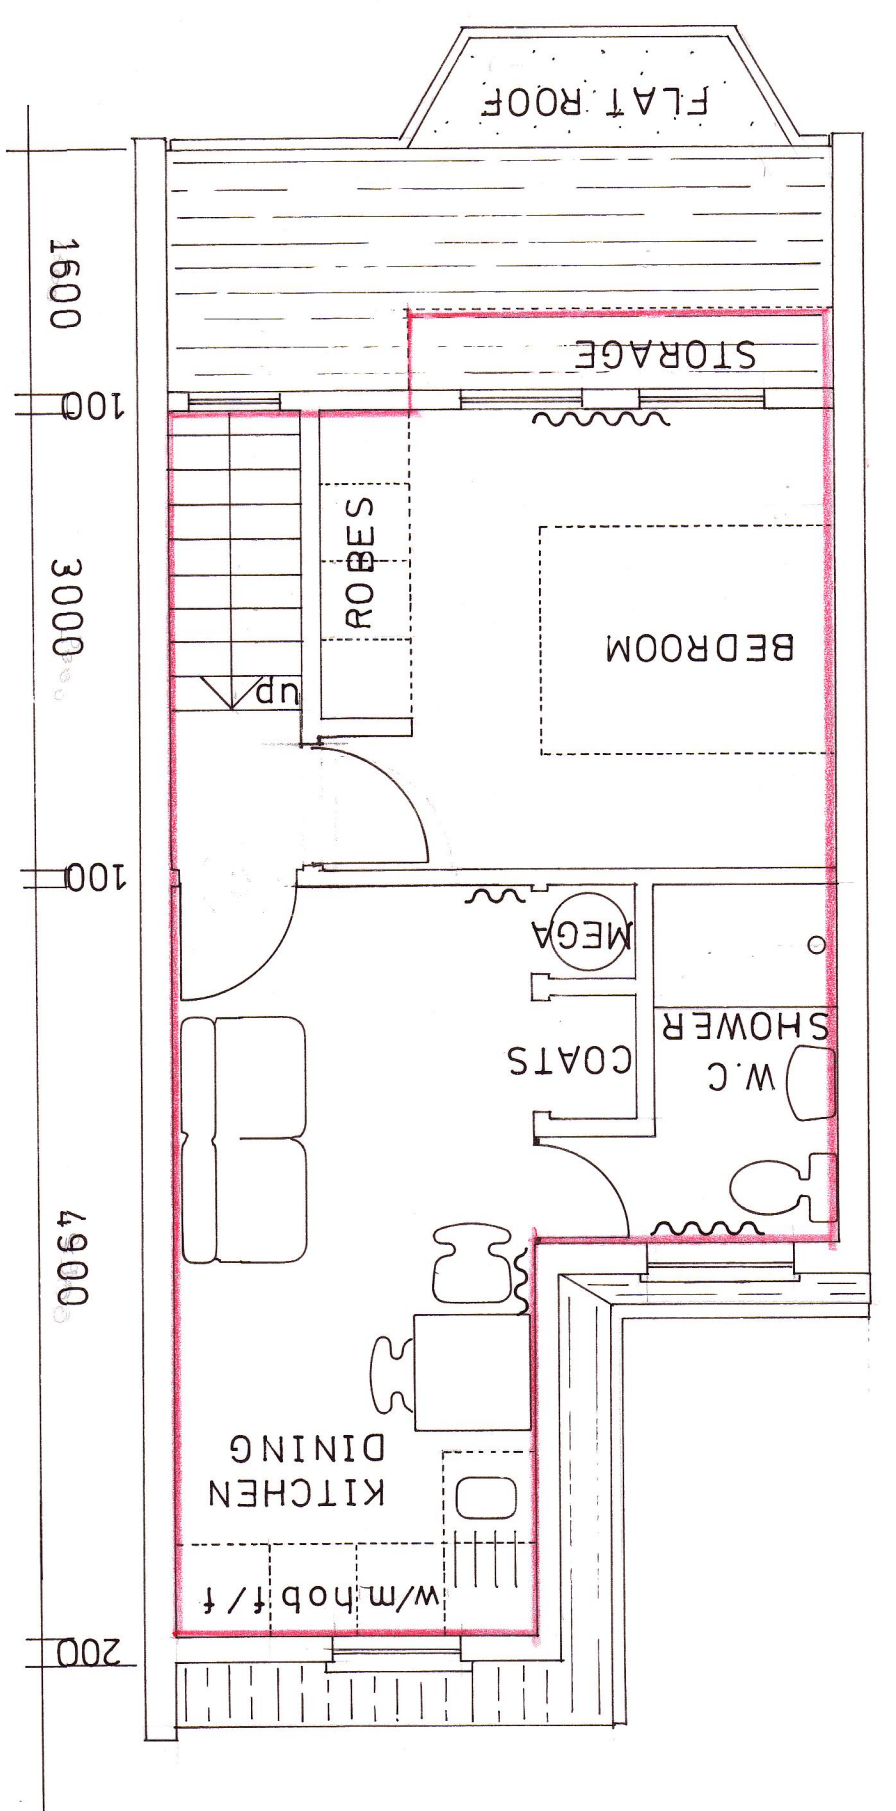

FIRST FLOOR PLAN
(floor area 32 m²)

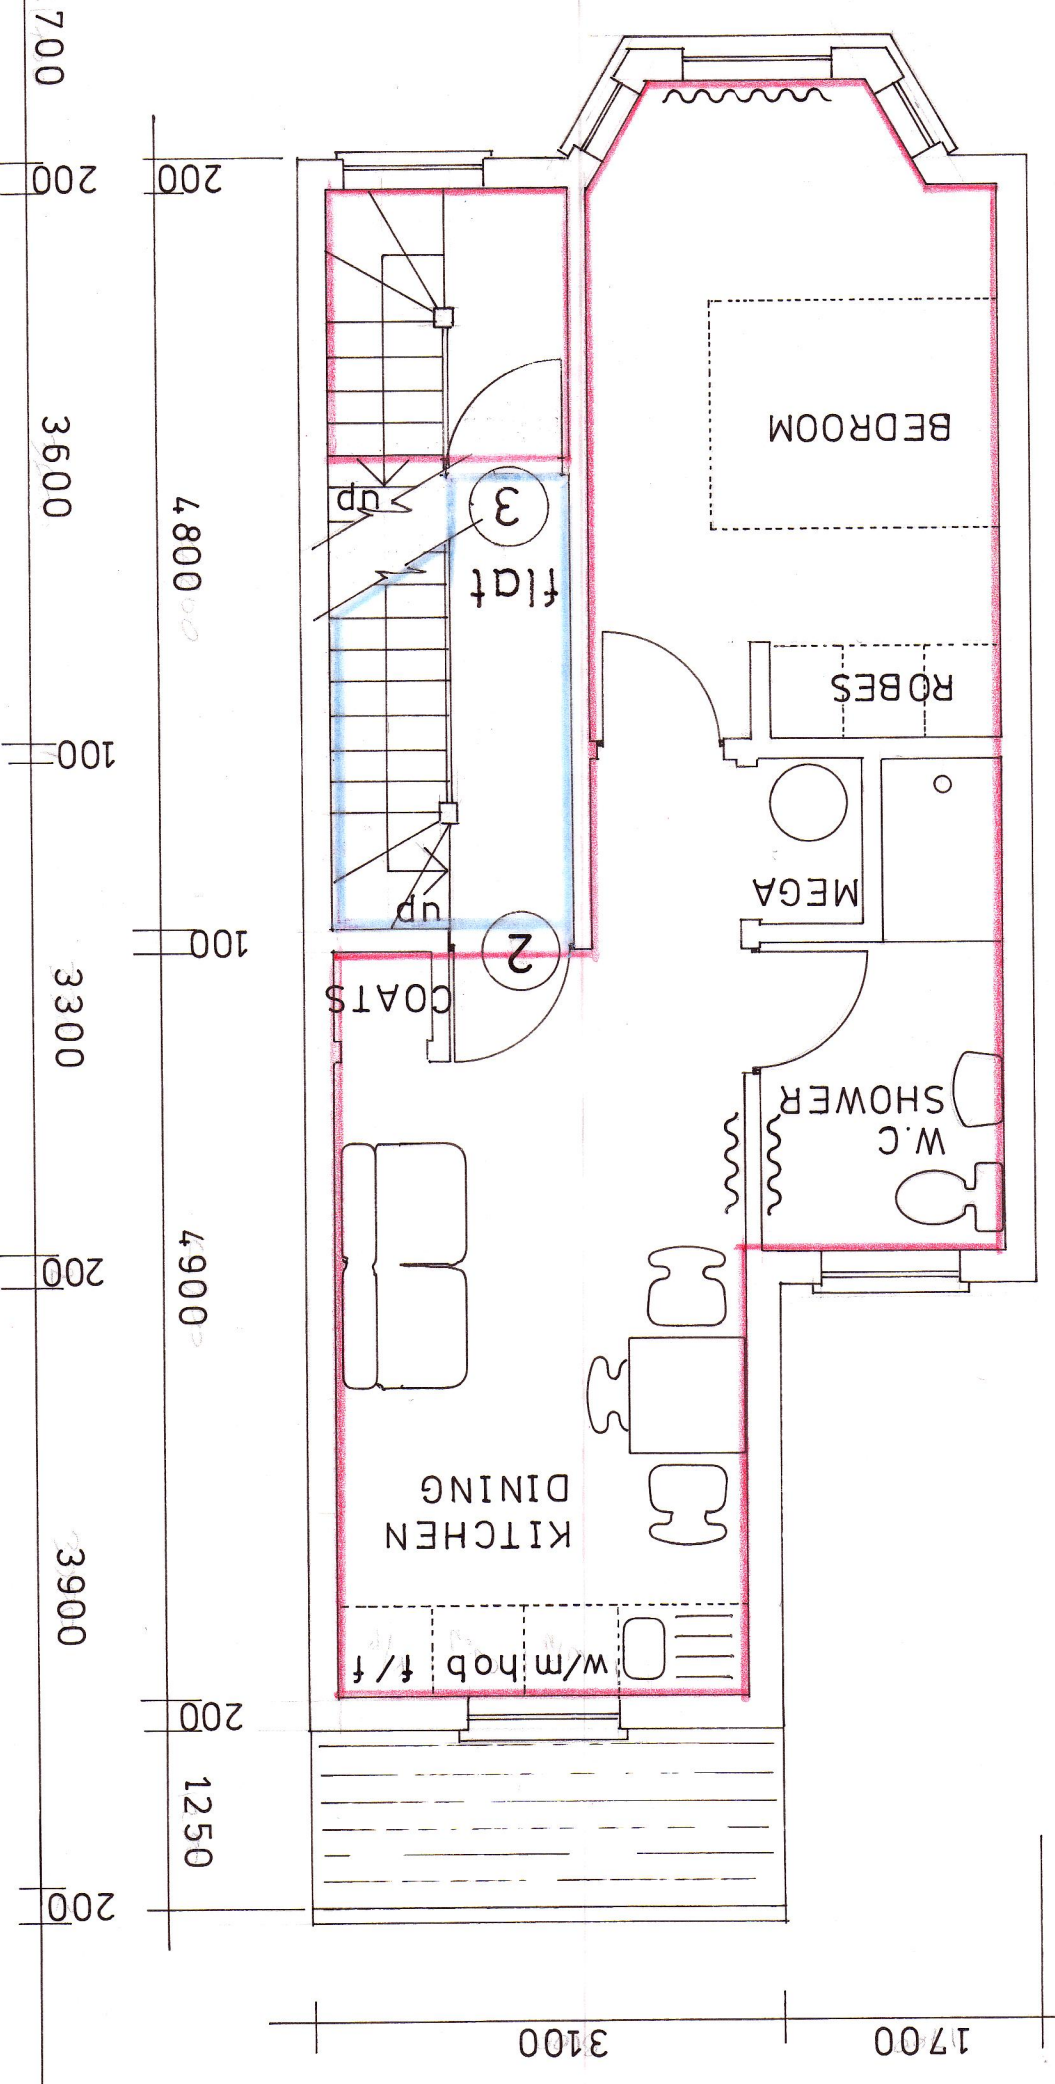

GROUND FLOOR PLAN
(floor area 38 m²)

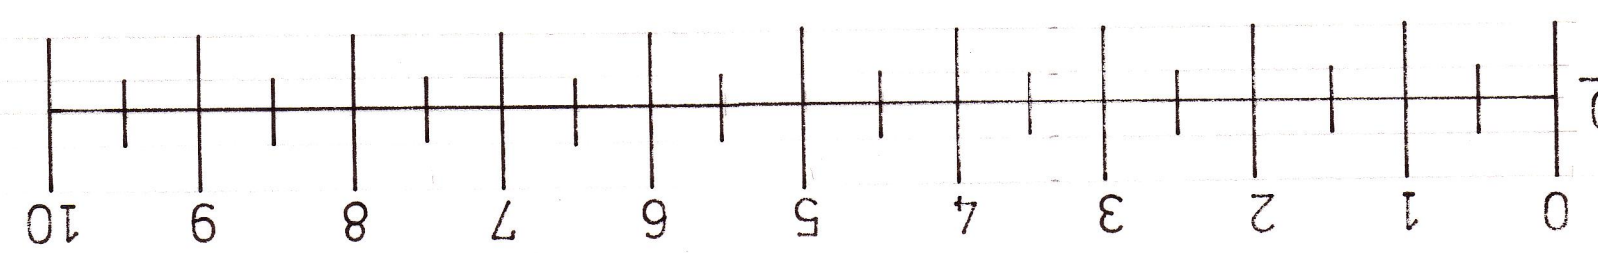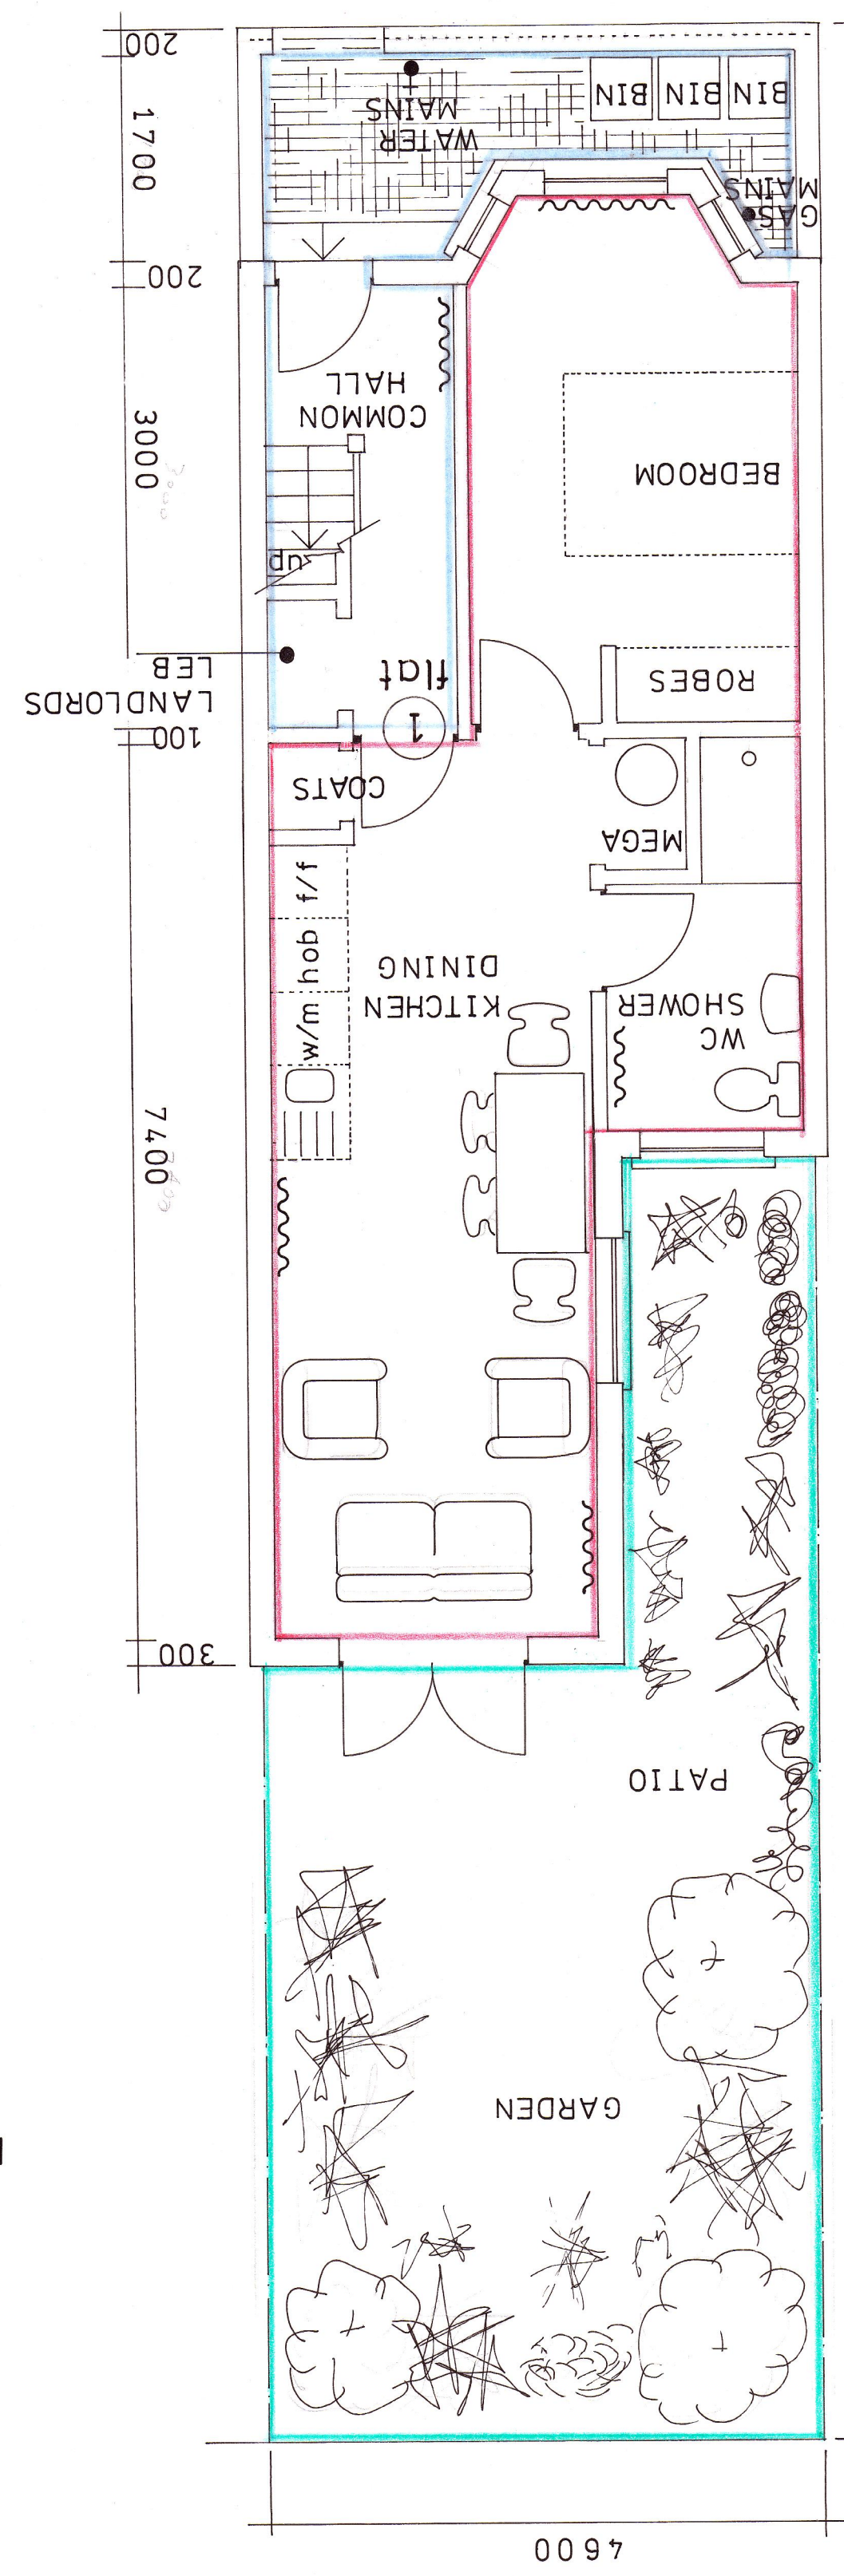

SCALE BAR 1/50

PLANS AS BUILT AND EXISTING
21 CLOMELL ROAD TOTTENHAM N17 6JY
CLIENT MR TASS ESTATHIOU
ARRANGED AS THREE UNITS 1/2/3
SCALE 1/50 DATE 12/03/2017
DRAWING No JP/03
AGENT MR TASS
TEL 07836 752 123
E-MAIL design.build@hotmail.co.uk

NOTES

NOTES

RED OUTLINE FLAT AREA
BLUE COMMON PARTS
GREEN GARDEN