

FOR CONTINUATION OF SERVICES SEE DRAWING NO. HPA/786/RD/550

THIS DRAWING IS THE PROPERTY OF HPA LIMITED TO AND IS LOANED TO YOU BY HPA LIMITED. IT IS NOT TO BE REPRODUCED OR USED IN ANY MANNER WITHOUT THE WRITTEN AUTHORIZATION OF HPA LIMITED.

DO NOT SCALE FROM THIS DRAWING. 1" = 1' UNLESS NOTED OTHERWISE.

THIS DRAWING CONVEYS DESIGN INTENT AND IS PROVIDED TO ASSIST THE CONTRACTOR IN THE INSTALLATION OF THE WORK. THE CONTRACTOR SHALL NOT INSTALL TO THIS DRAWING.

Notes

PETROL INTERCEPTORS KARQUESTER NGB 18.
FOUL PUMPING STATION AS NEW HIDDEN PUMPS
COMFAC-M-120 / 08 / 202.

Legend

- EXISTING HIGH VOLTAGE CABLE
- EXISTING LOW VOLTAGE CABLE
- EXISTING GAS MAIN
- EXISTING WATER MAIN
- EXISTING SURFACE WATER DRAIN
- EXISTING FOLL WATER DRAIN
- EXISTING BRUSH FELLLOW APPARATUS
- EXISTING PUMPED DRAIN (PUMP MAIN)
- EXISTING TRAFFIC LIGHT CABLE
- NEW HIGH VOLTAGE CABLE
- NEW GRANITE 125mm Ø UNPC PRODUCT
- NEW GAS MAIN
- NEW WATER MAIN
- NEW SURFACE WATER DRAIN
- NEW FOLL WATER DRAIN
- NEW BRUSH FELLLOW APPARATUS
- NEW PUMPED DRAIN (PUMP MAIN)
- NEW BRUSH FELLLOW APPARATUS
- ABANDONED HIGH VOLTAGE CABLE
- ABANDONED LOW VOLTAGE CABLE
- ABANDONED GAS MAIN
- ABANDONED WATER MAIN
- ABANDONED SURFACE WATER DRAIN
- ABANDONED FOLL WATER DRAIN
- ABANDONED BRUSH FELLLOW APPARATUS

NO.	REVISION	DATE	BY	APP.
1	ISSUED FOR TENDER	2005	RB	RB
2	FOR CONSTRUCTION	2005	RB	RB
3	FOR CONSTRUCTION	2005	RB	RB
4	FOR CONSTRUCTION	2005	RB	RB
5	FOR CONSTRUCTION	2005	RB	RB
6	FOR CONSTRUCTION	2005	RB	RB
7	FOR CONSTRUCTION	2005	RB	RB
8	FOR CONSTRUCTION	2005	RB	RB
9	FOR CONSTRUCTION	2005	RB	RB
10	FOR CONSTRUCTION	2005	RB	RB

Rev. Date Description App. (Rev.)

Client :

BRITEL FUND TRUSTEES

Project :

TOTTENHAM HALE RETAIL PARK

Drawing Title :

RECORD DRAWING
BELOW GROUND SERVICES
SHEET 4 OF 9

HPA


Halloran Payne Associates Ltd
BUILDING SERVICES CONSULTANTS
70-74 CITY ROAD, LONDON, EC1Y 2BU
TEL : +44 (0) 20 7486 7046 FAX : +44 (0) 20 7486 2507
E-Mail : enquiries@hpaassociates.co.uk

Scale 1/100 Sheet 00 Drawn ASB
Date JAN 2005 Checked RB


Drawing Number
HPA/786/RD/553

Revision

RECORD DRG

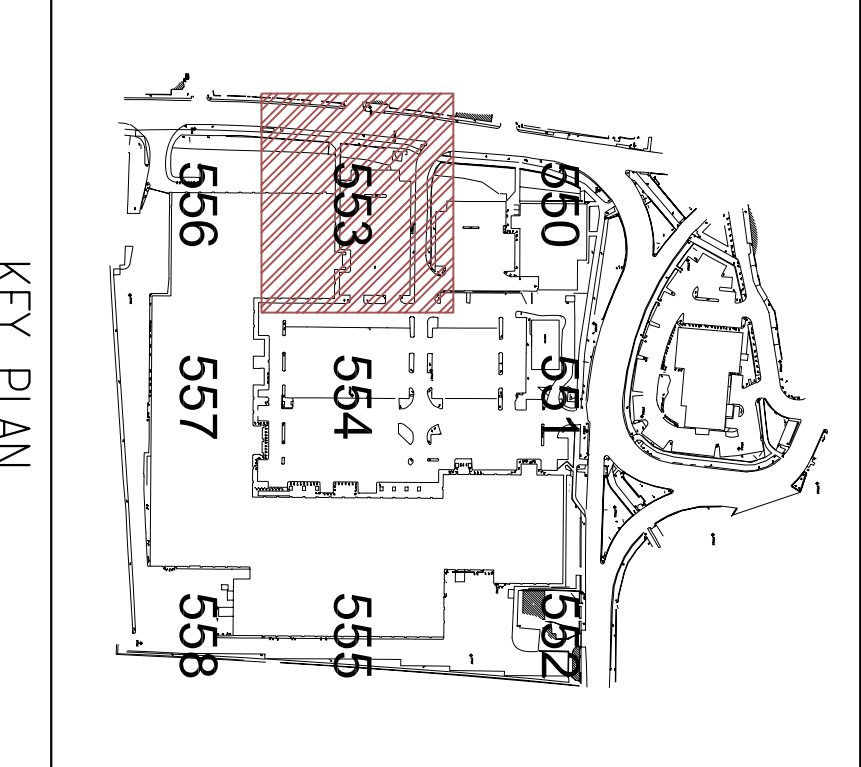

FOR CONTINUATION OF SERVICES SEE DRAWING NO. HPA/786/RD/556

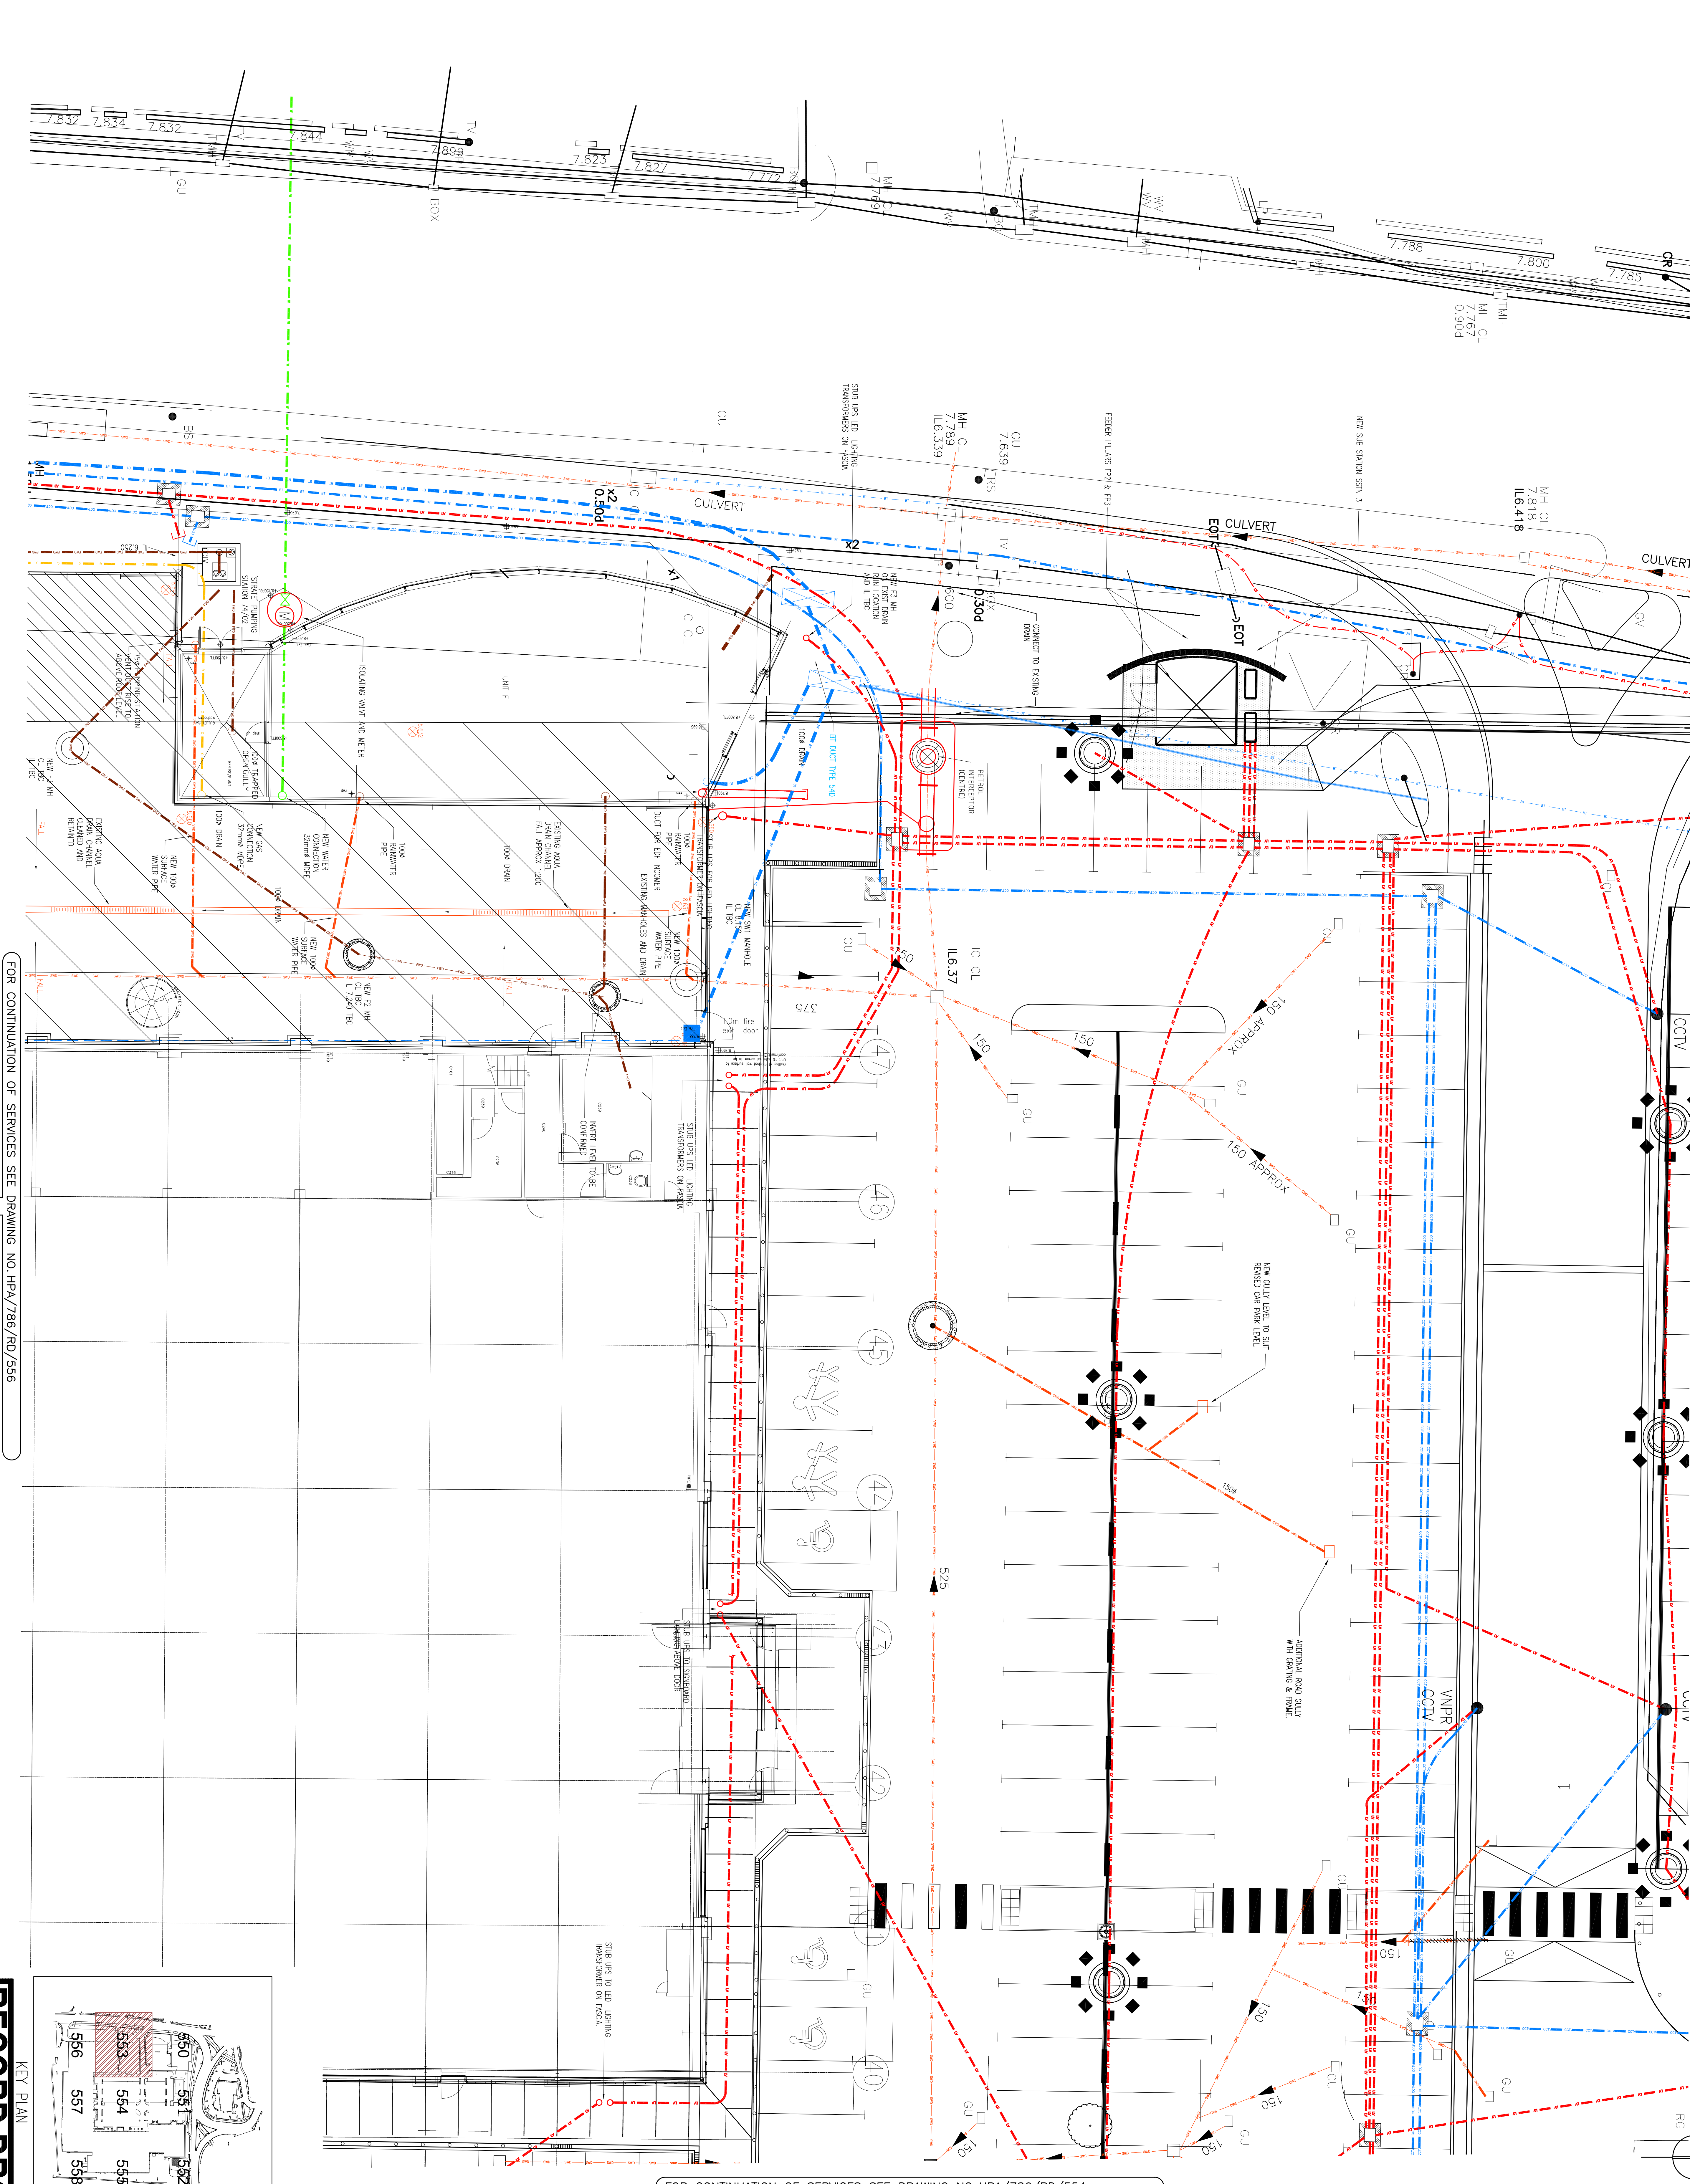

FOR CONTINUATION OF SERVICES SEE DRAWING NO. HPA/786/RD/554