
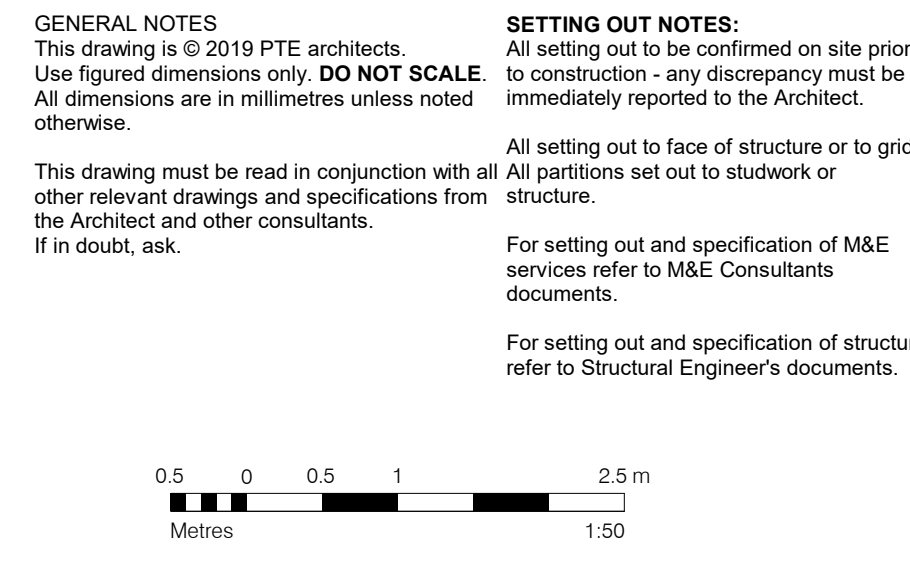


Lower MSA and omit intel

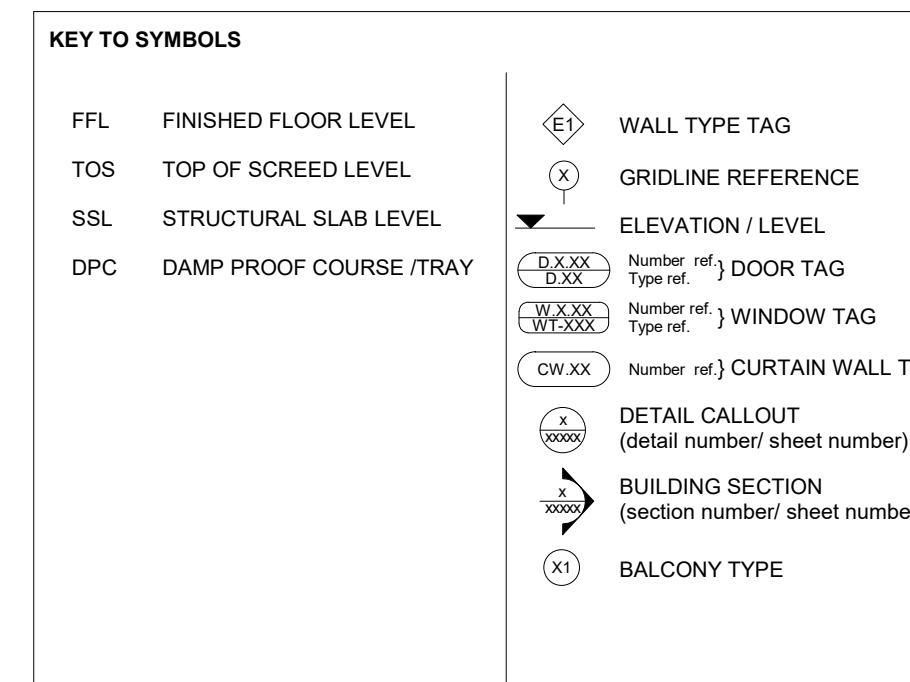

**MODEL EXCHANGES**

PTA model loaded as issued on 28/07/2022 (W257-PTA-DE-DZ-2XAS-01-0001)  
FRC model loaded as issued on 28/07/2022 (W257-PTA-DE-DZ-2XAS-01-0001)  
LDA model loaded as issued on 28/07/2022 (W257-LDA-DZ-2XAS-01-0001)  
RFA model loaded as issued on 28/07/2022 (W257-RFA-DZ-2XAS-01-0001) (R7T)

**REFER TO**

**FIRE ELEVATIONS FOR CAVITY BARRIERS AND FIRE STOPPING**

**DRAWINGS NO.**

W257-PT-DE-2X-XX-RFA-67-0101 TO 0104  
W257-PT-DE-2X-XX-RFA-67-0110 TO 0104  
W257-PT-DE-2X-XX-RFA-67-0110 TO 0104  
W257-PT-DE-2X-XX-RFA-67-0110 TO 0104

**COLOURED ELEVATIONS FOR EXTERNAL MATERIALS AND FINISHES**

**DRAWINGS NO.**

W257-PT-DE-2X-XX-RFA-6A-0012 TO 0015  
W257-PT-DE-2X-XX-RFA-6A-0009 TO 0012  
W257-PT-DE-2X-XX-RFA-6A-0012 TO 0015  
W257-PT-DE-2X-XX-RFA-6A-0010 TO 0013

**TO BE READ IN CONJUNCTION WITH:**

A161, A221, A271, A321, A671, A681, A701, A715) SERIES DRAWINGS

GENERAL ARRANGEMENT DRAWINGS 1:50

**NBS SPECIFICATION W257-PT-DE-DZ-XX-A-0-0011**

FOR RELEVANT OUTSTANDING ITEMS REFER TO

OUTSTANDING DESIGN INFORMATION TRACKER W257-PT-DD-XX-R-DE-A-0002

**DRAWINGS ISSUED "FOR CONSTRUCTION" STATUS IN LINE WITH PROGRAMME.**

ALL INFORMATION AND QUERIES ARE RESOLVED, DRAWINGS SUBJECT TO THE INFORMATION CONTAINING CORRECT, LATEST AND URGENT MATTER.

DPC LEVELS ADDED TO ASSIST. TO BE READ IN CONJUNCTION WITH PTE 16 SERIES GROUND DETAILS FOR DESIGN PRINCIPLES (MAX. HEIGHT PLACEMENT OF PUDLO DPC TRAY FROM FGL AND MIN. DPC HEIGHTS) AND LDA LANDSCAPE ARCHITECT DRAWINGS FOR LEVELS TO BUILDING PERIMETER TO DETERMINE FINAL LEVEL.


**St William**  
Designed for life

Title: St William Comments  
Date: 03/10/2022  
By: GR  
Comment: See drawing mark up  
Status: B

[illegible]

Diespeker Wharf  
 38 Graham Street  
 London N1 8JX  
 020 7336 7777  
 forename.surname@ptea.co.uk  
 @ptearchitects  
 www.pollardthomasedwards.co.uk

|                                     |                                 |          |           |          |
|-------------------------------------|---------------------------------|----------|-----------|----------|
| project                             | job number                      | drawn    | scale     | date     |
| Clarendon Road Phase 3a             | 19-028 VM                       |          | 1 : 50@A0 | Mar 2020 |
| drawing title                       | drawing number                  | revision |           |          |
| GA Elevation - D3 - North<br>- 1-50 | W257-PTE-D3-XX-DR-A-04-0005 C11 |          |           |          |

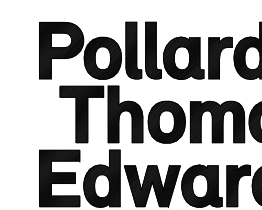



COLOUR CODED KEY - STONE EFFECT PPC COMPONENTS - D3

|     |                                               |
|-----|-----------------------------------------------|
| W9  | PRIMARY STRING COURSE                         |
| W10 | SECONDARY STRING COURSE                       |
| W11 | PRIMARY BALCONY COPING                        |
| W12 | SECONDARY BALCONY COPING                      |
| W13 | PRIMARY STRING COURSE TO PROJECTING BALCONY   |
| W14 | SECONDARY STRING COURSE TO PROJECTING BALCONY |
| M10 | COPING TO MASONRY WALLING                     |

GENERAL NOTES

This drawing is © 2019 PTE architects. Use of this drawing is subject to the terms and conditions of the contract. All dimensions are in millimetres unless noted otherwise.

For setting out and specification of MME services refer to MME Consultants documents.

For setting out and specification of structure refer to Structural Engineer's documents.

SETTING OUT NOTES


All setting out to be confirmed on site prior to construction - any discrepancy must be immediately reported to the Architect.

All setting out to face of structure or to grid.

For setting out and specification of MME services refer to MME Consultants documents.

For setting out and specification of structure refer to Structural Engineer's documents.

0 0.5 1 2.5 m  
Metres

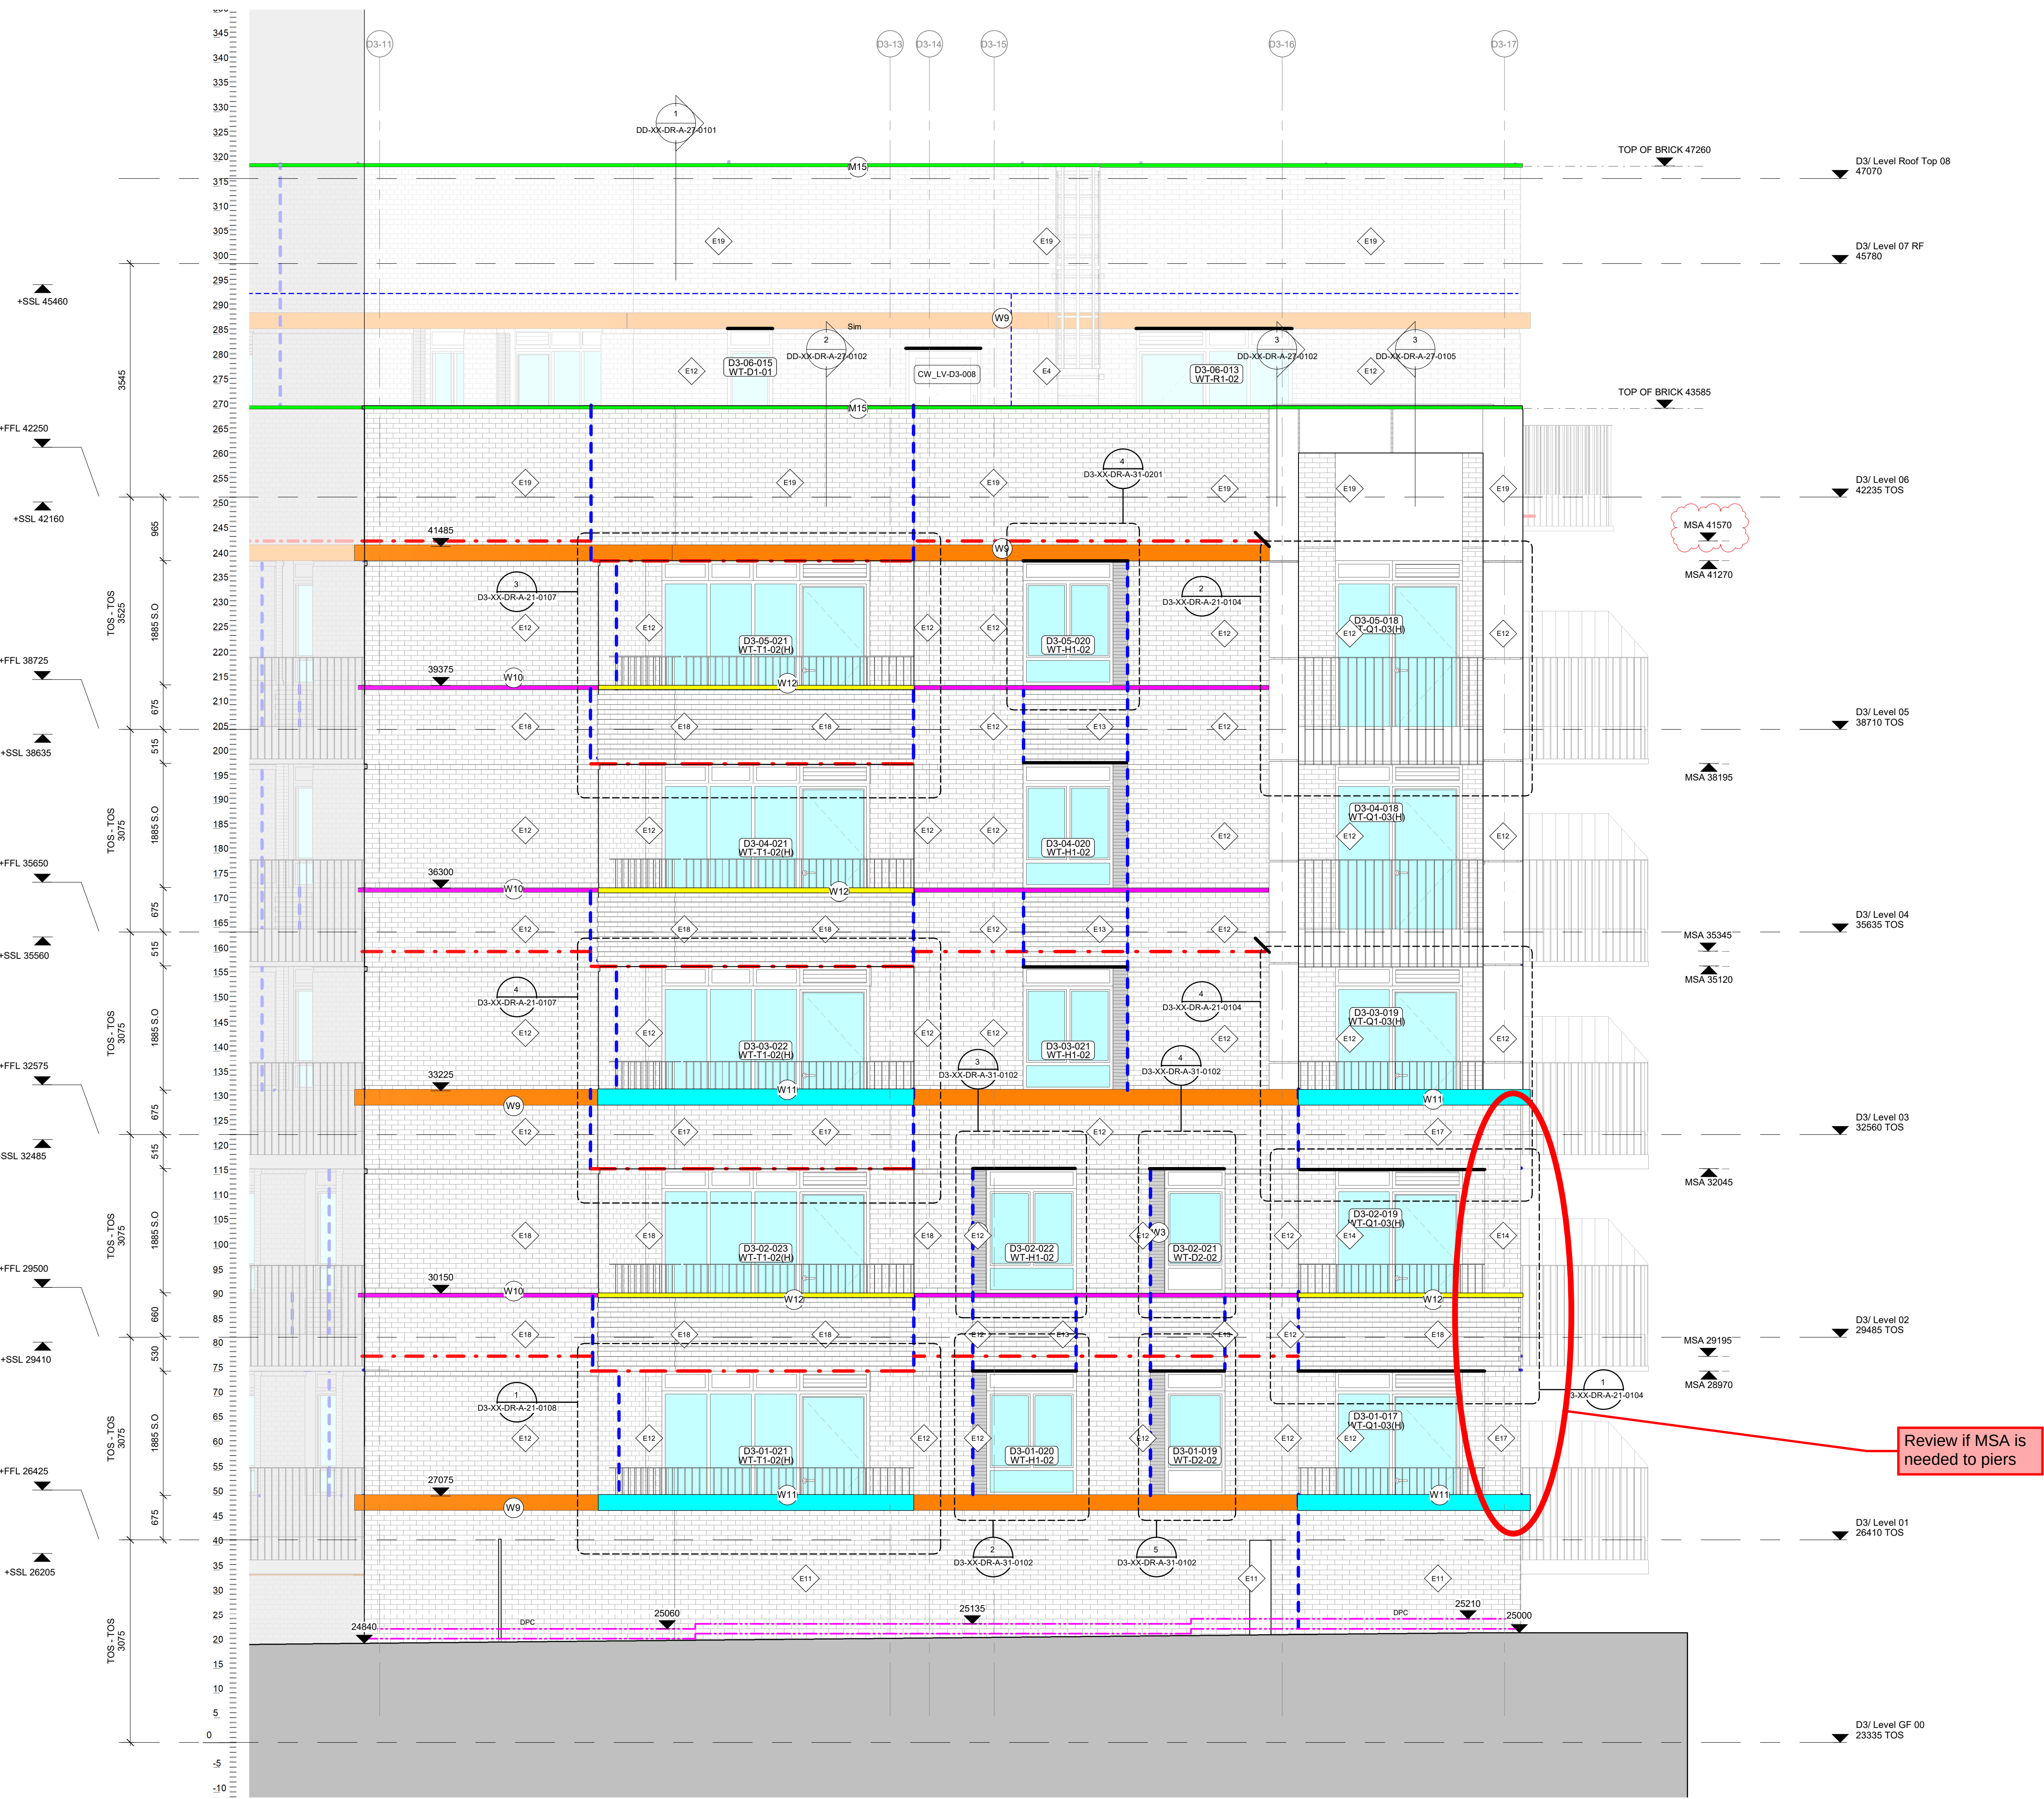

KEY TO SYMBOLS

|     |                          |                    |
|-----|--------------------------|--------------------|
| FFL | FINISHED FLOOR LEVEL     | WALL TYPE TAG      |
| TOS | TOP OF SCREED LEVEL      | GRIDLINE REFERENCE |
| SSL | STRUCTURAL SLAB LEVEL    | ELEVATION / LEVEL  |
| DPC | DAMP PROOF COURSE / TRAY | DOOR TAG           |
|     |                          | WINDOW TAG         |
|     |                          | CURTAIN WALL TAG   |
|     |                          | DETAIL CALLOUT     |
|     |                          | BUILDING SECTION   |
|     |                          | BALCONY TYPE       |

MU vertical movement joint (10mm thick)  
MSA masonry support angle with horizontal movement joint (15mm thick steel)  
MSA return to slab - brickwork columns and metal cladding slots highlighted for clarity  
Lintel above openings  
Change of wall type

MODEL EXCHANGES

PTA model loaded as issued on 28/07/2022 (W257-PTE-D3-XX-DR-A-04-0007)  
FRC model loaded as issued on 15/08/2022 (W257-FRC-D3-XX-DR-A-04-0007)  
LDA model loaded as issued on 07/03/2022 (W257-LDA-D3-XX-DR-A-04-0007)  
ACM model loaded as issued on 23/06/2022 (W257-ACM-D3-XX-DR-A-04-0007)

REFER TO:

FIRE ELEVATIONS FOR CAVITY BARRIERS AND FIRE STOPPING

DRAWINGS NO:  
W257-PTE-D3-XX-DR-A-04-0007 TO 0104  
W257-PTE-D3-XX-DR-A-04-0008 TO 0104  
W257-PTE-D3-XX-DR-A-04-0009 TO 0104  
W257-PTE-D3-XX-DR-A-04-0010 TO 0104

COLOURED ELEVATIONS FOR EXTERNAL MATERIALS AND FINISHES

DRAWINGS NO:  
W257-PTE-D3-XX-DR-A-04-0011 TO 0015  
W257-PTE-D3-XX-DR-A-04-0016 TO 0012  
W257-PTE-D3-XX-DR-A-04-0013 TO 0012  
W257-PTE-D3-XX-DR-A-04-0014 TO 0013

TO BE READ IN CONJUNCTION WITH:

A(16), A(21), A(27), A(31), A(37), A(40), A(47), A(51), A(57) SERIES DRAWINGS  
GENERAL ARRANGEMENT DRAWINGS 1:50  
NBS SPECIFICATION W257-PTE-D3-XX-DR-A-04-0007

FOR RELEVANT OUTSTANDING ITEMS REFER TO:

OUTSTANDING DESIGN INFORMATION TRACKER W257-PTE-D3-XX-DR-A-04-0007

DRAWINGS ISSUED "FOR CONSTRUCTION" STATUS IN LINE WITH PROGRAMME. DO NOT BUILD/MANUFACTURE/FABRICATE UNTIL ALL RELEVANT OUTSTANDING INFORMATION AND QUERIES ARE RESOLVED. DRAWINGS SUBJECT TO THE APPROVAL OF BUILDING CONTROL LAB & NBS WARRANTY PROVIDER.

DPC LEVELS ADDED TO ASSIST. TO BE READ IN CONJUNCTION WITH PTE 16 SERIES GROUND DETAILS FOR DESIGN PRINCIPLES (MAX HEIGHT PLACEMENT OF PUBLIC DPC TRAY FROM FGL AND MIN DPC HEIGHTS) AND LDA LANDSCAPE ARCHITECT DRAWINGS FOR LEVELS TO BUILDING PERIMETER TO DETERMINE FINAL LEVEL.

St William  
Designed for life

Title: St William Comments  
Date: 03/10/2022  
By: GRM  
Comment: See drawing mark up  
Status: B

| REV | DATE       | DESCRIPTION                                                                                                                                                                                                                       | DESIGN | CHECKED |
|-----|------------|-----------------------------------------------------------------------------------------------------------------------------------------------------------------------------------------------------------------------------------|--------|---------|
| C10 | 07.08.2022 | Issued as part of facade pack. MSA levels included following updated operational drawings. Standing by system. Additional columns added. Approx. DPC levels added as per SBO report 07.08.22. Key updates. Revisions as detailed. | KN     | KN      |
| C9  | 31.08.2022 | Issued as part of facade pack. Updates following PTA review 28.08.22 - additional movement joints added.                                                                                                                          | KN     | KN      |
| C8  | 12.04.2022 | Issued as part of facade pack. Revisions to operational drawings as per C2-C10. MSA levels revised following consultation with specialist drawings. Labels added. Key updates. Revisions as detailed.                             | KN     | KN      |
| C7  | 11.02.2022 | Issued as part of facade pack updates. STW comments incorporated, additional wall type tags added for clarity.                                                                                                                    | TZ     | KN      |
| C6  | 04.10.2021 | Issued as part of facade pack. Review of the Materials External Finishes.                                                                                                                                                         | LD     | KN      |
| C5  | 24.05.2021 | Issued as part of facade pack. Review of the Materials External Finishes. H&LJ.                                                                                                                                                   | LD     | KN      |
| C4  | 08.02.2021 | Ground levels added as per consultation with landscape Architect drawings. DPC - Gas maintenance DPC added to G.L. as detailed.                                                                                                   | KN     | KN      |
| C3  | 09.11.2020 | Issued as part of the 100% Window package. Revisions as detailed.                                                                                                                                                                 | KN     | KN      |
| C2  | 23.09.2020 | Issued as part of the 100% Window package. New tags added as detailed. DPC areas added where relevant.                                                                                                                            | KN     | KN      |
| C1  | 17.08.2020 | Issued as part of the 100% Window package. New tags added as detailed.                                                                                                                                                            | KN     | KN      |
| P1  | 10.07.2020 | First issue                                                                                                                                                                                                                       | VM     | KN      |

CONSTRUCTION

Dispeker Wharf  
38 Graham Street  
London N1 8JX  
020 7336 7777  
forname.surname@ptea.co.uk  
@ptearchitects  
www.pollardthomasedwards.co.uk

Pollard Thomas Edwards


PROJECT: Clarendon Road Phase 3a  
DRAWING NUMBER: 19-028 VM  
SCALE: 1:50@A0  
DATE ISSUED: May '20

DRAWING TITLE: GA Elevation - D3 - South  
DRAWING NUMBER: W257-PTE-D3-XX-DR-A-04-0007 C10  
SCALE: 1:50

COLOUR CODED KEY - STONE EFFECT PPC COMPONENTS - D3

|     |                                               |
|-----|-----------------------------------------------|
| W0  | PRIMARY STRING COURSE                         |
| W10 | SECONDARY STRING COURSE                       |
| W11 | PRIMARY BALCONY COPING                        |
| W12 | SECONDARY BALCONY COPING                      |
| W13 | PRIMARY STRING COURSE TO PROJECTING BALCONY   |
| W14 | SECONDARY STRING COURSE TO PROJECTING BALCONY |
| M10 | COPING TO MASONRY WALLING                     |

GENERAL NOTES:  
This drawing is © 2019 PTE architects. All setting out to be confirmed on site prior to construction - any discrepancy must be immediately reported to the Architect.  
Use figured dimensions only. **DO NOT SCALE**.  
All dimensions are in millimetres unless noted otherwise.  
This drawing must be read in conjunction with all other relevant drawings and specifications from the Architect and other consultants.  
For setting out and specification of MME services refer to MME Consultants documents.  
For setting out and specification of structure refer to Structural Engineer's documents.

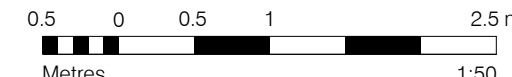

KEY TO SYMBOLS

|     |                          |                    |
|-----|--------------------------|--------------------|
| FFL | FINISHED FLOOR LEVEL     | WALL TYPE TAG      |
| TOS | TOP OF SCREED LEVEL      | GRIDLINE REFERENCE |
| SSL | STRUCTURAL SLAB LEVEL    | ELEVATION / LEVEL  |
| DPC | DAMP PROOF COURSE / TRAY | DOOR TAG           |
|     |                          | WINDOW TAG         |
|     |                          | CURTAIN WALL TAG   |
|     |                          | DETAIL CALLOUT     |
|     |                          | BUILDING SECTION   |
|     |                          | BALCONY TYPE       |

MODEL EXCHANGES

PTA model loaded as issued on 28/07/2022 (W257-PTA-DE-ZZ-M3-S-01-0001)  
FRC model loaded as issued on 15/08/2022 (W257-FRC-D3-ZZ-M3-AE-01-0001)  
LDA model loaded as issued on 07/03/2022 (W257-LDA-D3-ZZ-M3-LS-01-0001)  
ACM model loaded as issued on 23/06/2022 (W257-ACM-D3-ZZ-M3-M-01-0001-RV7)

REFER TO:

FIRE ELEVATIONS FOR CAVITY BARRIERS AND FIRE STOPPING

DRAWINGS NO:  
W257-PTA-D3-ZZ-M3-AE-01-0101 TO 0104  
W257-PTA-D3-ZZ-M3-AE-01-0105 TO 0108  
W257-PTA-D3-ZZ-M3-AE-01-0109 TO 0112  
W257-PTA-D3-ZZ-M3-AE-01-0113 TO 0116  
W257-PTA-D3-ZZ-M3-AE-01-0117 TO 0120

COLOURED ELEVATIONS FOR EXTERNAL MATERIALS AND FINISHES

DRAWINGS NO:  
W257-PTA-D3-ZZ-M3-AE-04-0012 TO 0015  
W257-PTA-D3-ZZ-M3-AE-04-0016 TO 0019  
W257-PTA-D3-ZZ-M3-AE-04-0020 TO 0023  
W257-PTA-D3-ZZ-M3-AE-04-0024 TO 0027  
W257-PTA-D3-ZZ-M3-AE-04-0028 TO 0031

TO BE READ IN CONJUNCTION WITH:

A/16, A/21, A/27, A/31, A/37, A/41, A/47, A/51, A/57, A/61, A/67, A/71, A/75, A/6471, A/6475