

AL(00)003

new window to match existing

SCALE 1:50



New proposal under this application shown in blue
New demolitions under this application shown in red

PLANNING ISSUE





McGUINNESS ARCHITECTS
unit d 163-167 barmondsey st
london e61 3uw
t:020 407 8543
info@mcguinnessarch.co.uk

15 Broadlands Rd, N6 4AE

TITLE: SECOND FLOOR PLAN - PROPOSED
SCALE: 1:50 @ A2
DATE: September 2022

AL(00)004

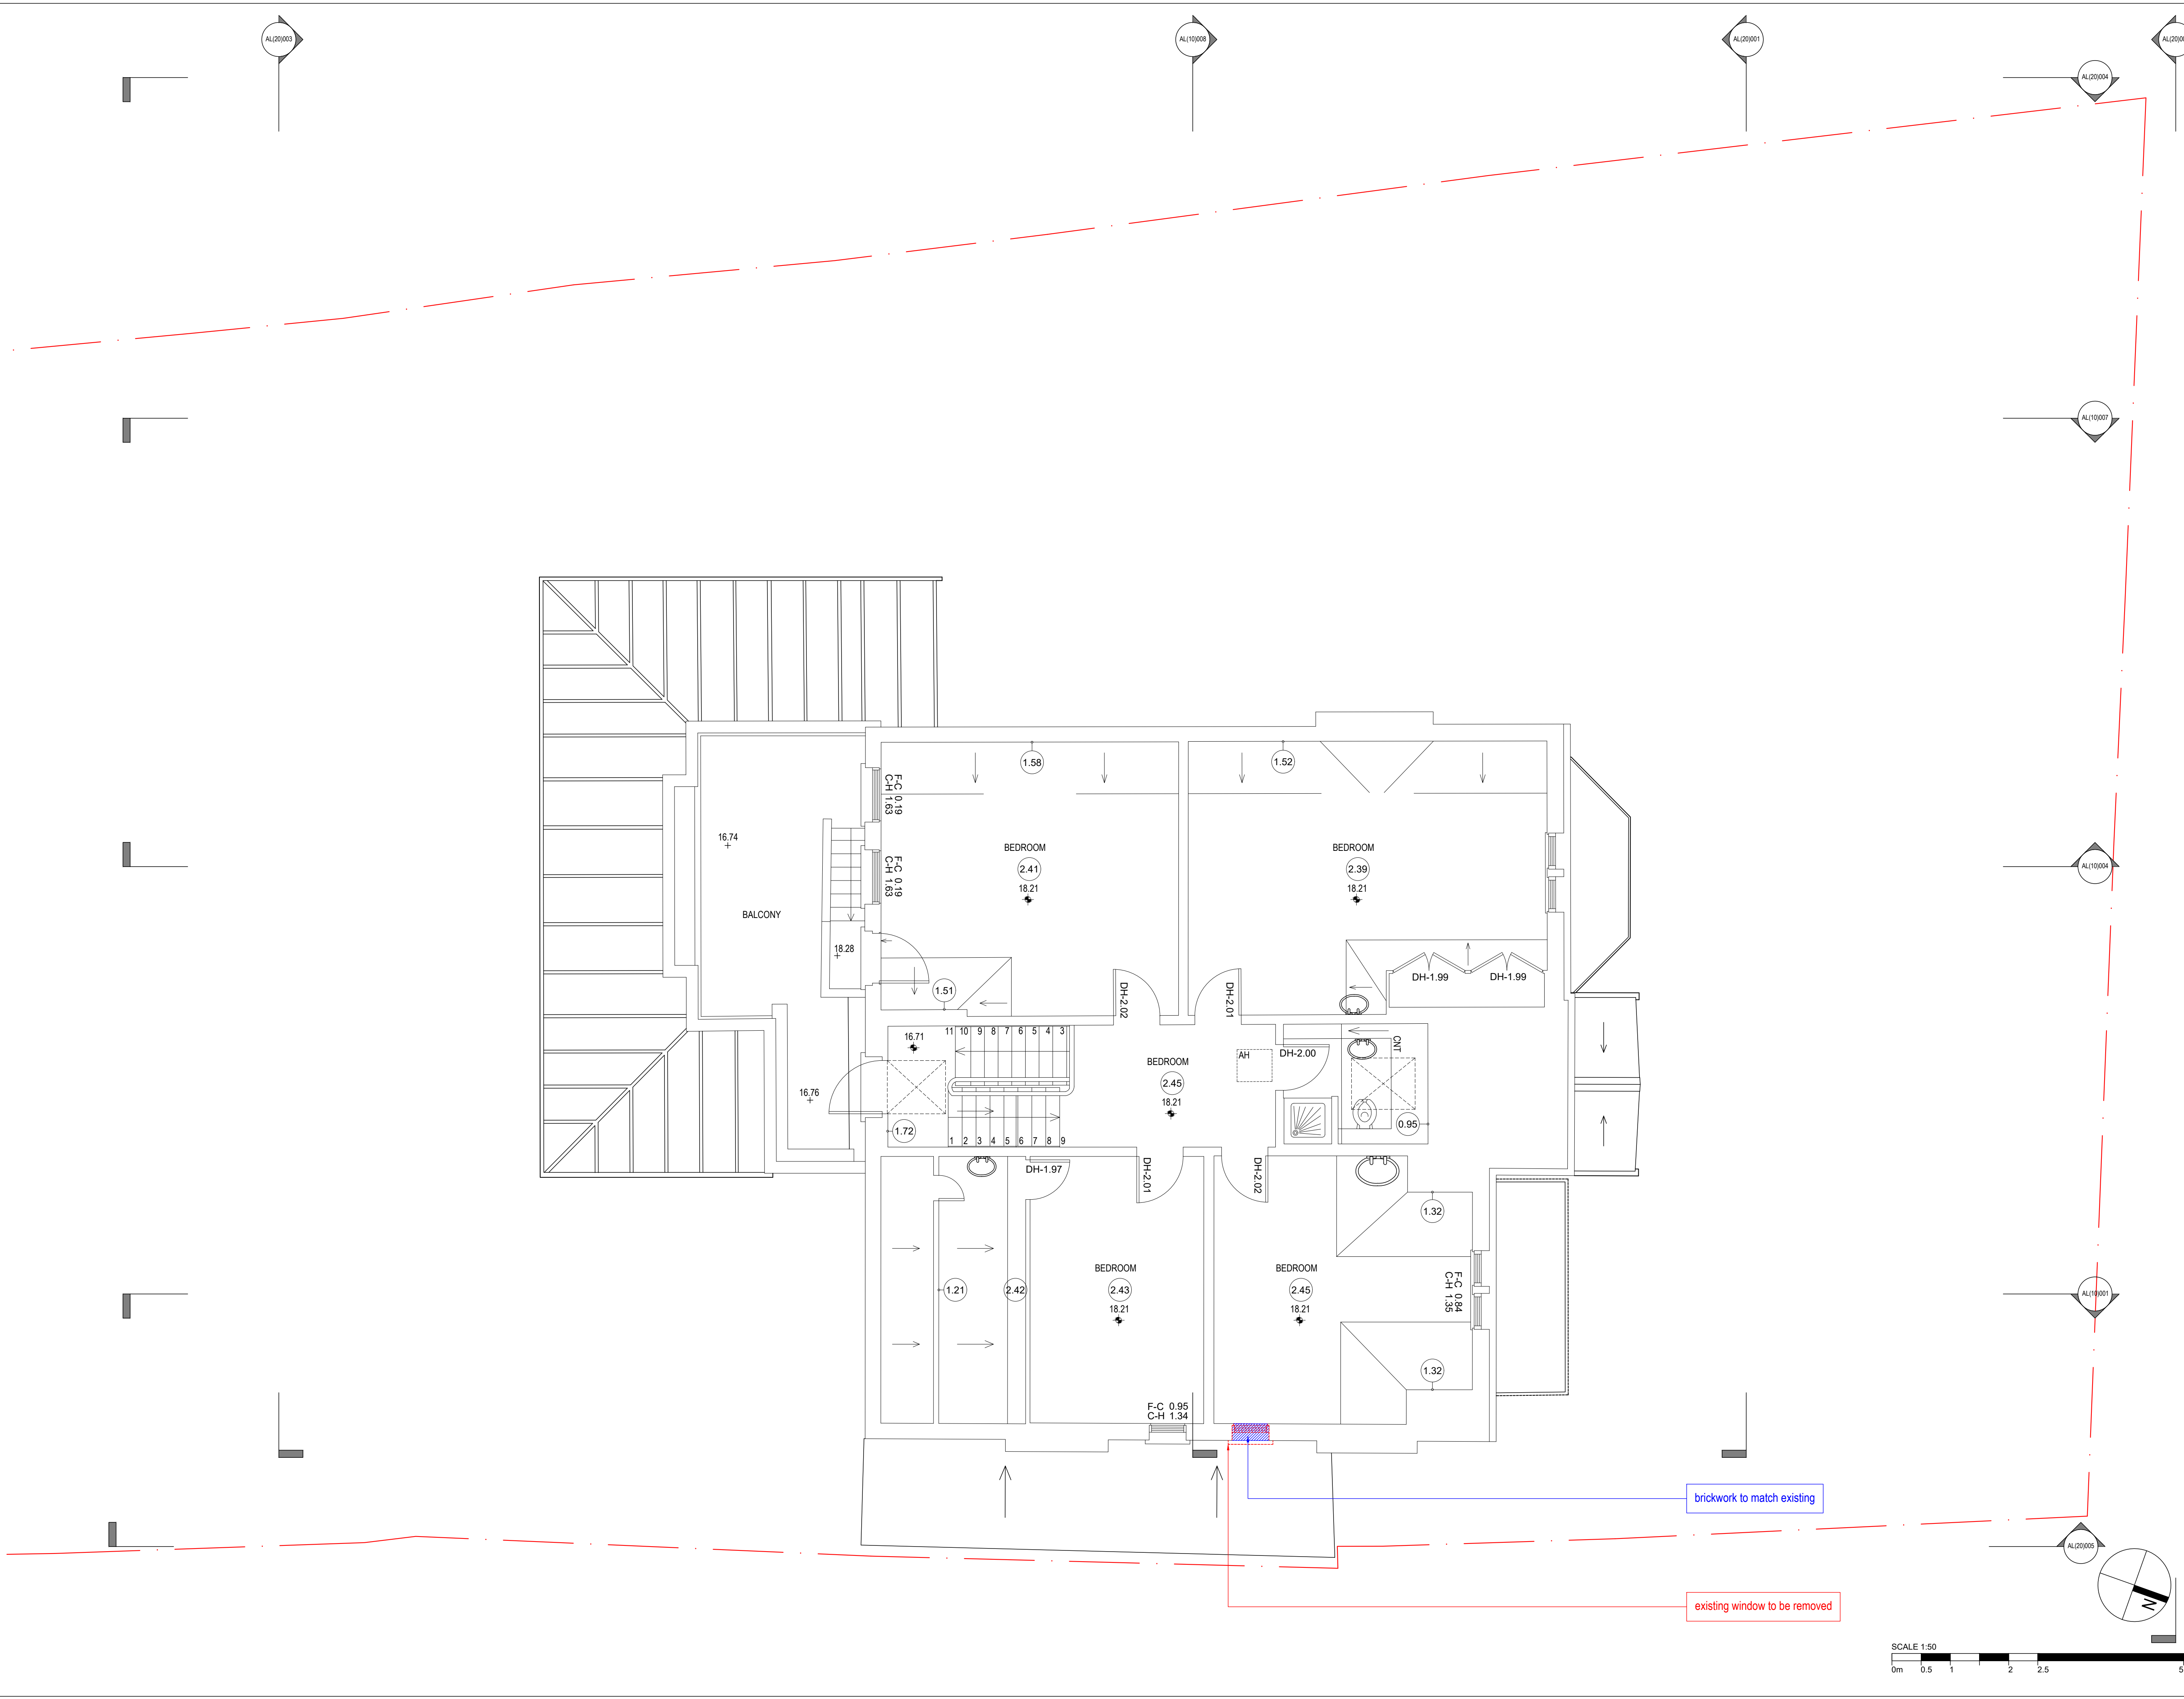

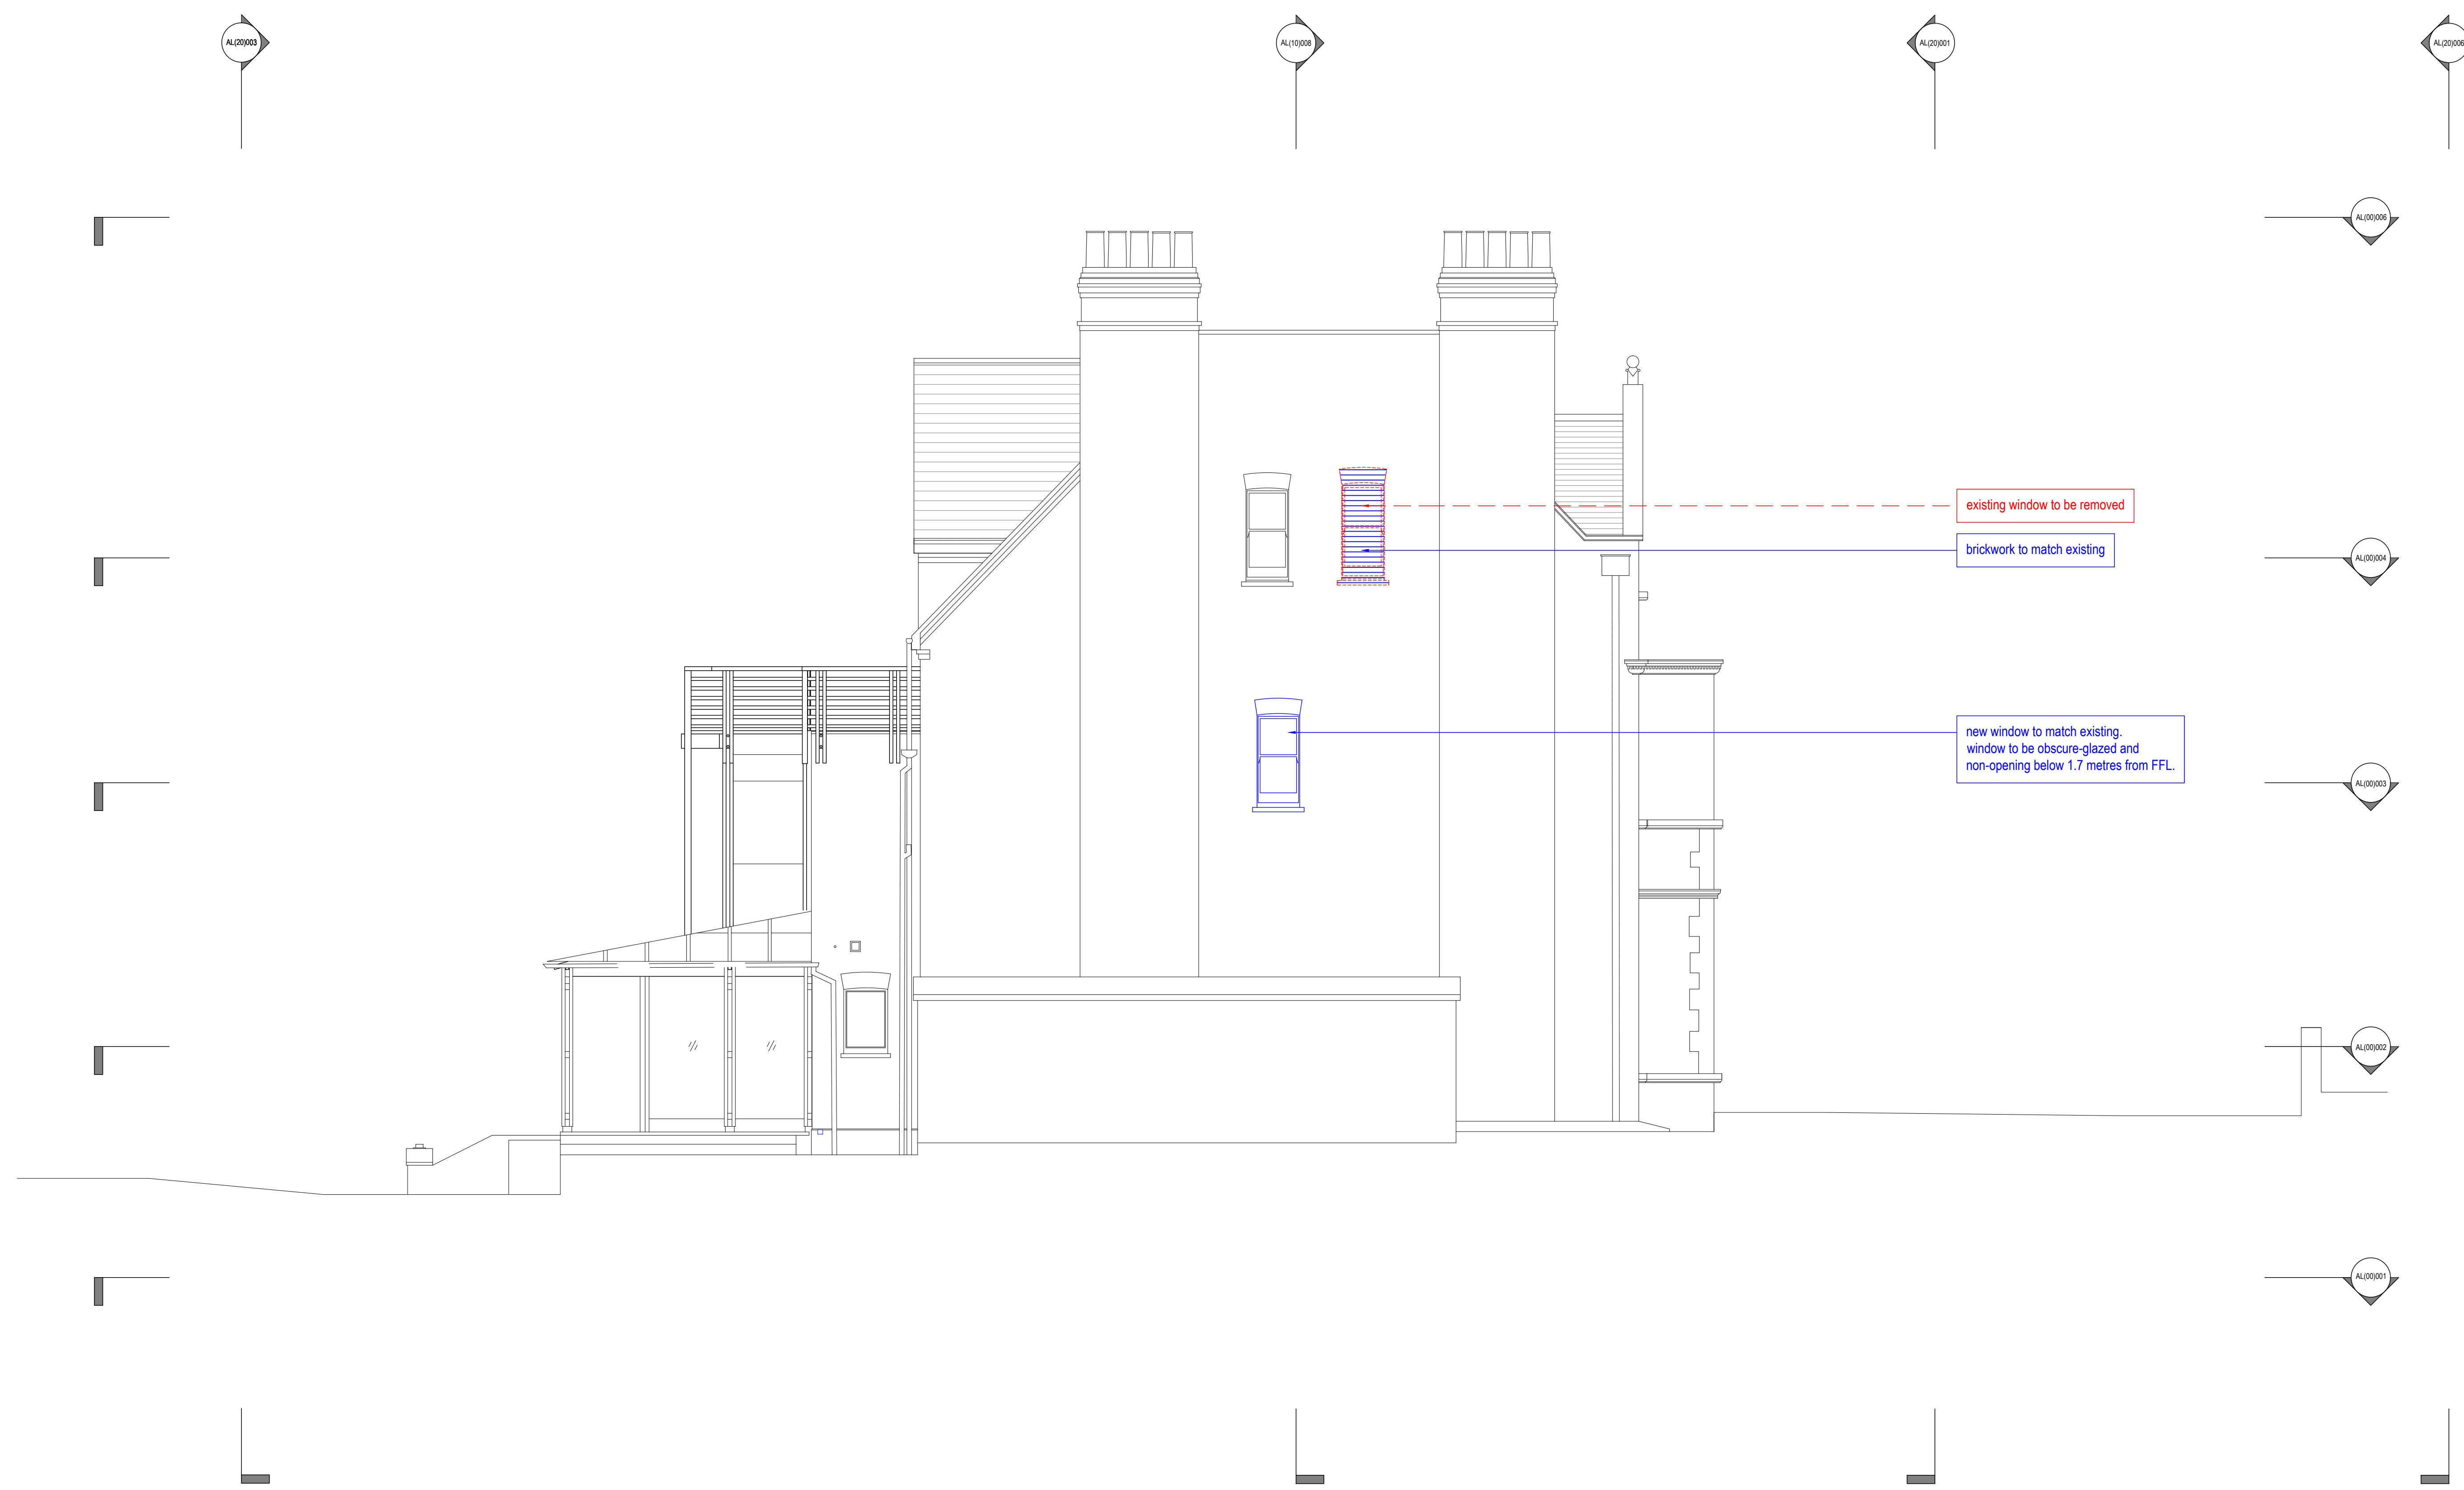

New proposal under this application shown in blue
New demolitions under this application shown in red

PLANNING ISSUE

McGUINNESS ARCHITECTS
unit d 163-167 hammondsey st
london e81 3uw
t: 0207 407 8540
e: info@mcguinnessarch.co.uk

15 Broadlands Rd, N6 4AE

TITLE: SIDE ELEVATION - PROPOSED
SCALE: 1:50 @ A1
DATE: September 2022

AL(20)005