





FRONT ELEVATION

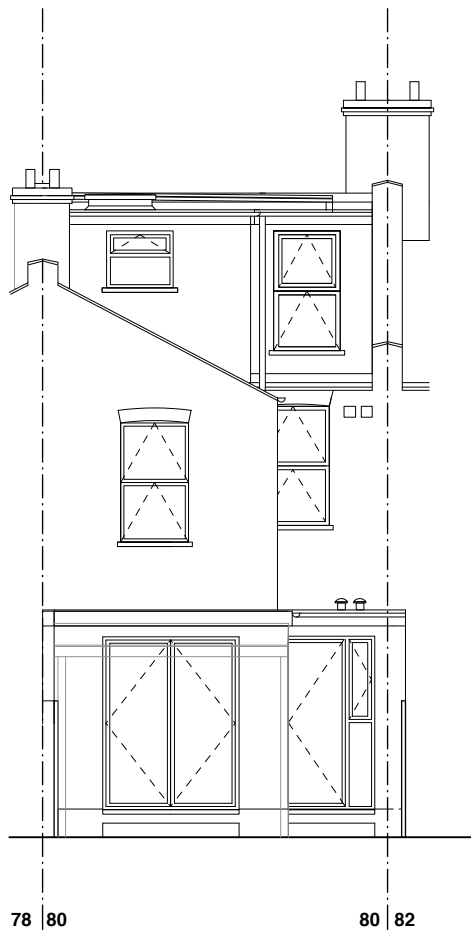

REAR ELEVATION

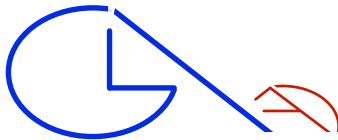

GLA Architecture and Design
Southgate Office Village, Block E,
286A Chase Road, London, N14 6HF
T 020 8886 5100 E g@glaad.co.uk

Client		
EASY LET PROPERTIES LIMITED		
Main Contractor		
PROJECT		
PROPOSED CHANGE OF USE FROM A DWELLING TO A HMO TO NO. 80 SHELBOURNE ROAD, LONDON N17 9XY		
Drawing Title		
AS BUILT FRONT & REAR ELEVATIONS		
Scale	Date	Drawn By
1:100 @ A3	March 2020	CA
Project No.	Drawing No.	Rev.
2003B	13	C-
DO NOT SCALE THIS DRAWING.		
ALL DIMENSIONS TO BE CHECKED ON SITE		
© Copyright		
DRAWING STATUS		
A SCHEME - Outline/Scheme drawings for proposals, budgets, etc.		
B DESIGN DEVELOPMENT - Evolving final design drawings for approvals, tenders, billing etc.		
C CONSTRUCTION - Fully developed drawings issued under instruction for construction.		
ONLY STATUS 'C'_DRAWINGS TO BE USED FOR CONSTRUCTION PURPOSES		

PROPOSED FRONT & REAR ELEVATIONS
scale 1:100

