


GLA Architecture and Design

Southgate Office Village, Block E,
286A Chase Road, London, N14 6HF
T 020 8886 5100 E g@glaad.co.uk

Client EASY LET PROPERTIES LIMITED		
Main Contractor		
PROJECT PROPOSED CHANGE OF USE FROM A DWELLING TO A HMO TO NO. 80 SHELBOURNE ROAD, LONDON N17 9XY		
Drawing Title AS BUILT SECTION AA		
Scale 1:100 @ A3	Date April 2020	Drawn By DK
Project No. 2003B	Drawing No. 14	Rev. C-
DO NOT SCALE THIS DRAWING. ALL DIMENSIONS TO BE CHECKED ON SITE		
DRAWING STATUS		
A SCHEME - Outline/Scheme drawings for proposals, budgets, etc.		
B DESIGN DEVELOPMENT - Evolving final design drawings for approvals, tenders, billing etc.		
C CONSTRUCTION - Fully developed drawings issued under instruction for construction.		
ONLY STATUS 'C' DRAWINGS TO BE USED FOR CONSTRUCTION PURPOSES		

PROPOSED SECTION AA
scale 1:100

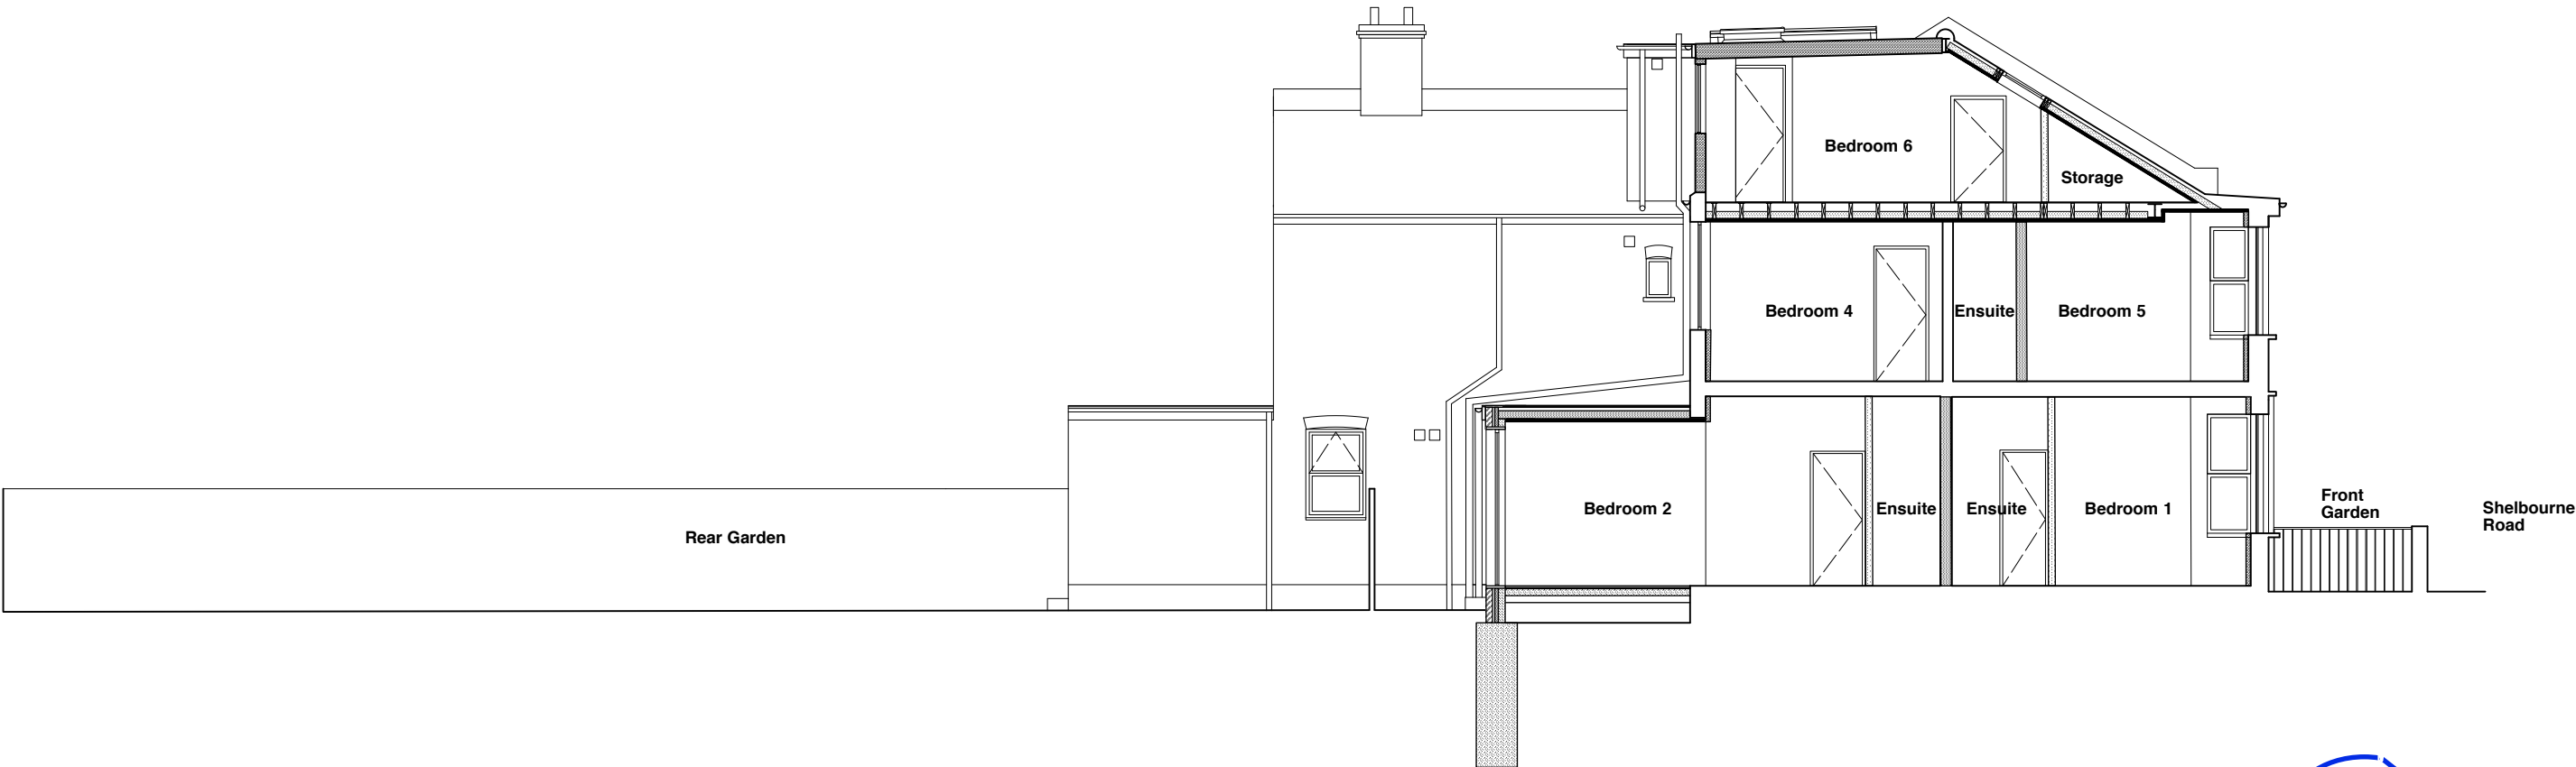