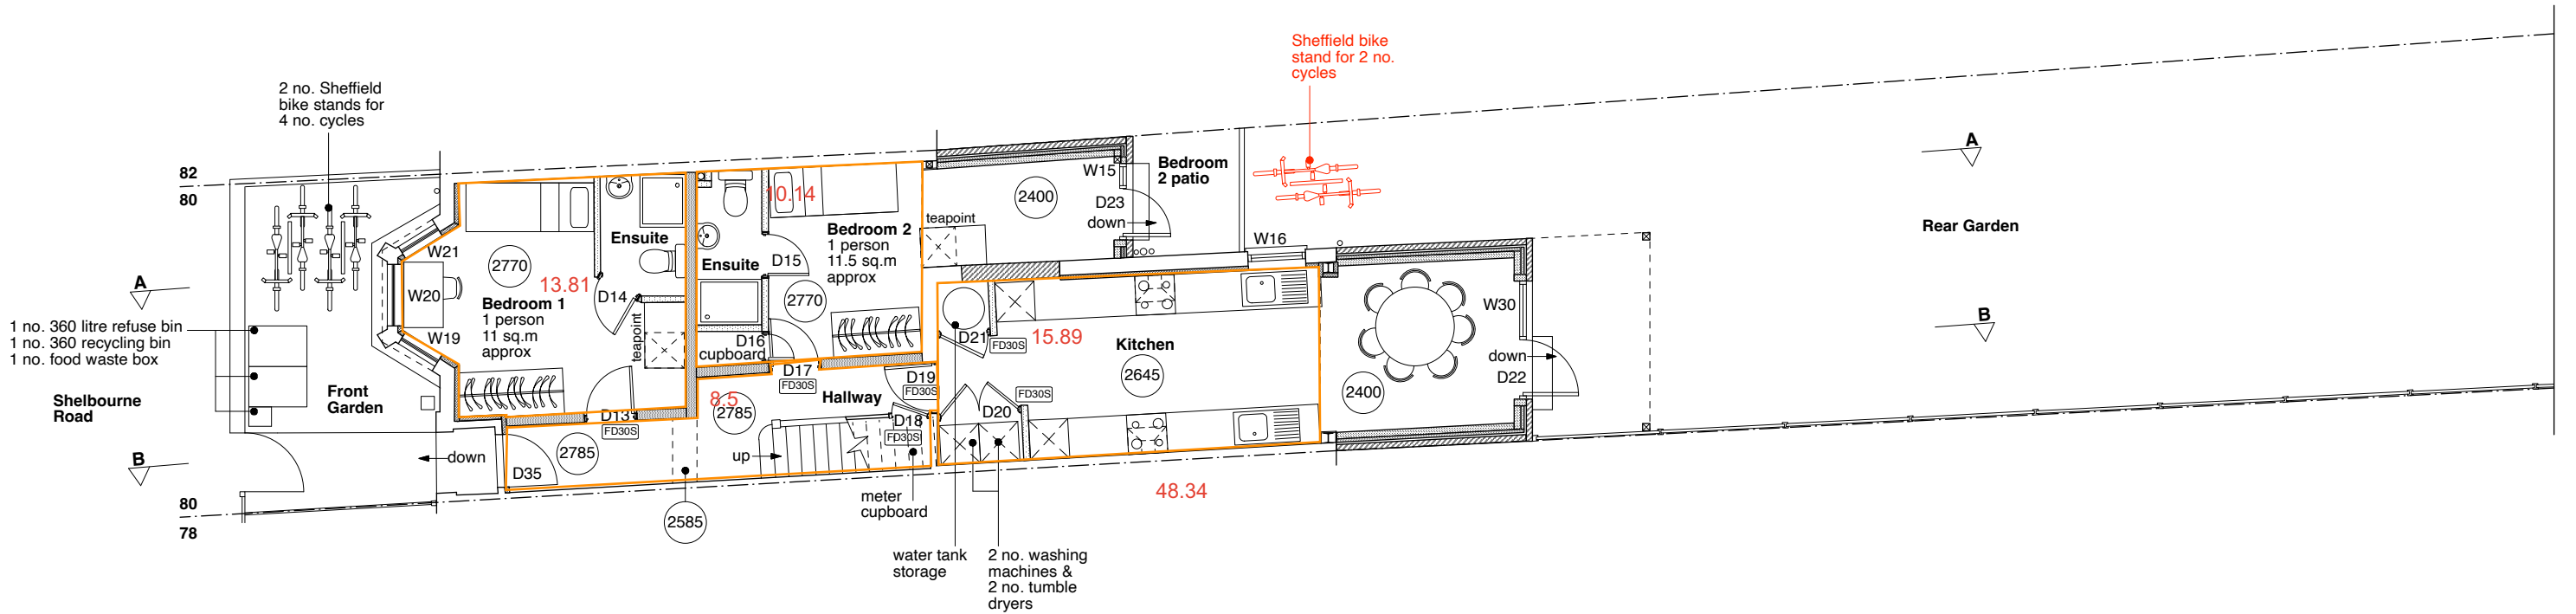


GLA Architecture and Design

Southgate Office Village, Block E,
286A Chase Road, London, N14 6HF
T 020 8886 5100 E g@glaad.co.uk

Revision: **C3**: -23.02.22: dk : Bike stand to garden added.
Revision: **C2**: -31.01.22: dk : Bike lockers & information amended.
Revision: **C1**: -1.12.21: dk : Bike lockers & information added.

Client
EASY LET PROPERTIES LIMITED

Main Contractor

PROJECT
PROPOSED CHANGE OF USE FROM A DWELLING TO A HMO TO NO. 80 SHELBOURNE ROAD, LONDON N17 9XY

Drawing Title
AS BUILT GROUND FLOOR PLAN

Scale 1:100 @ A3	Date March 2020	Drawn By DK
Project No. 2003B	Drawing No. 09	Rev. C3

DO NOT SCALE THIS DRAWING.
ALL DIMENSIONS TO BE CHECKED ON SITE © Copyright

DRAWING STATUS
A SCHEME - Outline/Scheme drawings for proposals, budgets, etc.
B DESIGN DEVELOPMENT - Evolving final design drawings for approvals, tenders, billing etc.
C CONSTRUCTION - Fully developed drawings issued under instruction for construction.

ONLY STATUS 'C' DRAWINGS TO BE USED FOR CONSTRUCTION PURPOSES

KEY

2985 - Ceiling Height

D01 - Door Number

W02 - Window Number



PROPOSED GROUND FLOOR PLAN
scale 1:100

