


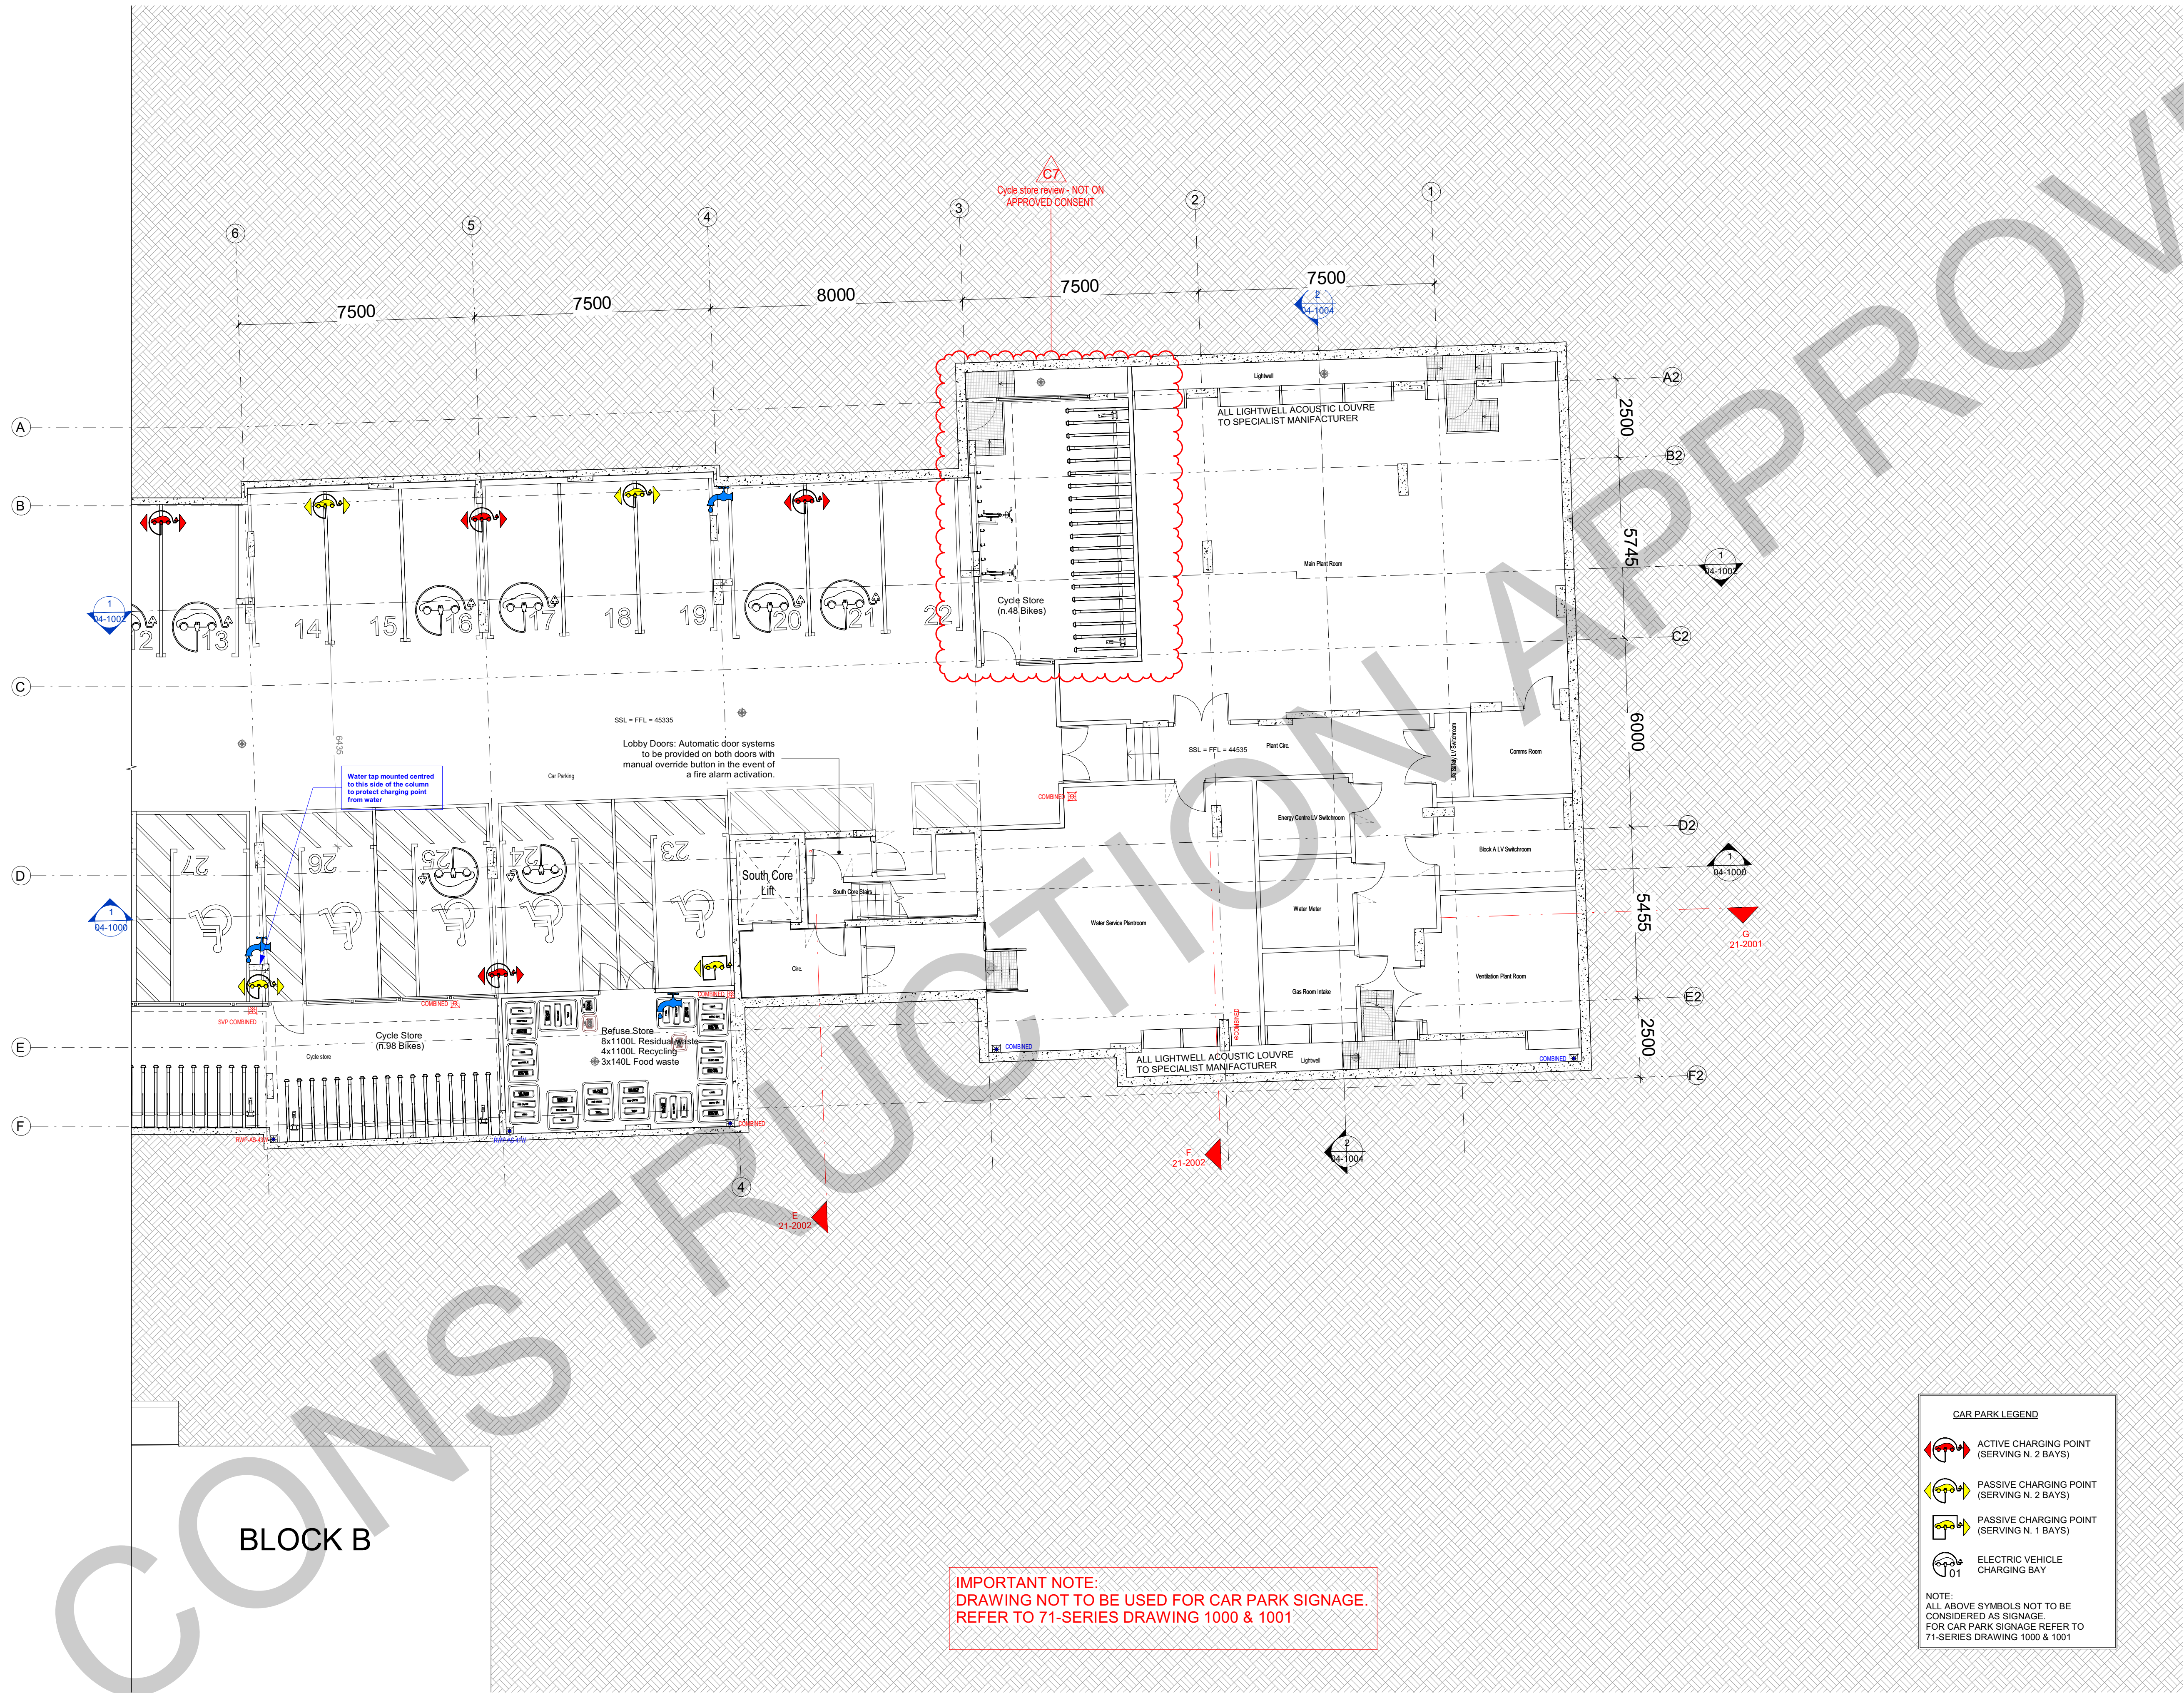

BLOCK B

IMPORTANT NOTE:
DRAWING NOT TO BE USED FOR CAR PARK SIGNAGE.
REFER TO 71-SERIES DRAWING 1000 & 1001

CAR PARK LEGEND

- ACTIVE CHARGING POINT (SERVING N. 2 BAYS)
- PASSIVE CHARGING POINT (SERVING N. 2 BAYS)
- PASSIVE CHARGING POINT (SERVING N. 1 BAYS)
- ELECTRIC VEHICLE CHARGING BAY


NOTE:
ALL ABOVE SYMBOLS NOT TO BE CONSIDERED AS SIGNAGE
FOR CAR PARK SIGNAGE REFER TO 71-SERIES DRAWING 1000 & 1001

© KDS & Associates Ltd
No part of this drawing may be reproduced without written consent.
All contractors must visit site and be responsible for taking and checking all dimensions relating to this work.
Do not scale from this drawing.

REVISION NOTES			
NO.	DESCRIPTION	DATE	NAME
P1	Preliminary Issue	08/11/19	FF
C1	First construction issue	10/12/19	FF
C2	Issued for Construction	27/02/20	CM
C3	Issued for construction: reviewed as clouded	22/06/20	FF
C4	Lower Ground floor review: Feeder pillar room added. Car parking bay 1 omitted. Drawings reviewed as clouded	26/02/21	FF
C5	Electrical charging point review	31/01/22	FF
C6	Updated as highlighted	24/04/22	ZZK
C7	LAST CONSTRUCTION ISSUE FOR AS BUILT PURPOSES: Changes from approved consent scheme highlighted	16/08/22	FF

- KEY:
- GRC PANELS AREA
 - BRICK WALL AREA
 - BALCONY/TERRACE PORCELAIN TILES
 - GARDEN PAVERS
 - GRASS
 - GREEN ROOF
 - PV PANELS
 - STRUCTURE
 - THRESHOLD CHANNEL DRAIN
 - ELECTRICAL VEHICLE CHARGING POINT
 - WATER POINT (wall mounted tap)
 - WATER POINT (free standing - floor mounted tap)
 - IP RATED SOCKET
 - EXTERNAL LIGHT
 - SOIL VENT PIPE
 - RAIN WATER OUTLET
 - SUB STACK
 - VENT PIPE
 - RAIN WATER PIPE
 - GULLY
 - INDICATIVE FALL PREVENTION LATCHWAY SYSTEM TO SPECIALIST SUB-CONTRACTORS DESIGN REQUIREMENTS
 - SSL = STRUCTURAL SLAB LEVEL
 - FSL = FINISH SCREED LEVEL
 - FFL = FINISH FLOOR LEVEL
 - SLAB EDGE
 - TRANSFER BEAM / STEPPED SLAB ABOVE
 - DRY RISER OFFSET IN CEILING
 - DRY RISER OFFSET AT LOWER LEVEL
 - BLINDS REQUIRED TO SATISFY OVERHEATING CRITERIA
 - (W) indicates Wheelchair Units
- NOTES
- FOR STRUCTURE REFER TO STRUCTURAL ENGINEER DRAWINGS
- FOR EXTERNAL WORKS LAYOUT REFER TO LANDSCAPE DRAWINGS
- FOR ELECTRICAL AND MECHANICAL EQUIPMENT REFER TO M&E DRAWINGS
- WATER POINT AND IP RATED SOCKETS TO M&E
- BOH WATER POINTS ARE CONNECTED TO CAT'S WATER MEAN. TERRACES AND GARDENS WATER POINTS ARE CONNECTED TO DOMESTIC WATER MEAN

- REVISION
- NORTH CORE COMMUNAL AREA STACKS REVIEWED.
 - SUBSTACKS REVIEWED AT GROUND FLOOR
 - WHEELCHAIR APARTMENTS INTERNAL DOORS REVIEWED

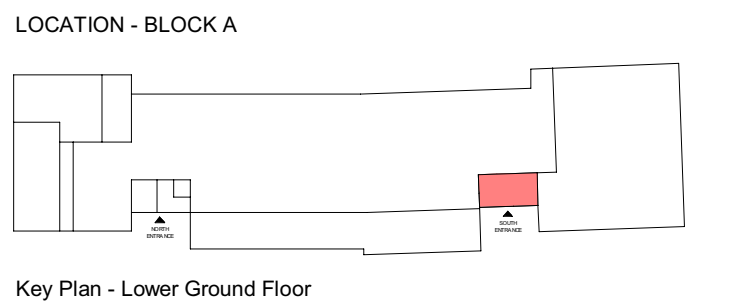

ARDMORE CONSTRUCTION LTD
6 WHARF STUDIOS,
28 WHARF ROAD,
LONDON, N1 7GR
TEL: 0208-344 0300
www.ardmoregroup.co.uk

KDS ASSOCIATES LTD
DESIGN ARCHITECTURE MANAGEMENT CONSULTANTS
101 The Blackfriars Foundry
106 Blackfriars Road
London SE1 8BN
Tel: 020 3355 9775
www.kdsassociates.co.uk

AS BUILT

PROJECT / DRAWING TITLE Homsey Town Hall	
DRAWING TITLE RESIDENTIAL BLOCK A GA Plan - Lower Ground Floor South Core	
DATE / DRAWN BY 08/09/17 FF	SCALE 1 : 100
PROJECT NO 3596-KDS-BA-B1-DR-A-03-1000	REV C7