




Scale 1 : 50

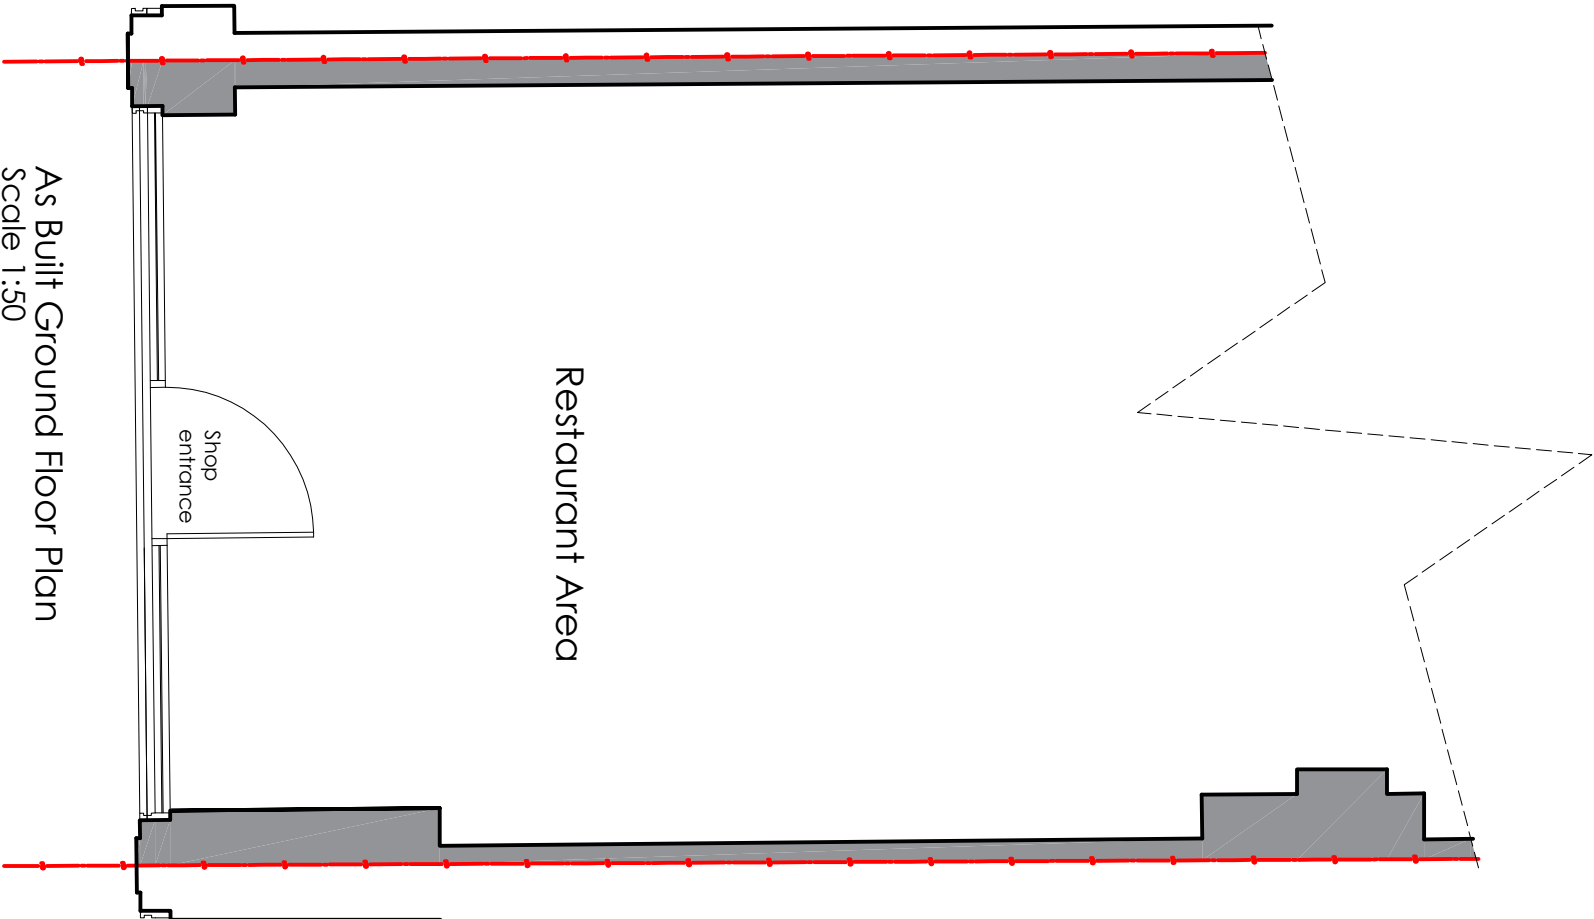

As Built Ground Floor Plan
Scale 1:50

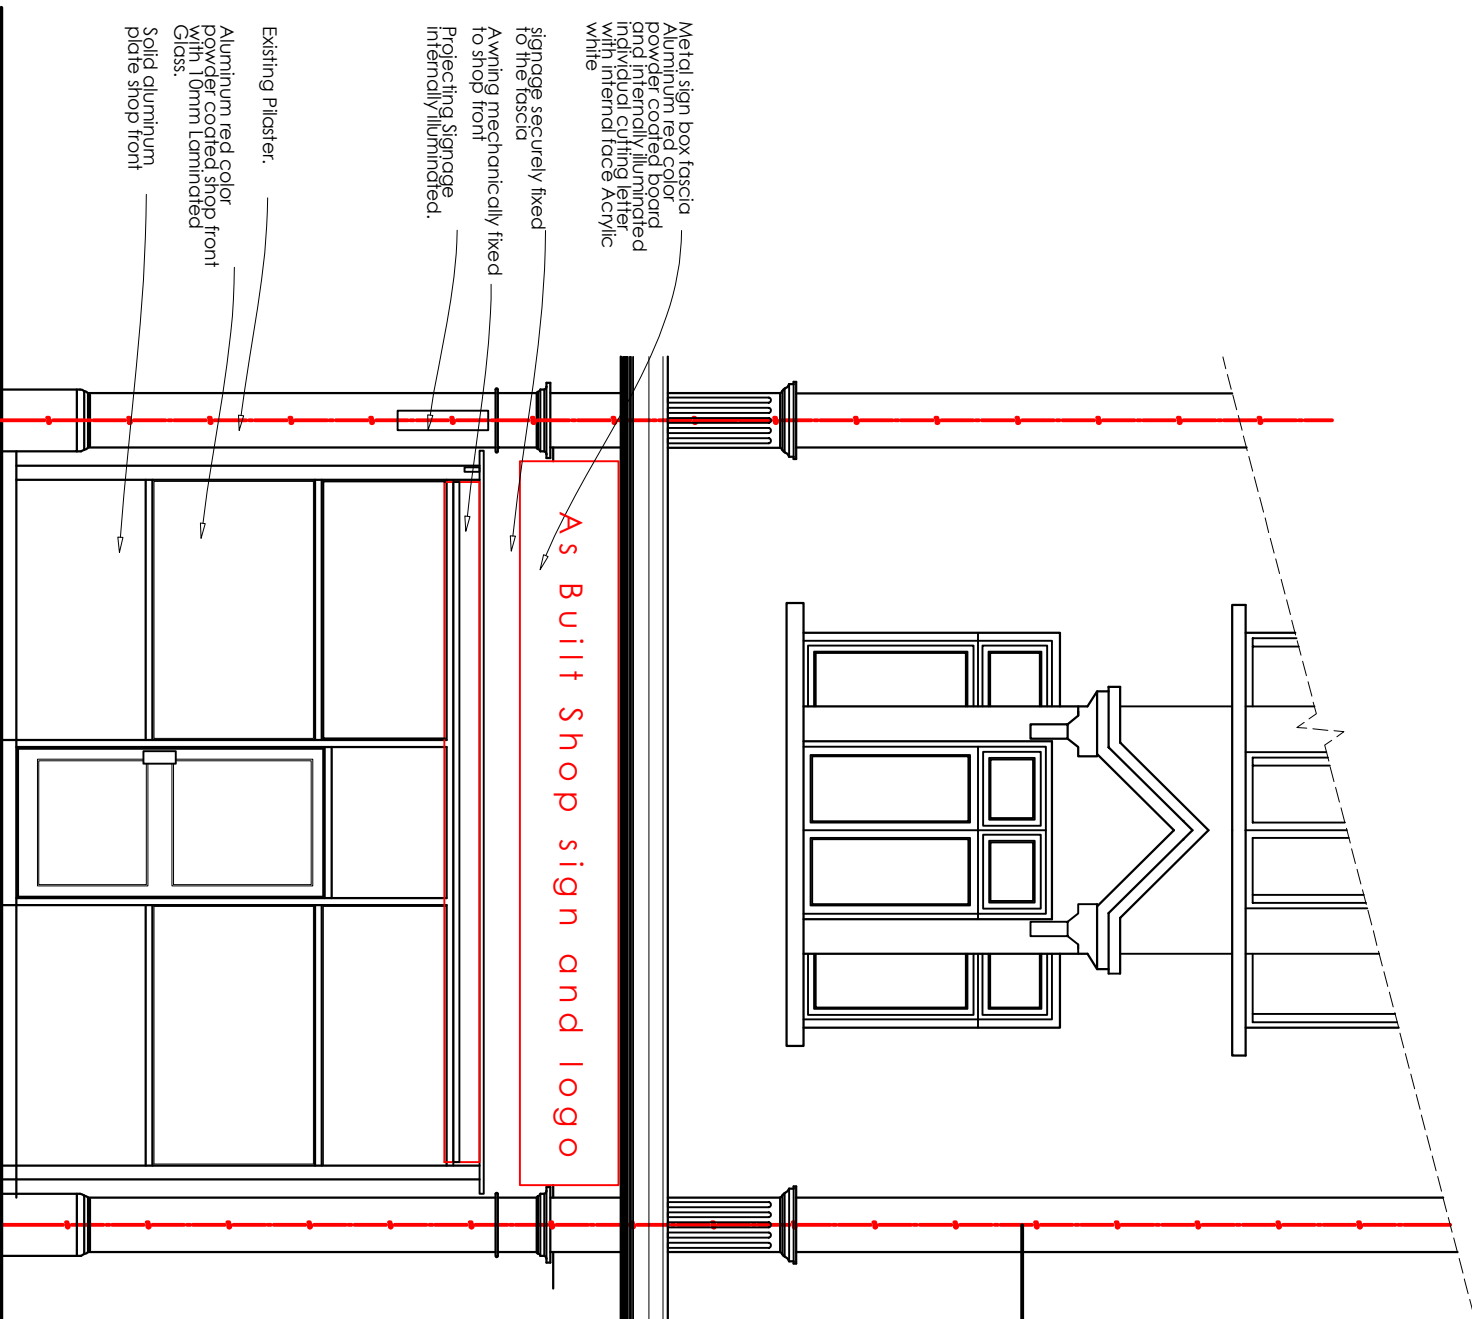

As Built front elevation
Scale 1:50

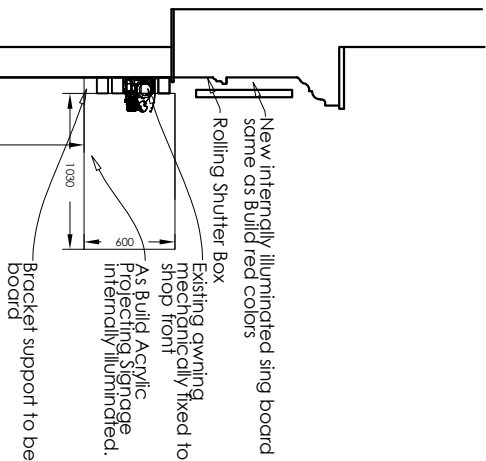

GENERAL NOTES : "This drawing is prepared solely for design and planning submission purposes. It is not intended or suitable for either Building Regulations or Construction purposes and should not be used for such". Structural Design and Building Control Approval is required before construction commences. This drawing is subject to copyright do not reproduce this drawing without prior permission.

Project Description
Change shop front and fascia sign.

Client's:
Mr Mohamed Hussein

Address:
552 High Road,
London
N17 9SY

T.M.D.S.Ltd
Architectural &
Planning Consultancy
Mobile : 07887555550

Issue:	Planning Approval
Scale: 1:50@A3	Date: 2021/10/06
Job No: 460/R1	Dwg No: 3

