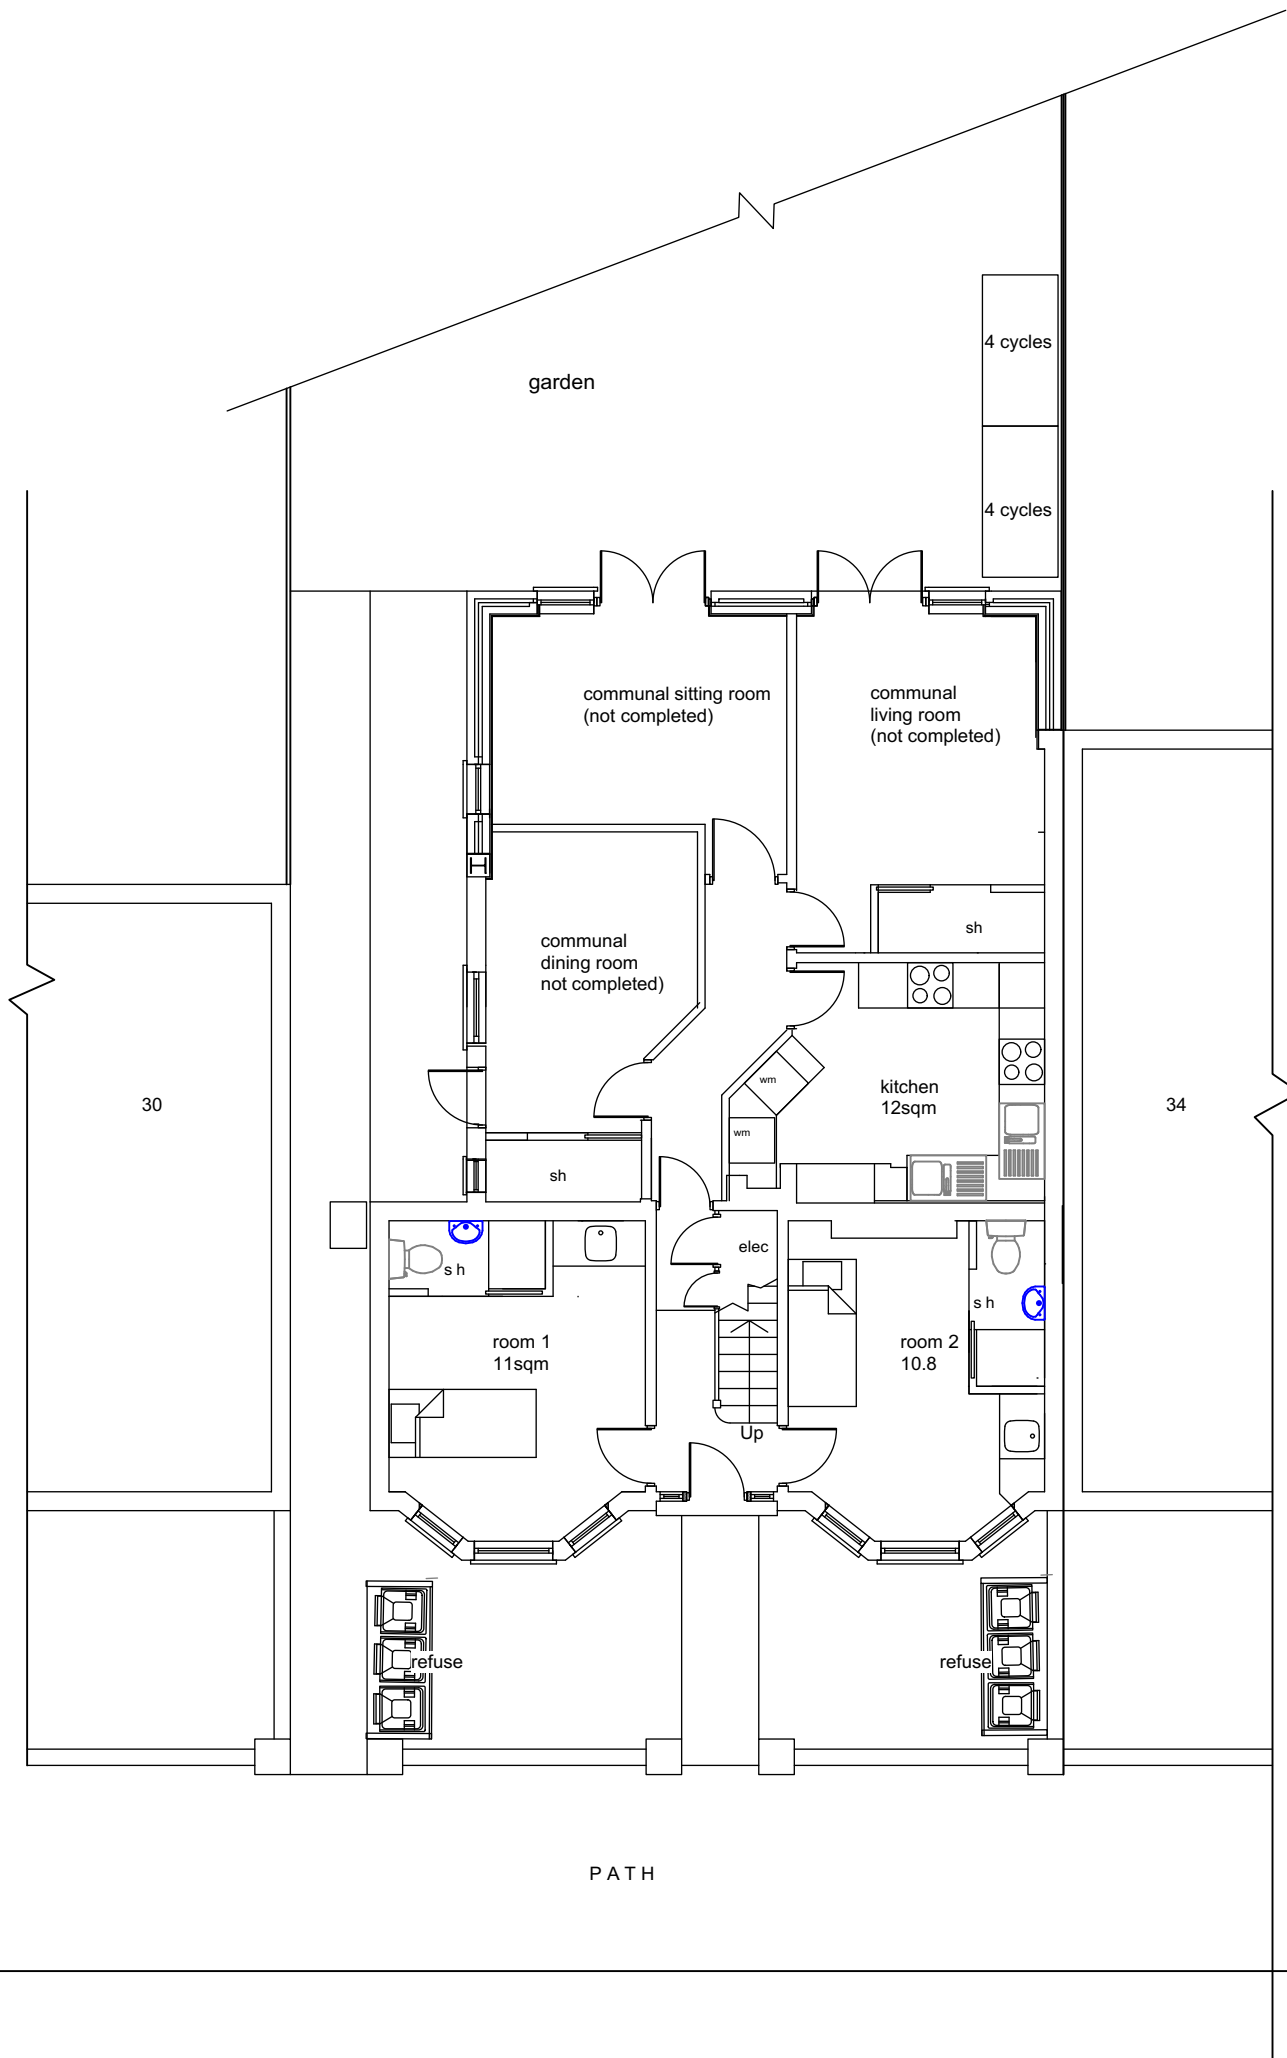


ALTARAS ARCHITECTURE LTD
41 High Street, Barkway
Herts. SG8 8EA
Tel : 01763 848952
Fax: 01763 848001
email: dolores@altarasarchitecture.co.uk

32 WILLOUGHBY LANE,
LONDON N17 0SS
Conversion to HMO (Retrospective)
Ground Floor Plan (as built)

Drawn By	DA
Checked By	DA
Scale	1:100 @A3
Date	Feb 2023
Drawing No.	SS- WL - P01