


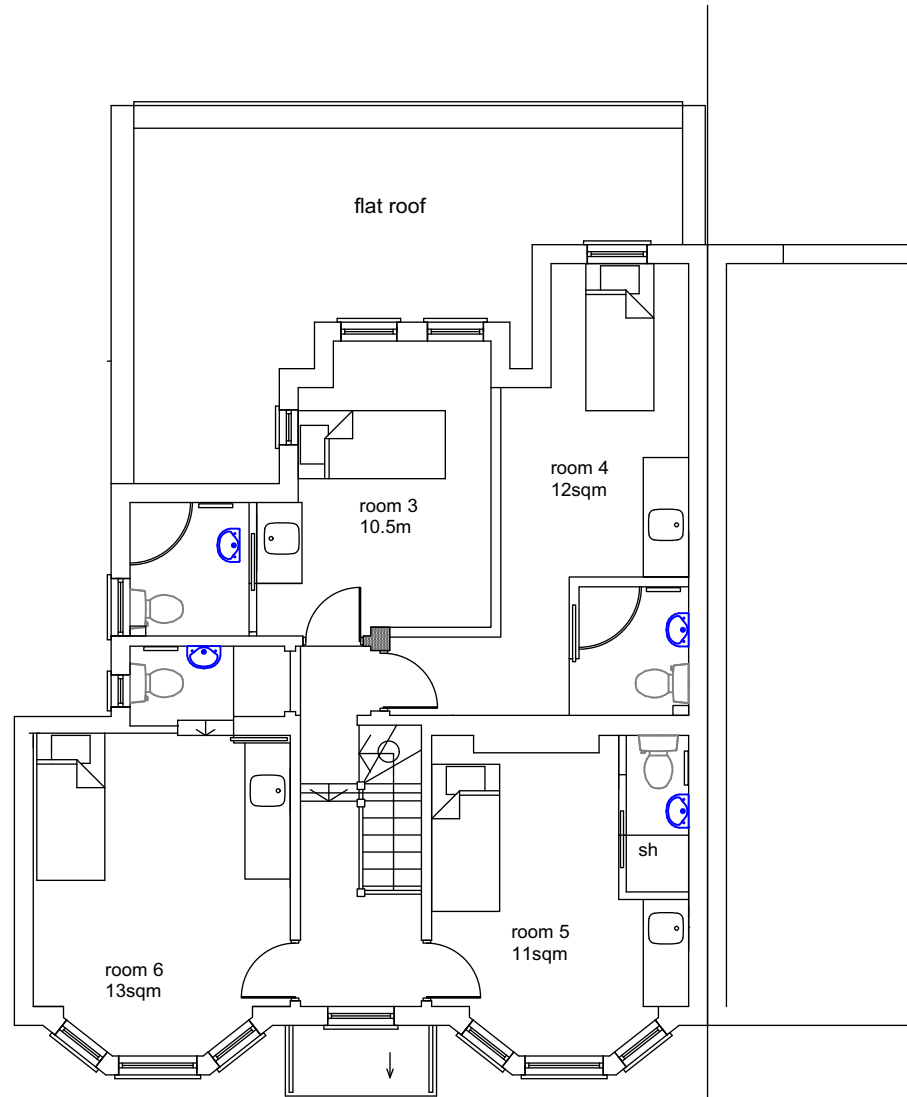


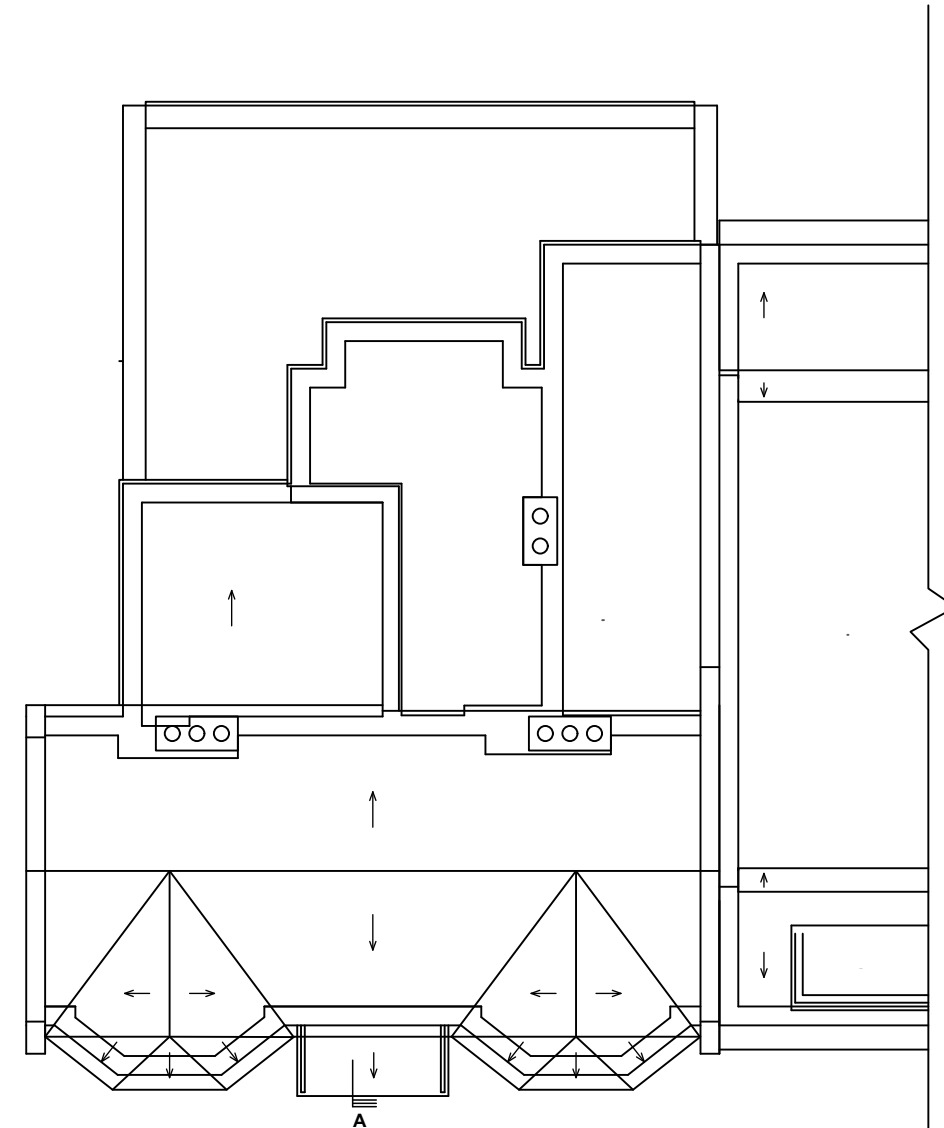

FIRST FLOOR PLAN

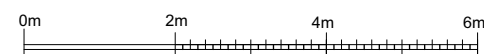

ROOF PLAN

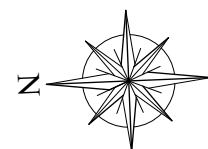

ALTARAS ARCHITECTURE LTD
 41 High Street, Barkway
 Herts. SG8 8EA
 Tel : 01763 848952
 Fax: 01763 848001
 email: dolores@altarasarchitecture.co.uk

**32 WILLOUGHBY LANE,
 LONDON N17 0SS**
Conversion to HMO (Retrospective)
First Floor and roof plans as built

Drawn By	DA
Checked By	DA
Scale	1:100 @A3
Date	Feb 2023
Drawing No.	SS- WL - P02