


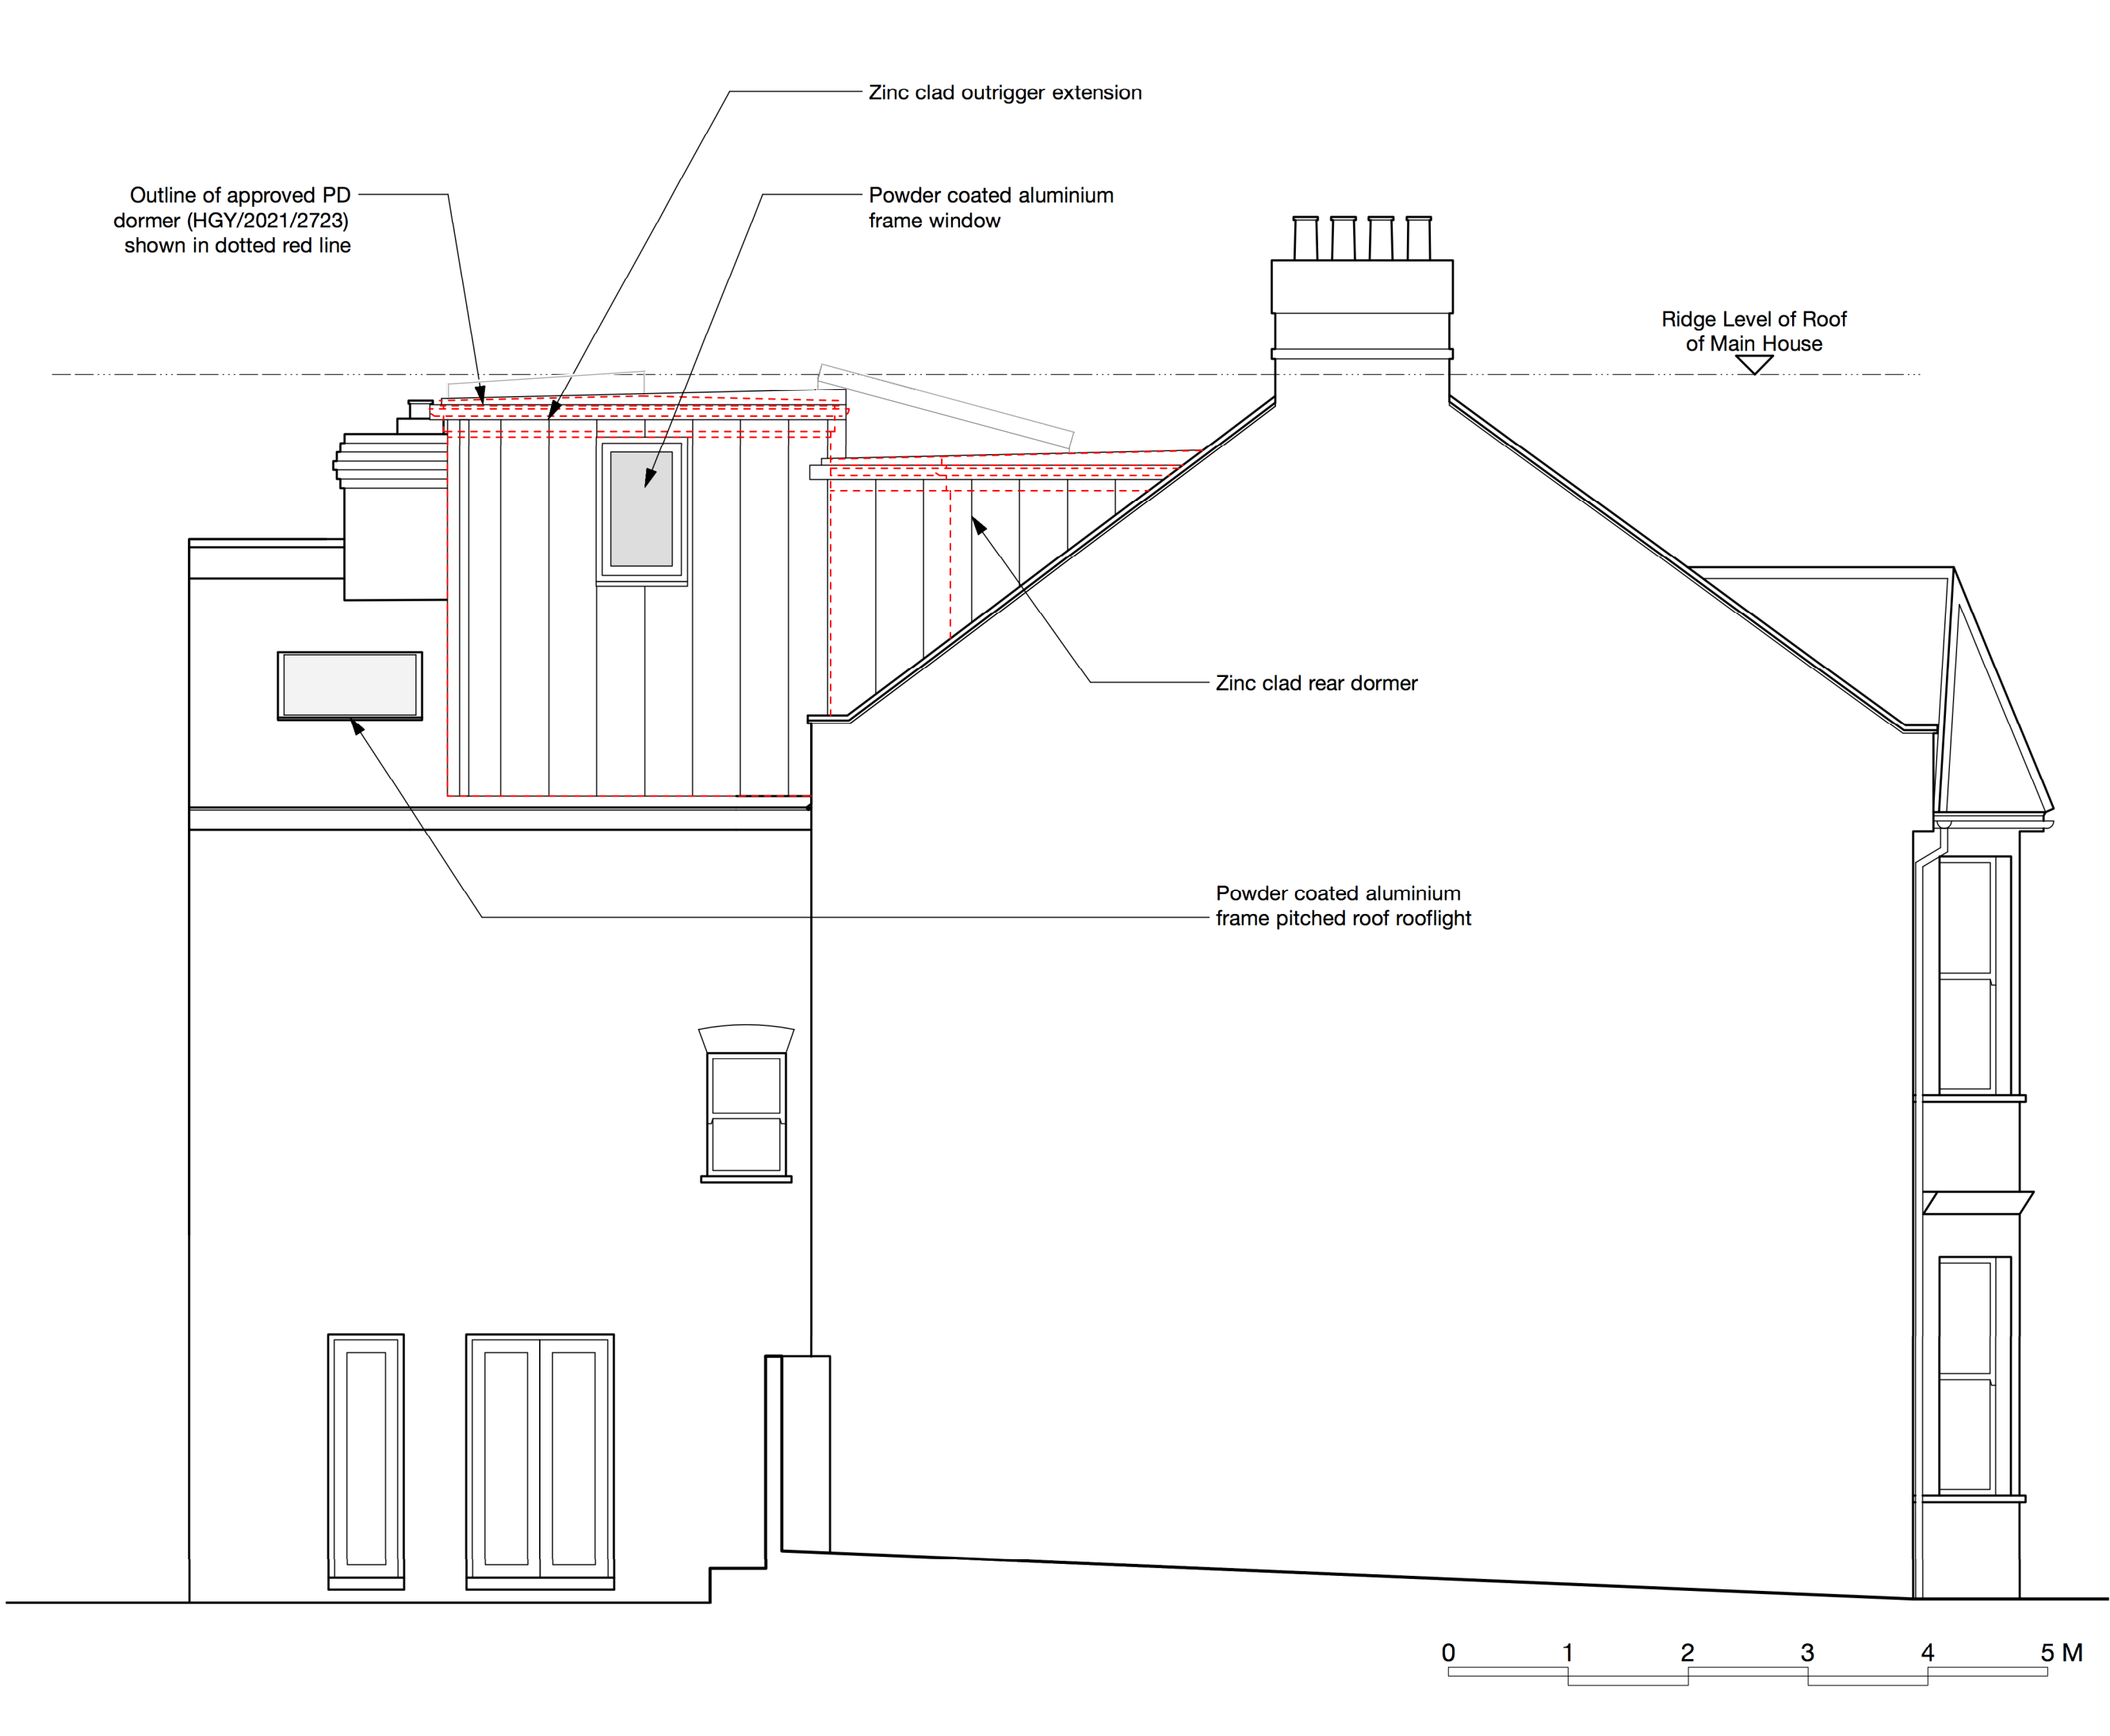

GENERAL NOTES

1. This drawing is the copyright of Haines Phillips Architects.
2. Do not scale from this drawing. Use figured dimensions only.
3. This drawing must not be used for land transfer purposes, or for construction purposes unless accompanied by an Architect's Instruction.

DRAWING ISSUE STATUS

ISSUE STATUS		COMMENT
P	PRELIMINARY	For comment and review Planning/Listed Building Application
PL	PLANNING	
BR	BUILDING REGS	Building Regs Application For pricing purposes only
T	TENDER	
C	CONSTRUCTION	For procurement & construction
FC	FINAL	Record drawings on completion
L	CONSTRUCTION	
	LEGAL	Conveyancing or other legal purposes

REVISIONS

REV	DATE	NOTES
-----	------	-------

**HAINES
PHILLIPS**
ARCHITECTS

Tankerton Works
12 Argyle Walk
London WC1H 8HA
t 020 7833 9324
f 020 7837 2864
e office@hainesphillips.co.uk

JOB TITLE
11 Gladwell Road
London N8 9AA

DRAWING TITLE
Side Elevation
As Proposed

DRAWN	DATE
PL	Jan 2023
JOB NR	SCALE
4166	1:50@A3
DRAWING NO.	ISSUE REVISION
GA 361	PL