


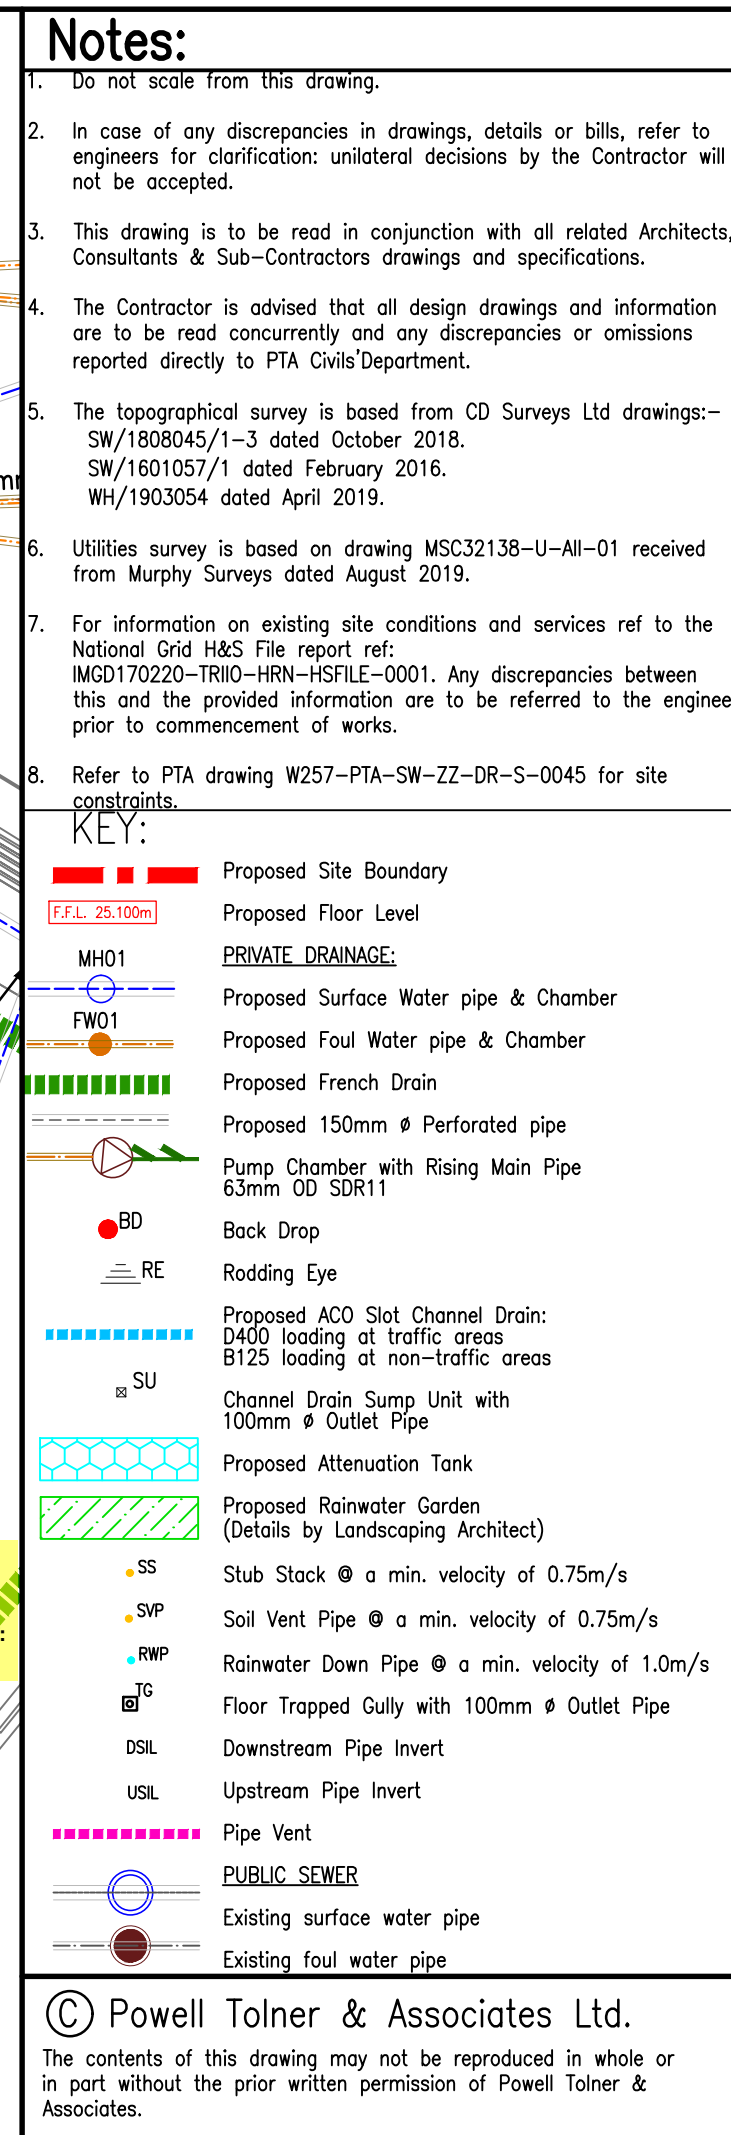

FOR CONSTRUCTION				
C11	floor gullies invert lvl added	SN	12.11.20	-
C10	D2 Terrace gullies added	SN	10.11.20	-
C9	Pumping Station chamber shape amended. Rising main & perforated pipe diameter added. channel drain amended	SN	30.10.20	-
C8	L&Q drainage added. Architect background amended	SN	15.10.20	-
C7	D1 L&Q drainage added	SN	08.10.20	-
C6	D1 & D2 Blocks SVP & SS amended to suit MEP layout.	SN	25.09.20	-
C5	Site Wide manhole covers level amended.	SN	14.08.20	-
C4	Drainage amended following a coordination exercise.	SN	06.08.20	-
C3	Drainage amended to suit Architect & M&E latest model	SN	16.07.20	-
C2	Drainage amended to suit M&E latest model	SN	22.05.20	AH
C1	Issue for Construction	SN	17.04.20	AH
P1	First Issue.	SN	13.03.20	
REV	DESCRIPTION	BY	DATE	CHK'D

Clarendon Ph3a Drawing Title Drainage Layout Sheet 1 of 3																			
<table border="1" style="width: 100%; border-collapse: collapse;"> <tr> <td style="padding: 5px;">DATE</td> <td style="padding: 5px;">Feb 20</td> </tr> <tr> <td style="padding: 5px;">DRAWN</td> <td style="padding: 5px;">SN</td> </tr> <tr> <td style="padding: 5px;">SCALE</td> <td style="padding: 5px;">1 : 100</td> </tr> <tr> <td style="padding: 5px;">DRG SIZE</td> <td style="padding: 5px;">A1</td> </tr> </table>	DATE	Feb 20	DRAWN	SN	SCALE	1 : 100	DRG SIZE	A1	<table border="1" style="width: 100%; border-collapse: collapse;"> <tr> <td style="padding: 5px;">CHECKED DO</td> <td style="padding: 5px;">JP</td> </tr> </table>	CHECKED DO	JP	<table border="1" style="width: 100%; border-collapse: collapse;"> <tr> <td style="padding: 5px;">CHECKED ENG</td> <td style="padding: 5px;">AH</td> </tr> </table>	CHECKED ENG	AH	<table border="1" style="width: 100%; border-collapse: collapse;"> <tr> <td style="padding: 5px;">PTA PROJ No</td> <td style="padding: 5px;">9669</td> </tr> <tr> <td style="padding: 5px;">REVISION</td> <td style="padding: 5px;">C19</td> </tr> </table>	PTA PROJ No	9669	REVISION	C19
DATE	Feb 20																		
DRAWN	SN																		
SCALE	1 : 100																		
DRG SIZE	A1																		
CHECKED DO	JP																		
CHECKED ENG	AH																		
PTA PROJ No	9669																		
REVISION	C19																		
DRAWING No W257-PTA-DE-ZZ-DR-C-01-8101																			
 Consulting Civil & Structural Engineers 29 Red Lion Street Chesham Bucks HP5 1EJ Tel. 01494 772721																			

C19	IC15 IL updated	JP	12.03.21	A
C18	FW15a/15/16 updated to as built positions FW17/18 levels updated	JP	02.03.21	A
C17	SW09 BD level ammended	JP	19.02.21	A
C16	Terrace drainage updated. Channel drain to D1 added.	JP	16.02.21	A
C15	FW15/ FW15a IL ammended. IC09b/IC09c shown in as-built position. CD added to terraces	JP	05.02.21	A
C14	IC09b & 09C moved & FW16 invert level ammended	SN	29.01.21	
C13	Perforated added	SN	06.01.21	
C12	RWP location & SW02 ammended	SN	25.11.20	