




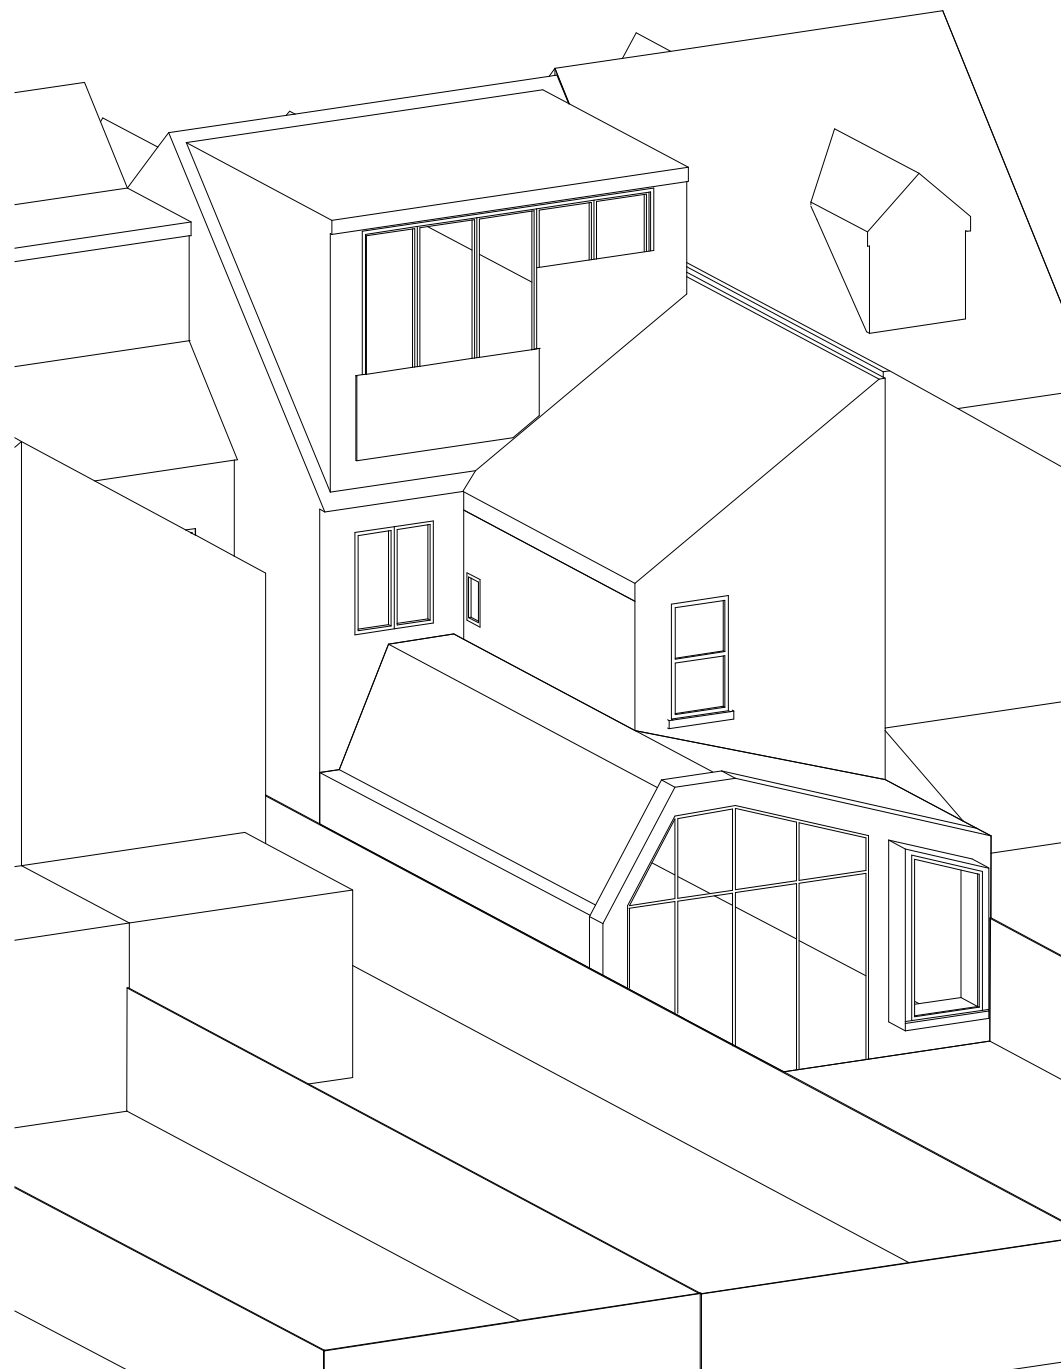

Pre Existing Rear View

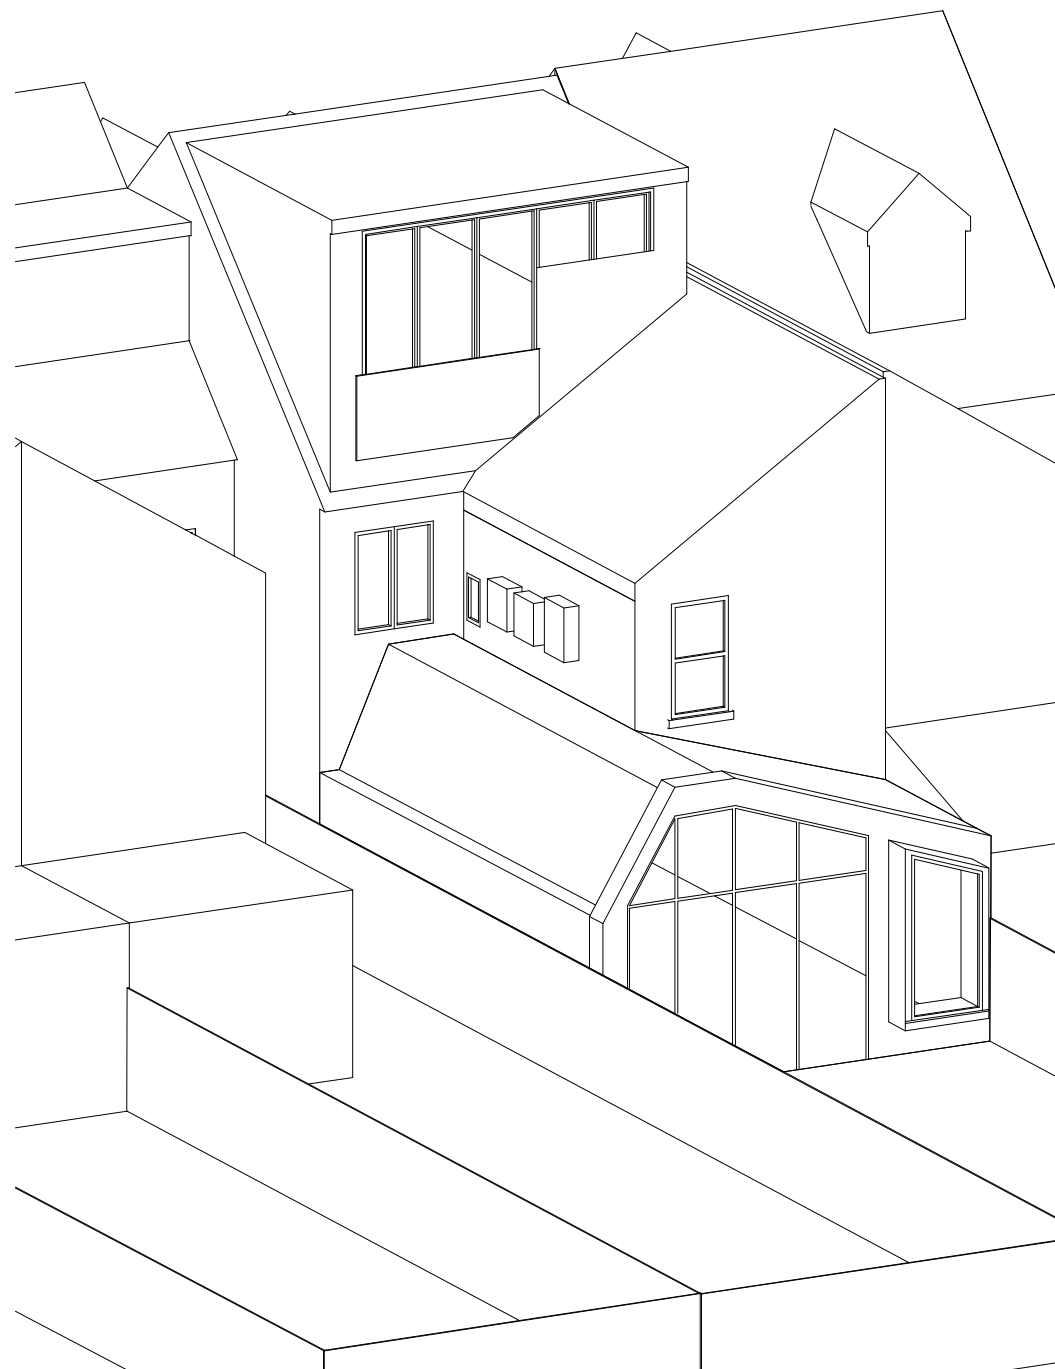

As Built Proposed Rear View

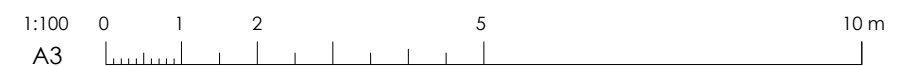

07

- General Notes**
- 1 This drawing is prepared solely for design and planning submission purposes. It is not intended or suitable for either Building Regulations or Construction purposes and should not be used for such.
 - 2 Setting-out is based on outline survey only. All dimensions to be checked on site prior to construction/ordering
 - 3 Unless shown otherwise all dimensions are to structural surfaces and are in mm.
 - 4 Unless shown refer to internal door schedule for door size. Door opening to be set out to give full specified architrave either side.
 - 5 Refer to drawing number.
 - 6 Any discrepancies between the Engineer's and Architect's drawings must be verified with the architect

Rev	Date	Description	By	Chkd

Client
Mr Mehdi Tabashiri

Site
**106 Priory Road
London N8 7HR**

Project
Installation of 3 x AC Units

Drawing Title
3d Rear Views

Date
March 23'

Scale
1:100

8110 - 400

t: 07904 119 951
e: info@omni-architecture.co.uk
www.omni-architecture.co.uk

Status
Planning

Revision

OMNI
ARCHITECTURE