





As built Proposed Side Elevation

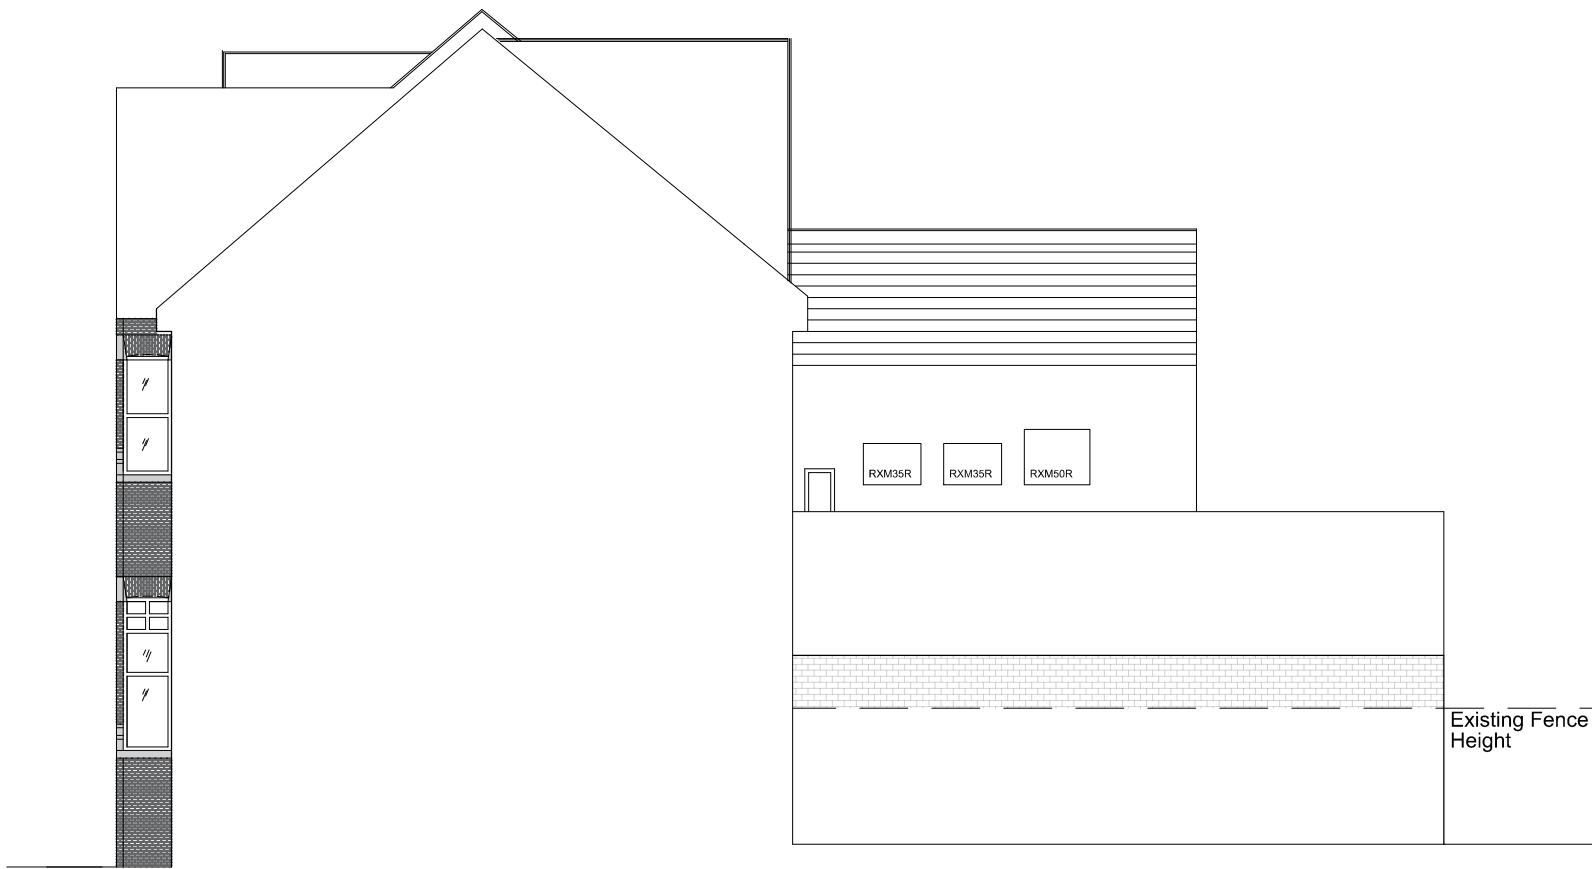

As built Proposed Rear Elevation

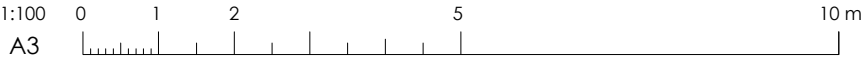

06	General Notes 1 This drawing is prepared solely for design and planning submission purposes. It is not intended or suitable for either Building Regulations or Construction purposes and should not be used for such. 2 Setting-out is based on outline survey only. All dimensions to be checked on site prior to construction/ordering 3 Unless shown otherwise all dimensions are to structural surfaces and are in mm. 4 Unless shown refer to internal door schedule for door size. Door opening to be set out to give full specified architrave either side. 5 Refer to drawing number. 6 Any discrepancies between the Engineer's and Architect's drawings must be verified with the architect	RevDateDescriptionByChkd				Client	Project	t: 07904 119 951 e: info@omni-architecture.co.uk www.omni-architecture.co.uk				
						Site	Drawing Title	Date	Scale	Status		
						106 Priory Road	As Built Proposed Rear and Side Elevations	March 23'	1:100	Planning		
						London N8 7HR		8110 - 311		Revision		

O

M

N

I

ARCHITECTURE

