



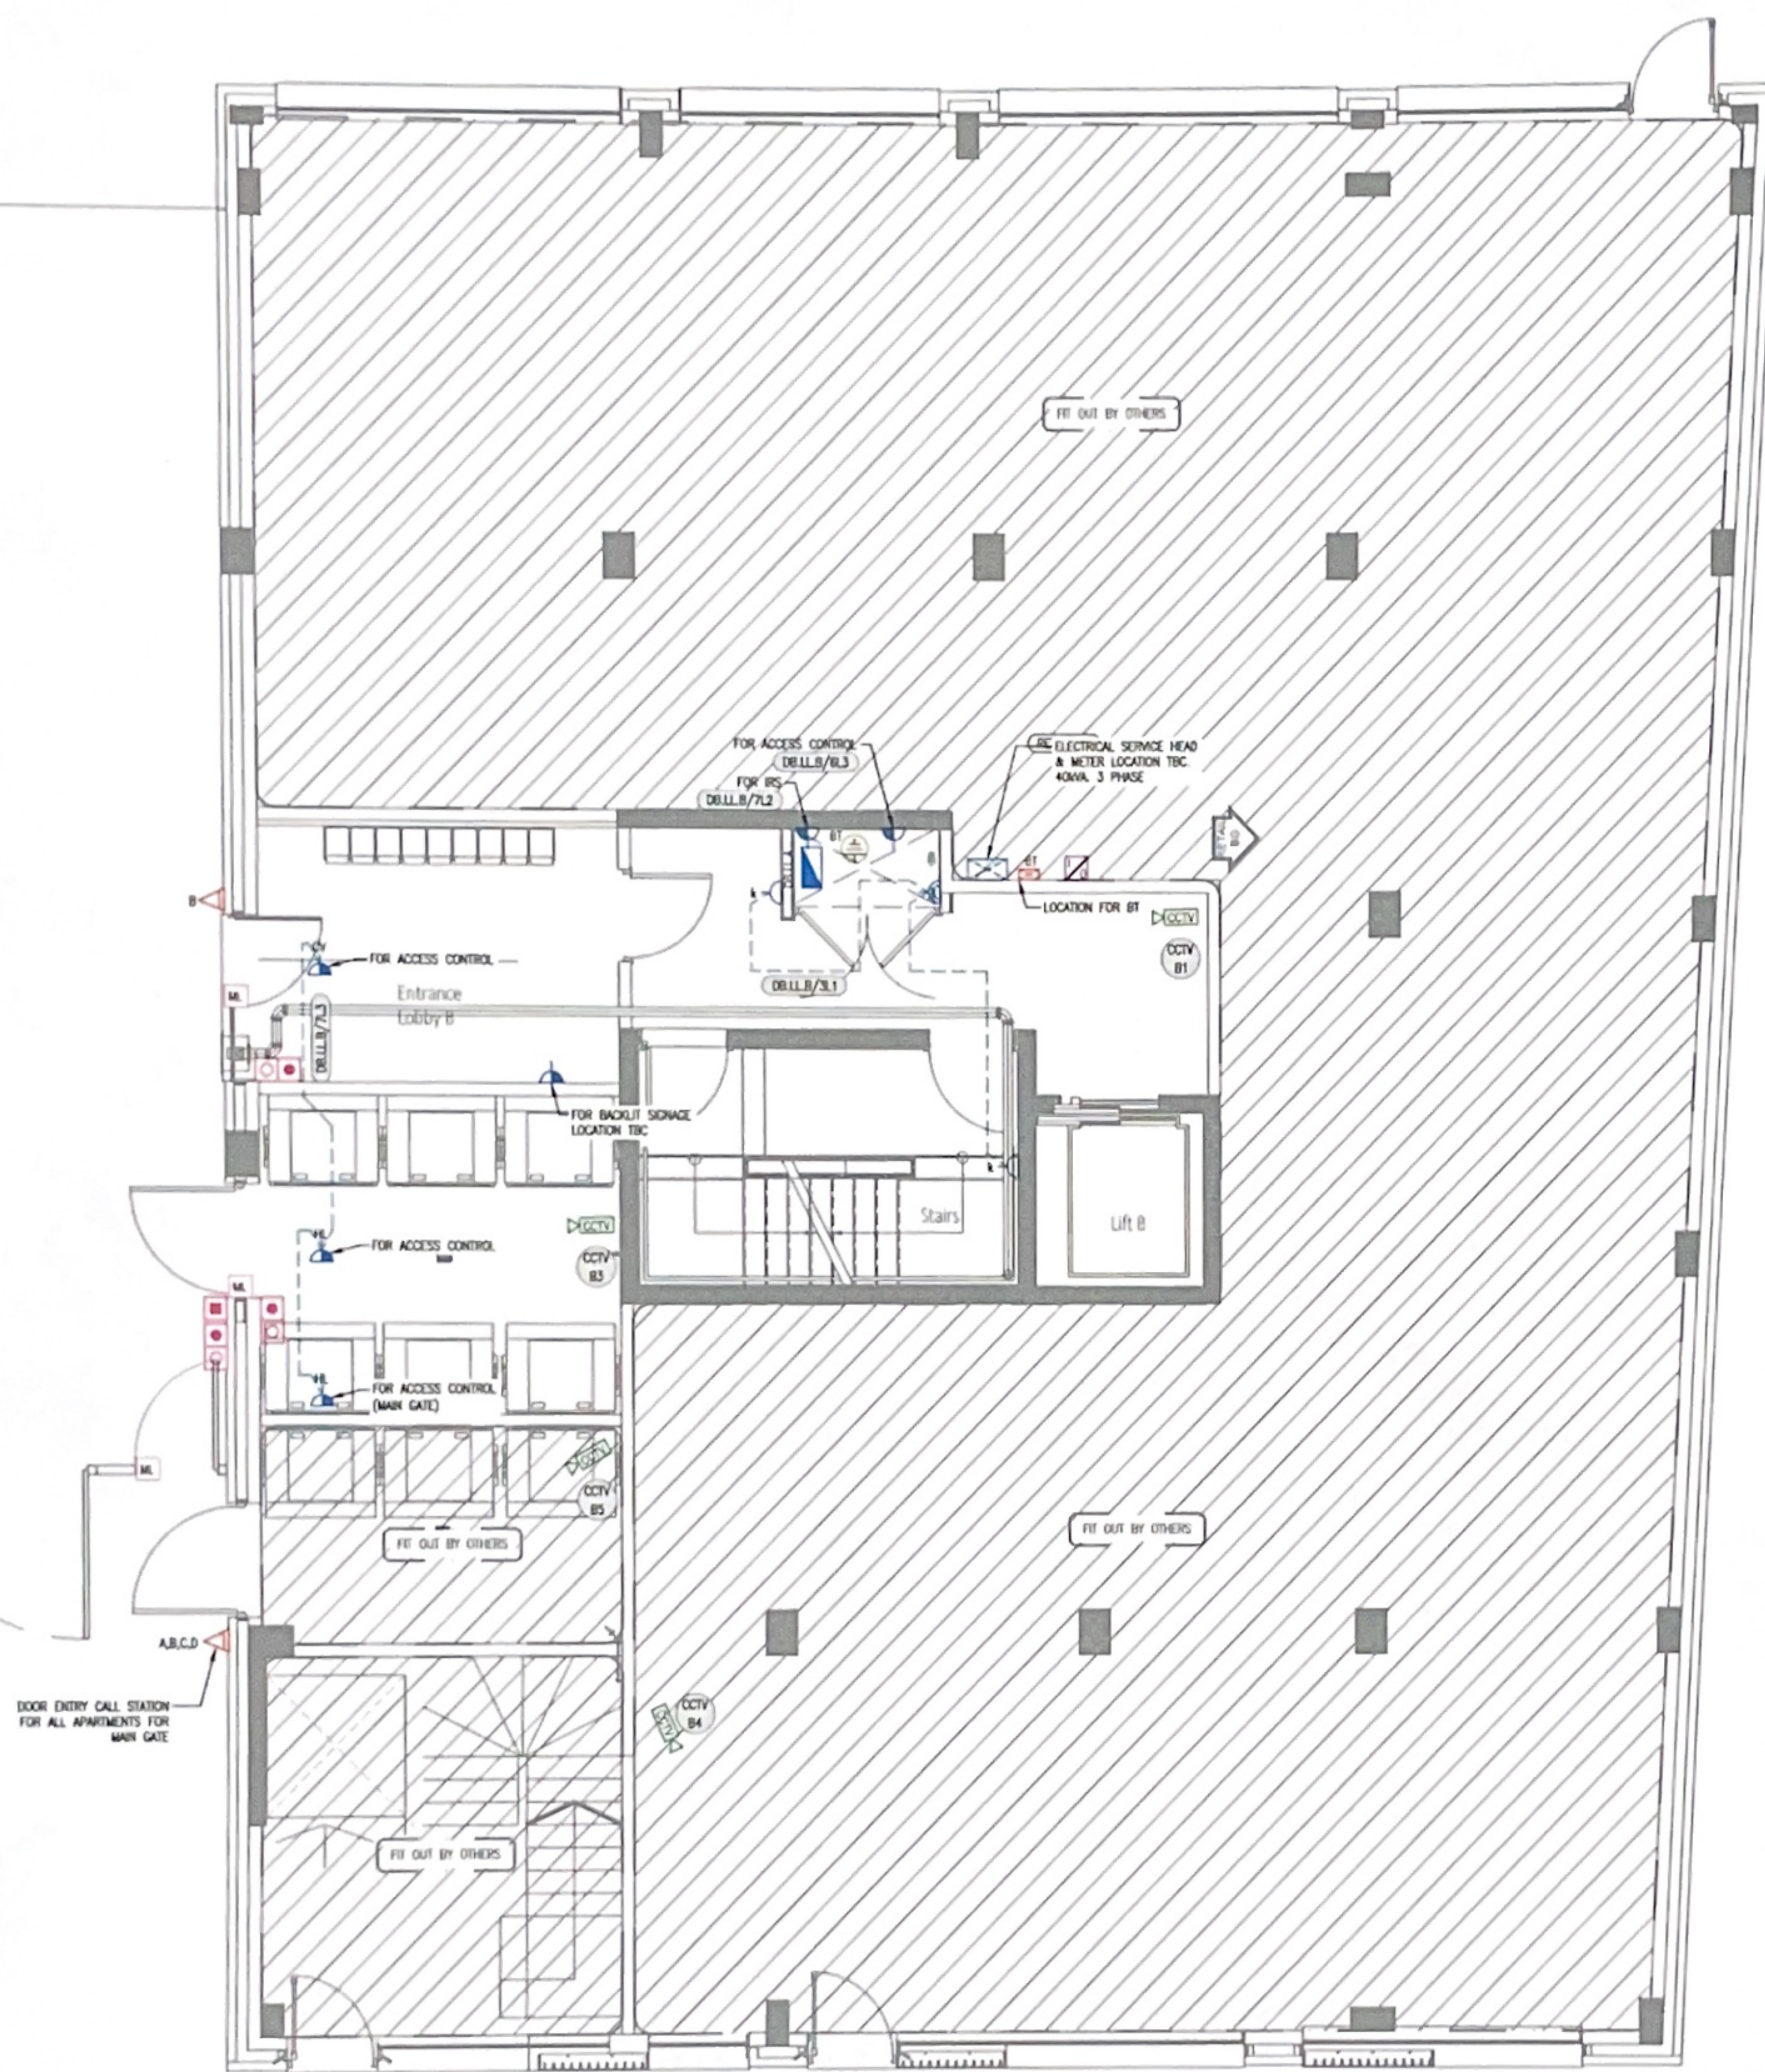

CORE B GROUND FLOOR SERVICES LAYOUT

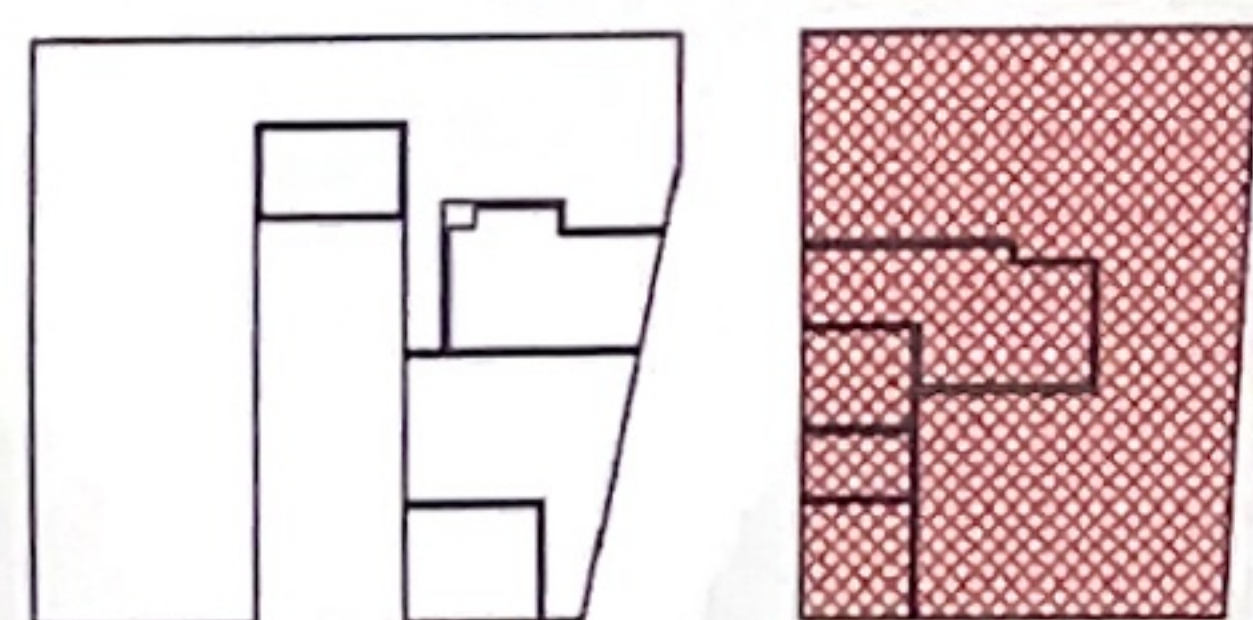

BLOCK A
BLOCK KEY PLAN

Status: AS BUILT

Client: CiField

DMO
MECHANICAL AND ELECTRICAL
ENGINEERING
27 Old Gloucester Street,
London, WC1N 3AX
0800 234 3443


Project Title: CROSS LANE,
HORNSEY, LONDON, N8 7AS

Drawn: RP CK'd: D.O. Scale A1: 1:50
Issued Date: FEB 20

Title: BLOCK A - CORE B
GROUND FLOOR
SMALL POWER AND ACCESS CONTROL
LAYOUT


AB1 AS BUILT DRAWING	19.02.20	RP
Revisions	Date	Dm

Drawing No. DMO-1400-63-GA-B-01 Revision: AB1

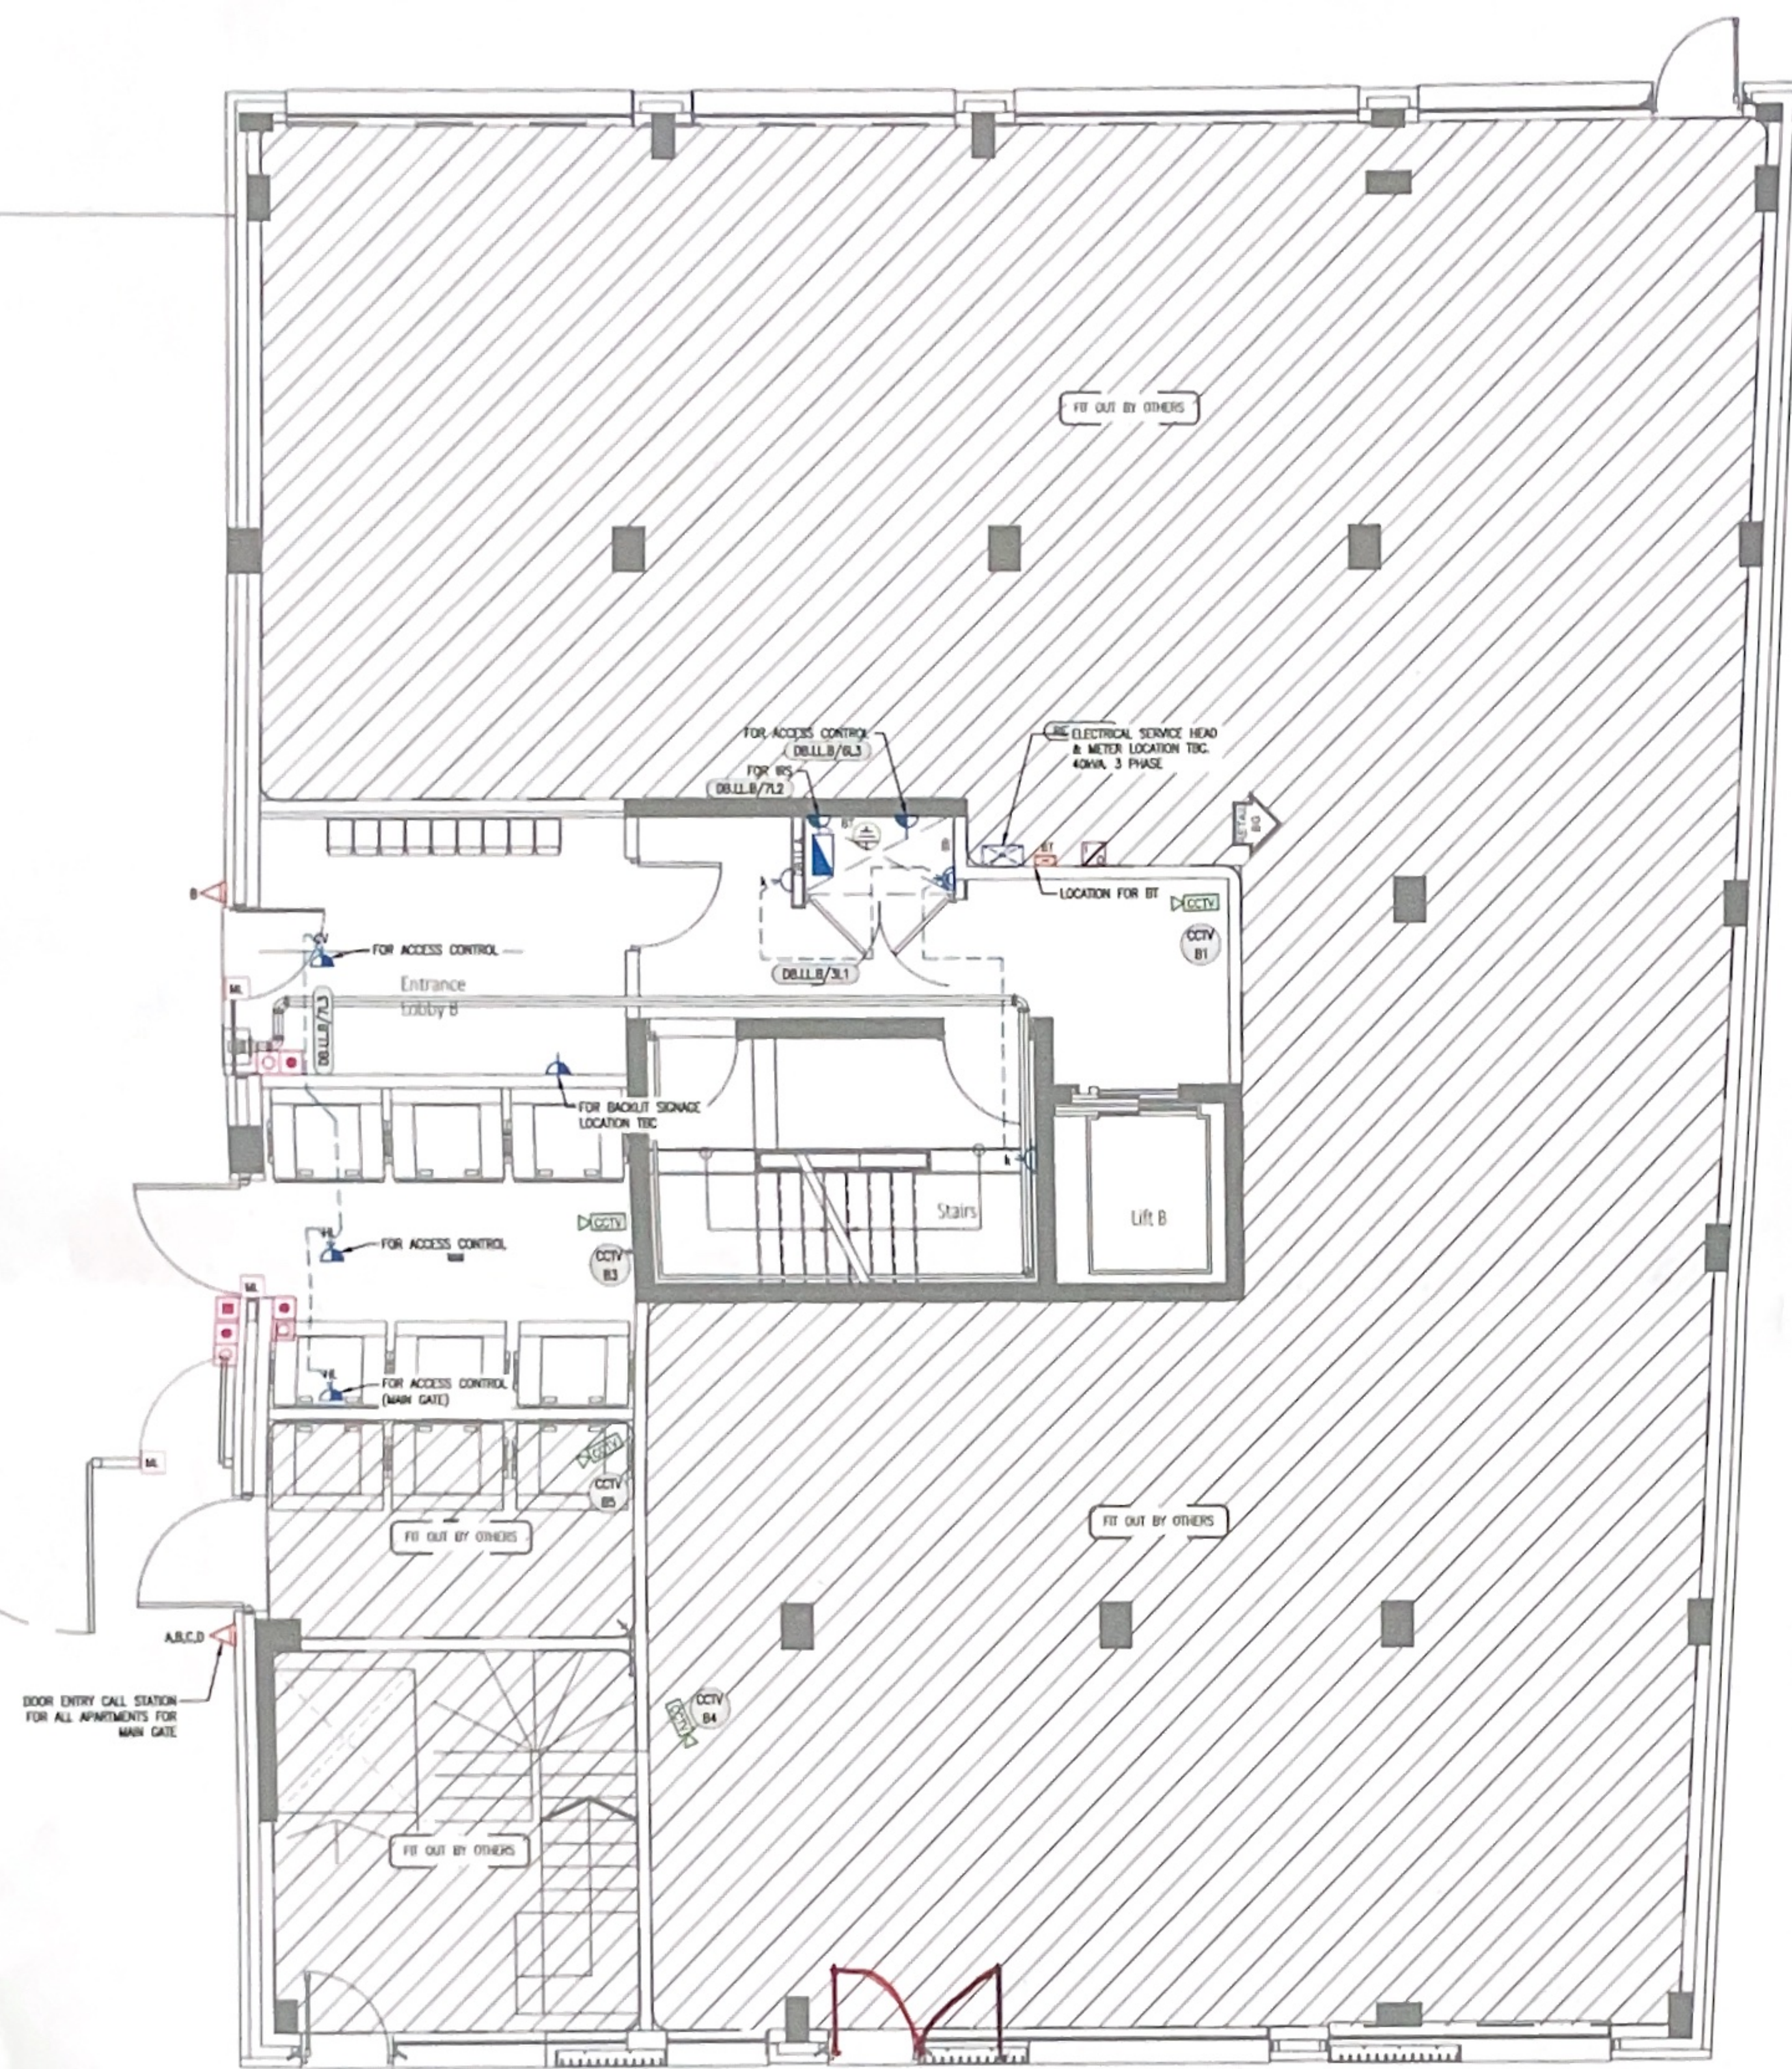

amended door opening

CORE B GROUND FLOOR SERVICES LAYOUT

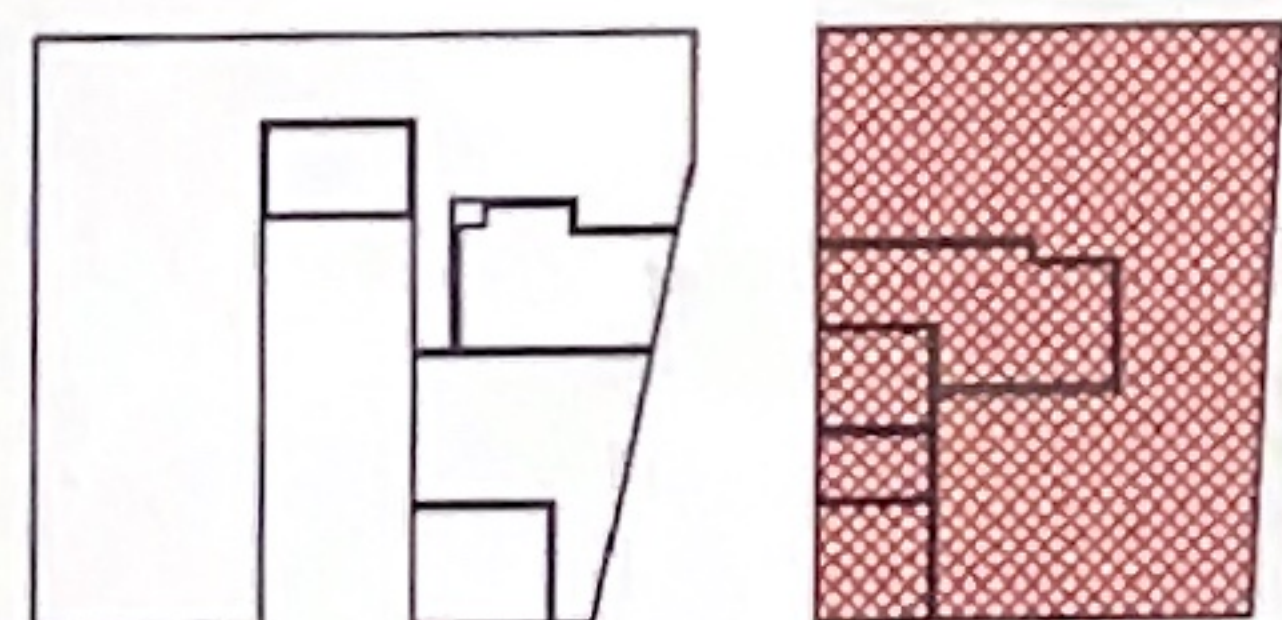

BLOCK A
BLOCK KEY PLAN

Status: AS BUILT

Client: CiField

DMO
MECHANICAL AND ELECTRICAL
ENGINEERING
27 Old Gloucester Street,
London, WC1N 3AX
0800 234 3443

Project Title: CROSS LANE,
HORNSEY, LONDON, N8 7AS

Drawn: RP Ck'd: D.O. Scale A1: 1:50
Issued Date: FEB 20

Title: BLOCK A - CORE B
GROUND FLOOR
SMALL POWER AND ACCESS CONTROL
LAYOUT

Drawing No. DMO-1400-63-GA-B-01 Revision: AB1

AB AS BUILT DRAWING	19.02.20	RP
Revisions	Date	Drn.