



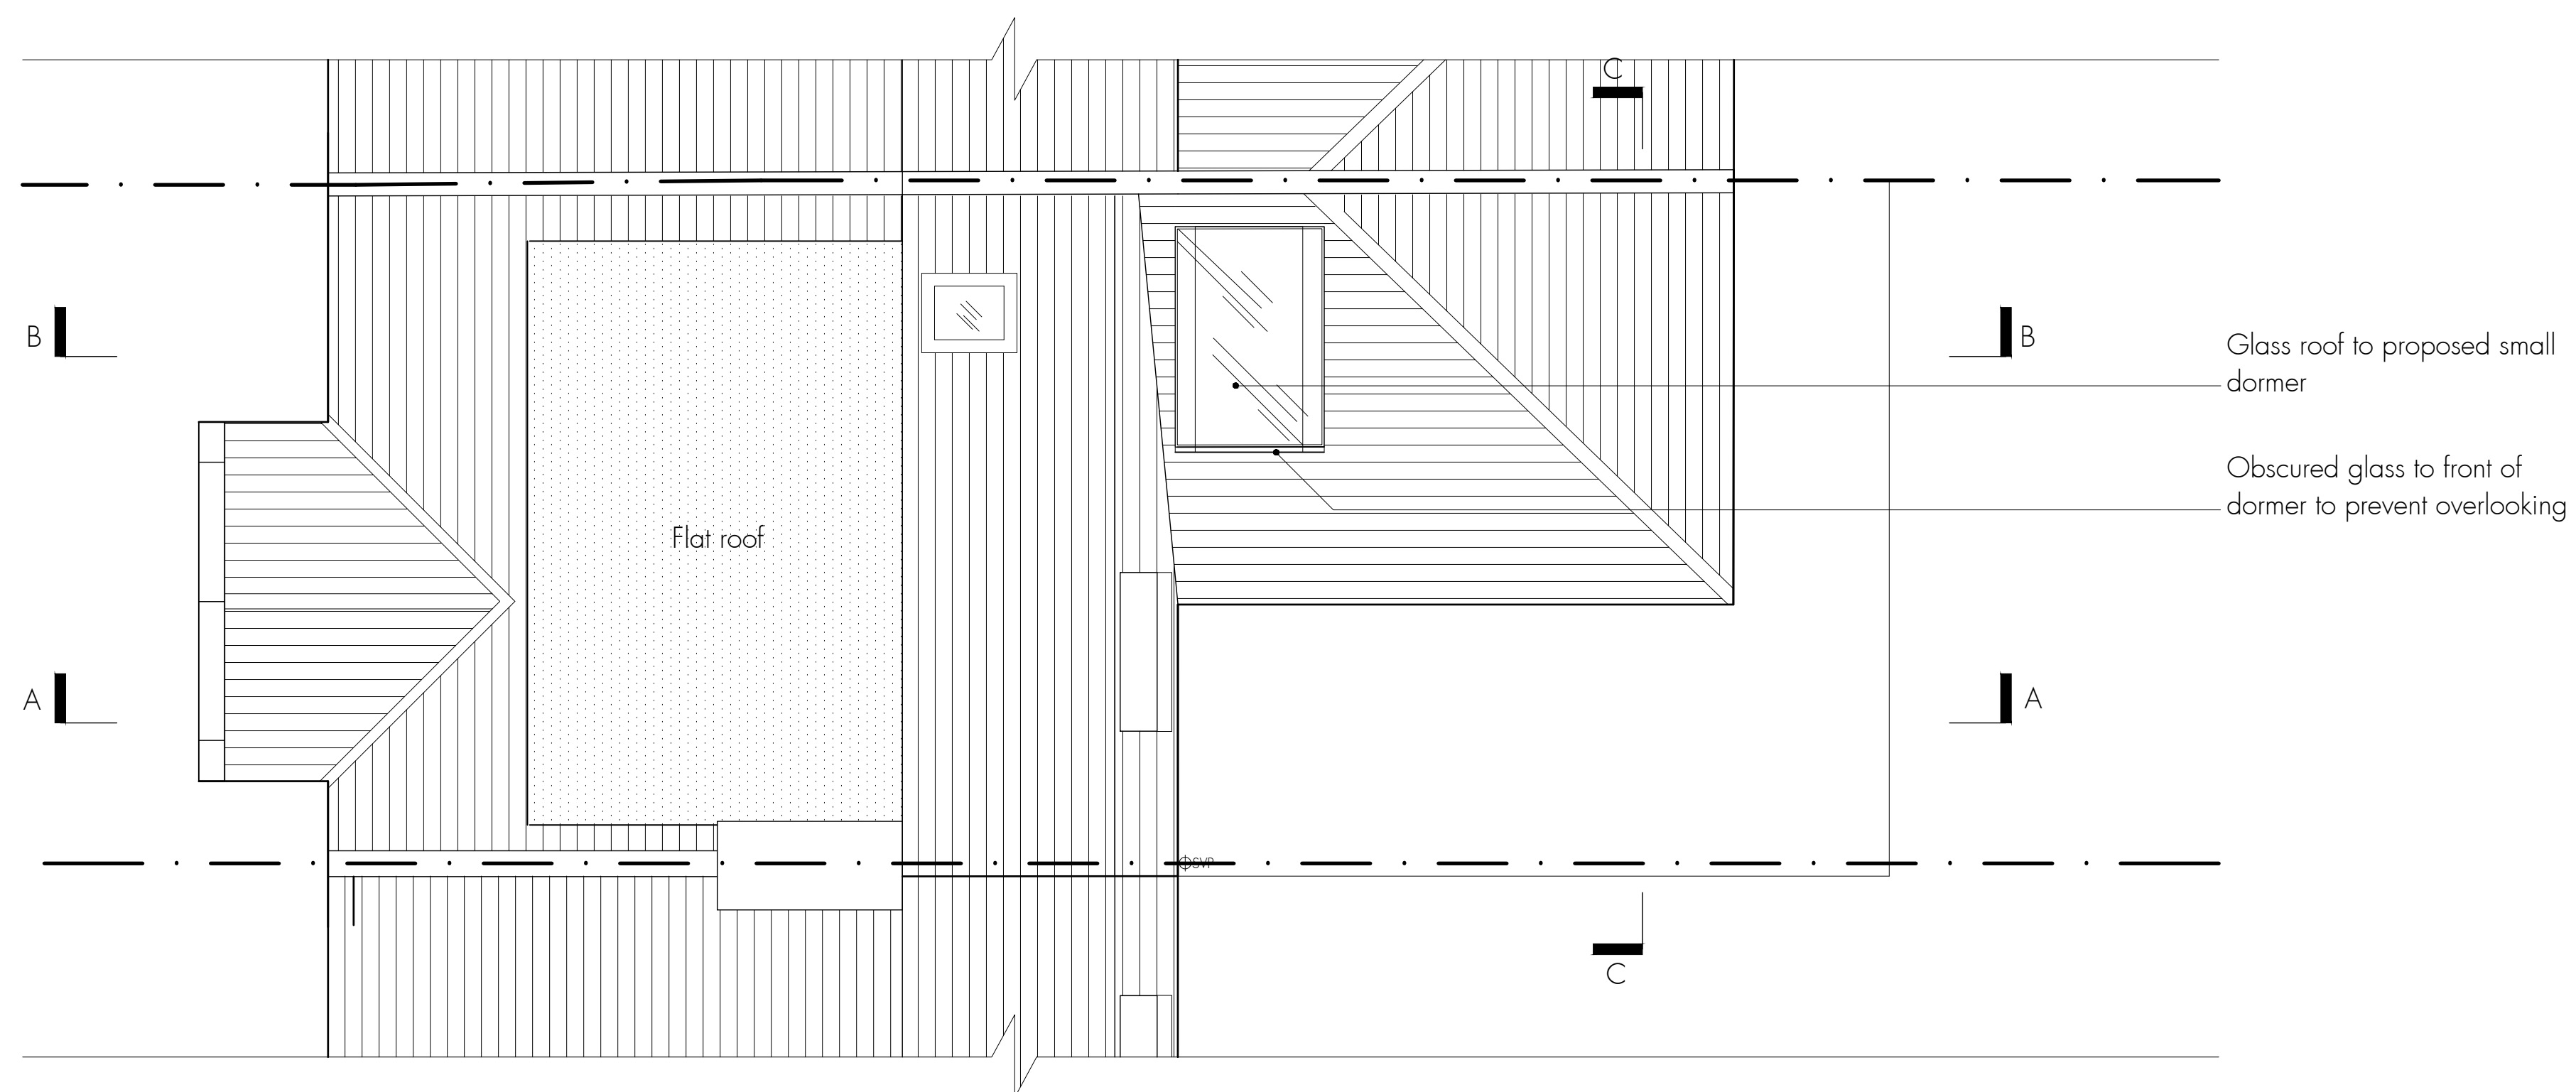

Roof Plan

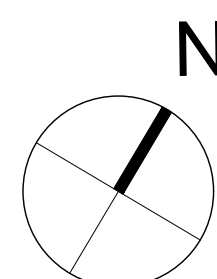

Do not scale off this drawing.

All indicated dimensions to be checked and verified on site by the Main Contractor before commencement of any fabrication drawings or work whatsoever on site.

Report all discrepancies to the Architect immediately.
This drawing is to be read in conjunction with all the related Architect's
and Structural Engineer's drawings, details and all relevant information.

rev.	rev. date	rev. description
------	-----------	------------------

tasou
associates architects + structural engineers

4 Armwell Street, London, EC1R 1UQ T:020 7713 7070 F:020 7713 7071 E:tasou@tasou.co.uk			
project 23 Birchington Road London N8 8HP			
drwg title EXISTING - AS BUILT Roof Plan			
date June 2020		drwg no. PP/03	
scale @ A1 1:50 (1:100 @A3)		job no. 1764	

© copyright of tasou associates



Report all discrepancies to the Architect immediately.
This drawing is to be read in conjunction with all the related Architect's
and Structural Engineer's drawings, details and all relevant information.

rev.	rev. date	rev. description
------	-----------	------------------

architects + structural engineers


project

23 Birchington Road
London
N8 8HP

EXISTING - AS BUILT
Section AA

date March 2020	dwg no. PP/04	rev. C
scale @ A1 1:50 (1:100 @A3)	job no. 1764	

© copyright of tasou associates

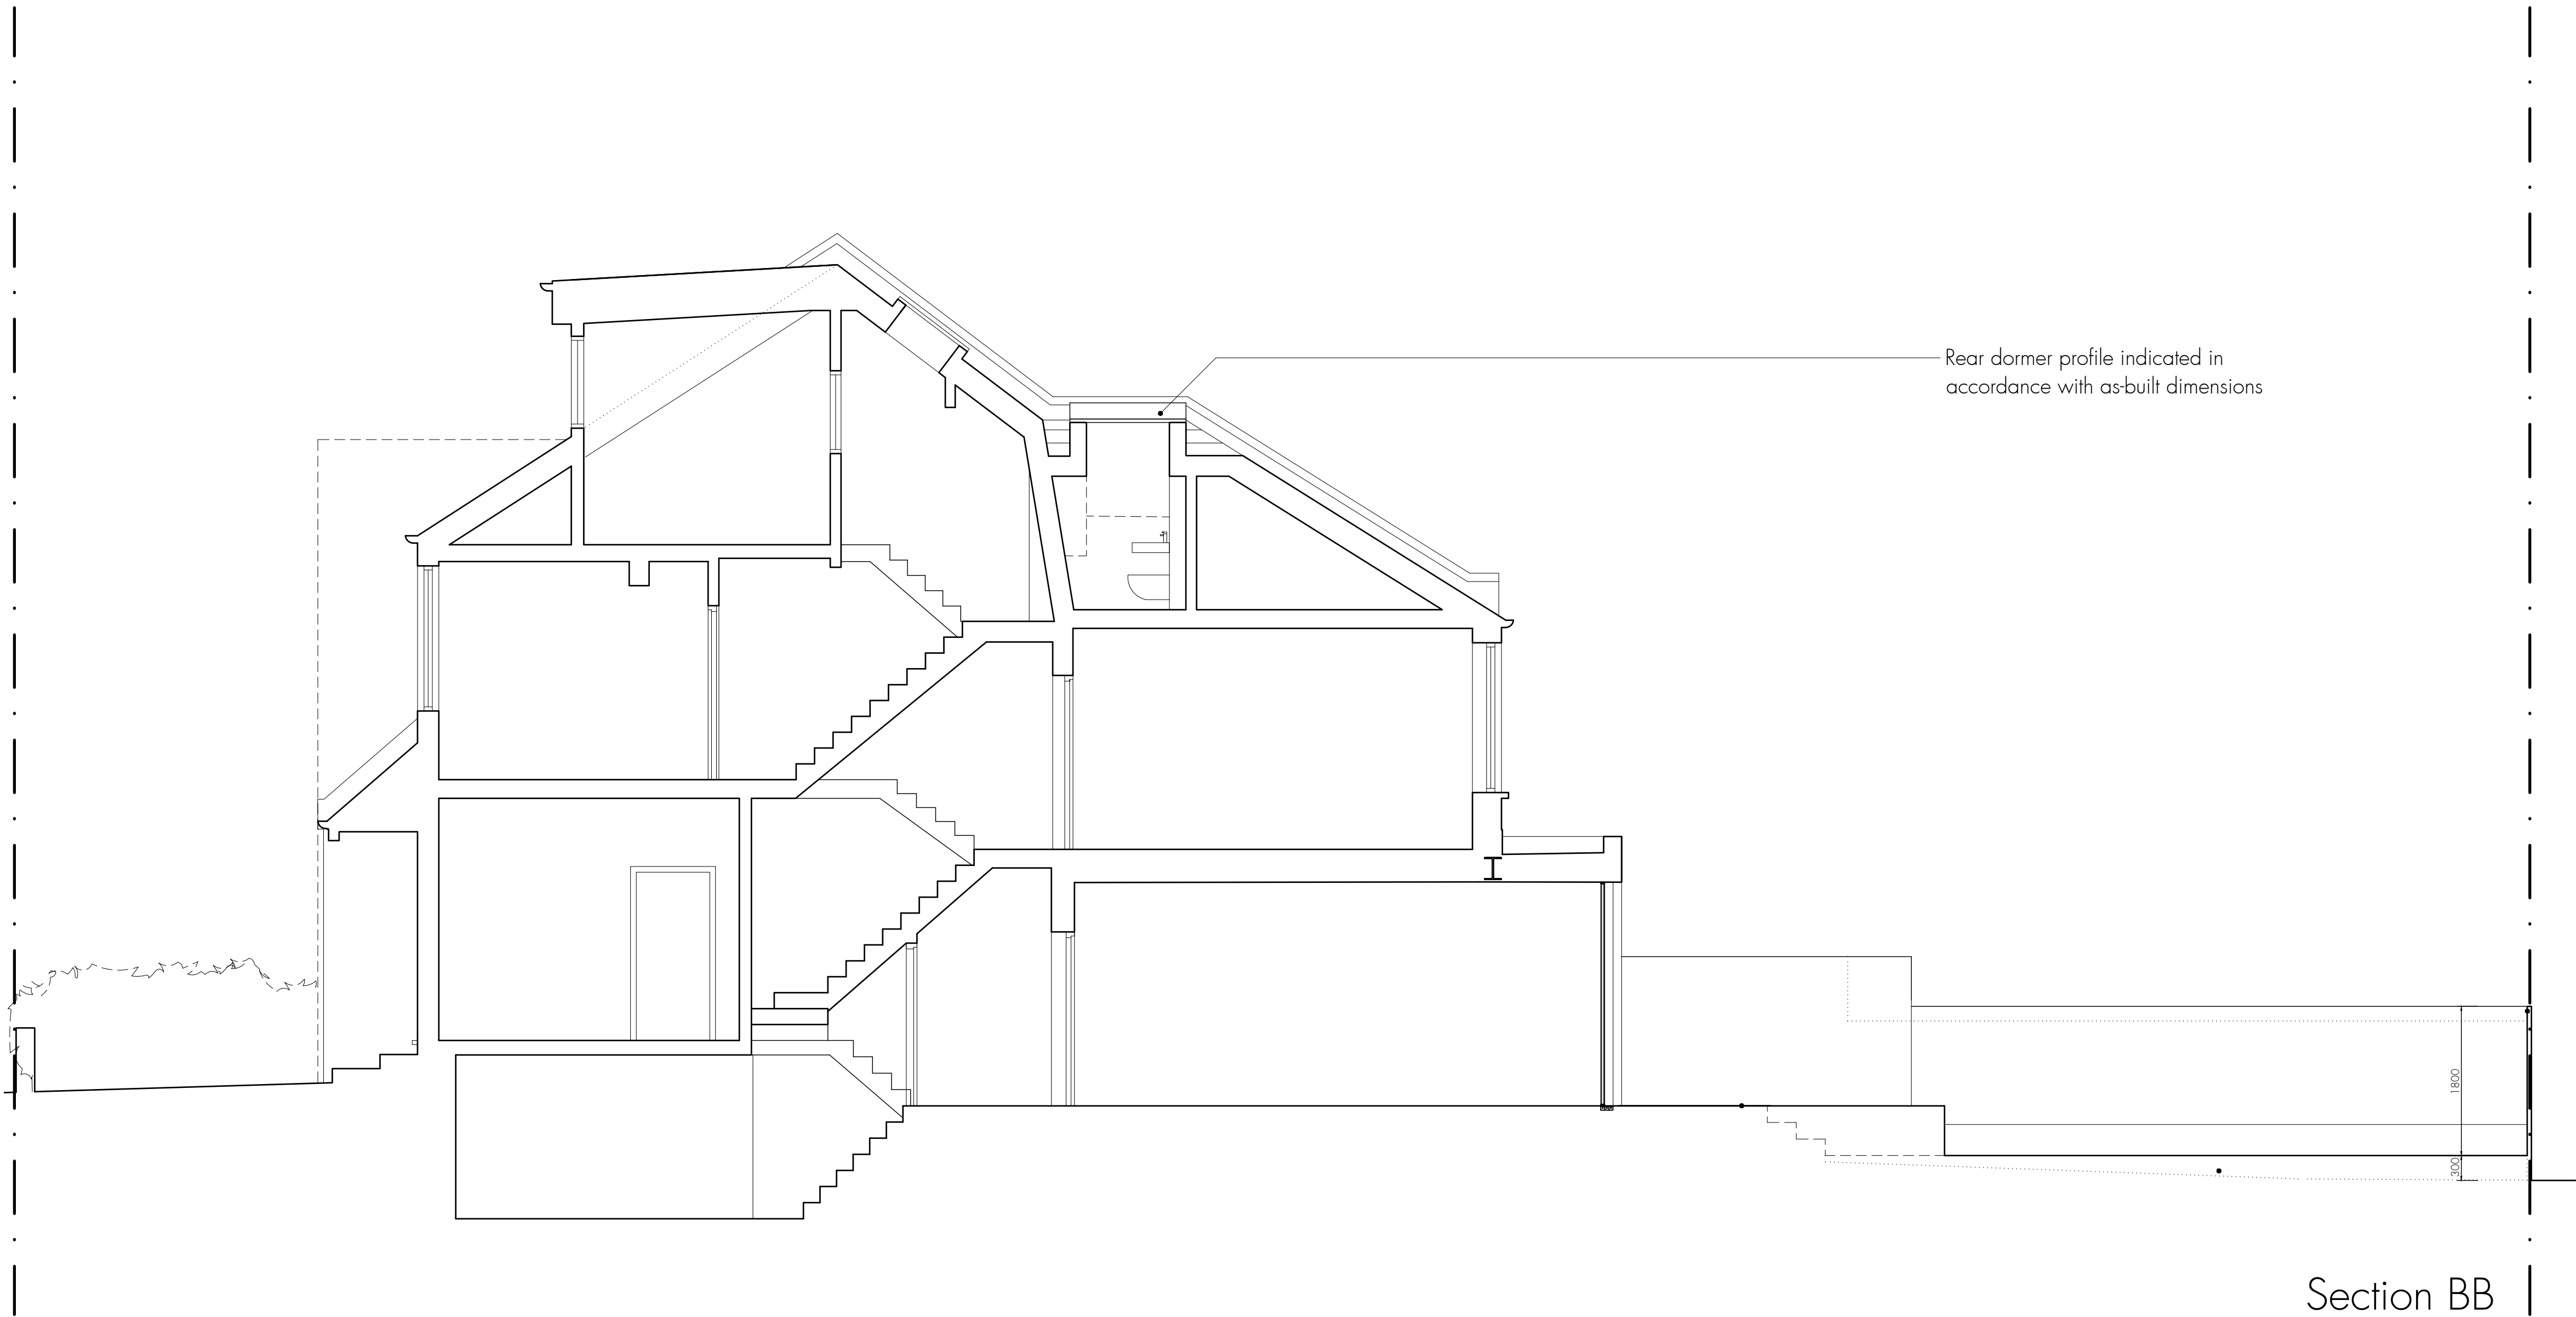

Section BB

Do not scale off this drawing.

All indicated dimensions to be checked and verified on site by the Main Contractor before commencement of any fabrication drawings or work whatsoever on site.

Report all discrepancies to the Architect immediately.

This drawing is to be read in conjunction with all the related Architect's and Structural Engineer's drawings, details and all relevant information.

C.	02.03.23	Rear dormer roof profile revised in accordance with as-built
B.	26.11.20	Proposed rear and side extension 225mm higher and rooflights to rear extension omitted
A.	16.09.20	Lawn level raised by no more than 300mm
rev.	rev. date	rev. description

tasou
associates

architects + structural engineers

4 Amwell Street, London. EC1R 1UG T:020 7713 7070 F:020 7713 7071 E:tasou@tasou.co.uk		
project 23 Birchington Road London N8 8HP		
dwg title EXISTING - AS BUILT Section BB		
date March 2020	dwg no. PP/05	rev. C
scale @ A1 1:50 (1:100 @A3)	job no. 1764	

