

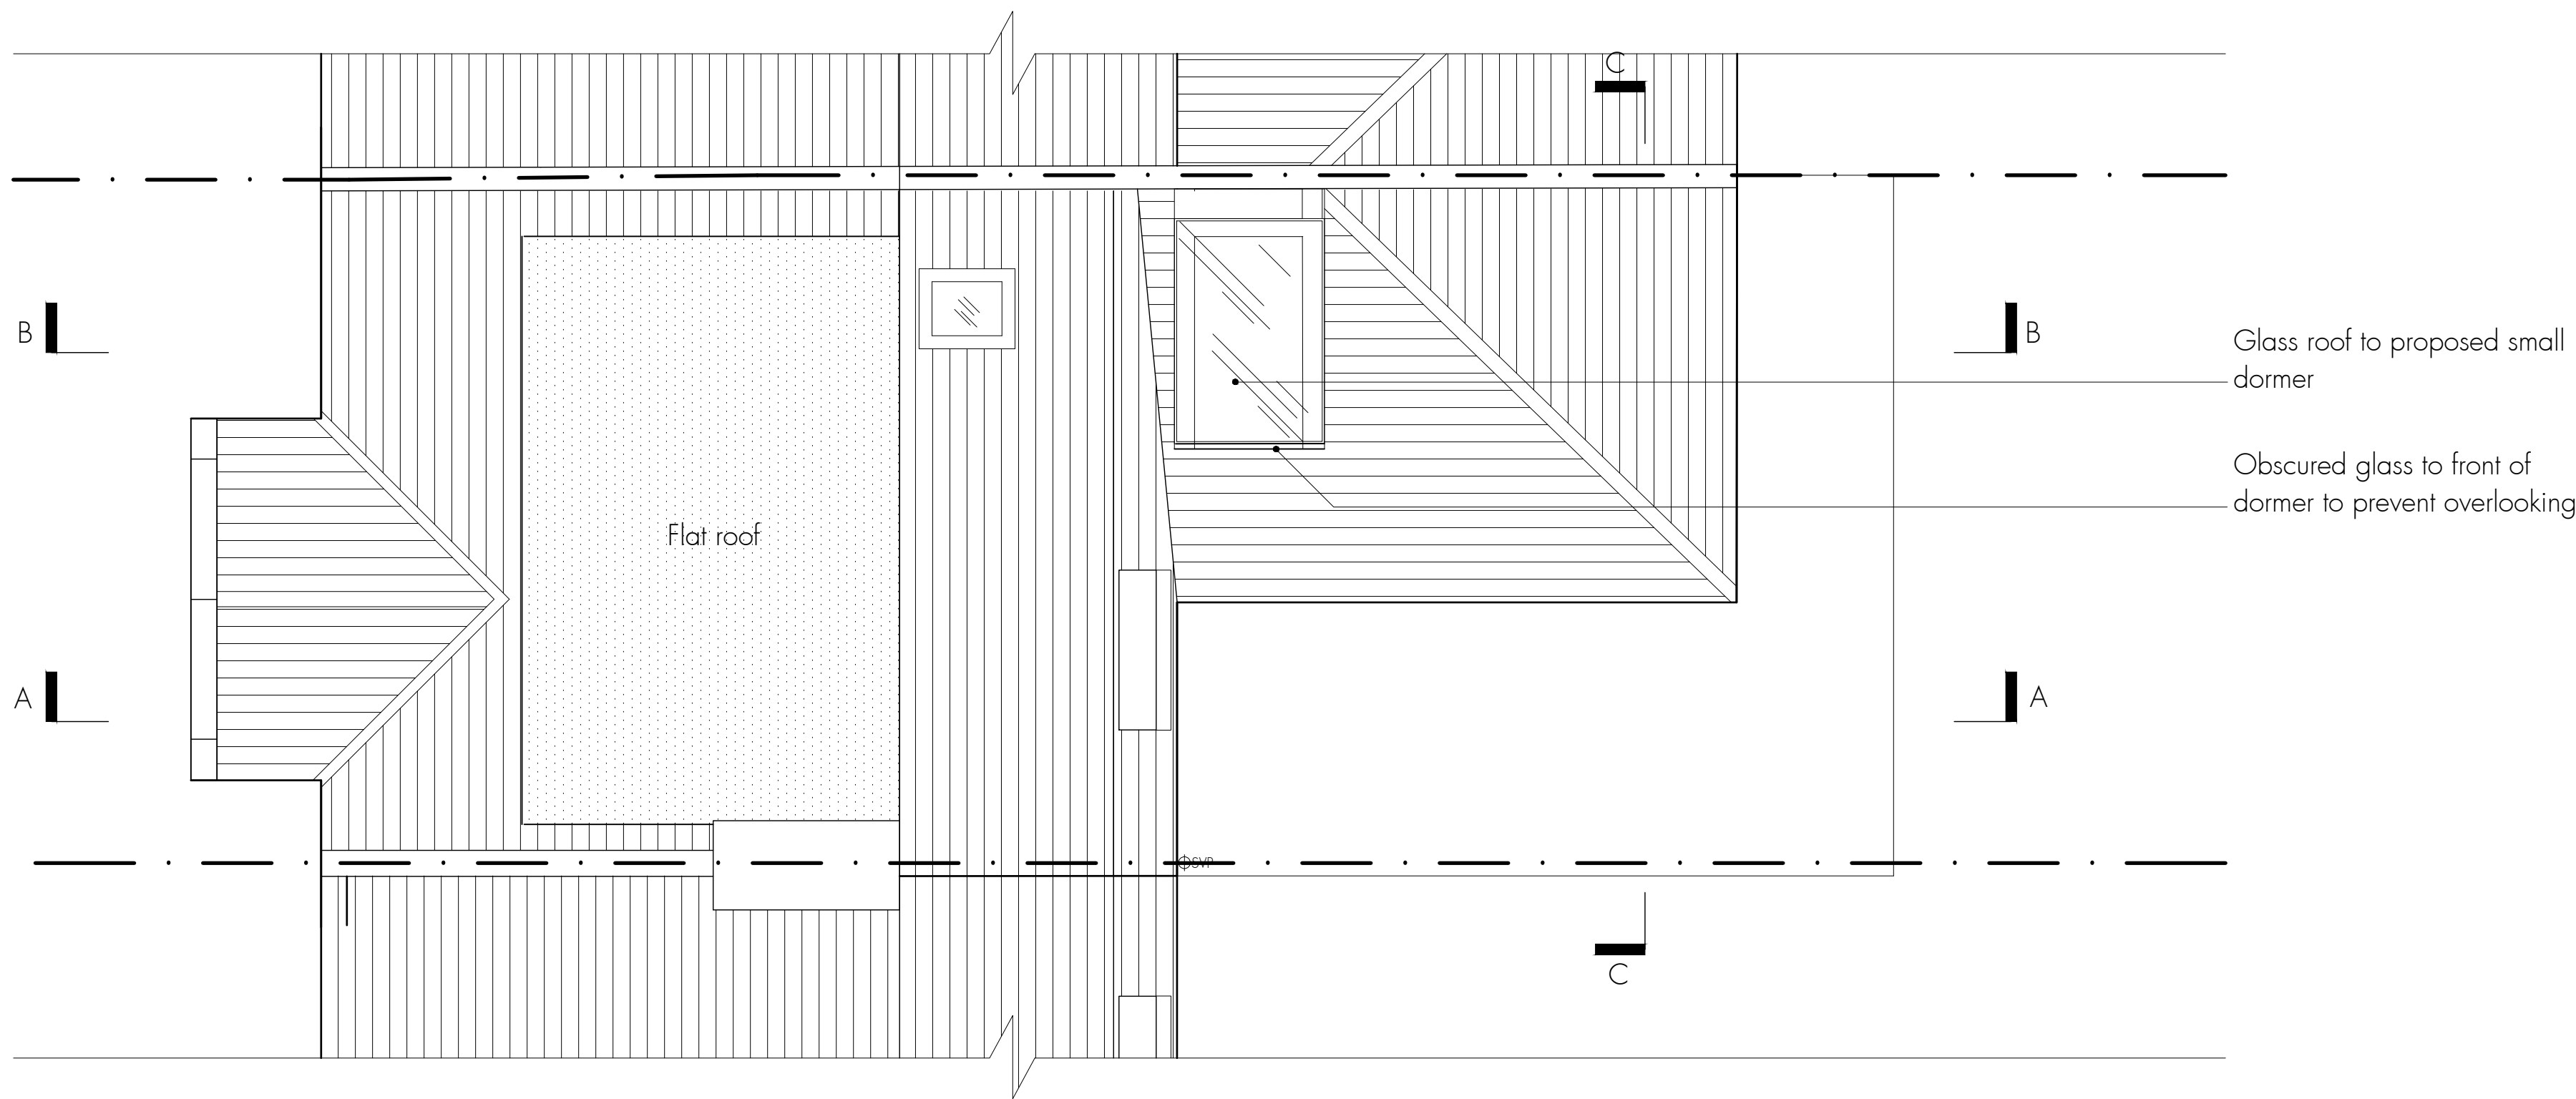


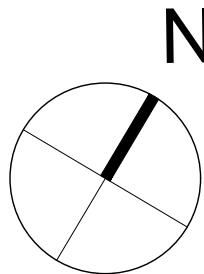

Roof Plan

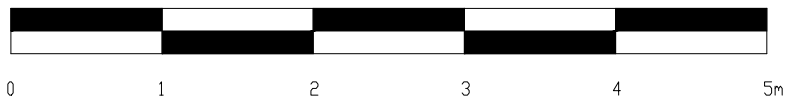

Do not scale off this drawing.

All indicated dimensions to be checked and verified on site by the Main Contractor before commencement of any fabrication drawings or work whatsoever on site.

Report all discrepancies to the Architect immediately.


This drawing is to be read in conjunction with all the related Architect's and Structural Engineer's drawings, details and all relevant information.

A.	16.09.20	Dormer extended back to party wall parapet
rev.	rev. date	rev. description

tasou
associates

architects + structural engineers

4 Amwell Street, London. EC1R 1UG T:020 7713 7070 F:020 7713 7071 E:tasou@tasou.co.uk		
project 23 Birchington Road London N8 8HP		
dwg title Proposed Drawings Roof Plan		
date June 2020	dwg no. PP/03	rev. A
scale @ A1 1:50 (1:100 @A3)	job no. 1764	

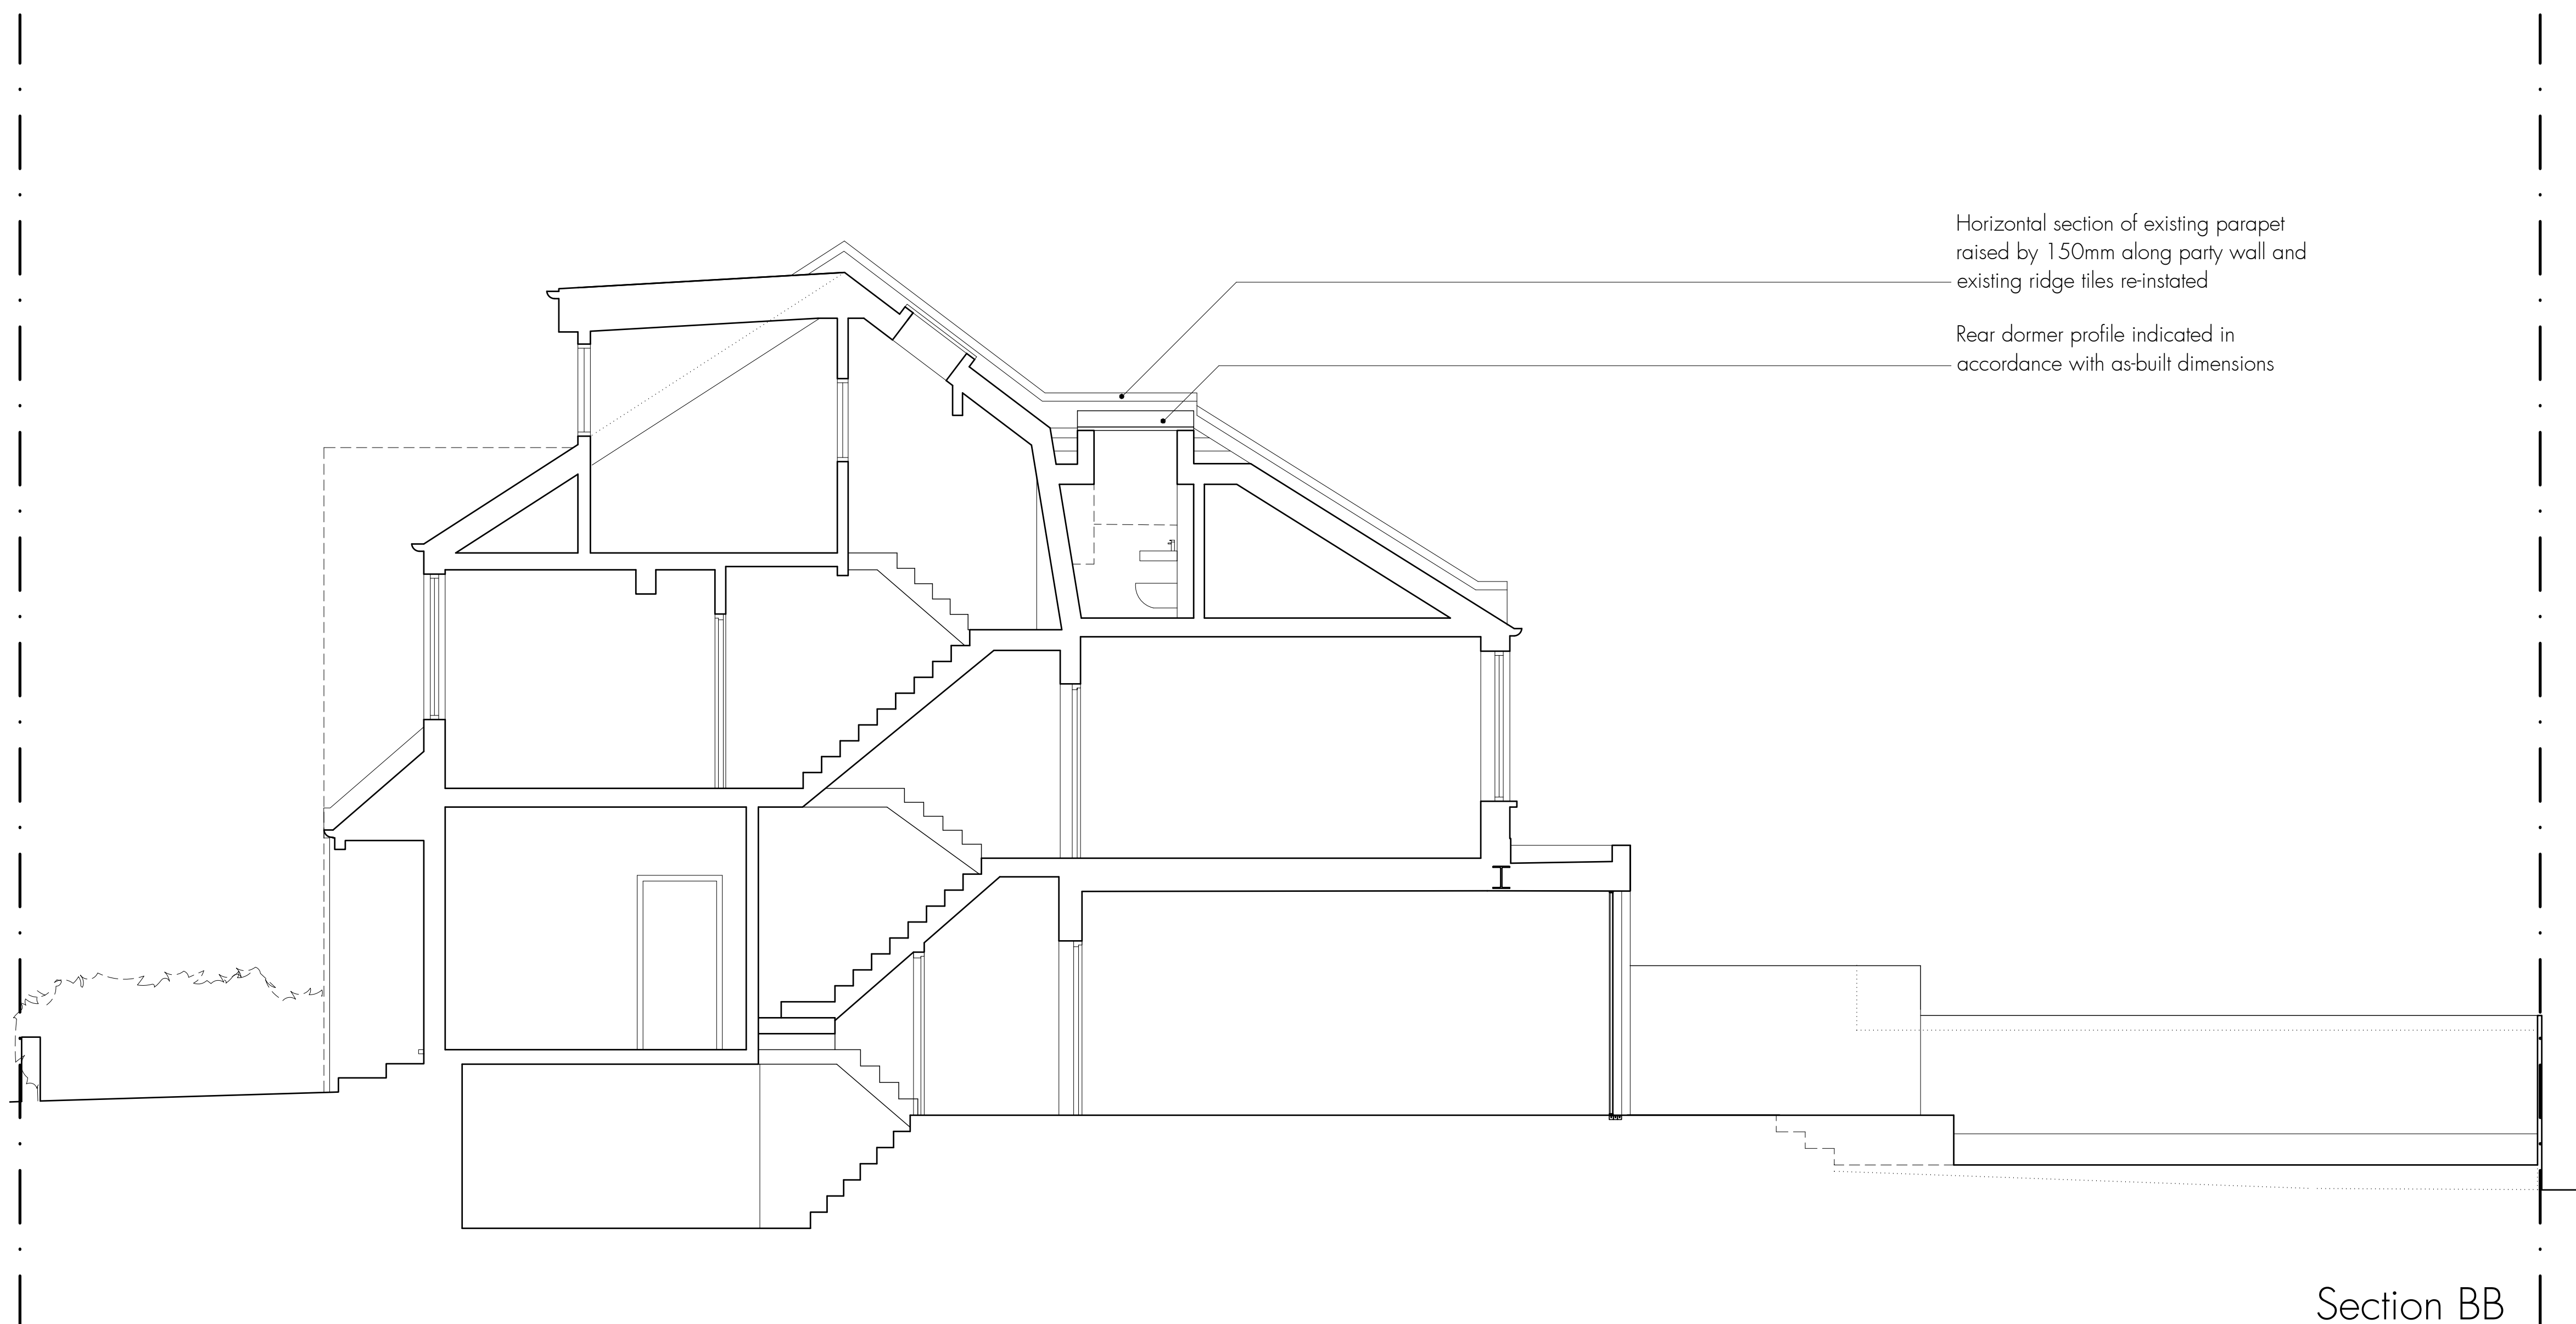

Section BB



Do not scale off this drawing.

All indicated dimensions to be checked and verified on site by the Main Contractor before commencement of any fabrication drawings or work whatsoever on site.

Report all discrepancies to the Architect immediately.
This drawing is to be read in conjunction with all the related Architect's
and Structural Engineer's drawings, details and all relevant information.

D.	02.03.23	Rear dormer roof profile revised in accordance with asbuilt
C.	02.03.23	Rear dormer roof profile revised in accordance with asbuilt
B.	26.11.20	Proposed rear and side extension 225mm higher and rooflights to rear extension omitted
A.	16.09.20	Lawn level raised by no more than 300mm
rev.	rev. date	rev. description

tasou
associates architects + structural engineers

4 Amwell Street, London, EC1R 1UG T:020 7713 7070 F:020 7713 7071 E:tasou@tasou.co.uk			
project			
23 Birchington Road London N8 8HP			
dwg title			
CURRENT PROPOSED Section BB			
date	dwg no.		rev.
March 2020	PP/05		D
scale of A1 1:50 (1:100 @A3)	job no.		1764

© copyright of tasou associates

