



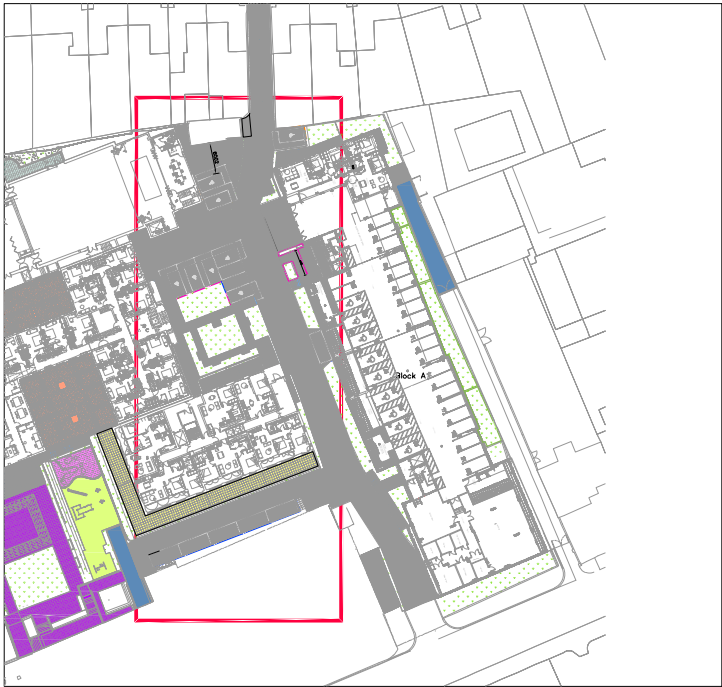


External Parking Bay Location GA

- Residential Accessible Bay
- Residential Standard Bay
- Accessible Visitor Bay


External parking bays to include..
8 Residential Standard Bays
5 Residential Accessible Bays
3 Accessible Visitor Bays
Quantities are in addition to Block A
Basement Level Parking which include.
23 Residential Standard Bays
9 Residential Accessible Bays

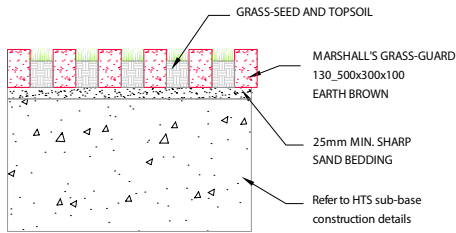


GRASS-GUARD PARKING BAY
CONSTRUCTION WITH REGULAR
VEHICULAR LOADING

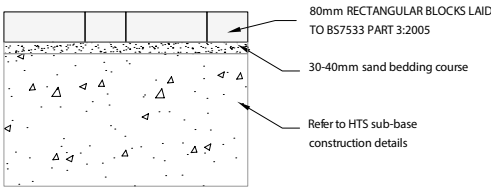

CONCRETE BLOCK PAVING
CONSTRUCTION WITH REGULAR
VEHICULAR LOADING

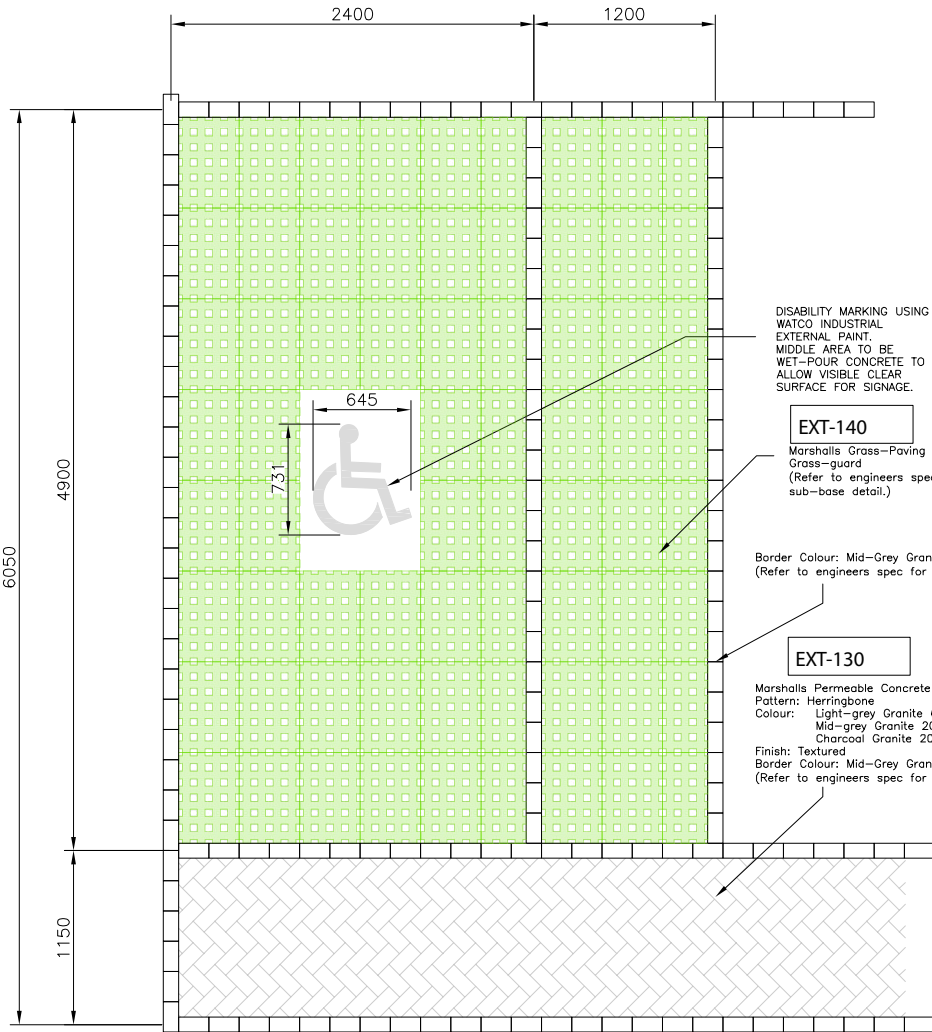

1:50 - Typ. Disabled Parking Bay

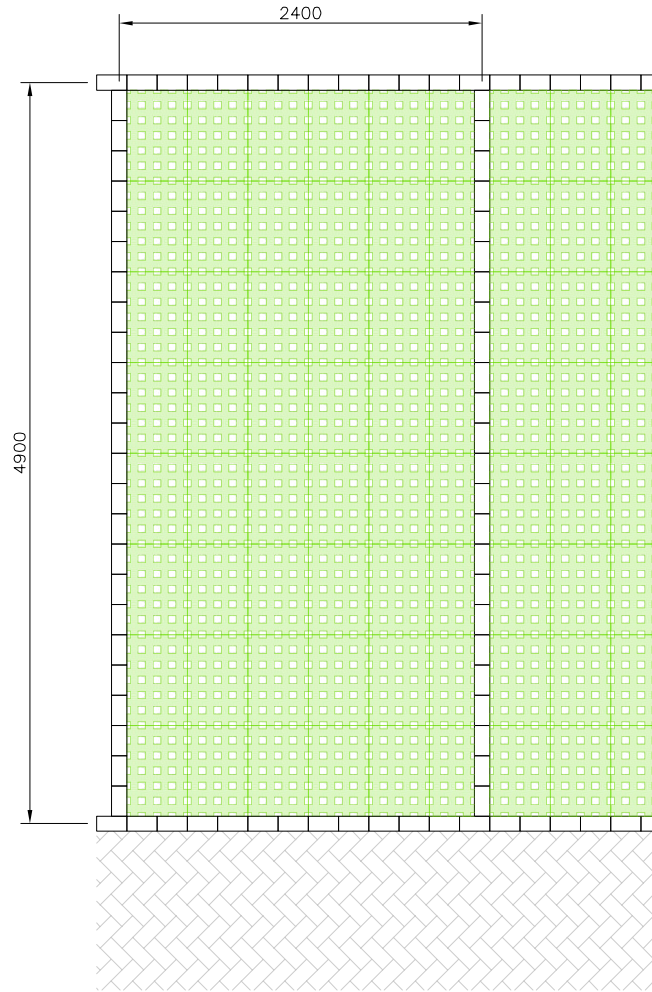

1:50 - Typ. Standard Parking Bay

Parallel parking adjacent to library to be 2.4x6m to allow clear access and maneuverability.



LIGHT-GREY - TEXTURED



MID-GREY - TEXTURED



CHARCOAL GREY - TEXTURED



GRASS-GUARD BLOCK

Notes:

1. THE COPYRIGHT OF THIS DRAWING IS VESTED IN GREENSIDE LANDSCAPES AND IT MAY NOT BE REPRODUCED IN WHOLE OR PART OR USED FOR THE MANUFACTURE OF ANY ARTICLE WITHOUT THE EXPRESS PERMISSION OF THE COPYRIGHT HOLDERS.
2. WORK TO FIGURED DIMENSIONS ONLY.
3. THIS DRAWING IS TO BE READ IN CONJUNCTION WITH ALL RELEVANT ARCHITECT'S, SERVICE ENGINEER'S AND GREENSIDE LANDSCAPES SPECIFICATIONS.

AB	AS BUILT	LF	12.10.22
C02	Access parking bays relocated	LF	20.11.20
P01	Bay added to Library Wall area	LF	11.09.20
REV:	DESCRIPTION:	BY:	DATE:
STATUS: AS BUILT			

GREENSIDE
LANDSCAPES

Unit 45, Golds Business Park, Jenkins Drive, Elsenham, Essex, CM22 6JX

CLIENT:

ARCHITECT:

SITE:

Hornsey Town Hall

TITLE: Typical Parking Application and Detail

SCALE AT A3: 1: 50	DATE: 16.07.20	DRAWN: LF	CHECKED:
PROJECT NO: HTH_20	DRAWING NO: GSL_P2.01_002	REVISION:	AB