


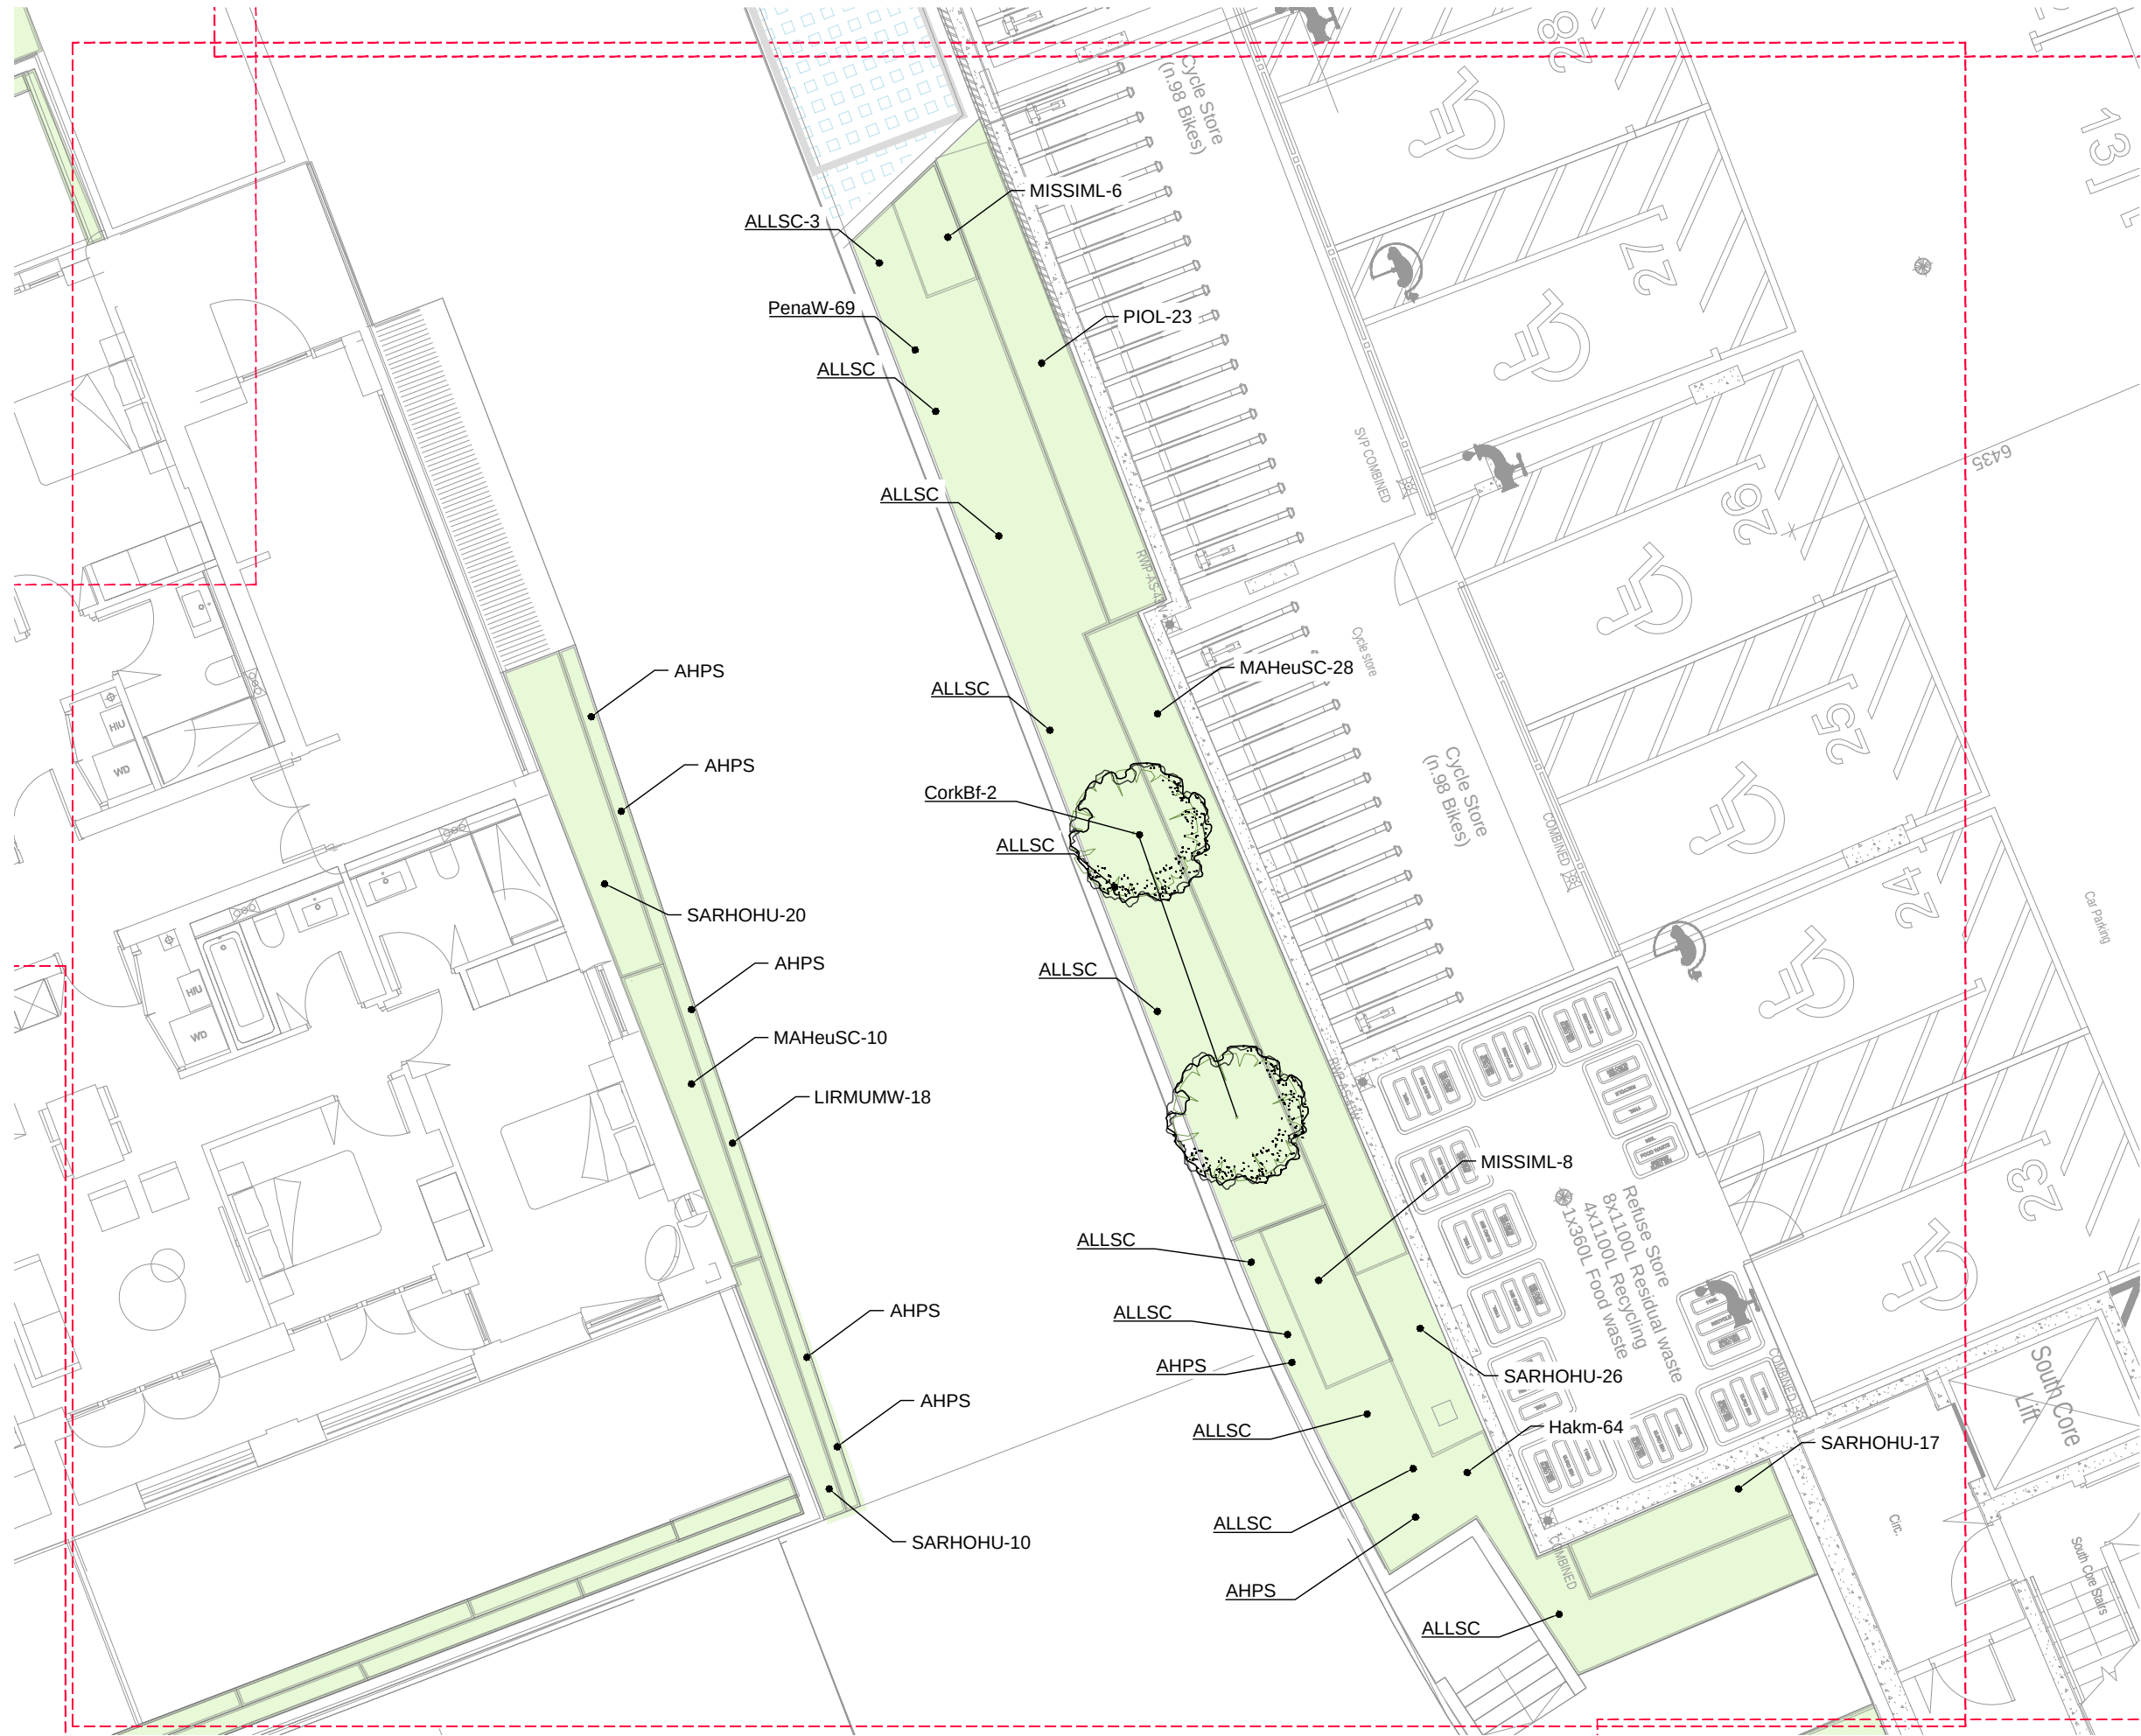

Notes:

1. THE COPYRIGHT OF THIS DRAWING IS VESTED IN GREENSIDE LANDSCAPES AND IT MAY NOT BE REPRODUCED IN WHOLE OR PART OR USED FOR THE MANUFACTURE OF ANY ARTICLE WITHOUT THE EXPRESS PERMISSION OF THE COPYRIGHT HOLDERS.
2. WORK TO FIGURED DIMENSIONS ONLY.
3. THIS DRAWING IS TO BE READ IN CONJUNCTION WITH ALL RELEVANT ARCHITECT'S, SERVICE ENGINEER'S AND GREENSIDE LANDSCAPES SPECIFICATIONS.

AB	AS BUILT	LF	12.10.22
C02	Amended to suit Outerspace plans	LF	07.07.22
C01	Plant Quantities added	LF	03.02.22
REV:	DESCRIPTION:	BY:	DATE:
STATUS:		AS BUILT	

GREENSIDE
LANDSCAPES

Unit 45, Golds Business Park, Jenkins Drive, Elsenham, Essex, CM22 6JX

CLIENT: Ardmore Construction

ARCHITECT:

SITE: Hornsey Town Hall

TITLE: Block B East-Block A West
Planting Layout

SCALE AT A3: 1:100	DATE: 16.02.21	DRAWN: LF	CHECKED:
PROJECT NO: HTH-20	DRAWING NO: GSL-P4.01-008	REVISION:	AB