

general notes:  
do not scale from the drawing. all dimensions shall be checked on site prior to commencing works.  
all works shall conform to the current edition of the building regulations and other relevant statutory requirements.  
all materials and workmanship shall conform with the relevant british standard specifications and codes of practice.  
this drawing is the copyright of gdm architects and shall not be copied or reproduced without permission.  
this drawing shall be read in conjunction with gdm architect's health and safety risk assessments and all works shall be carried out in a safe manner, by competent persons.  
drawing produced by gdm architects ltd trading as gdm architects.

0m 0.4m 0.8m 1.2m 1.6m 2m  
VISUAL SCALE 1:20 @ A0

Louvred doors and over panel to achieve 2.25m<sup>2</sup> minimum total aerodynamic free area.

Provide a rubber door threshold to prevent water ingress.


Provide signage to indicate 2.5m maximum clearance height.

All frames and louvres PPC Dark Grey RAL 7016


Secured by design B15, M3 to M10



4 Bury Road Vehicular entrance

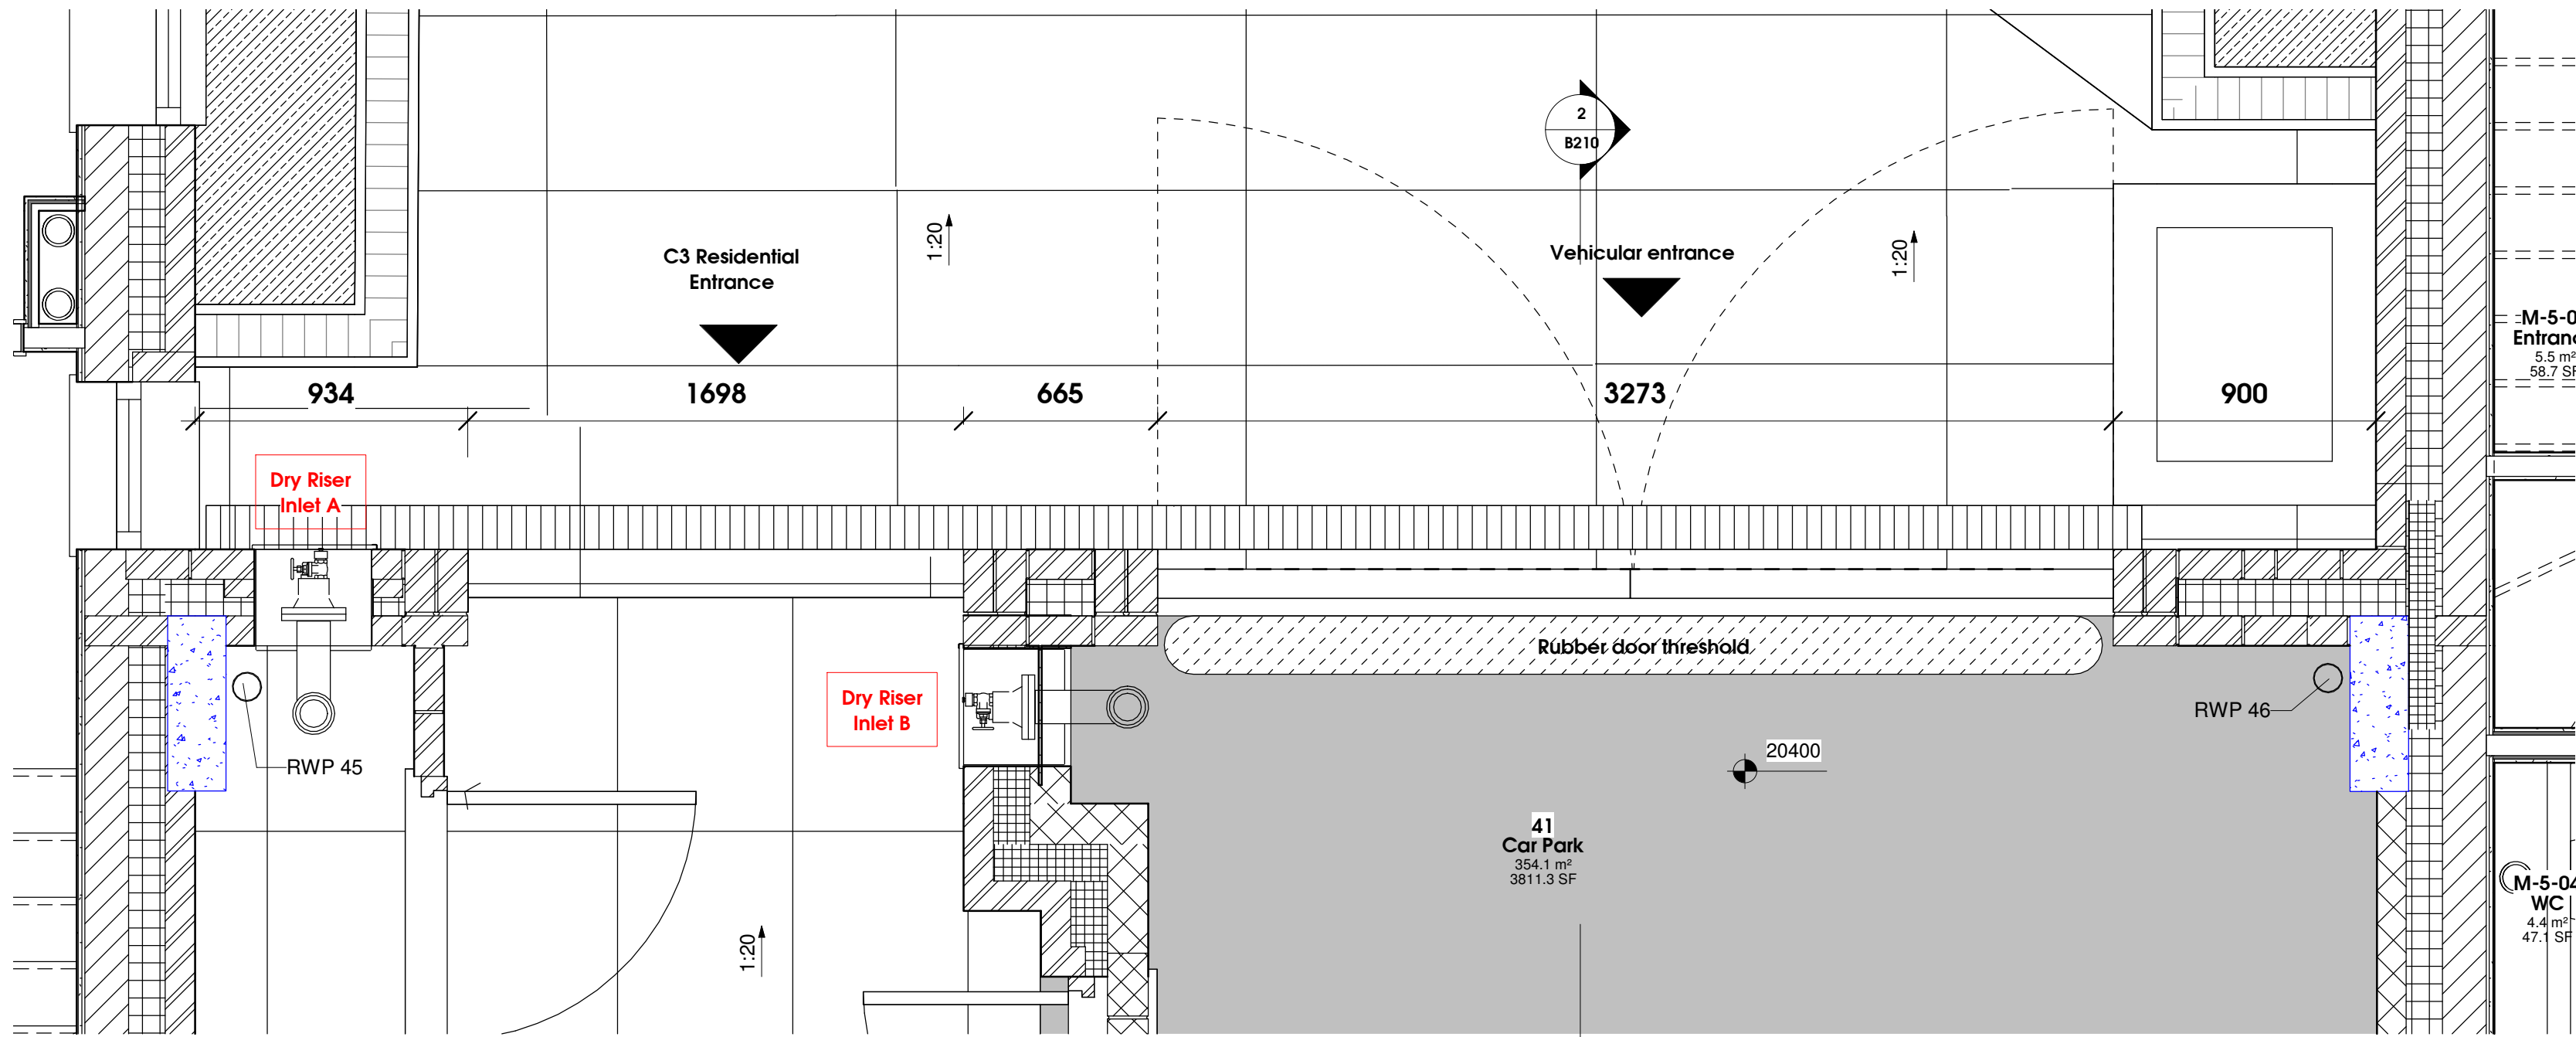


0 Vehicular Entrance Plan  
1 : 20

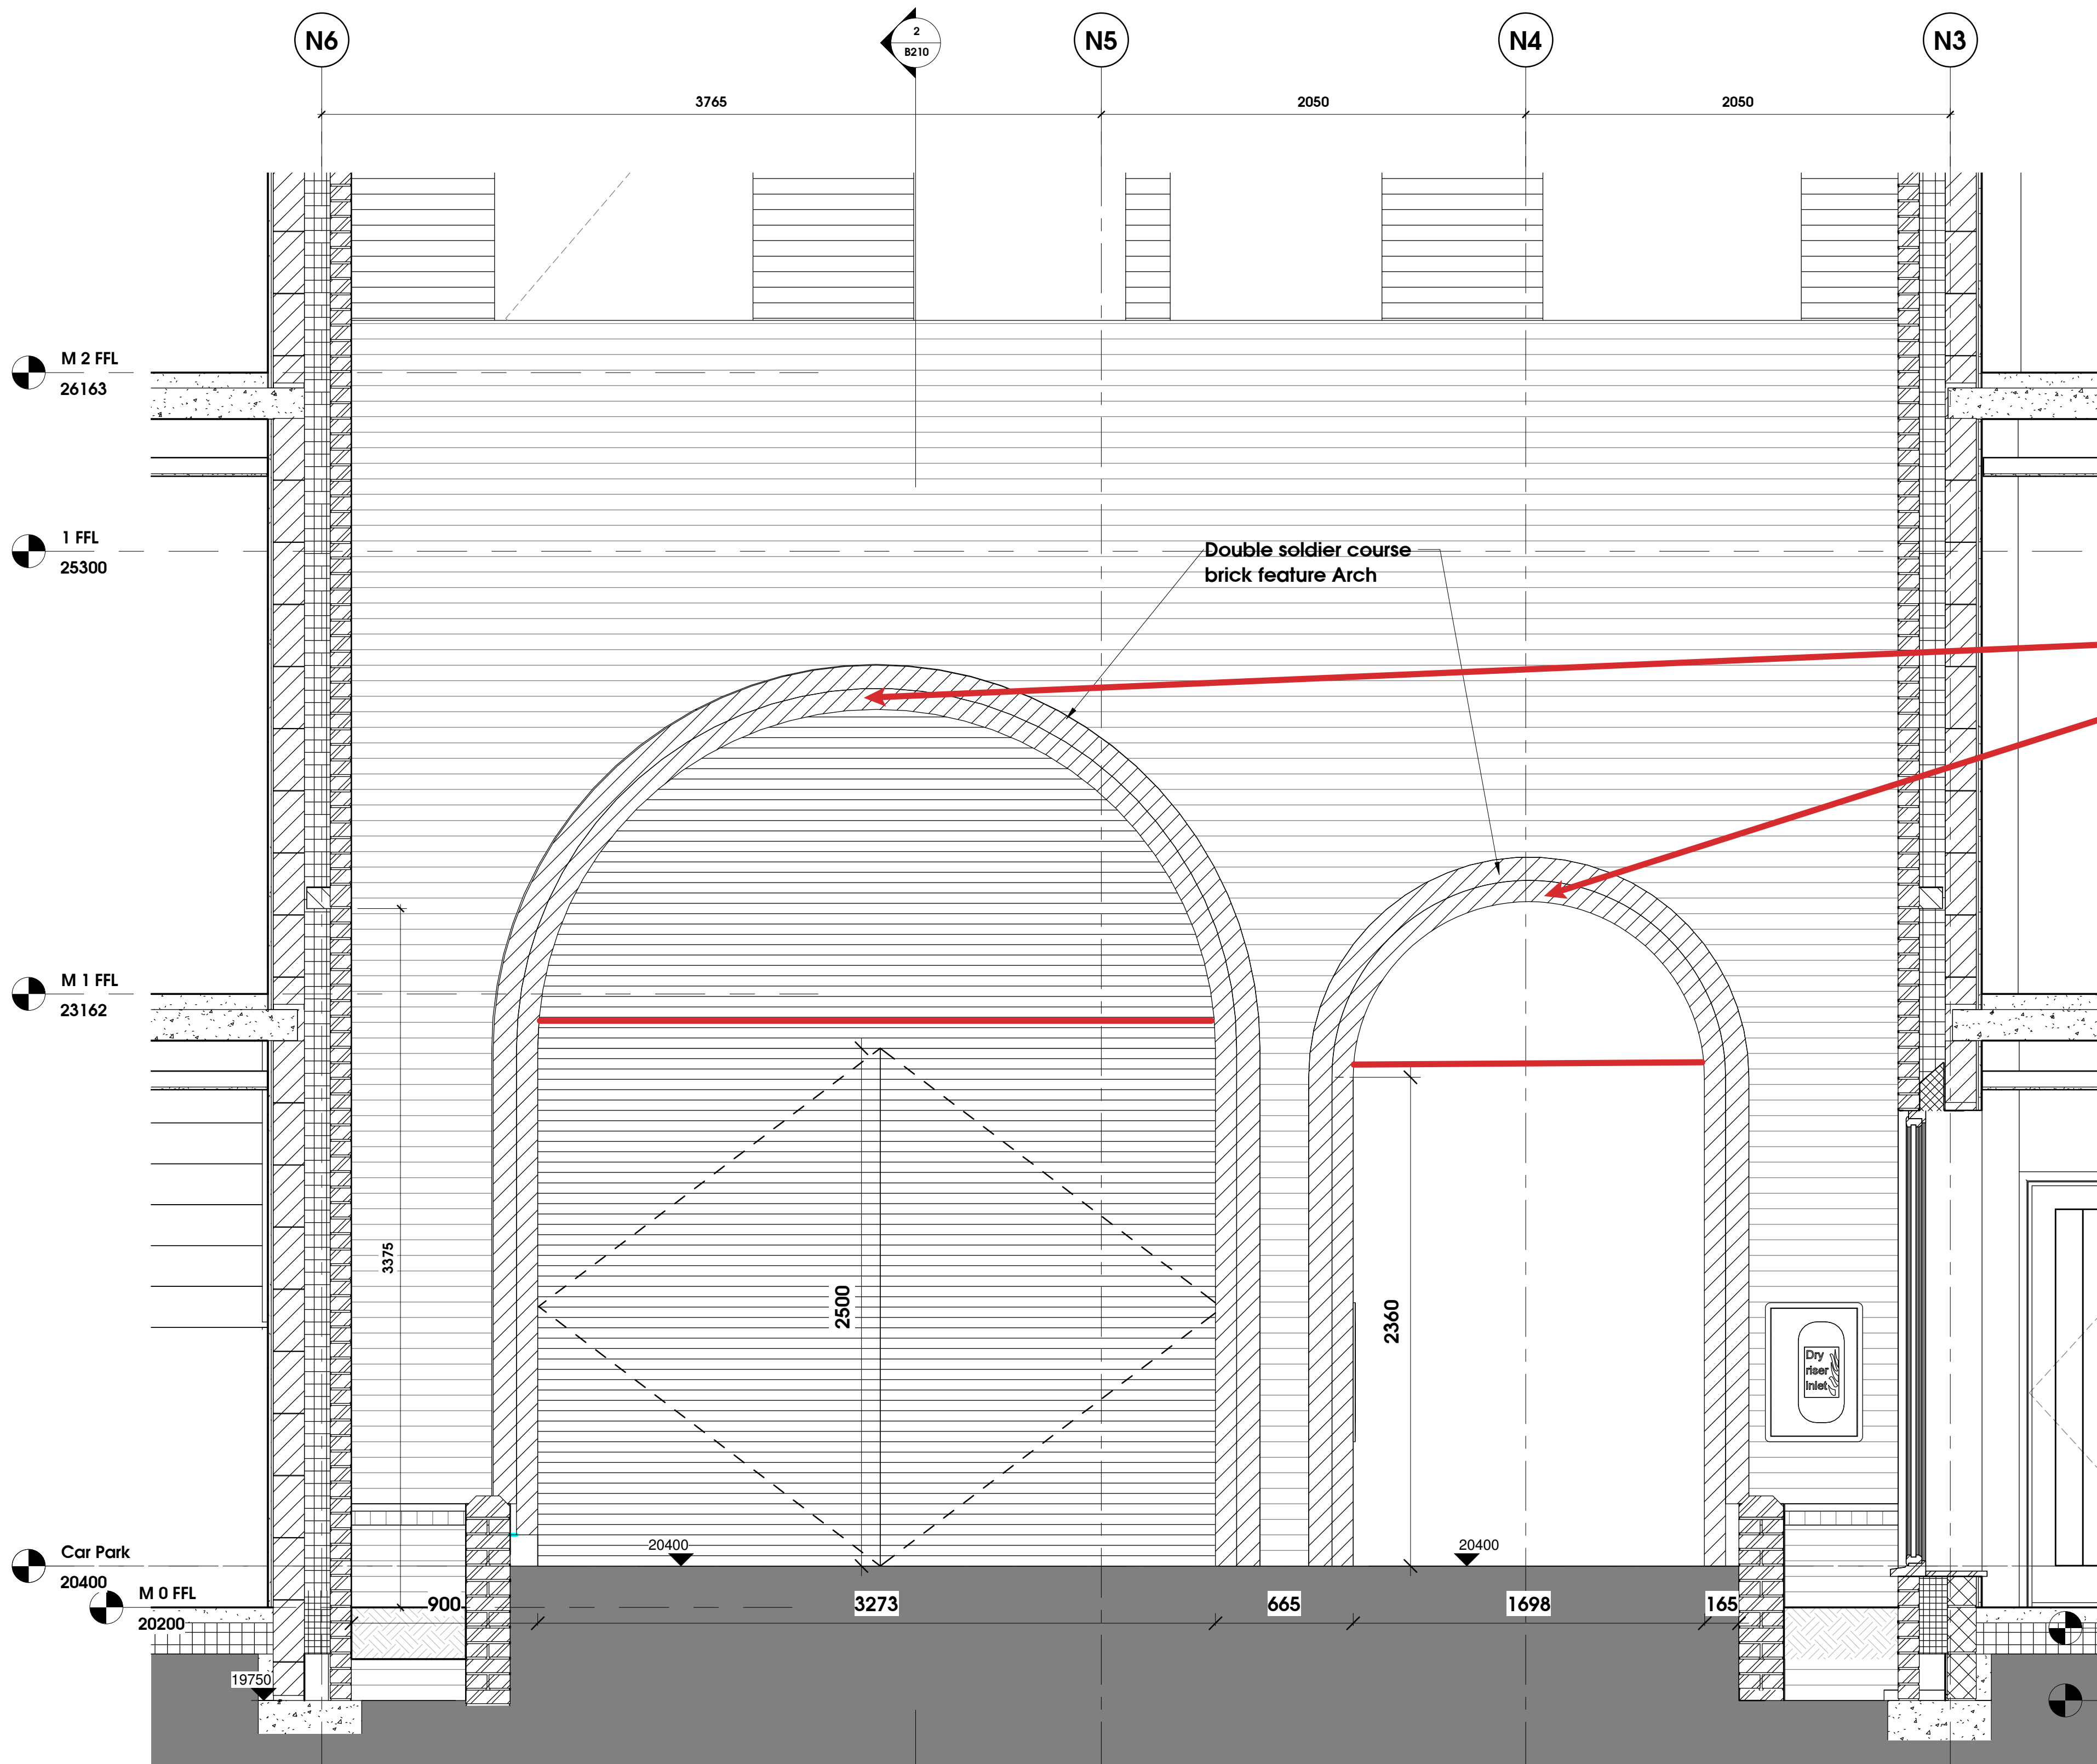

3 North Vehicular entrance  
1 : 20

Please provide radius for the arches.

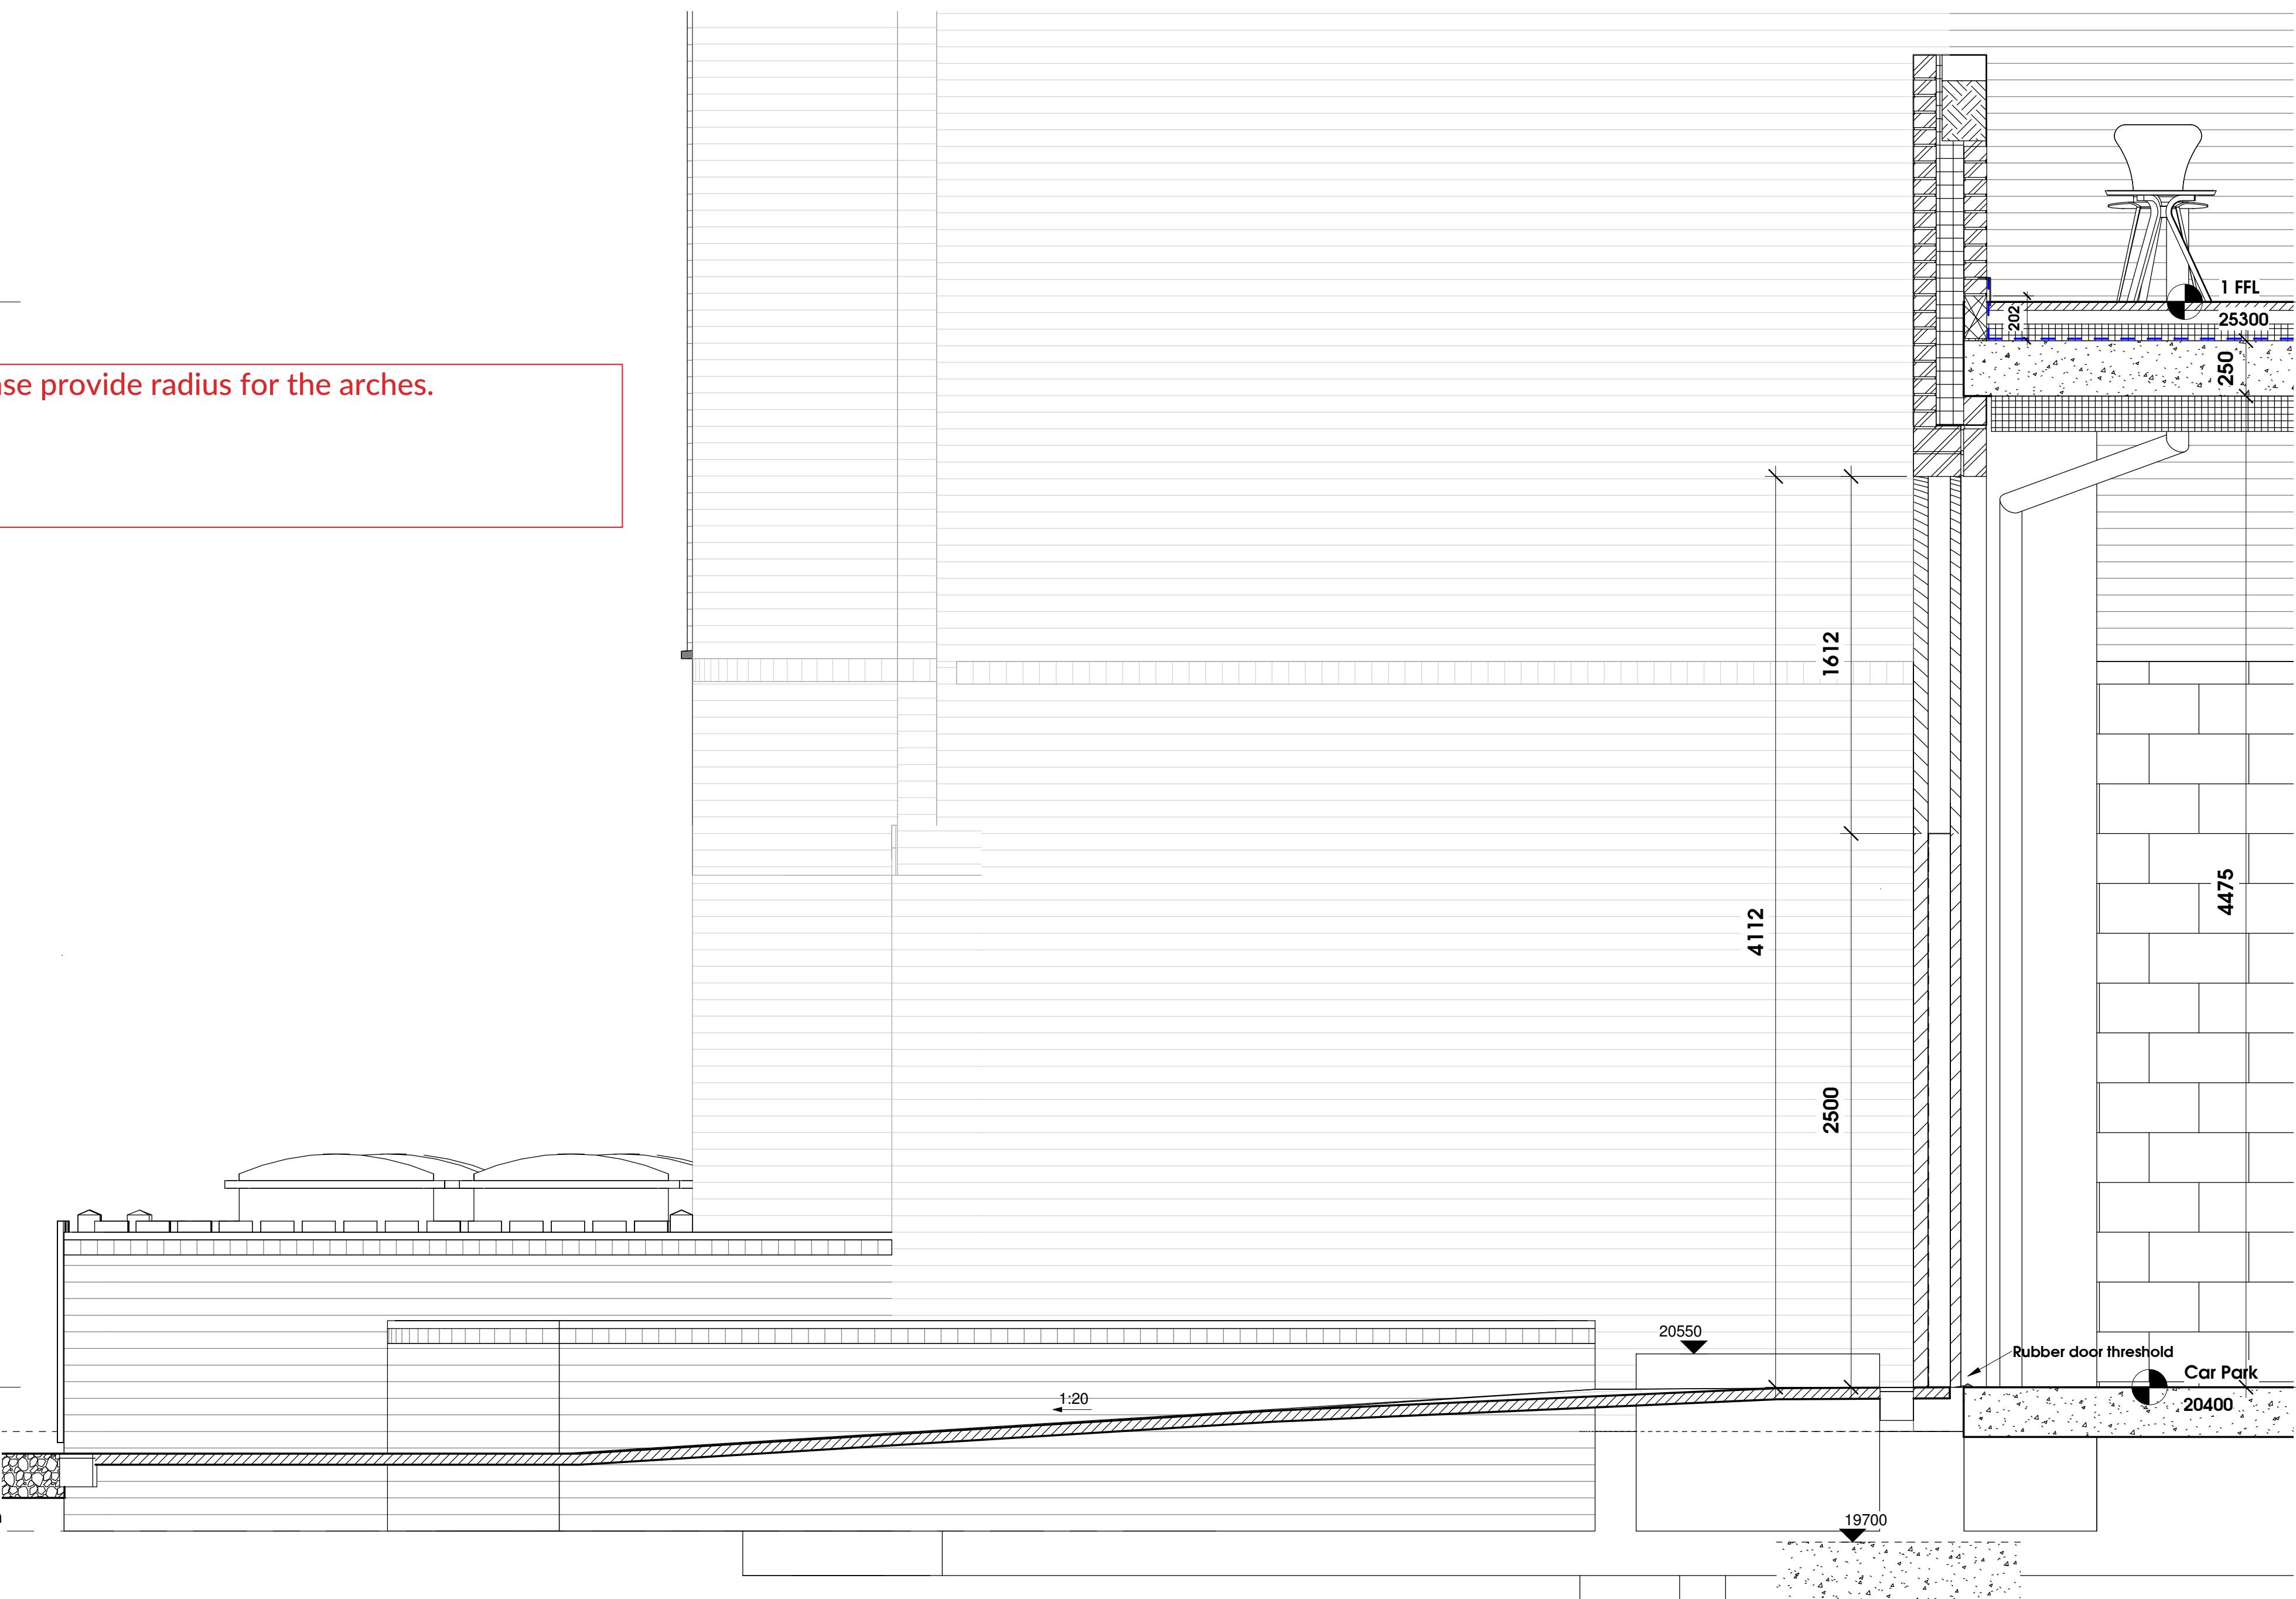

2 Vehicular Entrance Section  
1 : 20

|                                                                                                                                |                                                                               |              |                          |
|--------------------------------------------------------------------------------------------------------------------------------|-------------------------------------------------------------------------------|--------------|--------------------------|
| A                                                                                                                              | Vehicular entrance area<br>pass door removed dry<br>river added<br>Felt issue | m<br>m       | 04.07.2022<br>04.11.2021 |
| Rev                                                                                                                            | Description                                                                   | Issued by    | Date                     |
| gdmarchitects                                                                                                                  |                                                                               |              |                          |
| the master's house, college road, malden, kent. ME15 6YF<br>t: 01422 786979 w: info@gdmarchitects.co.uk w: gdmarchitects.co.uk |                                                                               |              |                          |
| client:                                                                                                                        | Canbury                                                                       |              |                          |
| project:                                                                                                                       | 44 - 46 High Road,<br>Wood Green                                              |              |                          |
| drawing:                                                                                                                       | Bury Road Vehicular<br>Entrance                                               |              |                          |
| date:                                                                                                                          | 17.08.21                                                                      | drawn by: TM |                          |
| scale:                                                                                                                         | 1 : 20 @A0                                                                    | checked: KM  |                          |

|                |                |          |
|----------------|----------------|----------|
| project number | drawing number | revision |
| 4179           | B210           | A        |