


01 Proposed Ground Floor Plan

1:100

02 Proposed Lower Ground Floor Plan

1:100

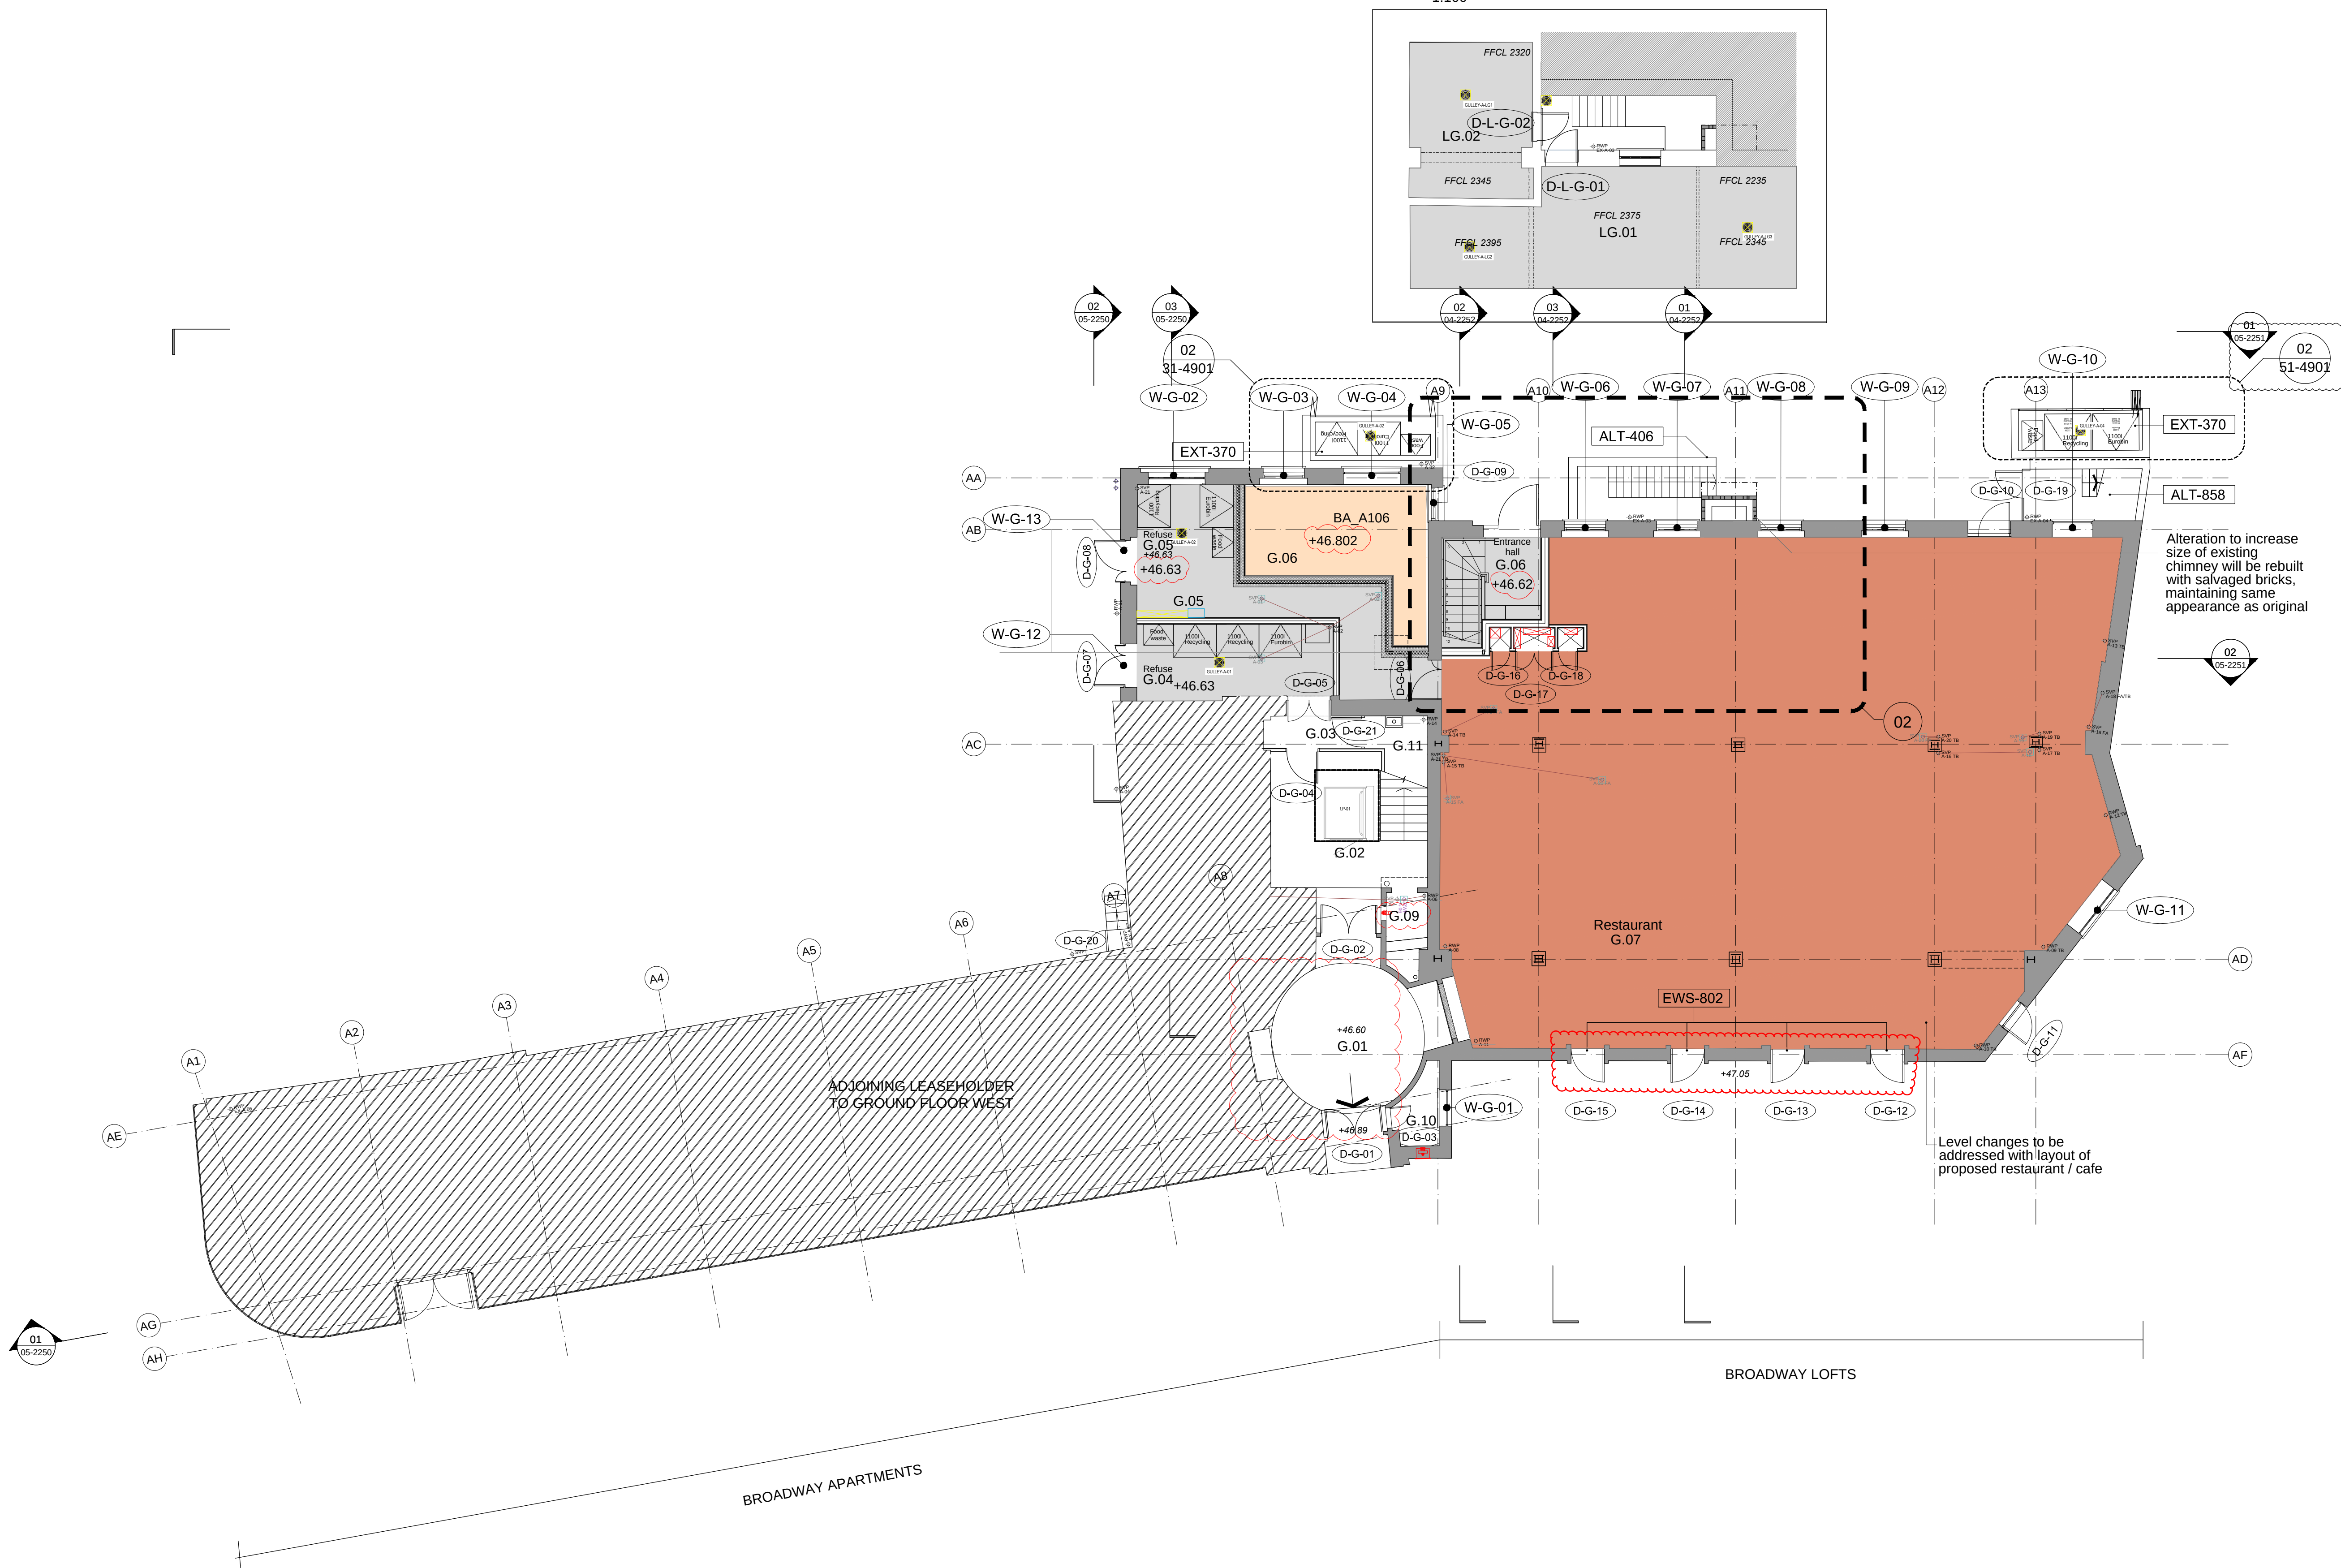

© KDS & Associates Ltd
No part of this drawing may be reproduced without written consent.
All contractors must visit site and be responsible for taking and checking all dimensions relating to this work.
Do not scale from this drawing.

REVISION NOTES

P1	08-09-2019	AC	ISSUED FOR INFORMATION
P2	11-12-2019	AC	REVISED INTERNAL STAIRCASE
P3	15-09-2020	AC	ENLARGED CHIMNEY, BA A106 AND REFUSE AREA
C1	22-09-2020	AC	ISSUED FOR CONSTRUCTION
C2	09-02-2021	AC	ADDED SERVICES
C3	01-10-2021	AC	ADDED LEVELS, REMOVED A DOOR G0.9
C4	10-06-2022	AC	REMOVED LANDSCAPE & REVISED REFER NUMBER
C5	25-01-2023	AC	REMOVED RAMP AND ADDED DRY RISER
C6	25-01-2023	AC	AS BUILT AFFORDABLE APARTMENT

EXTERNAL LEVELS, CYCLE SPACES REFER TO LANDSCAPE ARCHITECT DRAWINGS

+50.XXXXX EXISTING PROPOSED LEVEL

+51.XXXXX NEW PROPOSED LEVEL

1 BEDROOM UNIT


2 BEDROOM UNIT

ANCILLARY

FOOD AND BEVERAGE

ACCESS AND CIRCULATION

Keyplan

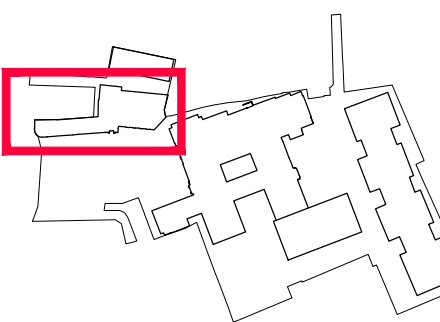

Armore GROUP
ARDMORE CONSTRUCTION LTD
6 WHARF STUDIOS,
25 WHARF ROAD,
LONDON, N1 7GR
TEL: 0208-344 0300
www.ardmoregroup.co.uk

KDS ASSOCIATES LTD
TECHNICAL ● ARCHITECTURAL ● MANAGEMENT ● CONSULTANTS
101 THE BLACKFRIARS FOUNDRY
156 BLACKFRIARS ROAD
LONDON SE1 5EN
0203 355 0775
www.kdsassociates.co.uk

AS BUILT

PROJECT / DRAWING TITLE
HORNSEY TOWN HALL
BROADWAY ANNEX
N8 9JJ

DRAWING TITLE
PROPOSED PLAN
LOWER GROUND & GROUND FLOOR

DATE / DRAWN BY
18-06-19 AC

SCALE
1:100 @A1

PROJECT / DRAWING NO
3670-KDS-BA-ZZ-DR-A-03-2000

REV
C6