


FOR DISCUSSION.


Do not scale. Builders & Contractors to take all dimensions from site.

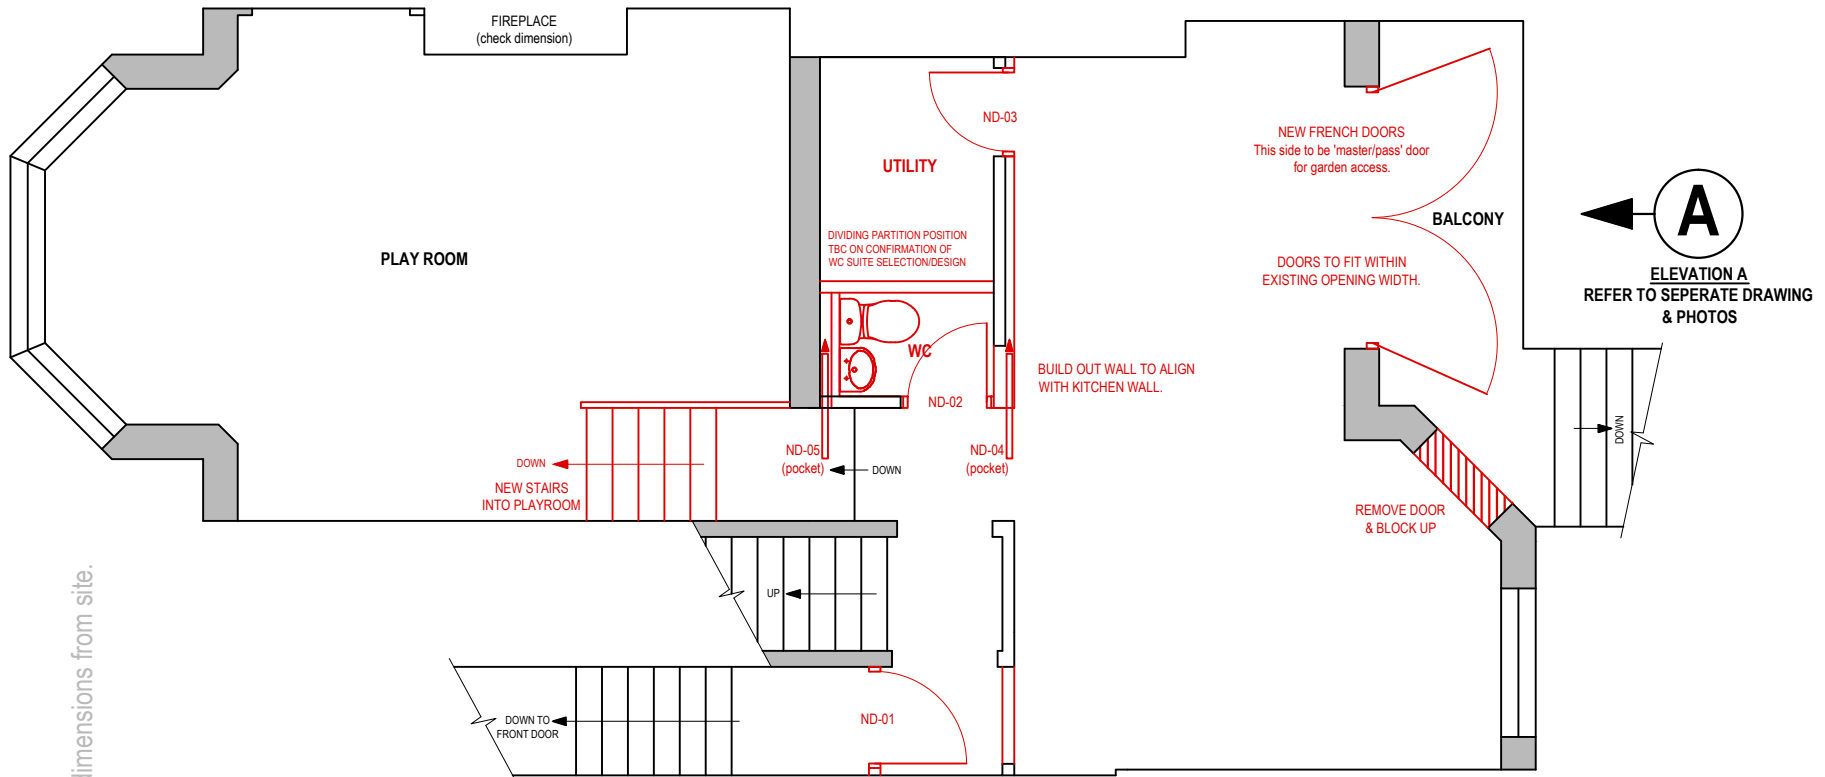

NEW SHOWN IN RED

NEW DOORS ND-03, ND-04 & ND-05 TO BE 'POCKET' SLIDING DOORS. BUILDER TO ADVISE DESIGN FOR APPROVAL.

NEW BI-FOLD DOOR. BUILDER TO ADVISE DESIGN FOR APPROVAL.

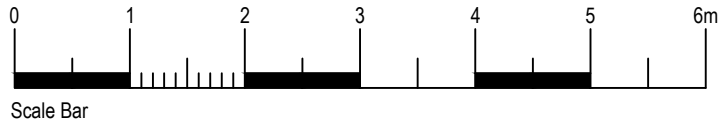

REV B (26/01/2023): French doors added. Partition amends to WC/kitchen. Window blocked up.

REV A (07/11/2022): New elements shown following meeting with builder.

client: O + A COCKERHAM	scale: NOT TO SCALE	date: 25/10/2022
drawing title: NEW ELEMENTS (Rev B)	drawing status: FOR INFORMATION ONLY	
location: 13 METHUEN PARK MUSWELL HILL LONDON N10 2JR	DISCLAIMER: ALL NEW AND EXISTING SITE DIMENSIONS TO BE CHECKED PRIOR TO COMMENCEMENT OF ANY WORKS. DO NOT SCALE. ANY DISCREPANCIES ARE TO BE NOTIFIED TO THE CLIENT AND NOT DIMENSIONS ARE TO BE SCALED FROM THIS DRAWING. ALL DIMENSIONS ARE IN MILLIMETRES UNLESS OTHERWISE STATED. THE CONTRACTOR IS TO COMPLY WITH ALL CURRENT BUILDING REGULATIONS AND CODES OF PRACTICE WHETHER SPECIFICALLY STATED ON THESE DRAWINGS OR NOT AND IN ACCORDANCE WITH BUILDING CONTROL OFFICERS INSTRUCTIONS AND RECOMMENDATIONS. ADAM COCKERHAM IS NOT RESPONSIBLE FOR THE ACCURACY OF INFORMATION RECEIVED FROM OTHERS TO PRODUCE THIS DRAWING. THIS DRAWING SHALL BE READ IN CONJUNCTION WITH ALL RELEVANT SPECIFICATION DOCUMENTATION.	