



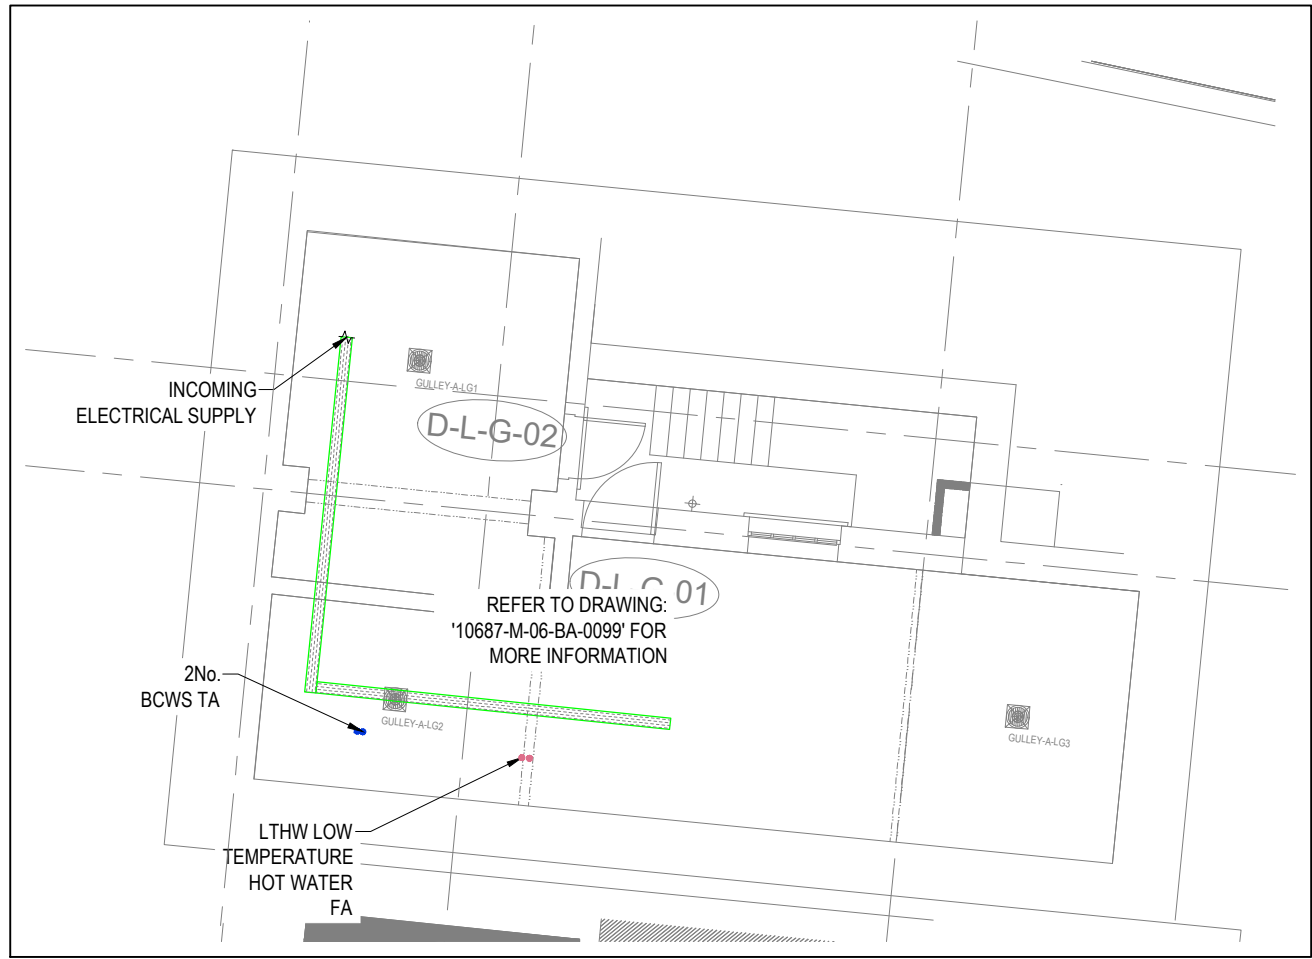

LOWER GROUND FLOOR LAYOUT

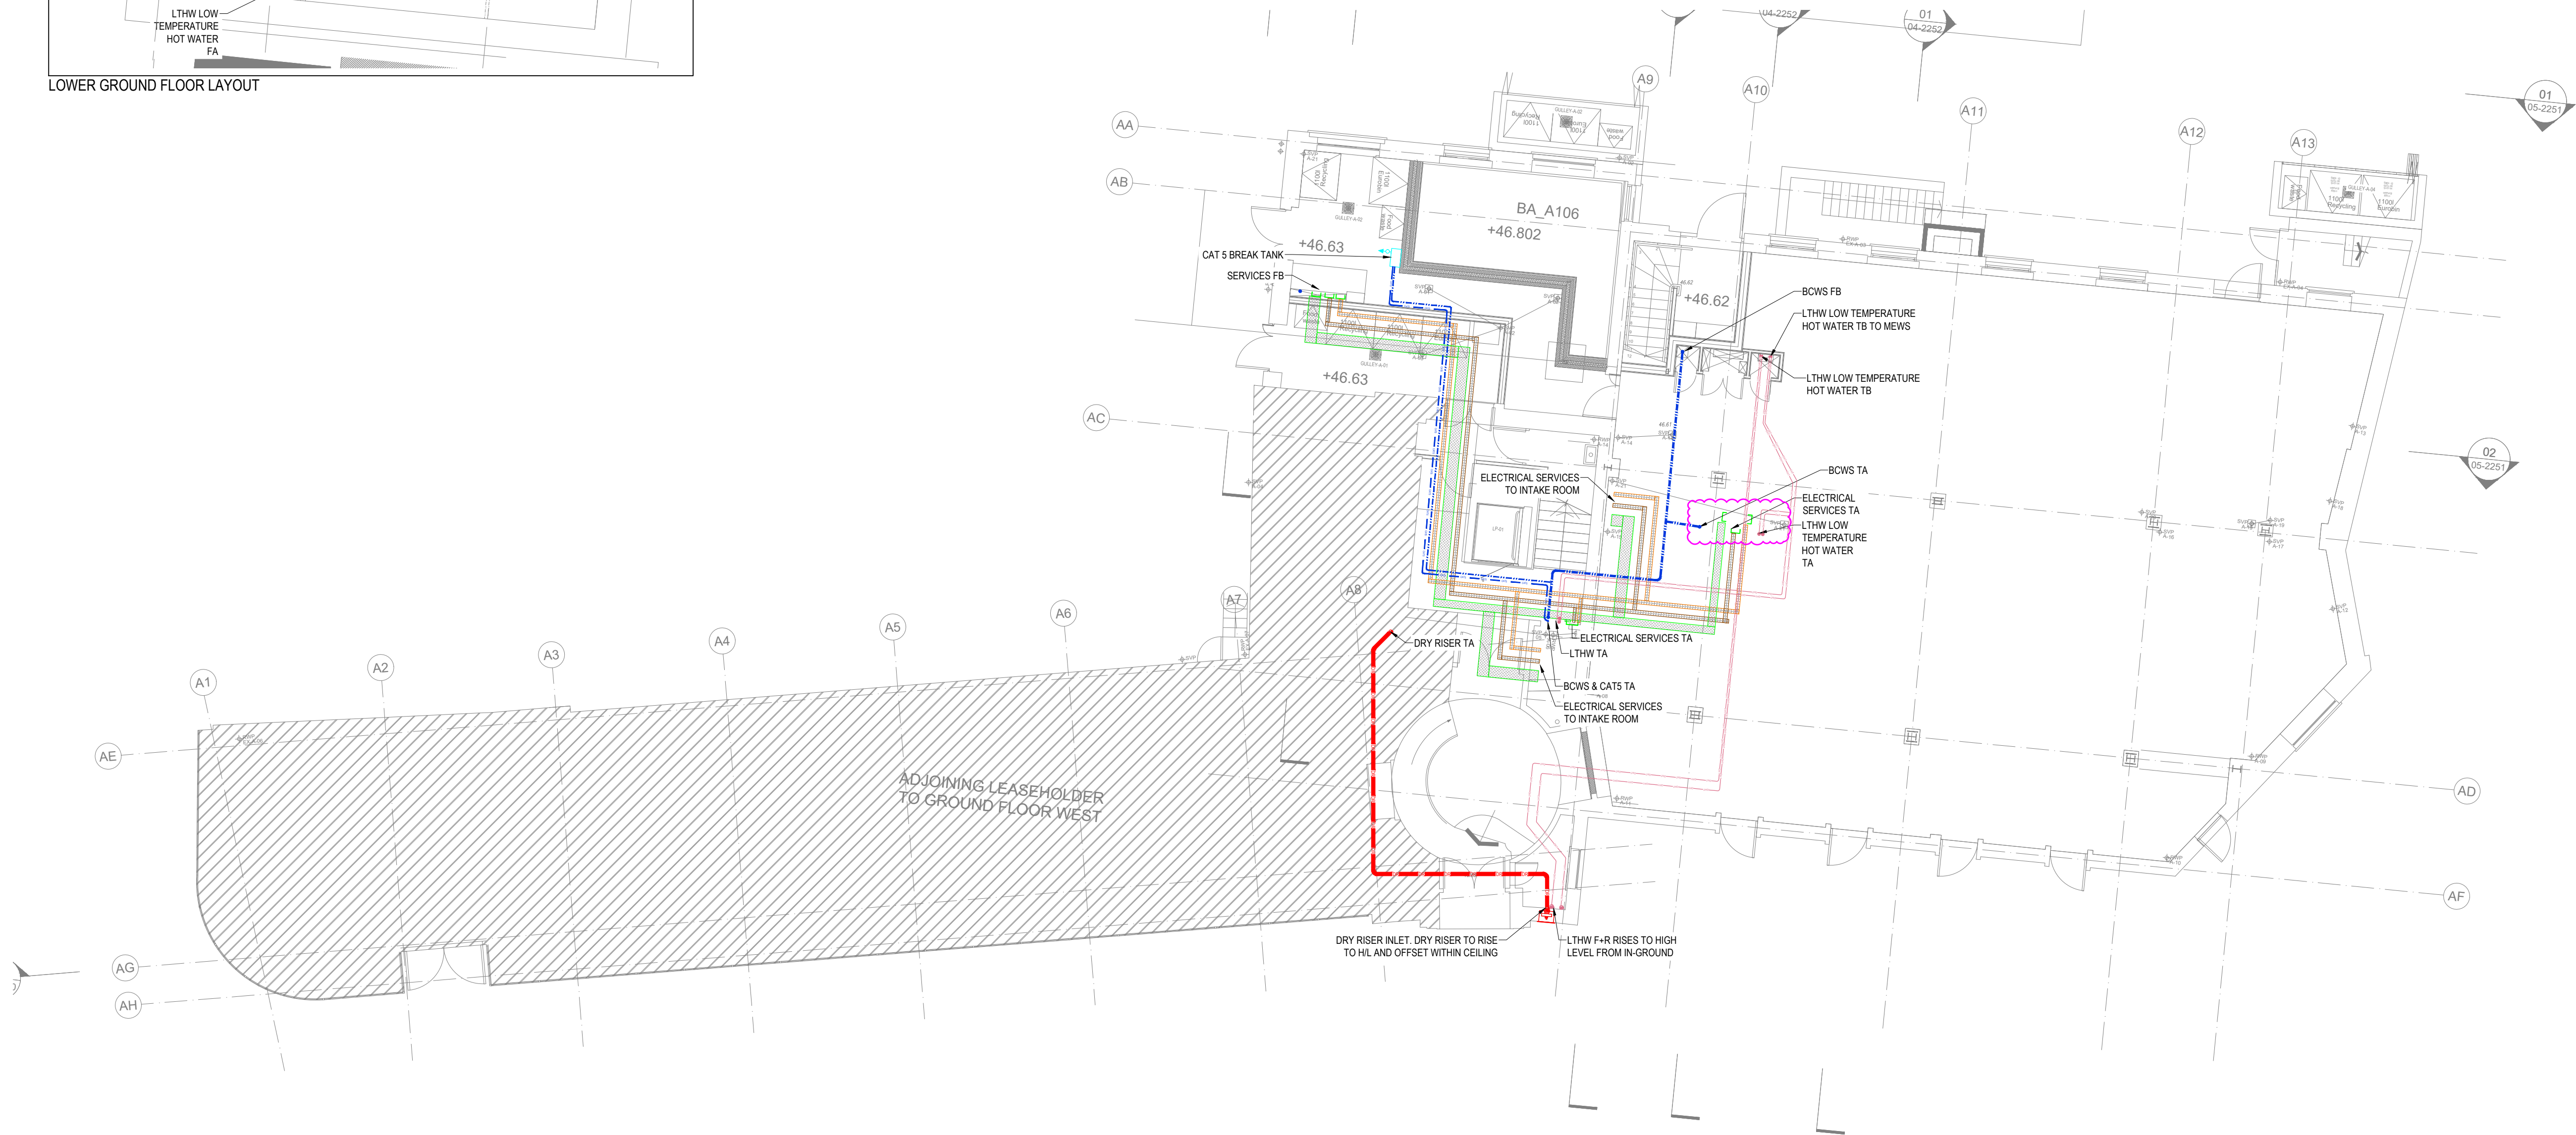

Copyright, Designs and Patents Act 1988

The copyright & design right of the design documents & of the design remains that of Whitecode Ltd. All copies are only for information about the application, they may not be used for any other purpose or copied without the express written permission of Whitecode Ltd.

Conflicts of Information

It is the responsibility of the installer/contractor to ensure that there are no conflicts with information provided by ourselves & that of any manufacturers information or relevant requirements of statutory Bodies or Client specification/Et's. If any conflicts do exist it is the responsibility of the installer/contractor to inform The Consultant/Client immediately verbally & in writing.

WARNING TO HOUSE PURCHASERS - Property Misdescriptions Act 1991

Buyers are warned that this is a working drawing and is not intended to be treated as descriptive material describing, in relation to any descriptive material describing, in relation to any descriptive particular property or development, any of the Specific Matters prescribed by an Order made under the above Act. The contents of this drawing may be subject to change at any time & alterations and variations can occur during the progress of the works without revision of the drawing. Consequently the layout, form, contents & dimensions of the finished construction may differ materially from those shown. Nor do the contents of this drawing constitute a contract, part of any contract or a warranty.

LEGEND

- SUBMANS CABLE TRAY
- ELV CABLE BASKET
- LANDLORDS CABLE BASKET
- STACKED CABLE TRAYS
- DISTRICT HEATING F&R PIPEWORK
- CAT5 CAT5 CATEGORY 5 WATER MAIN
- BOOSTED COLD WATER PIPEWORK
- WATER MAIN PIPEWORK
- PUMPED CONDENSATE PIPEWORK FROM FCU
- GAS MAIN PIPEWORK
- REFRIGERANT PIPEWORK
- SPRINKLER MAINS PIPEWORK
- HEATING PIPEWORK AT HIGH LEVEL (IN CEILING VOID)
- HEATING PIPEWORK AT LOW LEVEL (IN FLOOR BUILD UP)
- PHOTO-VOLTAIC PANEL
- BIB TAP
- FIRE COLLAR
- VERTICAL DUCT WORK
- VERTICAL PIPE WORK
- PIPEWORK AT LOW LEVEL
- PIPEWORK TO DROPRISE
- PIPEWORK BENEATH FLOOR / WITHIN FLOOR SCREED / HIDDEN
- PIPEWORK AT HIGH LEVEL / WITHIN CEILING VOID
- DRY RISER OUTLET VALVE

DRAWING ISSUED TO AS-BUILT STATUS FOLLOWING CONFIRMATION FROM ARDMORE ON 11.01.2023 THAT THERE WERE NO CHANGES ON SITE AGAINST THE CONSTRUCTION ISSUE DRAWING

BACKGROUND PLAN AS PER: KDS ASSOCIATES LTD			
TRAWLING	3670-KDS-TH-LG-DR-A-03-1998	REVISION	DATE RECEIVED
P1	02.02.2021	C2	21.09.2021
P1	02.02.2021	C4	06.06.2022

AB	23.01.2023	As Built	IV	EJ
C2	01.07.2022	Updated to new backgrounds	JH	EJ
C1	11.10.2021	Refrigerant routes changed to DHT and revised risers	DS	EJ
P1	02.02.2021	Preliminary Issue	DALS	EJ
Rev	Date	Description	Dwn	Chkd
Current purpose:	AS BUILT	Scale: 1:100	Size: A1	
Original Issue Date:	02.02.2021	Dwn: DALS	Chkd: EJ	

BUILDING SERVICES DESIGN CONSULTANTS

26-27 The Hill, Northfleet, Gravesend

Kent, DA11 9EU

www.whitecode.co.uk

T: 01322 289977 E: design@whitecode.co.uk

Title: BROADWAY ANNEX MECHANICAL SERVICES DISTRIBUTION GROUND FLOOR

Project: HORNSEY TOWN HALL

Client: ARDMORE

Dwg Number: 10687-M-02-BA-0100

Rev: AB