



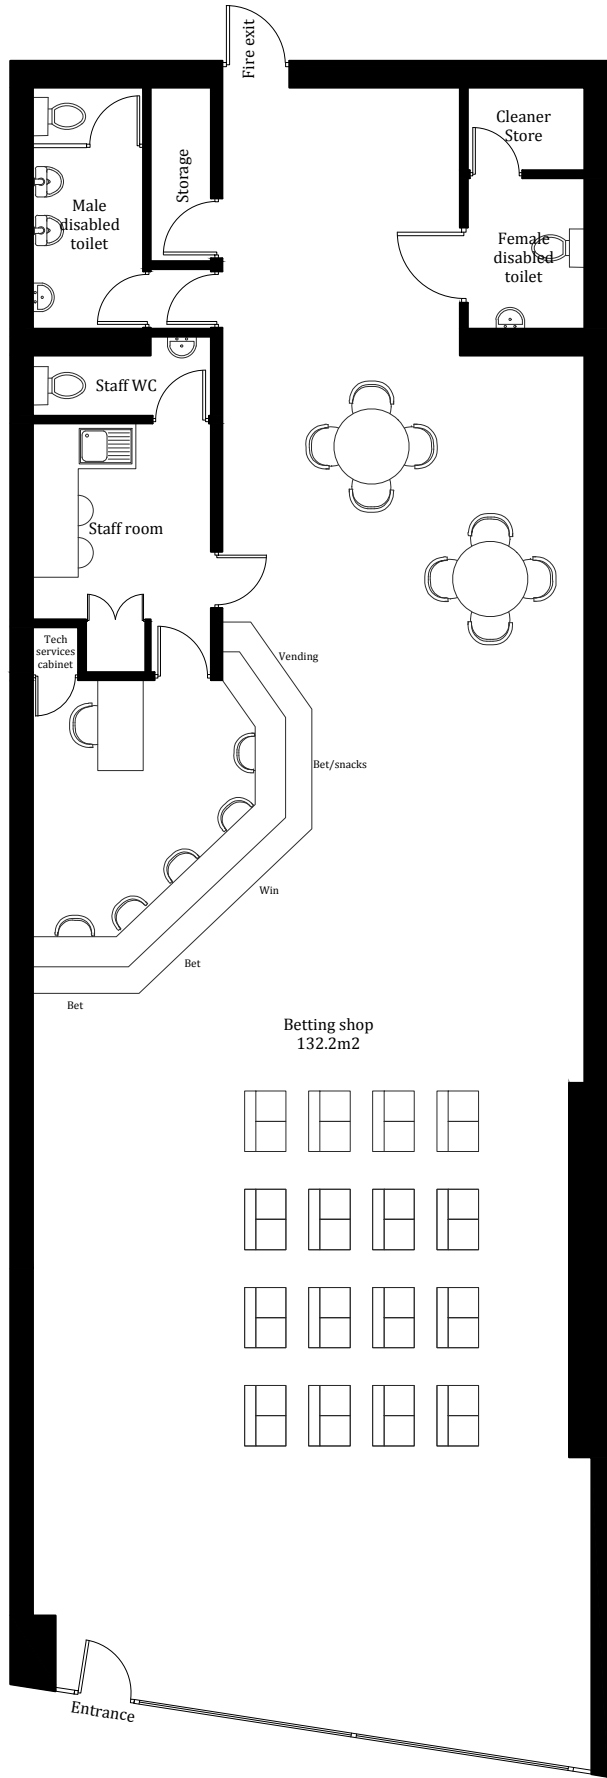

Existing floor plan

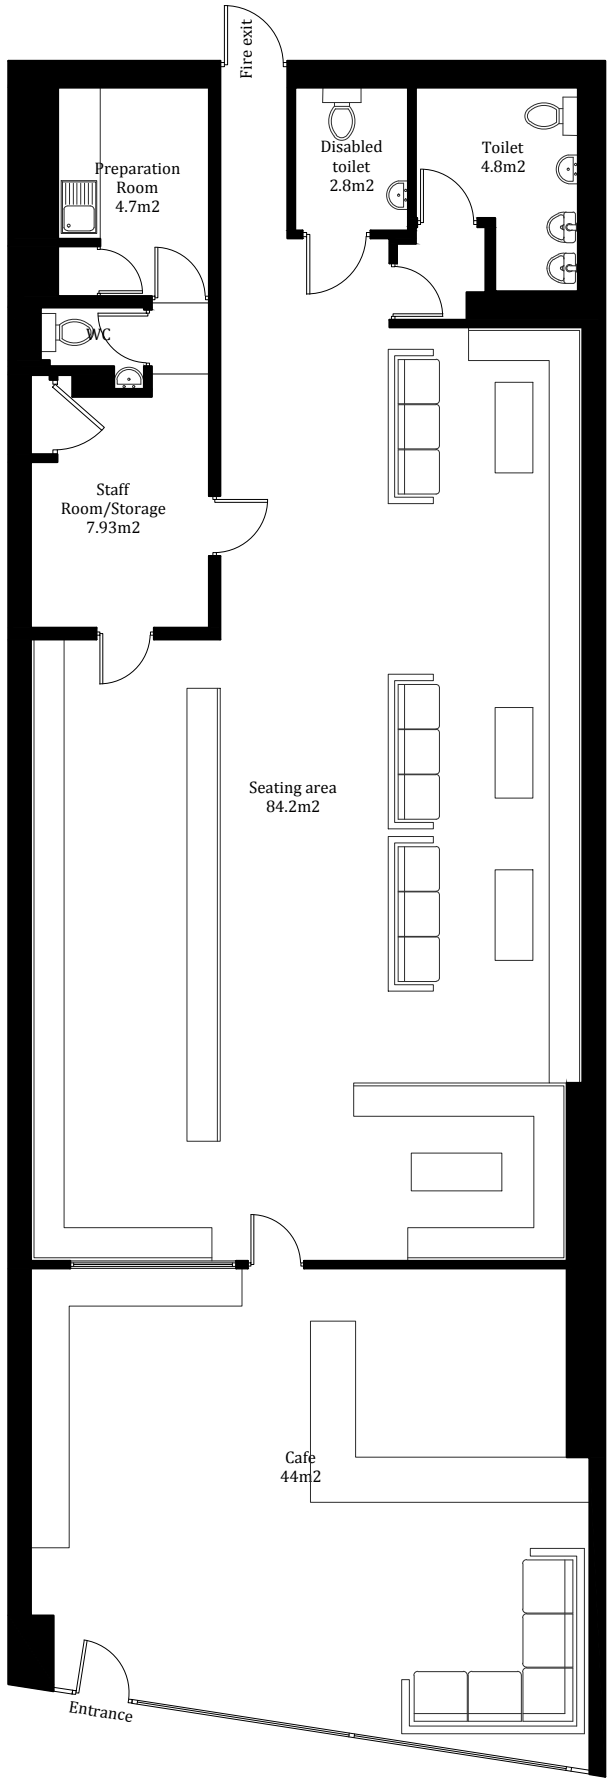

As-built floor plan





AYGUL BOYRAZ
ARCHITECTURE

Contact:	Ms. Aygul Boyraz
Email:	info@aygulboyraz.com
Tel:	+44 750 785 8488

Project Title

427 Lordship Lane,
London, N22 5DH

Sheet Title

Existing and
As-built plans

Scale

1:100 @ A3

Drawn By

AYGUL BOYRAZ

Reference Number

076A_PL01B

Date

23/03/2023

Notes:

This drawing is not to be copied, altered or changed without permission.

While this drawing can be used as a base drawing for construction purposes, it is VERY IMPORTANT that all dimensions are checked carefully before any work commences or any materials are ordered.

This drawing can be used as part of a planning application, although the planning officer may ask for more specific information about some aspects of the design.

The drawing intends to illustrate the general arrangement of the project proposals. As it stands this drawing does not include all of the detail necessary for a full plans building regulations application.