

Our Reference : D4002-L-01
Your Reference :

16 February 2023

Austringer Capital Ltd

[REDACTED]
[REDACTED]
Dear Sirs,


**Brook Road - Wood Green Core 4 - Proposed Foul Drainage
As Built - Feb 2023**

Thank you for providing photographic evidence of the foul drainage pipe construction you supervised 11 February 2023. We can confirm that the drainage length constructed (highlighted on the attached plan) appears to accurately reflect the materials, size and location of that set out on the design drawing.

Yours sincerely,



Graham Sanderson

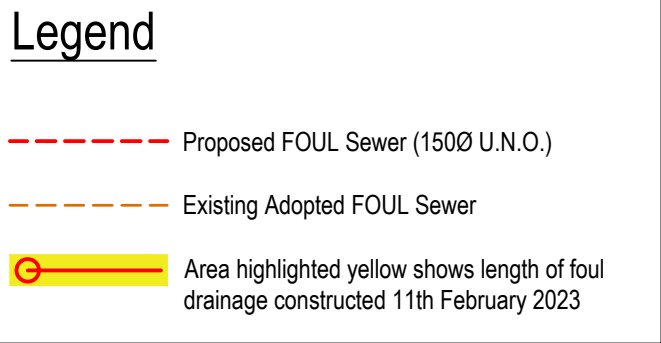

- NB: The exact position and depth of the public sewer must be established on site
Final connection detail subject to S106 approval from Thames Water

