

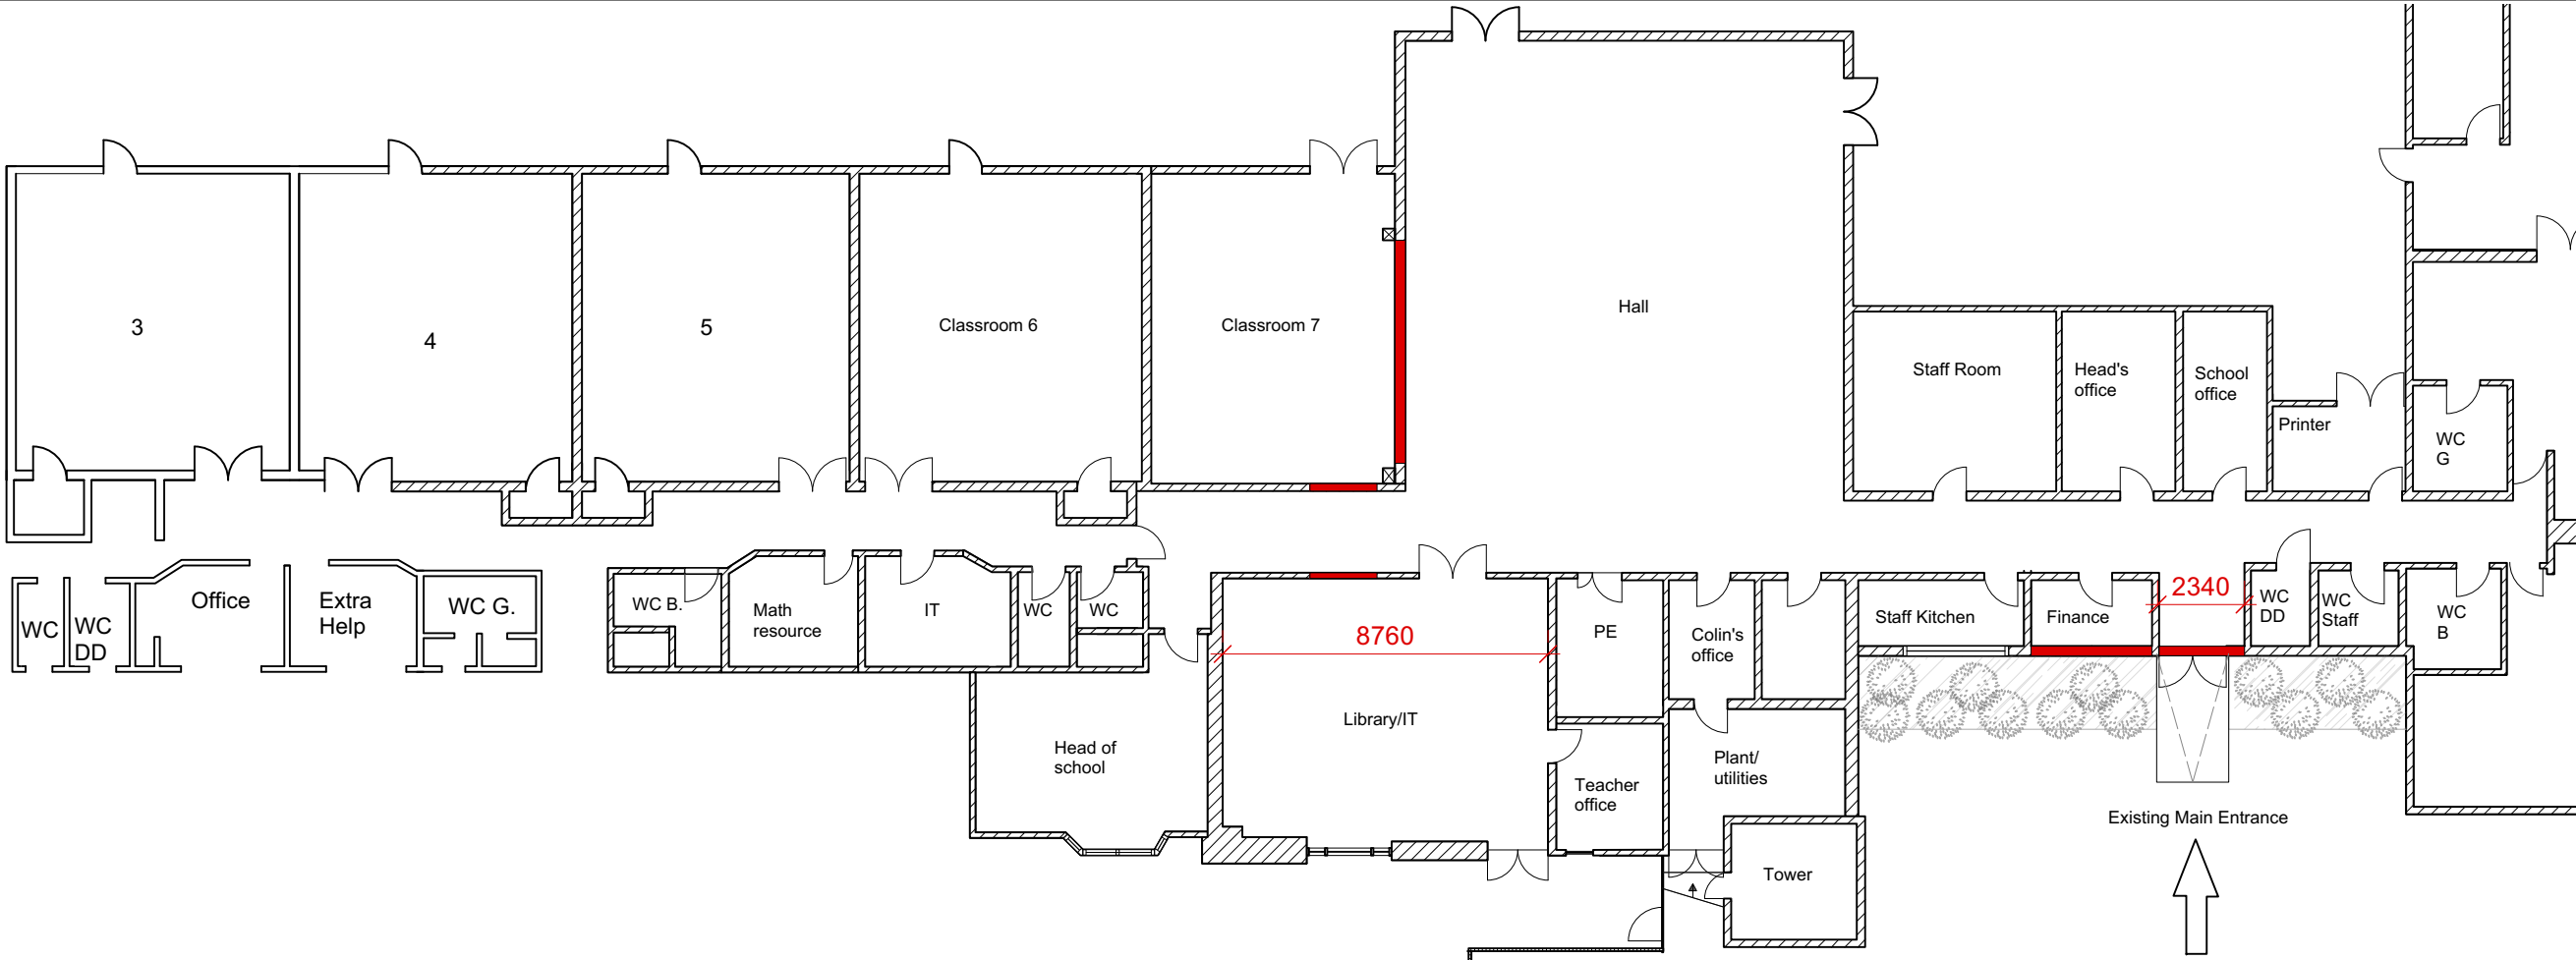


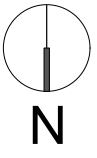

NOTES

Walls marked in red to be removed

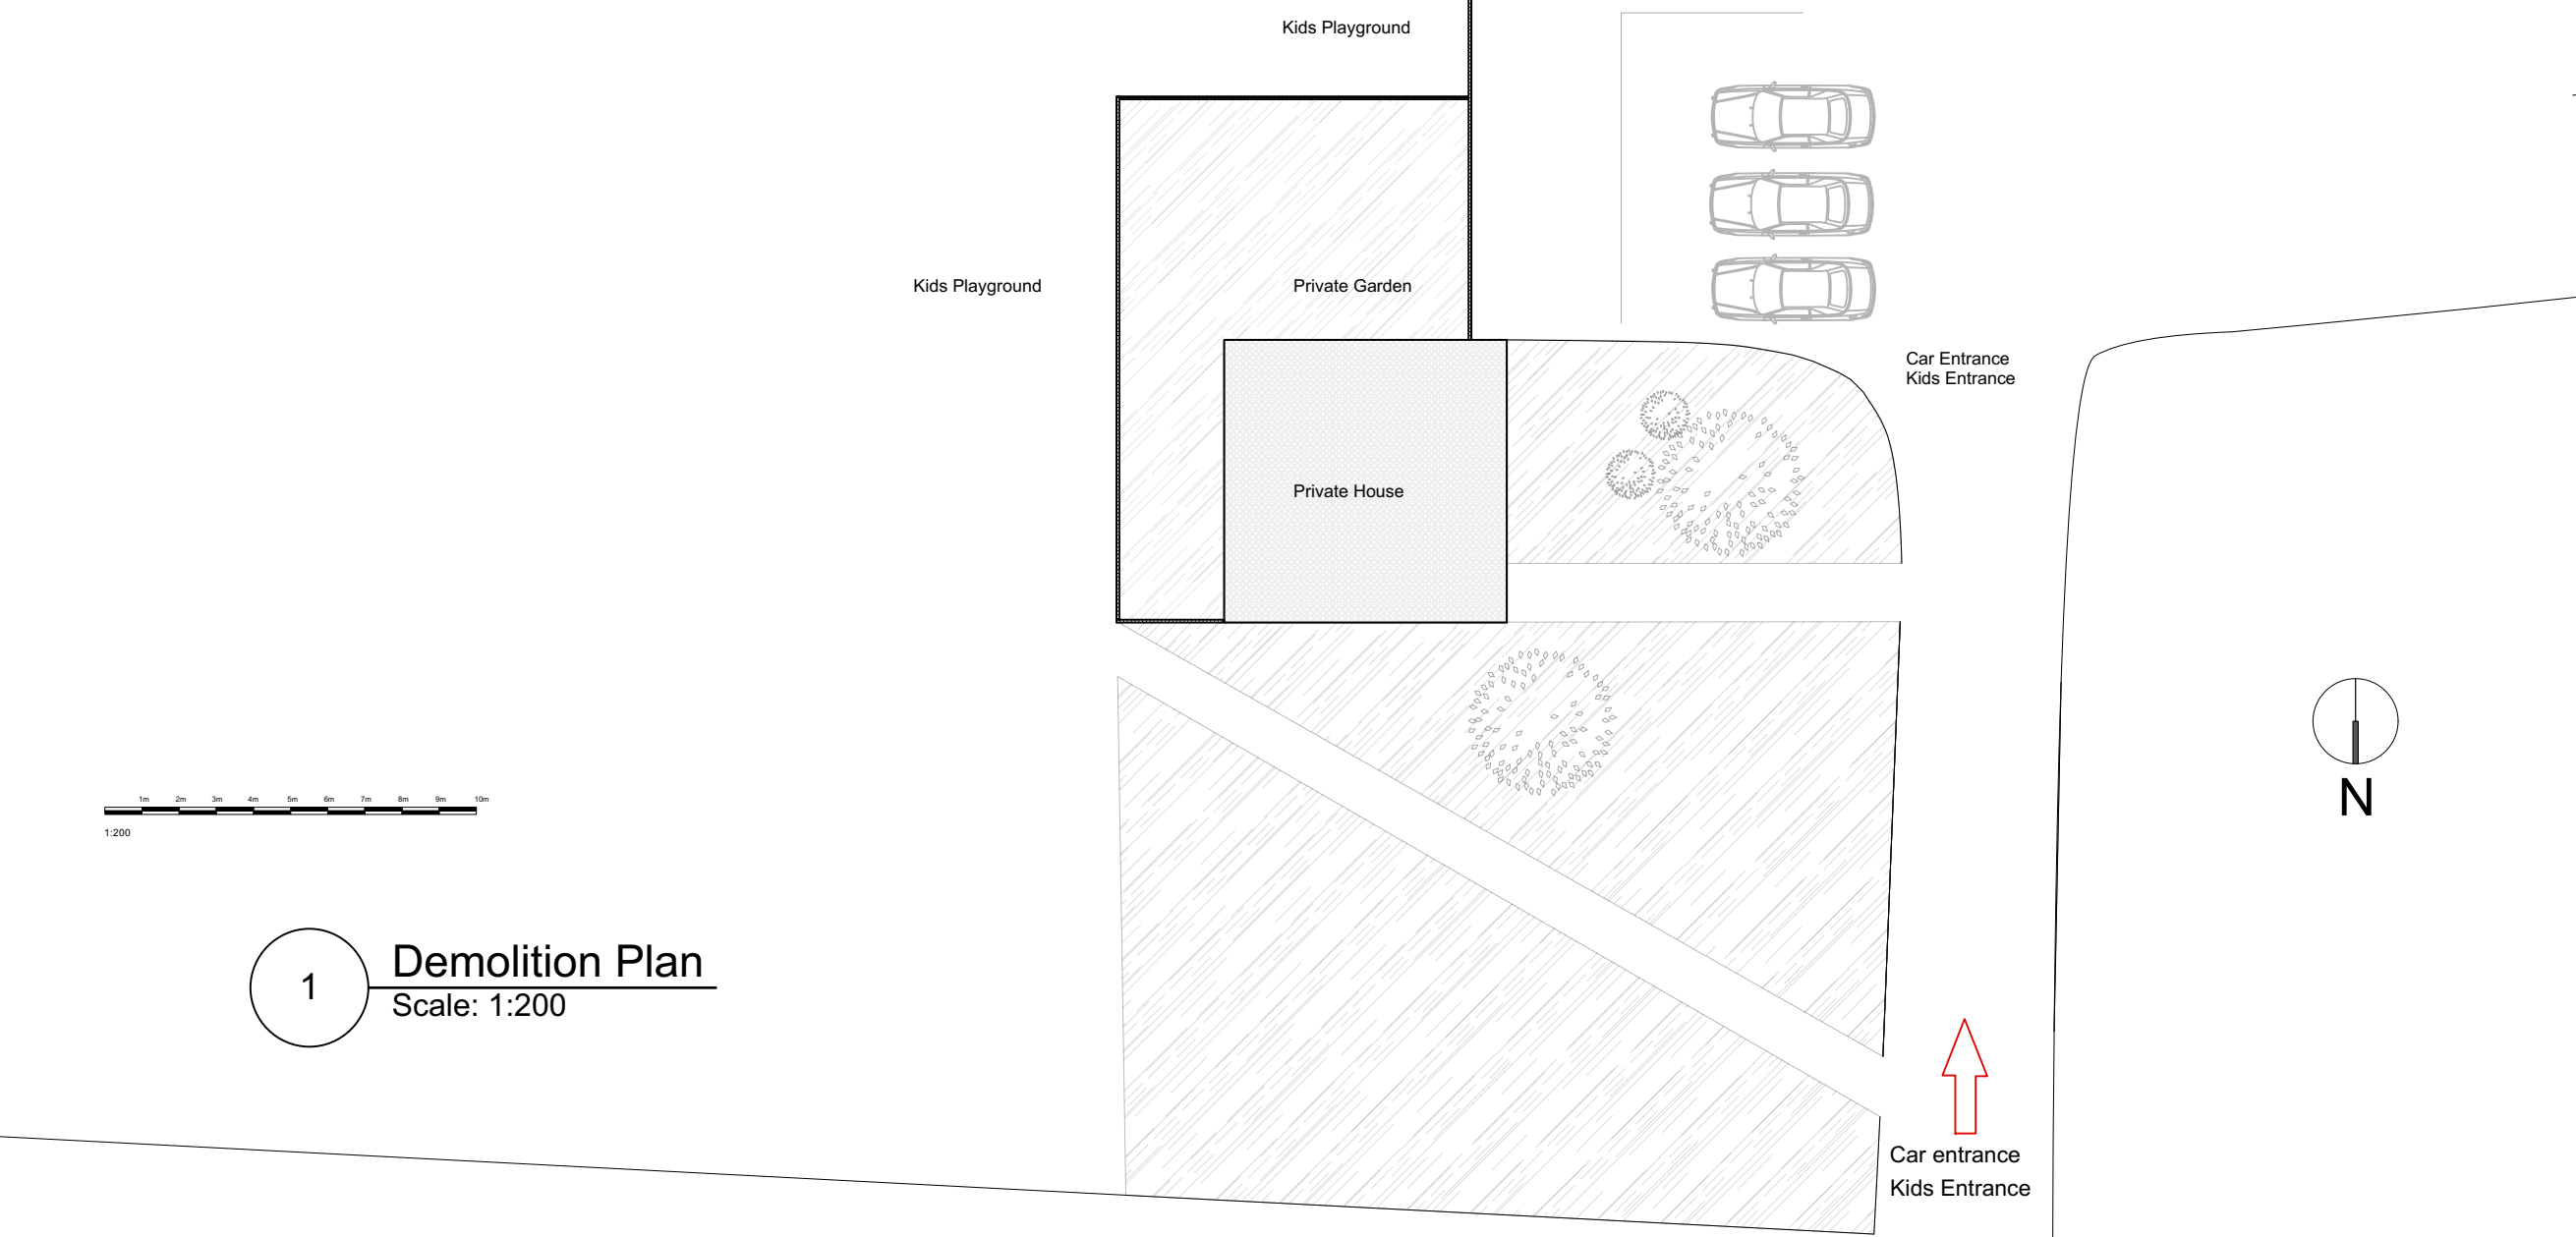

1 Demolition Plan
Scale: 1:200

DWG NUMBER_	REVISION_
02-PL-SJ-GF-E	-

TITLE_
Existing Plan with Demolition Plan

JOB_
St James School
Woodside Ave, London N103JA

CLIENT_ St James School

DATE_ June 2023

UNITS_ mm

SCALE_ 1/200 @ A3

Do not scale this drawing. Figured dimensions only are to be used in preference to small scale drawings. All dimensions are to be checked on site before work proceeds.