




EXISTING AS BUILT

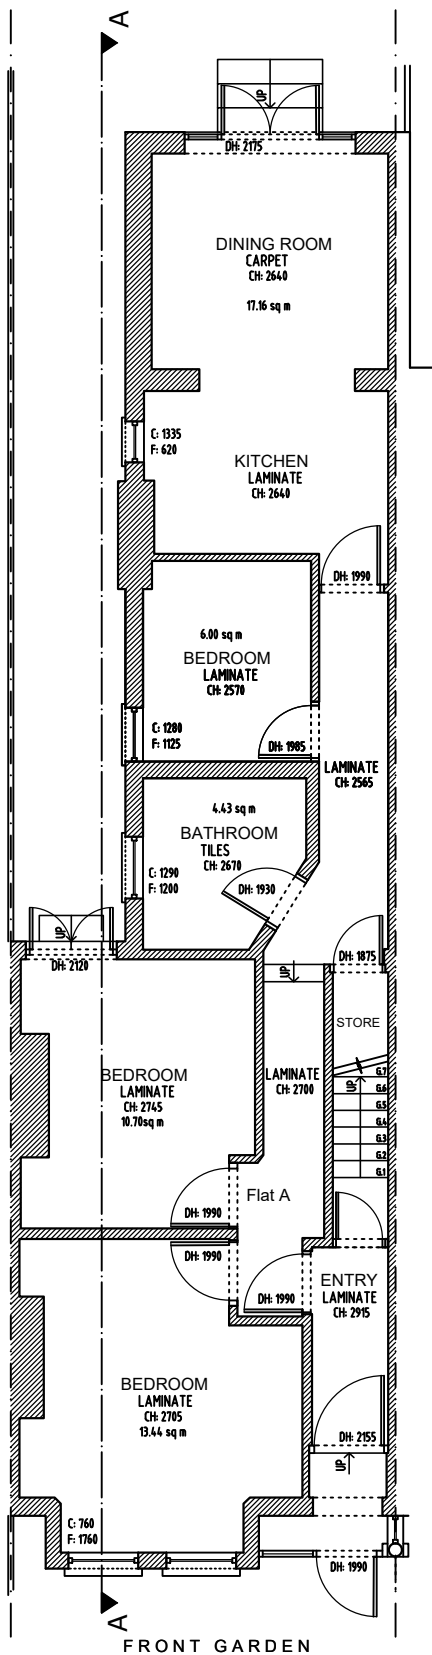


Existing Ground Floor

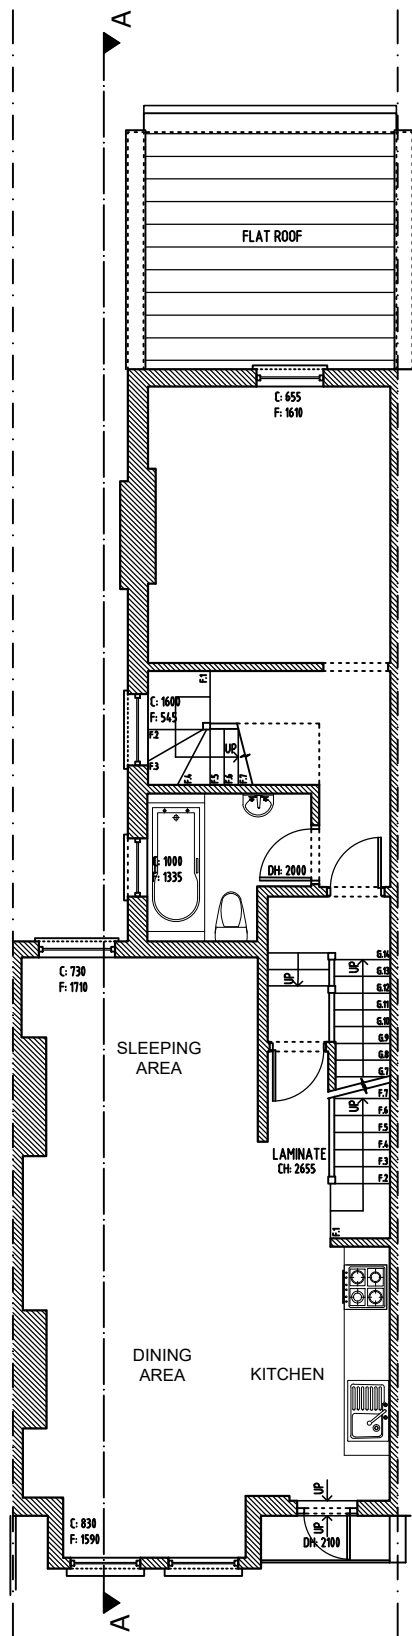


Existing First Floor

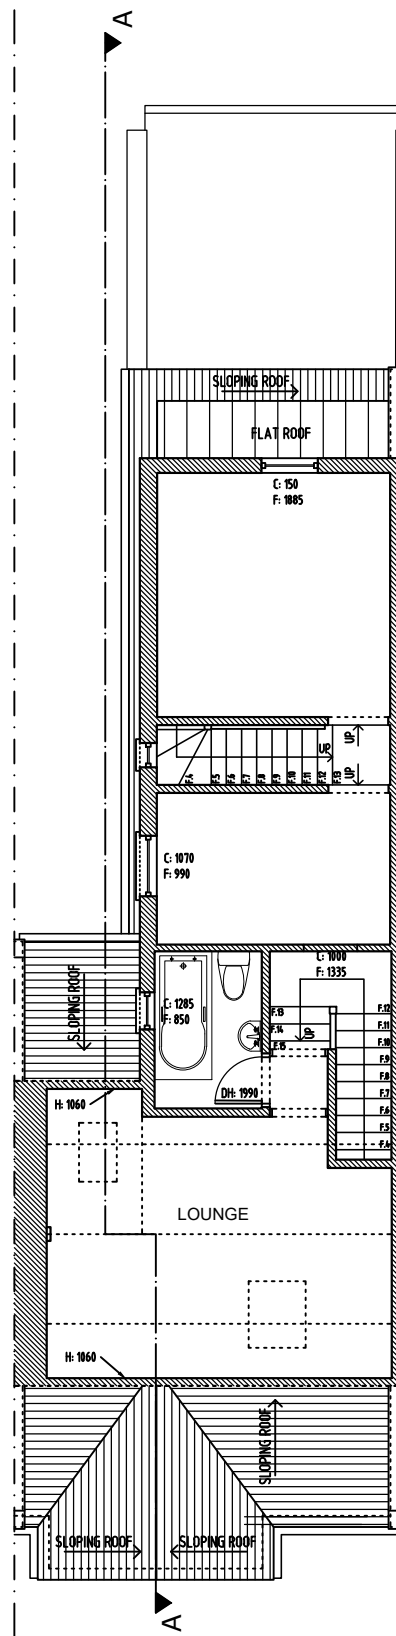

Existing Loft Floor

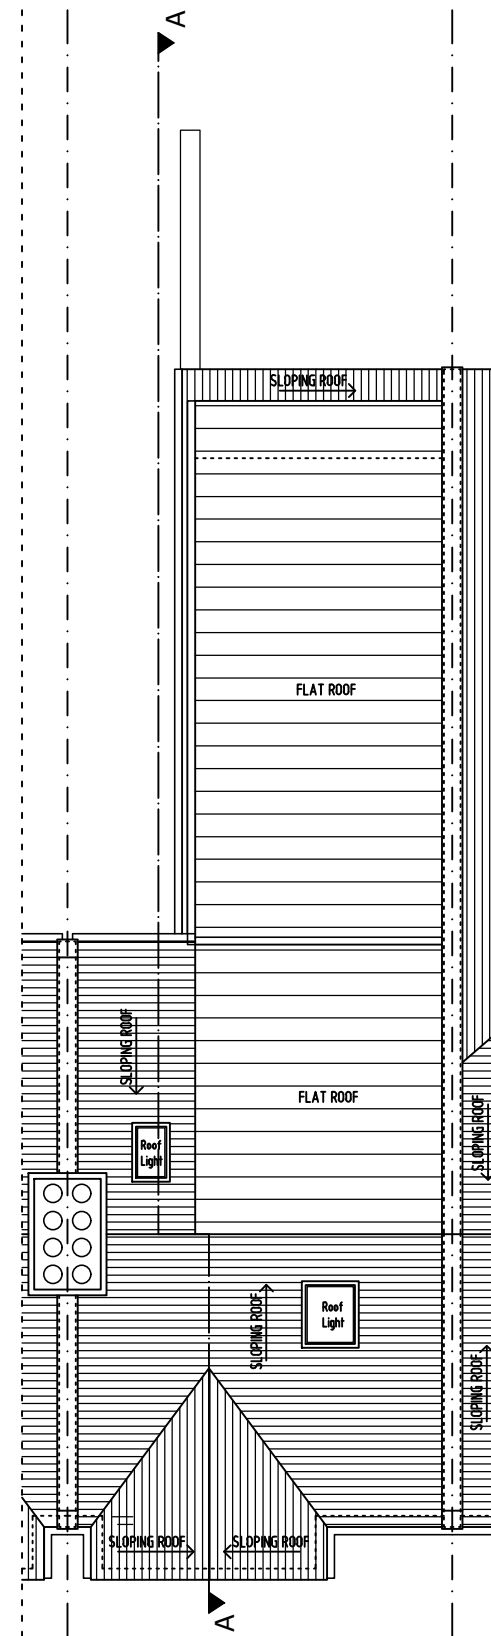

Existing Roof Plan

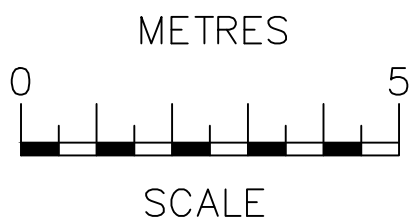

C - Sill Height
F - Window Height
CH - Ceiling Height
DH - Door Height



NOTES
The contractors are to check all the dimensions, levels, drain runs and general condition of the site before works commence.
All works are to be carried out in accordance with current Building Regulations, British Standards, Code of Practice and Local Authority Requirements.

Project: 263 Mount Pleasant Road, London N17 6HD		
Title: EXISTING Floor Plans		
Date: 19.07.20	Scale: 1:100 @ A3	
Dwg. No. MPR.263.EX.01		Rev: