




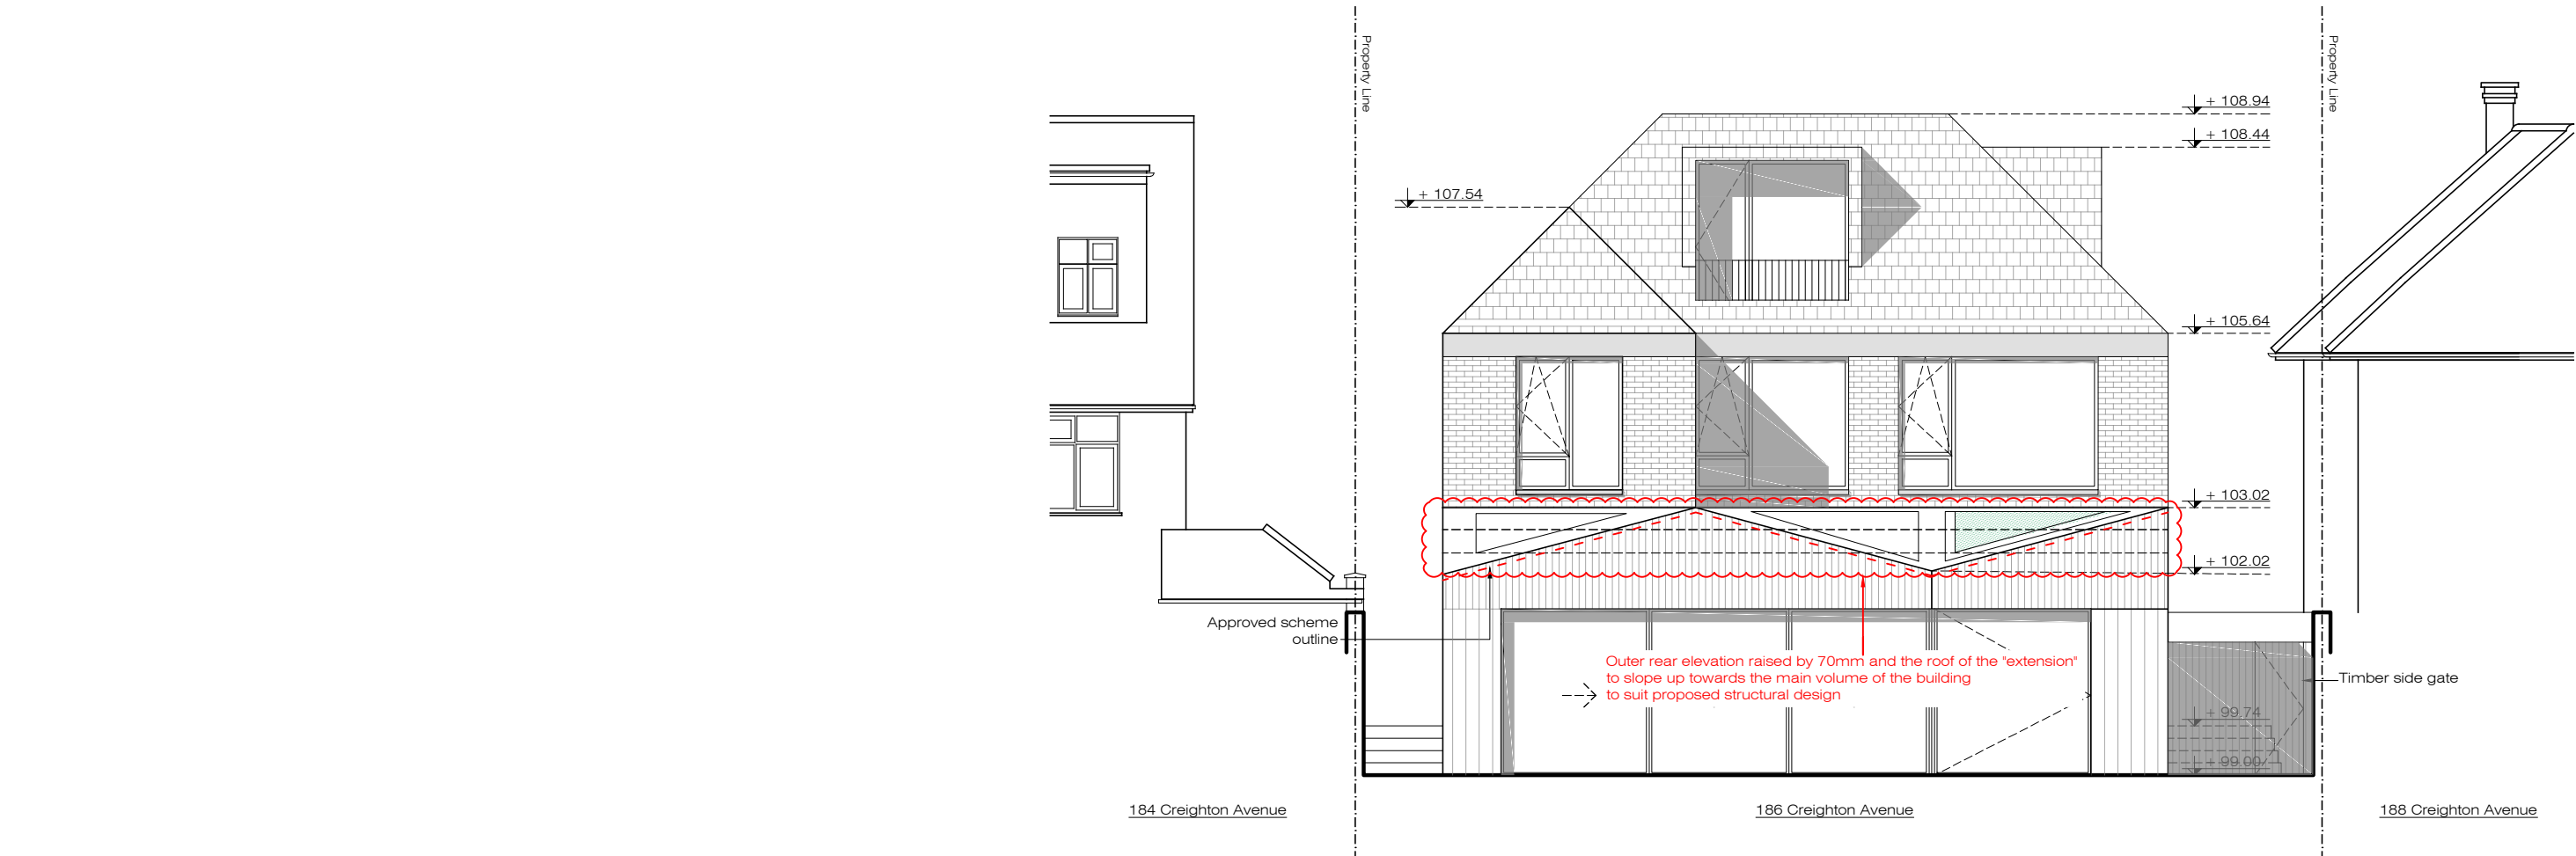

X PROPOSED
Rear Elevation 1:100@A3

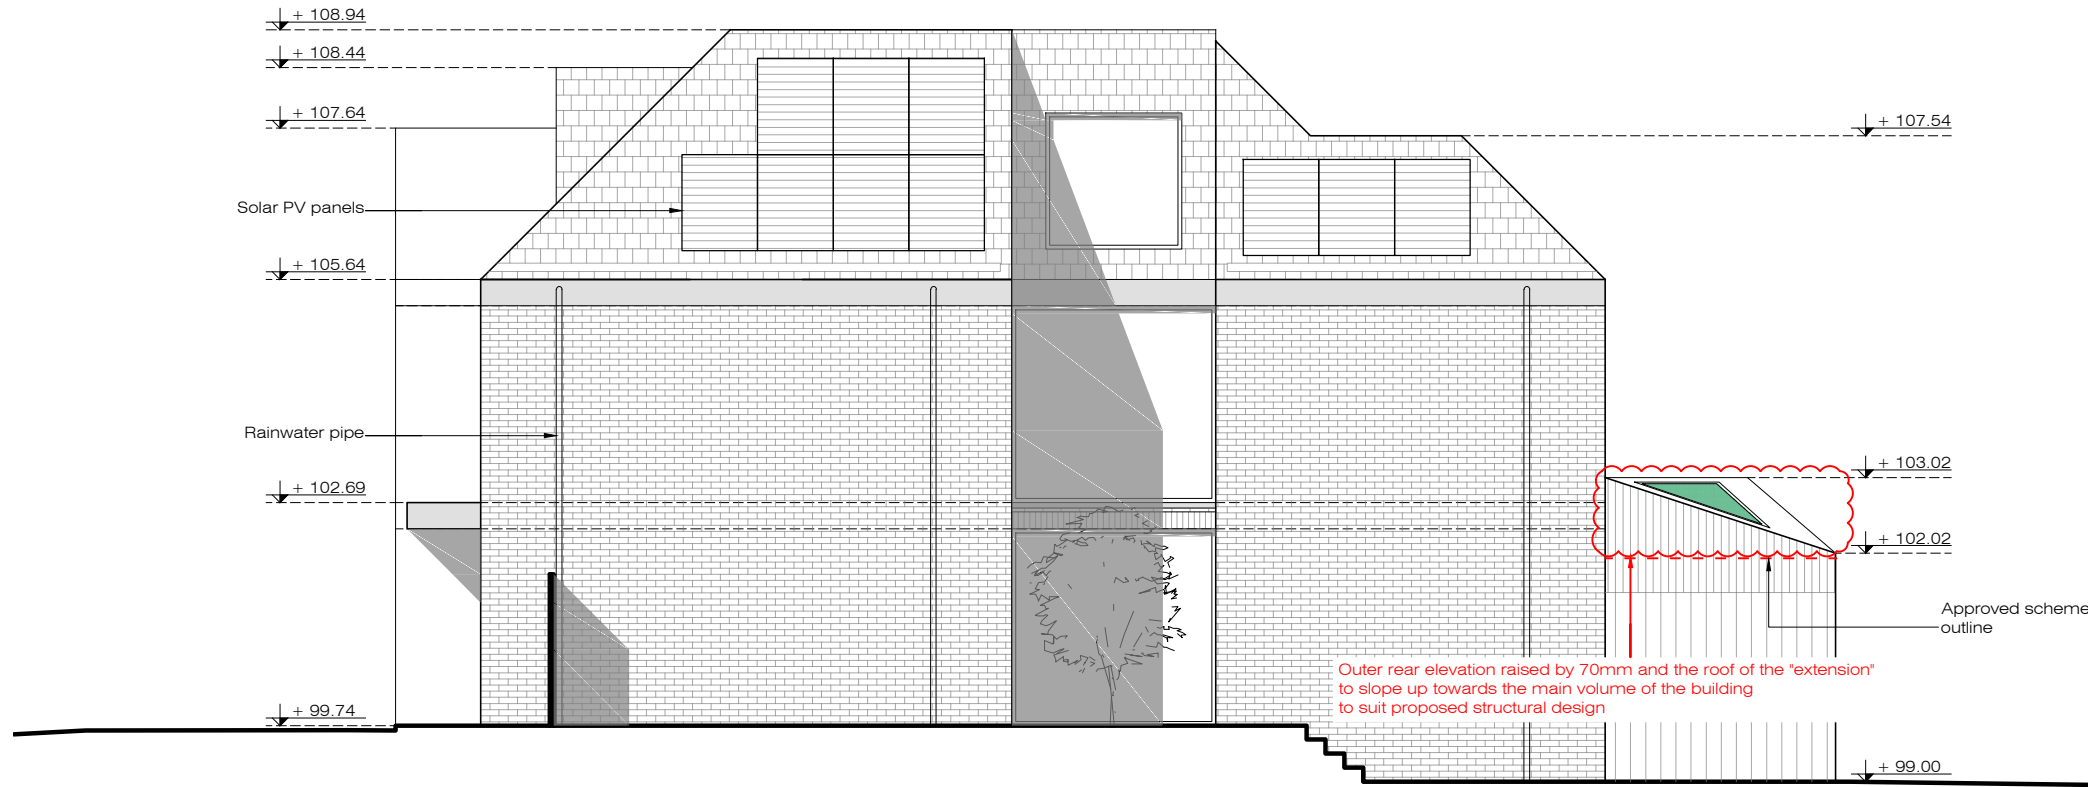

X PROPOSED
Side Elevation 1 1:100@A3

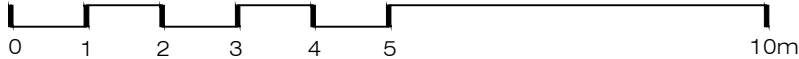

Ground Floor Office
33 Belsize Lane
London NW3 5AS
Office: +44 (0) 207 431 9014
info@xularchitecture.co.uk
www.xularchitecture.co.uk

PLEASE NOTE:

- All dimensions to be checked on site before fabrication,
- Contractor to refer to engineers drawings before proceeding with works.
- All drawings and designs are covered by design right (intellectual property), and may not be distributed, copied or issued without written permission by the Architect.
- All design concepts are the sole property of the Architect and no adaptations, reproductions or copies may be made without written permission of the Architect.
- These drawings are subject to any variation required or recommendation by any statutory authority, or for the better carrying out of the works.
- Samples to be provided by contractor for XUL Architecture's approval.
- All finishes to XUL Architecture's satisfaction.
- All drawings to be approved by XUL Architecture prior to construction.

ADDITIONAL NOTE:

Issue key:

Information (I)
Planning (P)
Tender (T)
Construction (C)
As Built (B)

Project Address
186 Creighton Avenue, N2 9BJ

Scale 1:100@A3

Rev. Date 30.05.23

Drawn FM

Checked SS

PROPOSED

Rear Elevation & Side Elevation 1

Dwg. No. PA-06 Rev. P-02

Project Number 21175

Issue For:
PLANNING