


- NOTES:**
1. This drawing is to be read in conjunction with all relevant engineer's drawings, architect's drawings and specifications.
 2. For setting out information, refer to the relevant architect's drawing.
 3. All elevations and levels are in metres and are related to Ordnance Datum (O.D.). All dimensions are in metres unless noted otherwise.
 4. Drawings should not be scaled either by hand or from the computer digital data, only figured dimensions are to be used.

KEY

-  Site Boundary
-  Formation As-Built Level

P02	21.06.2022	WH	21.06.2022	SG
UPDATED AS-BUILT SURVEY				
P01	16.05.2022	WH	16.05.2022	SG
FIRST FOR REVIEW				
Rev	Date	By	Chkd	Appd

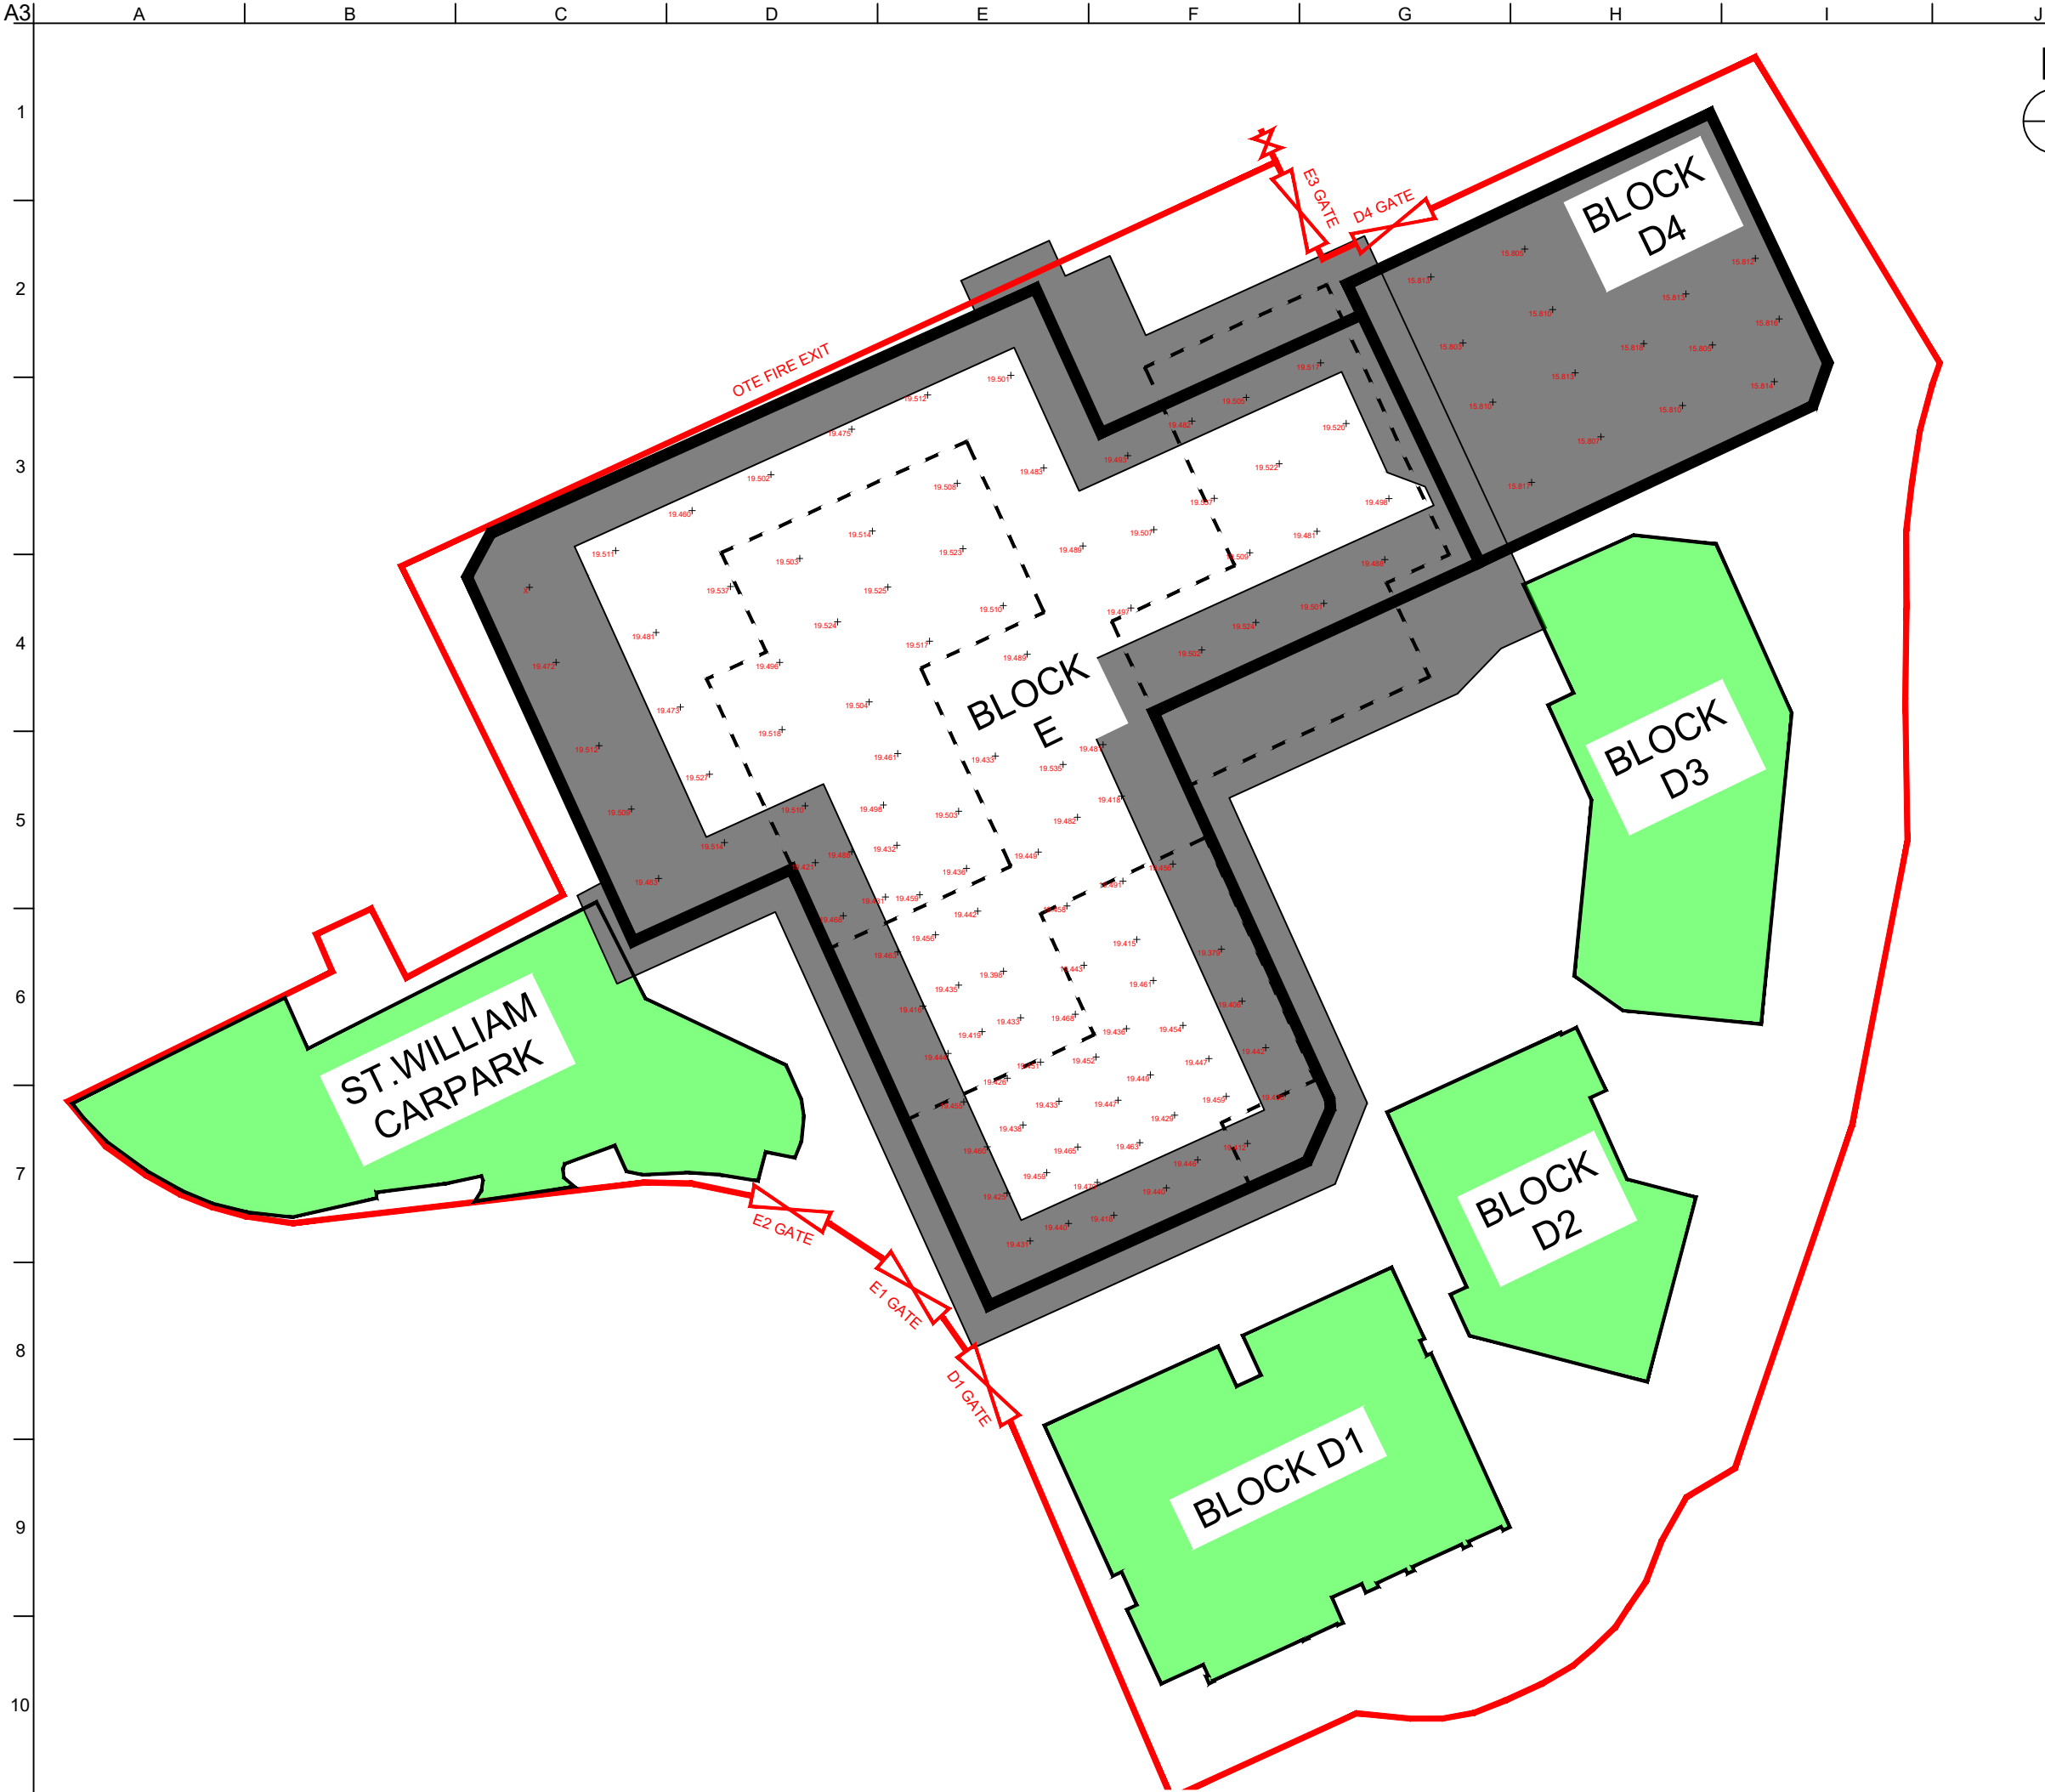

St. Andrew's House
Portsmouth Road
Esher KT10 9TA
T: +44 (0)20 7643 1000 F: +44 (0)20 7643 1001 E: enquiries@keltbray.com
www.keltbray.com
Client

St William
Designed for life

Project Title
CLARENDON GASWORKS PHASE 3

Key Plan

Drawing Title
**BLOCK E FORMATION AS-BUILT
LEVELS**

Scale at A3
NTS

Role
X - SUBCONTRACTOR

Suitability
S2 - FOR INFORMATION

Keltbray Remediation Job No 6089	Rev P02
--	-------------------

Name
CG3-KRE-X-000-XX-M2-CE-1003
Phase - Originator - Role - Zone - Level - Type - Element - Number