




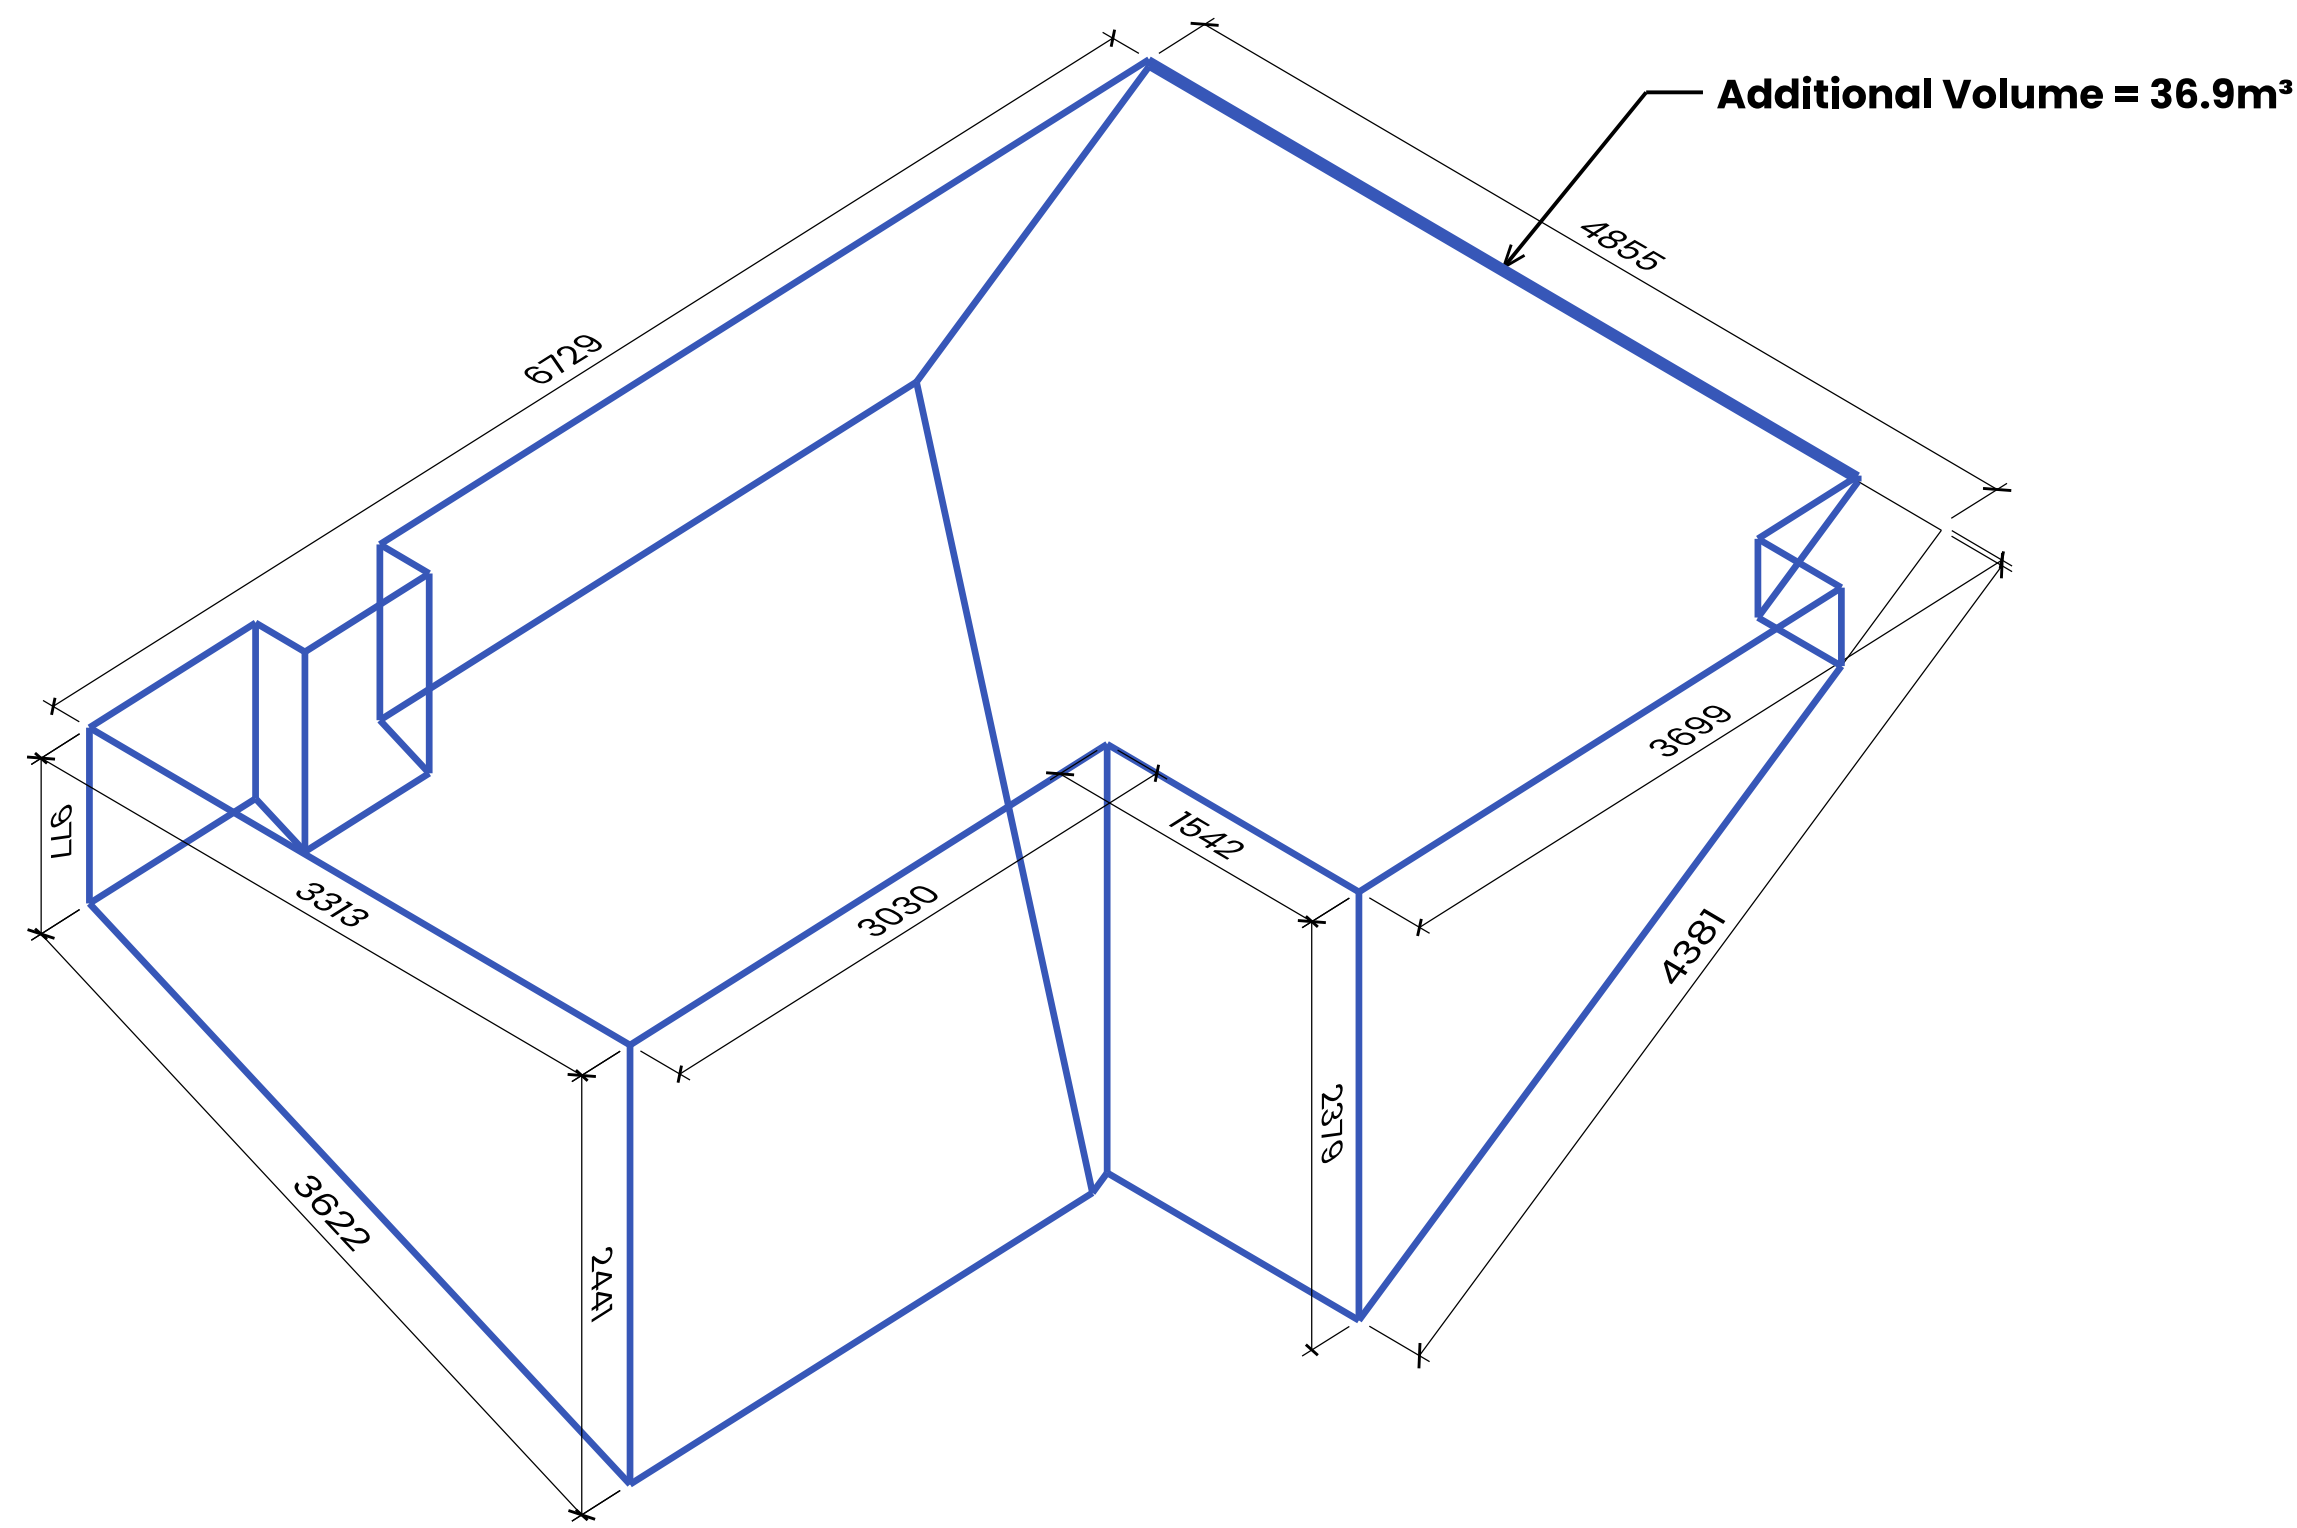

01 3D Model of Additional Volume
NTS

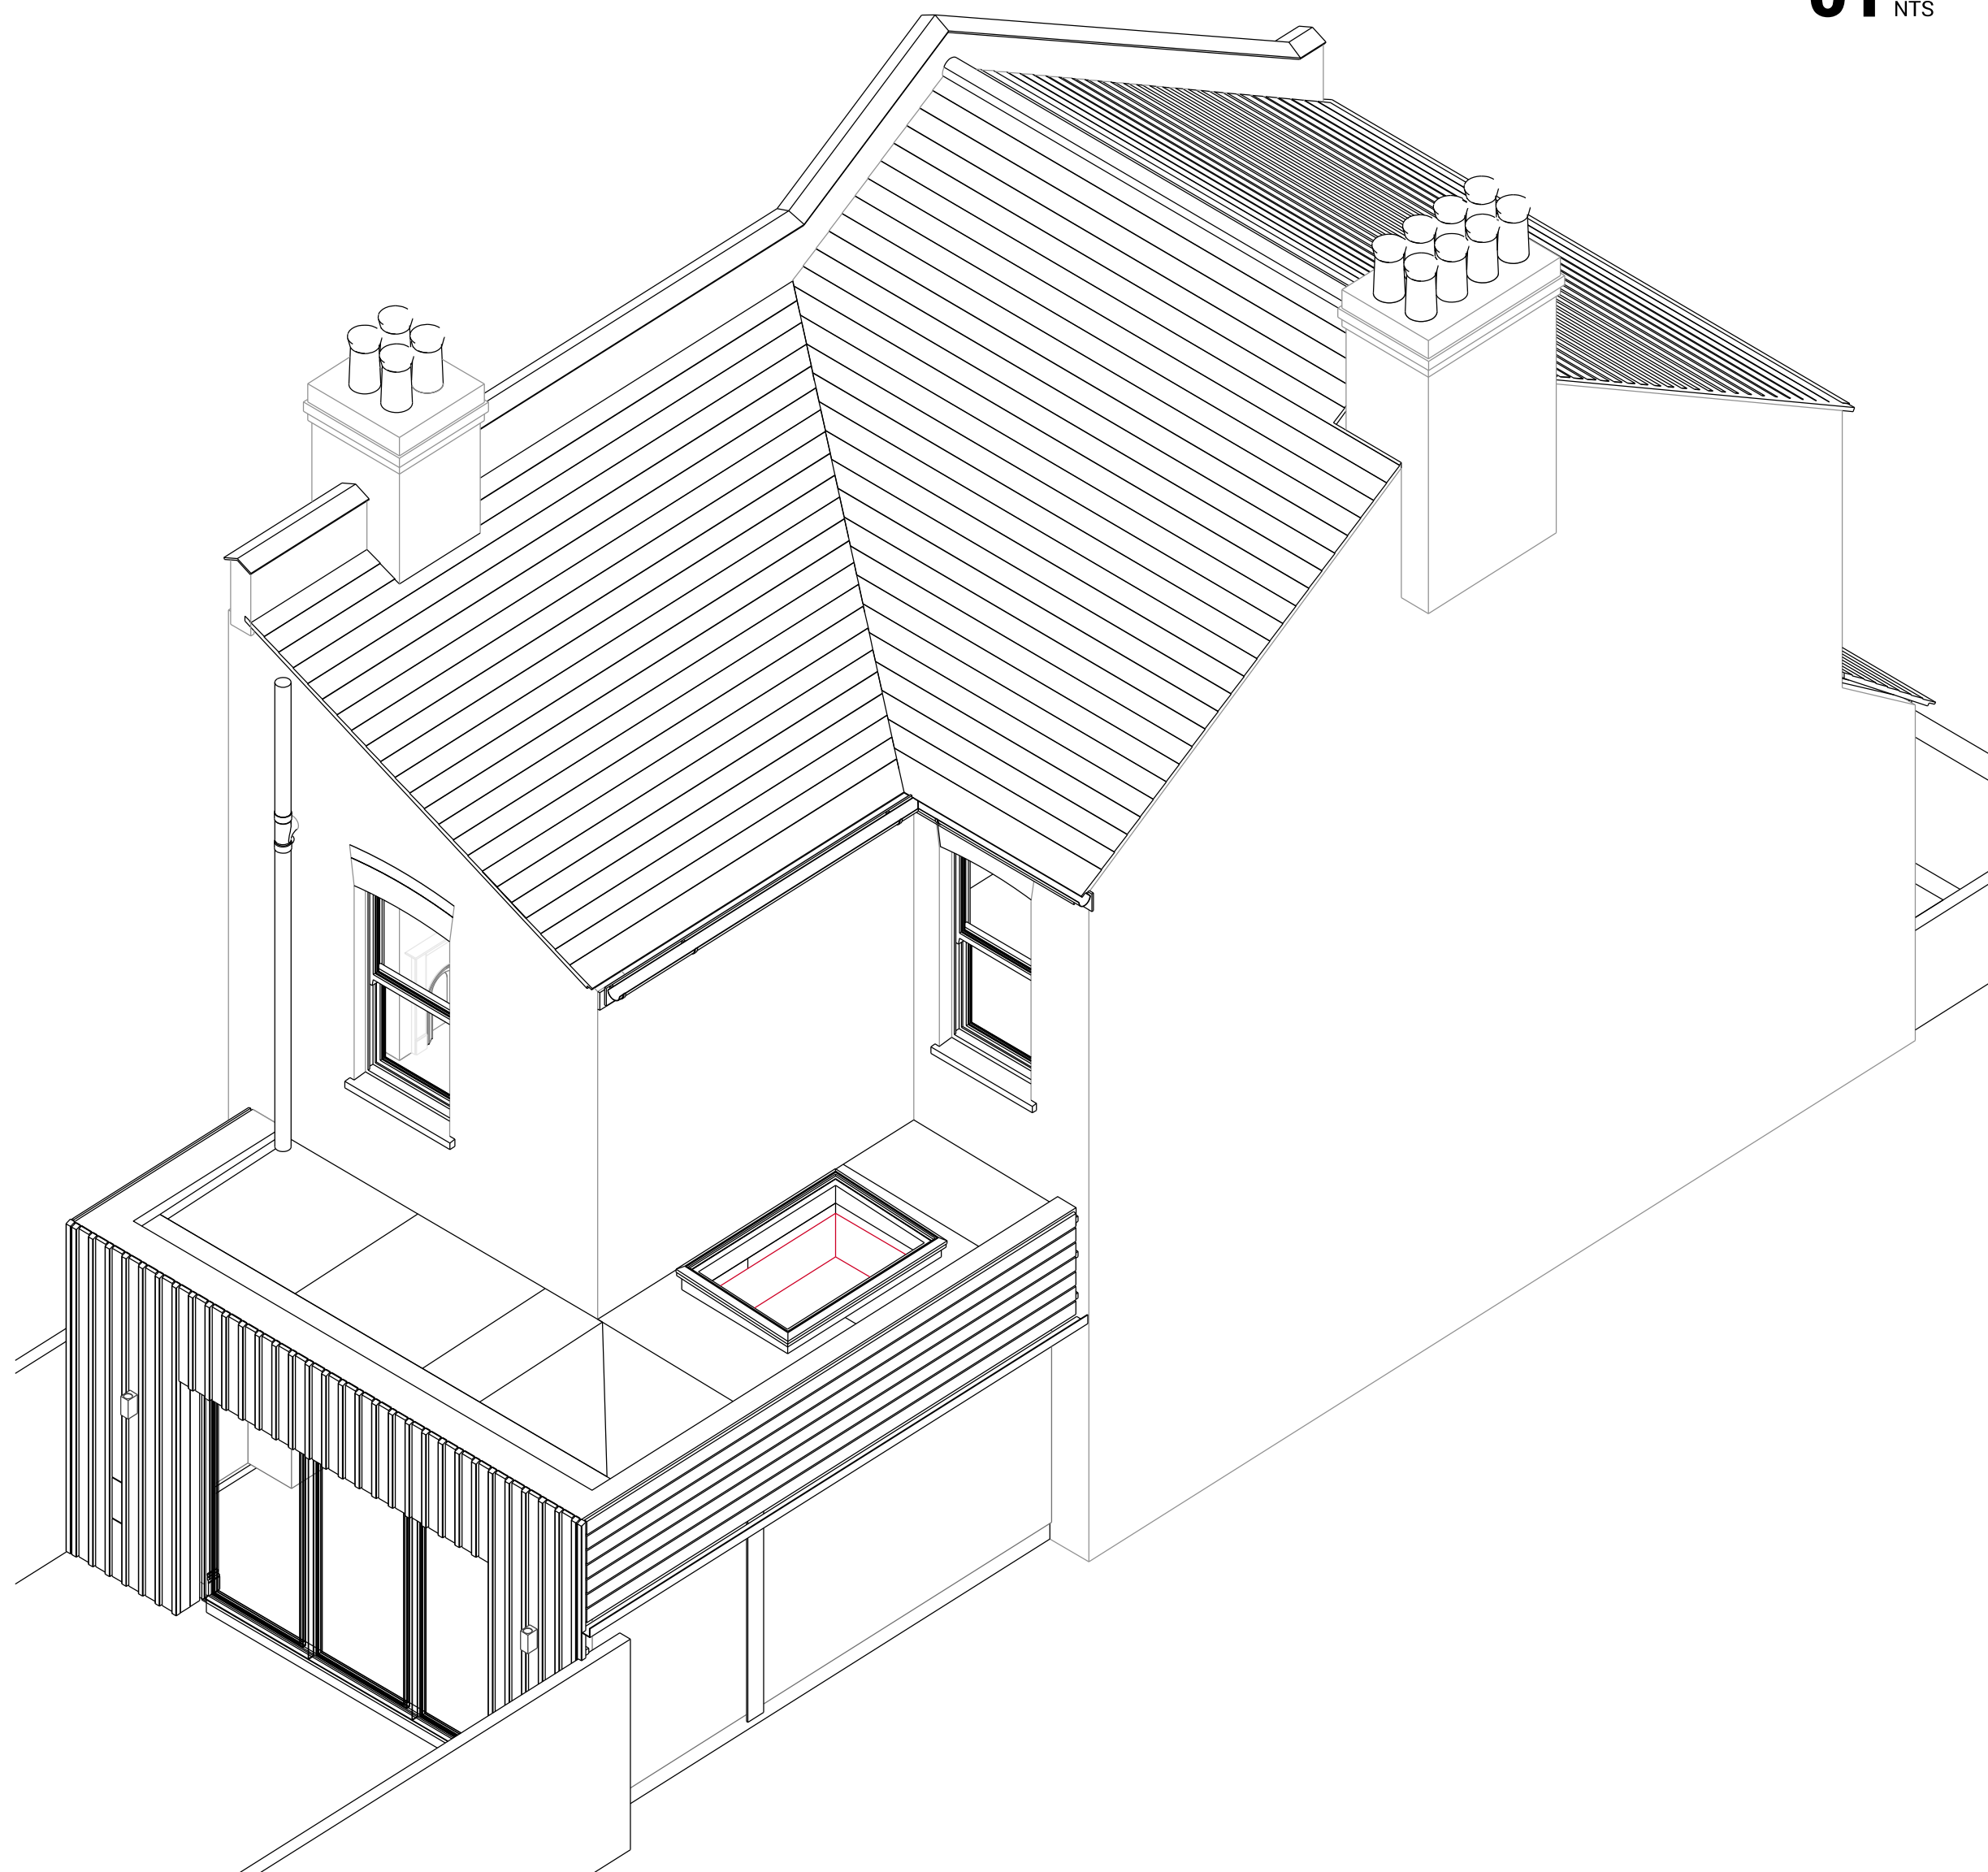

02 3D Model of Previous Volume
NTS

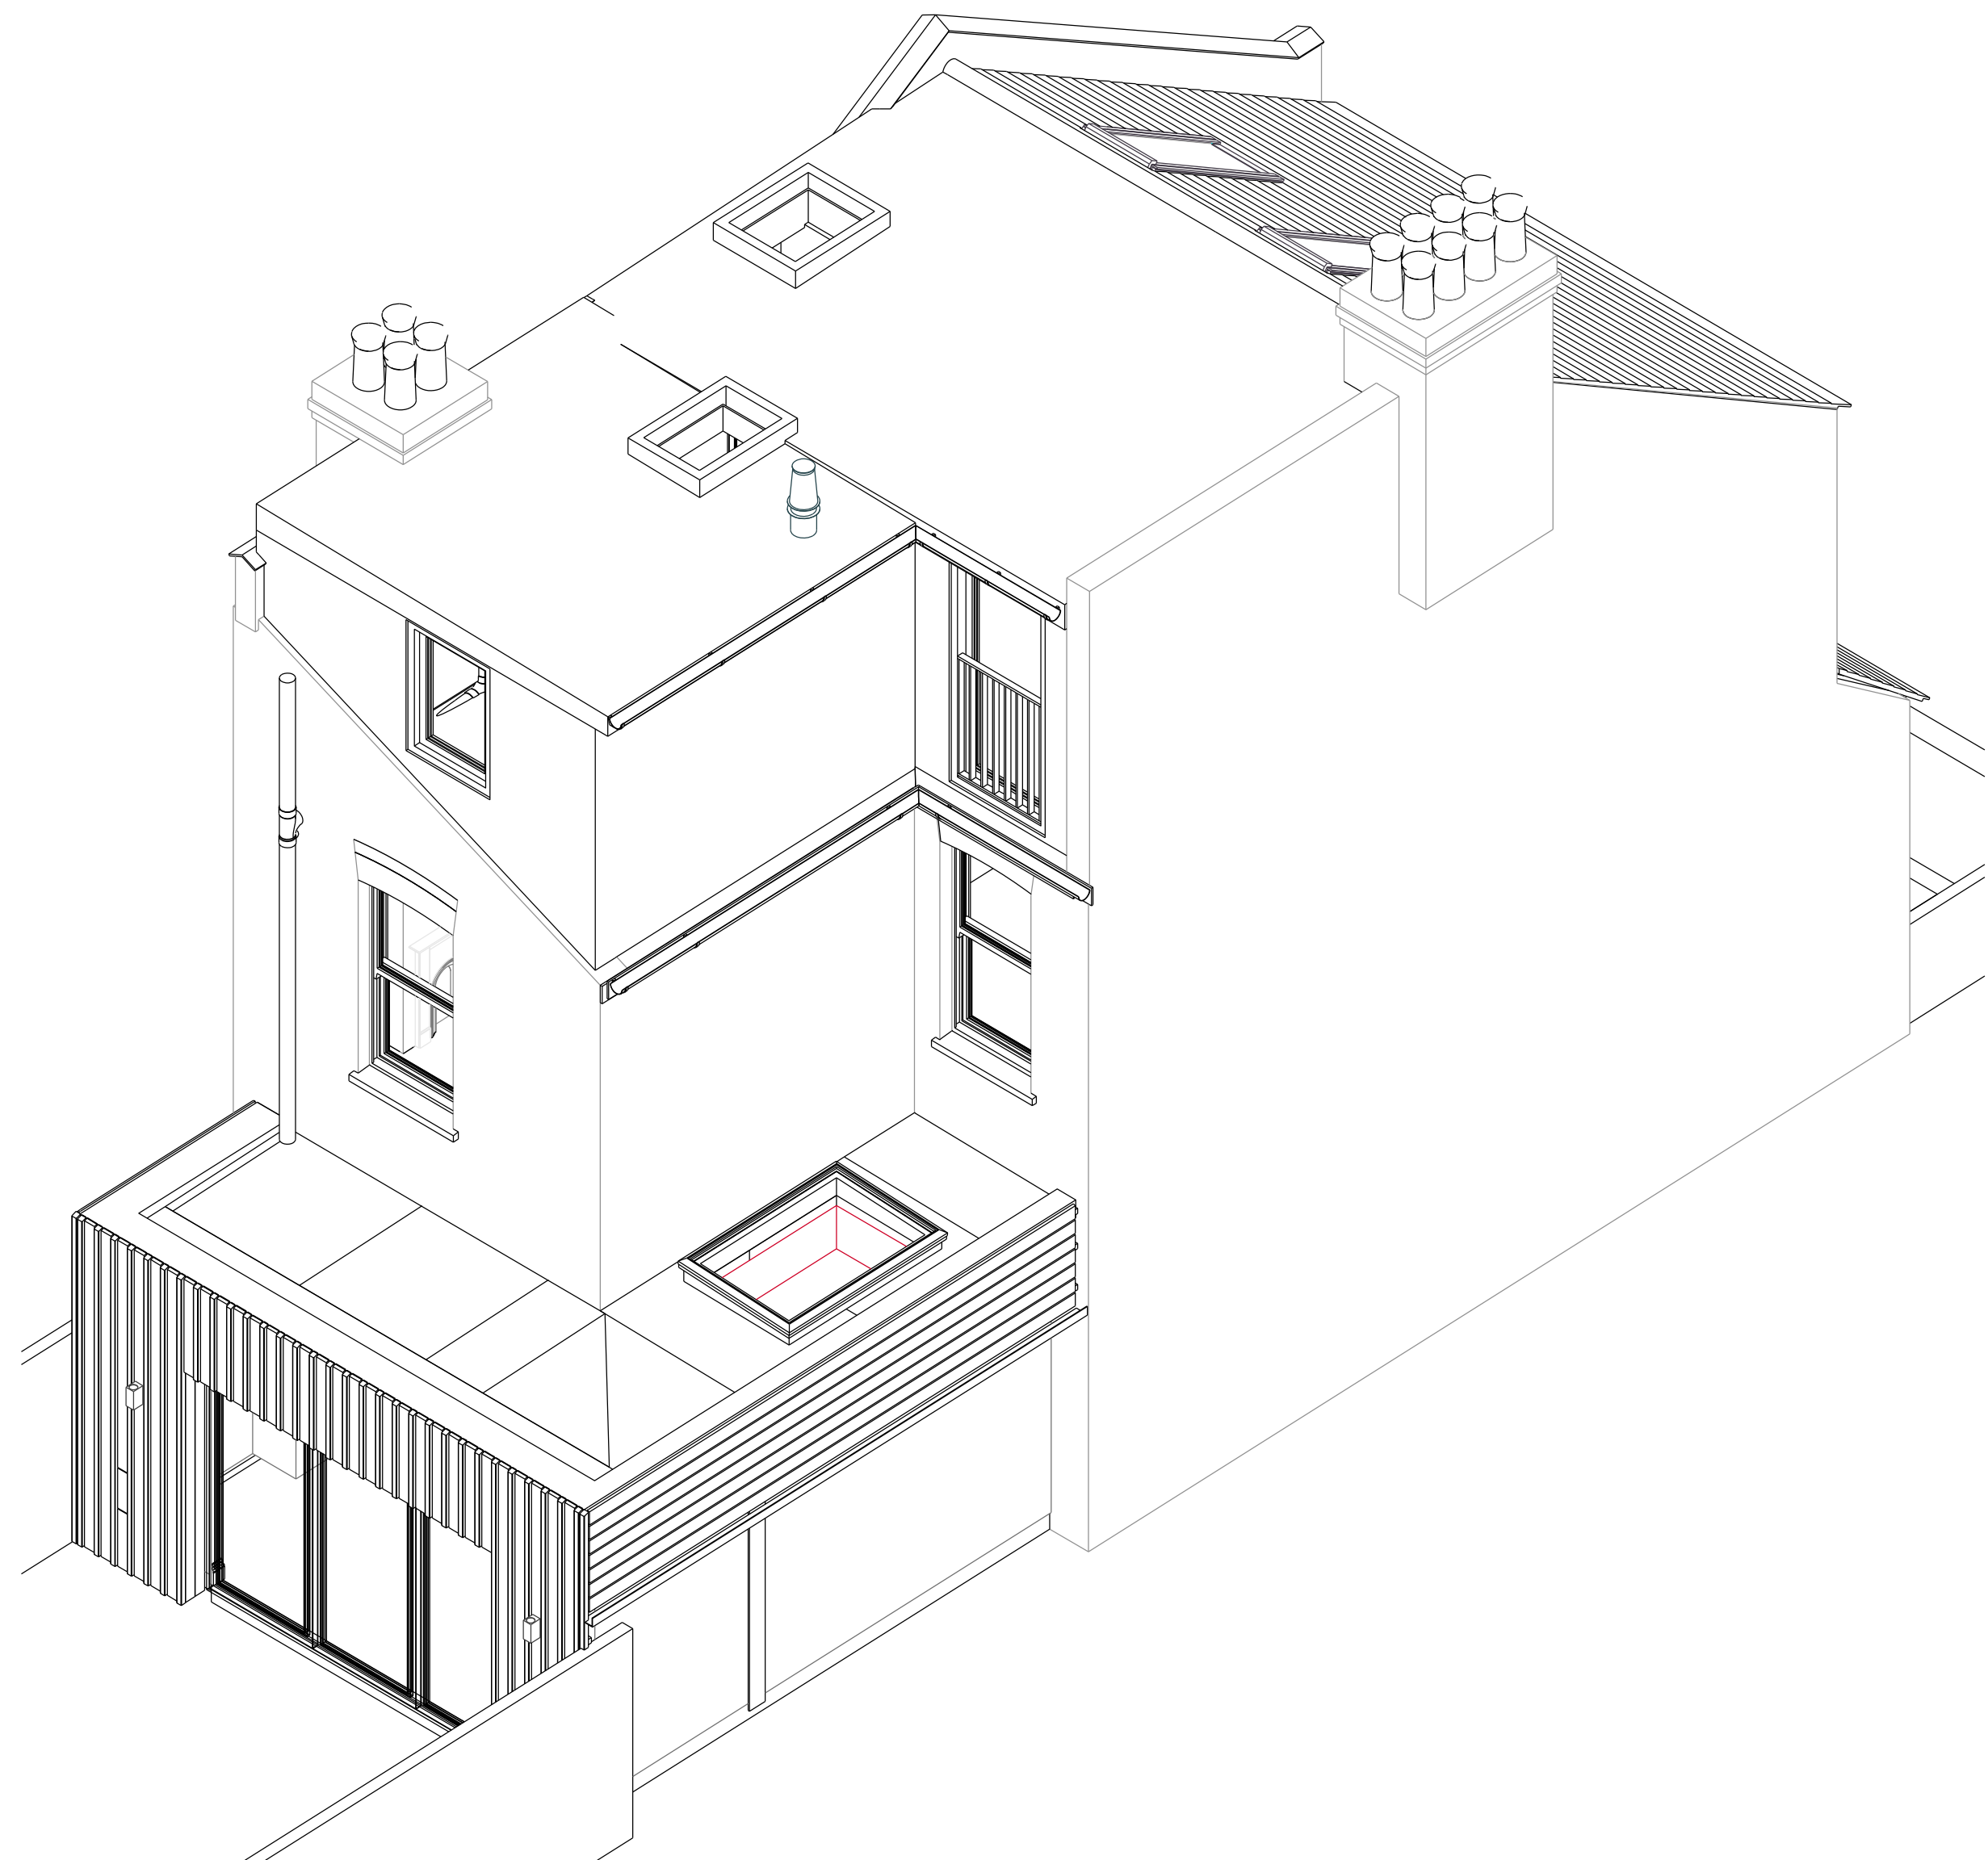

03 3D Model of Existing (As-built) Volume
NTS

R00	13.07.23	Certificate of Lawful Use	PKP
Rev	Date	Reason for Issue	Chk
Architect			
Client			
Project 62 Hanbury Road, N17 9RJ			
Drawing Title Additional Volume Calculation			
Scale 1:25 @ A1 1:50 @ A3		Project No. 23001	
Stage Planning		Revision R00	
Drawing Number CLEUD-018		Revision R00	