


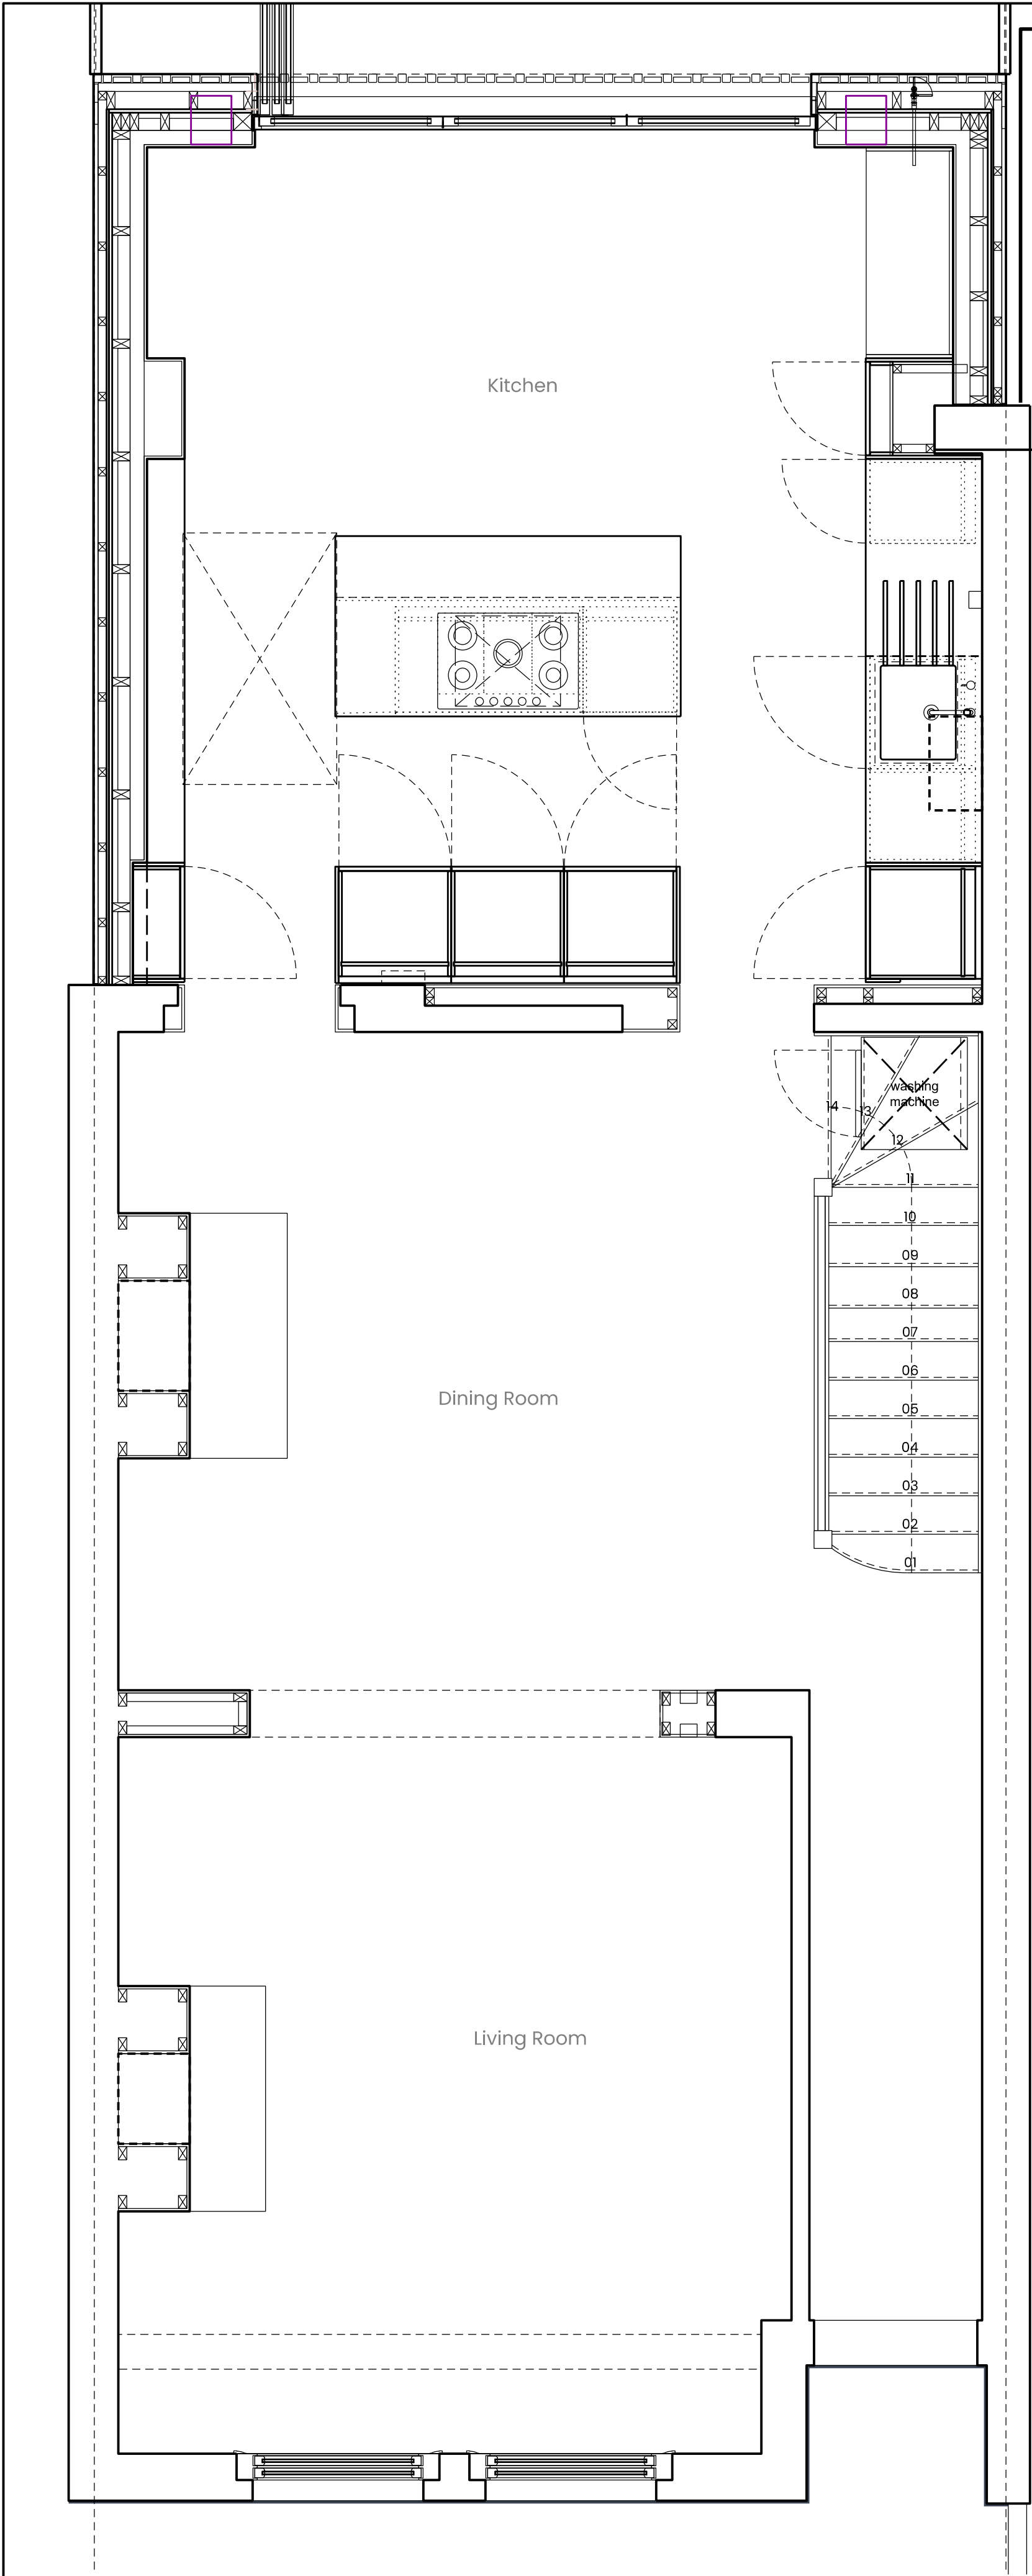


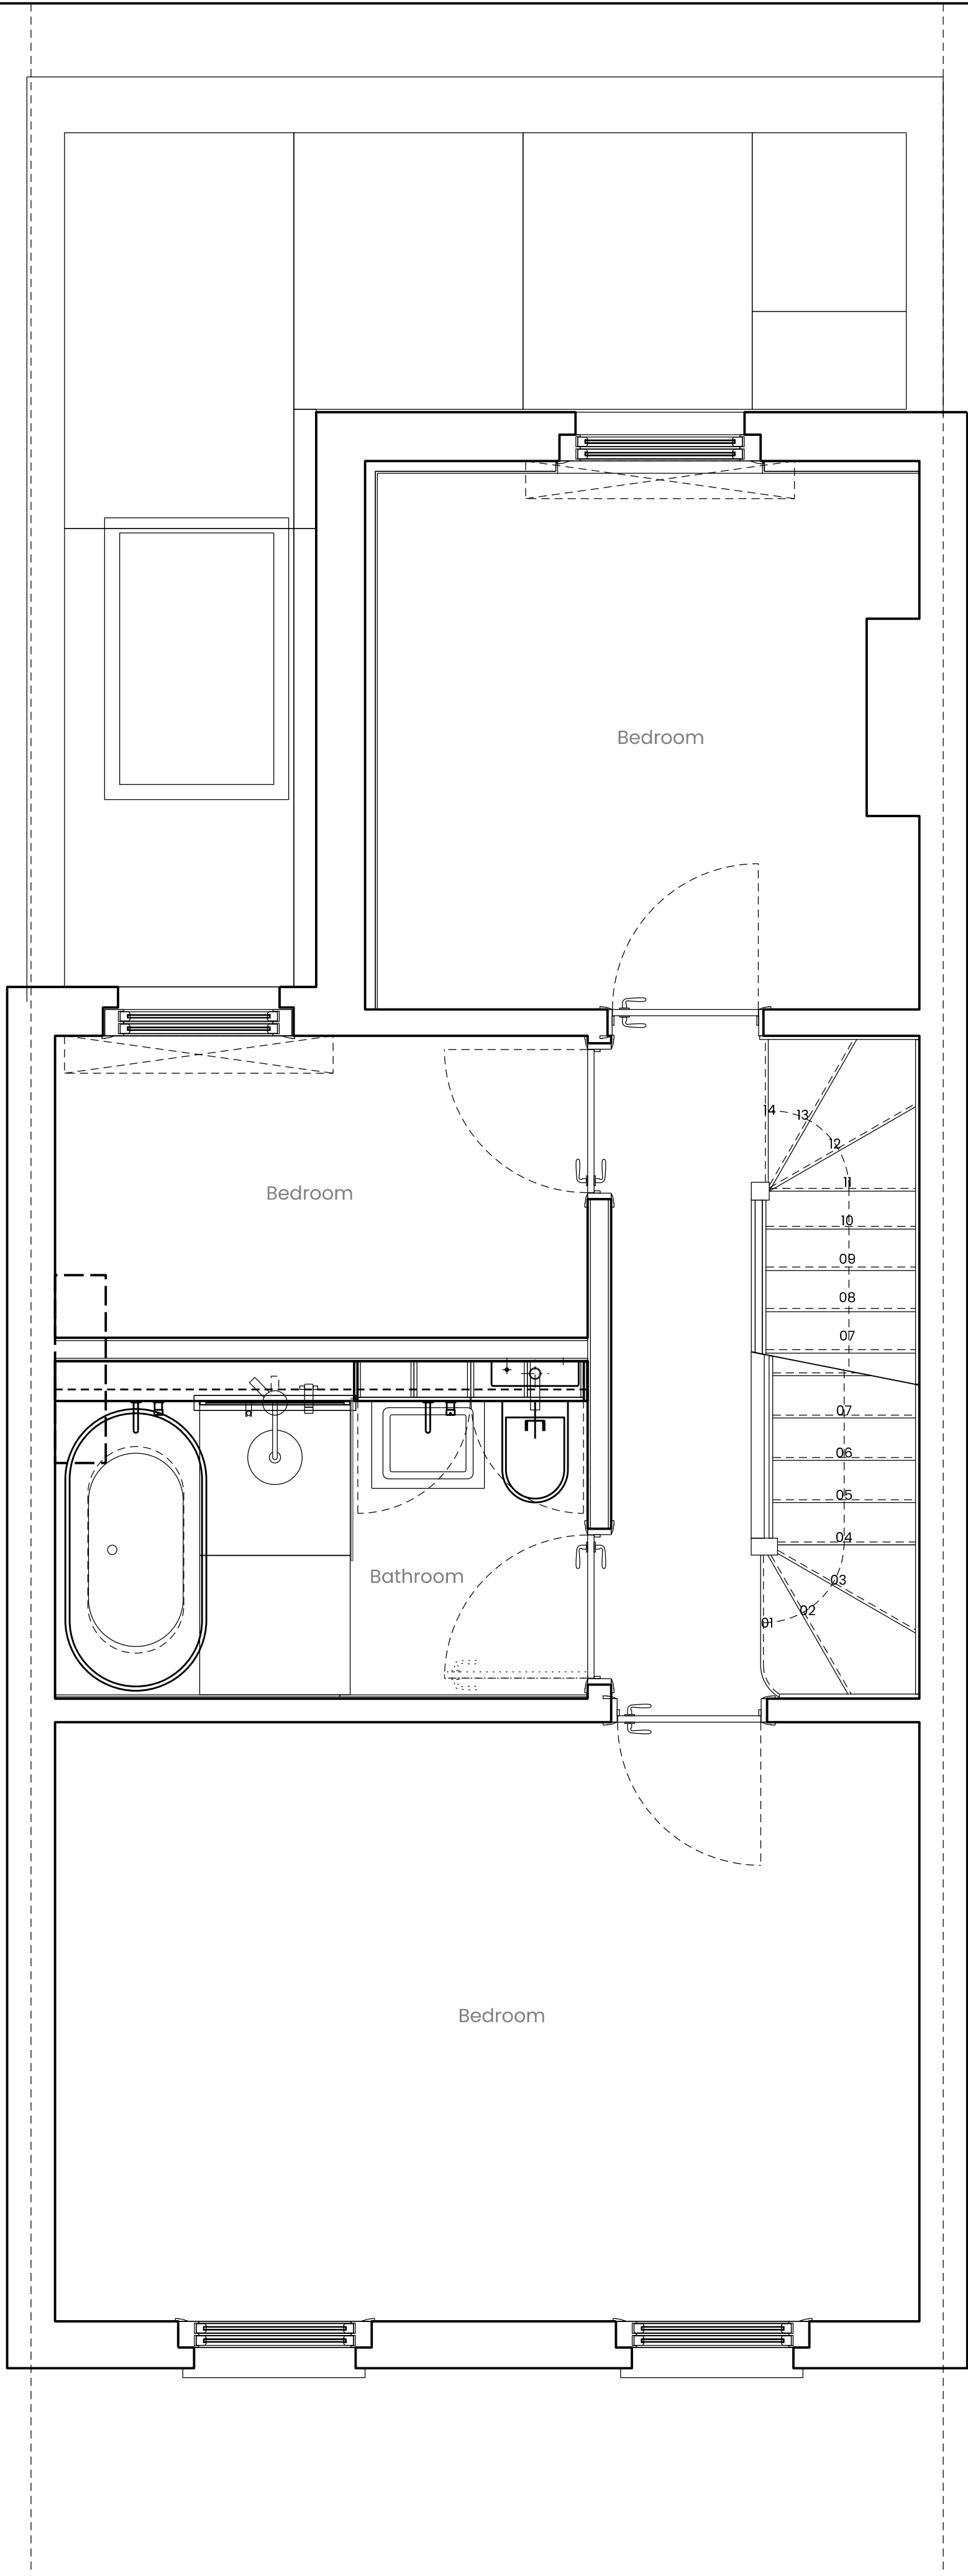

01 Existing Ground Floor Plan
1:25 @ A1 1:50 @ A3

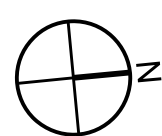

02 Existing (As-built) First Floor Plan
1:25 @ A1 1:50 @ A3

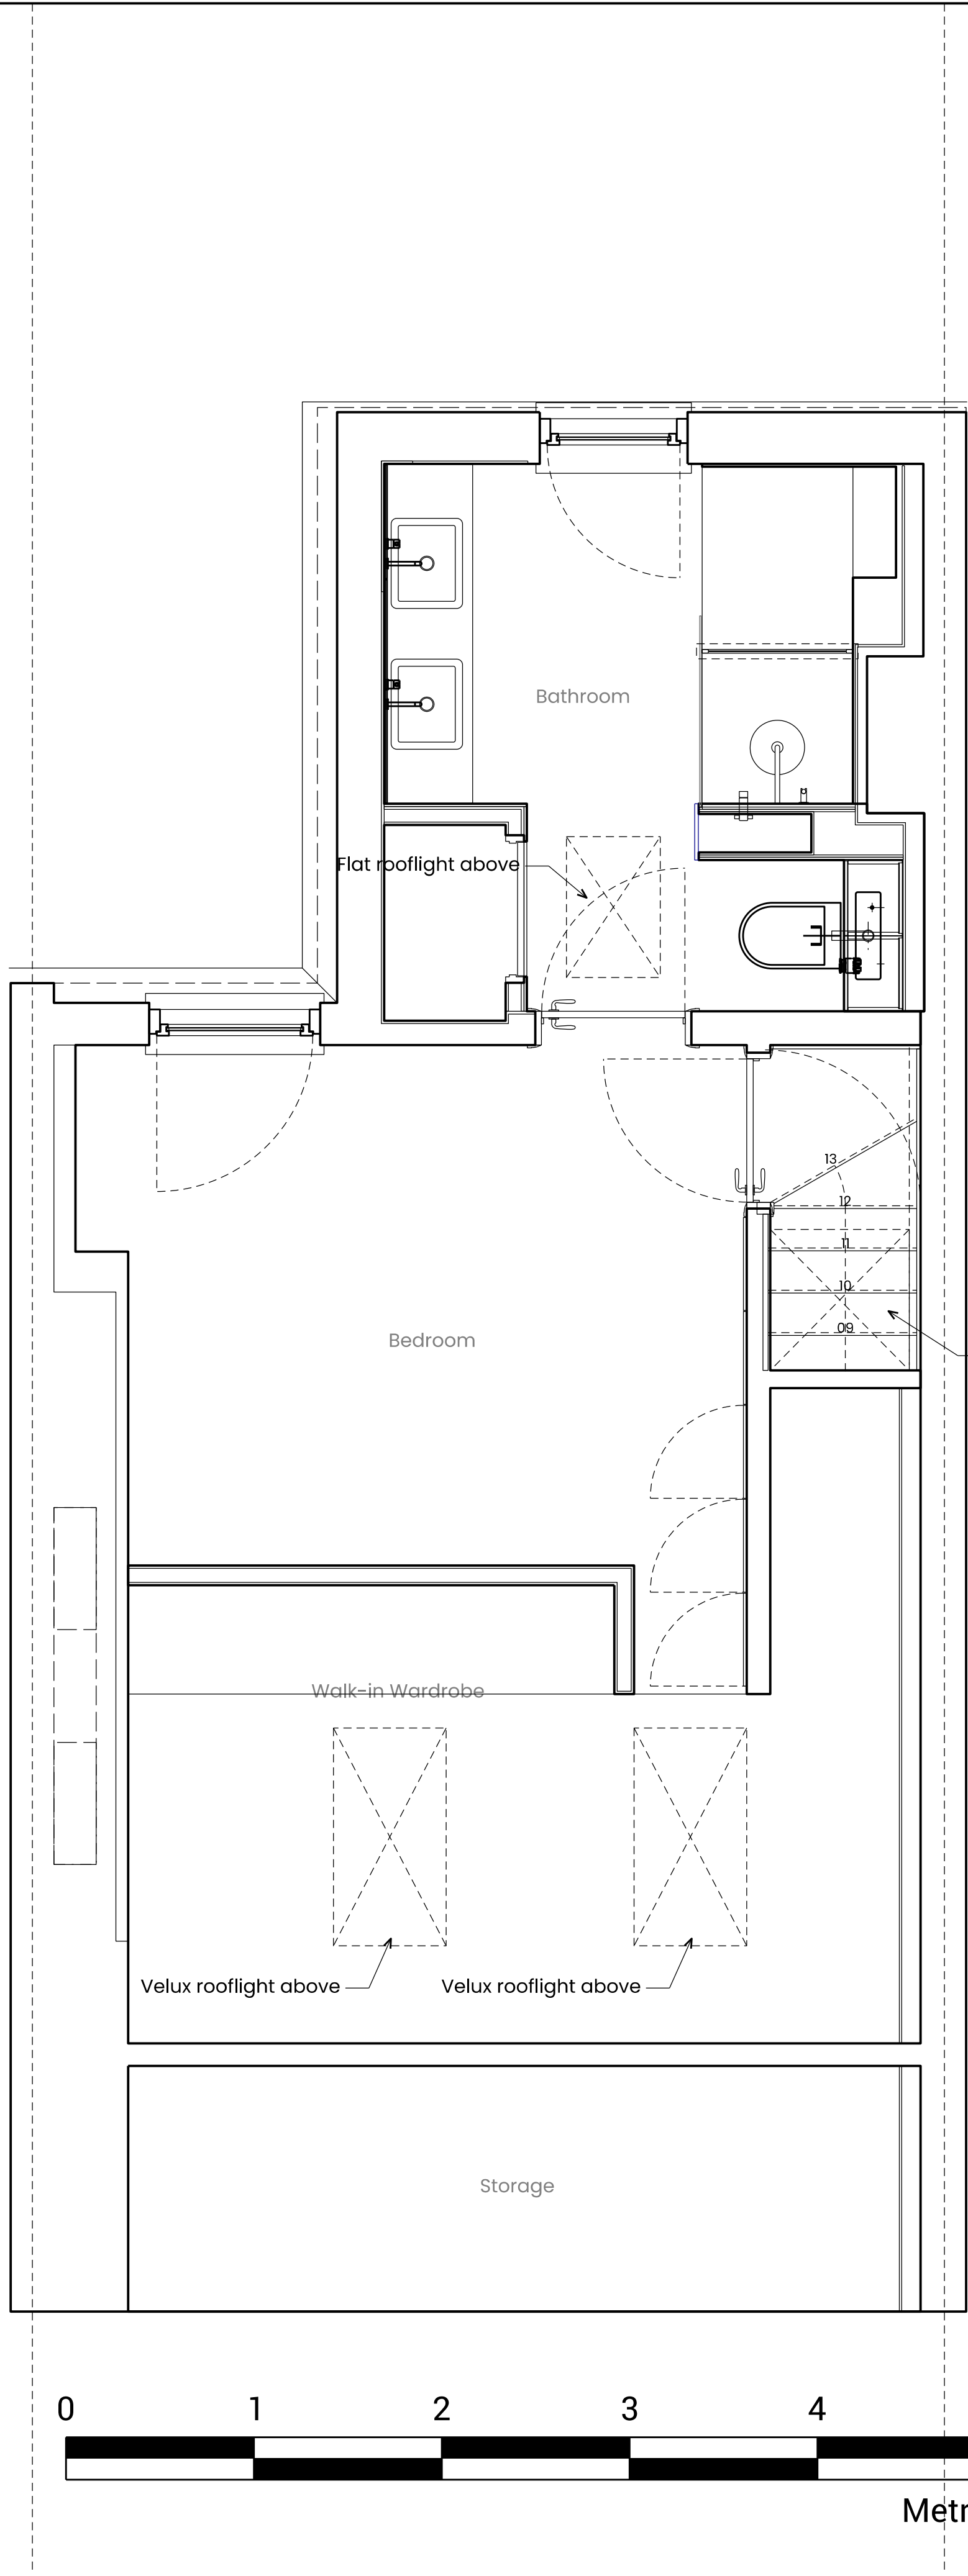

Metres

R00	13.07.23	Certificate of Lawful Use	PKP
Rev	Date	Reason for Issue	Chk
Architect			
Client			
Project 62 Hanbury Road, N17 9RJ			
Drawing Title Existing Plans Ground, First and Loft			
Scale 1:25 @ A1 1:50 @ A3		Project No. 23001	
Stage Planning		Revision R00	
Drawing Number CLEUD-013		Revision R00	