

As-Built Elevations

Sheet #
SH-12

Drawn By:
SU

Date:
17/07/2023

Scale:
1: 100
@ A1
unless
stated


As Built Elevations:
1 Stonebridge Road, Seven Sisters, London, N15 5NY



As Built Front Elevation - Scale 1: 50 £A1



As Built Rear Elevation - Scale 1: 50 @A1

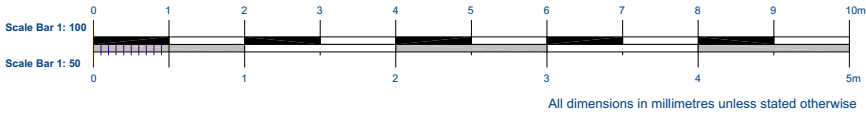

As-Built Elevations

Sheet #

SH-13

Drawn By:

SU

Date:

17/07/2023


Scale:

1: 100
@ A1
unless
stated


As Built Elevations:

1 Stonebridge Road, Seven Sisters, London, N15 5NY



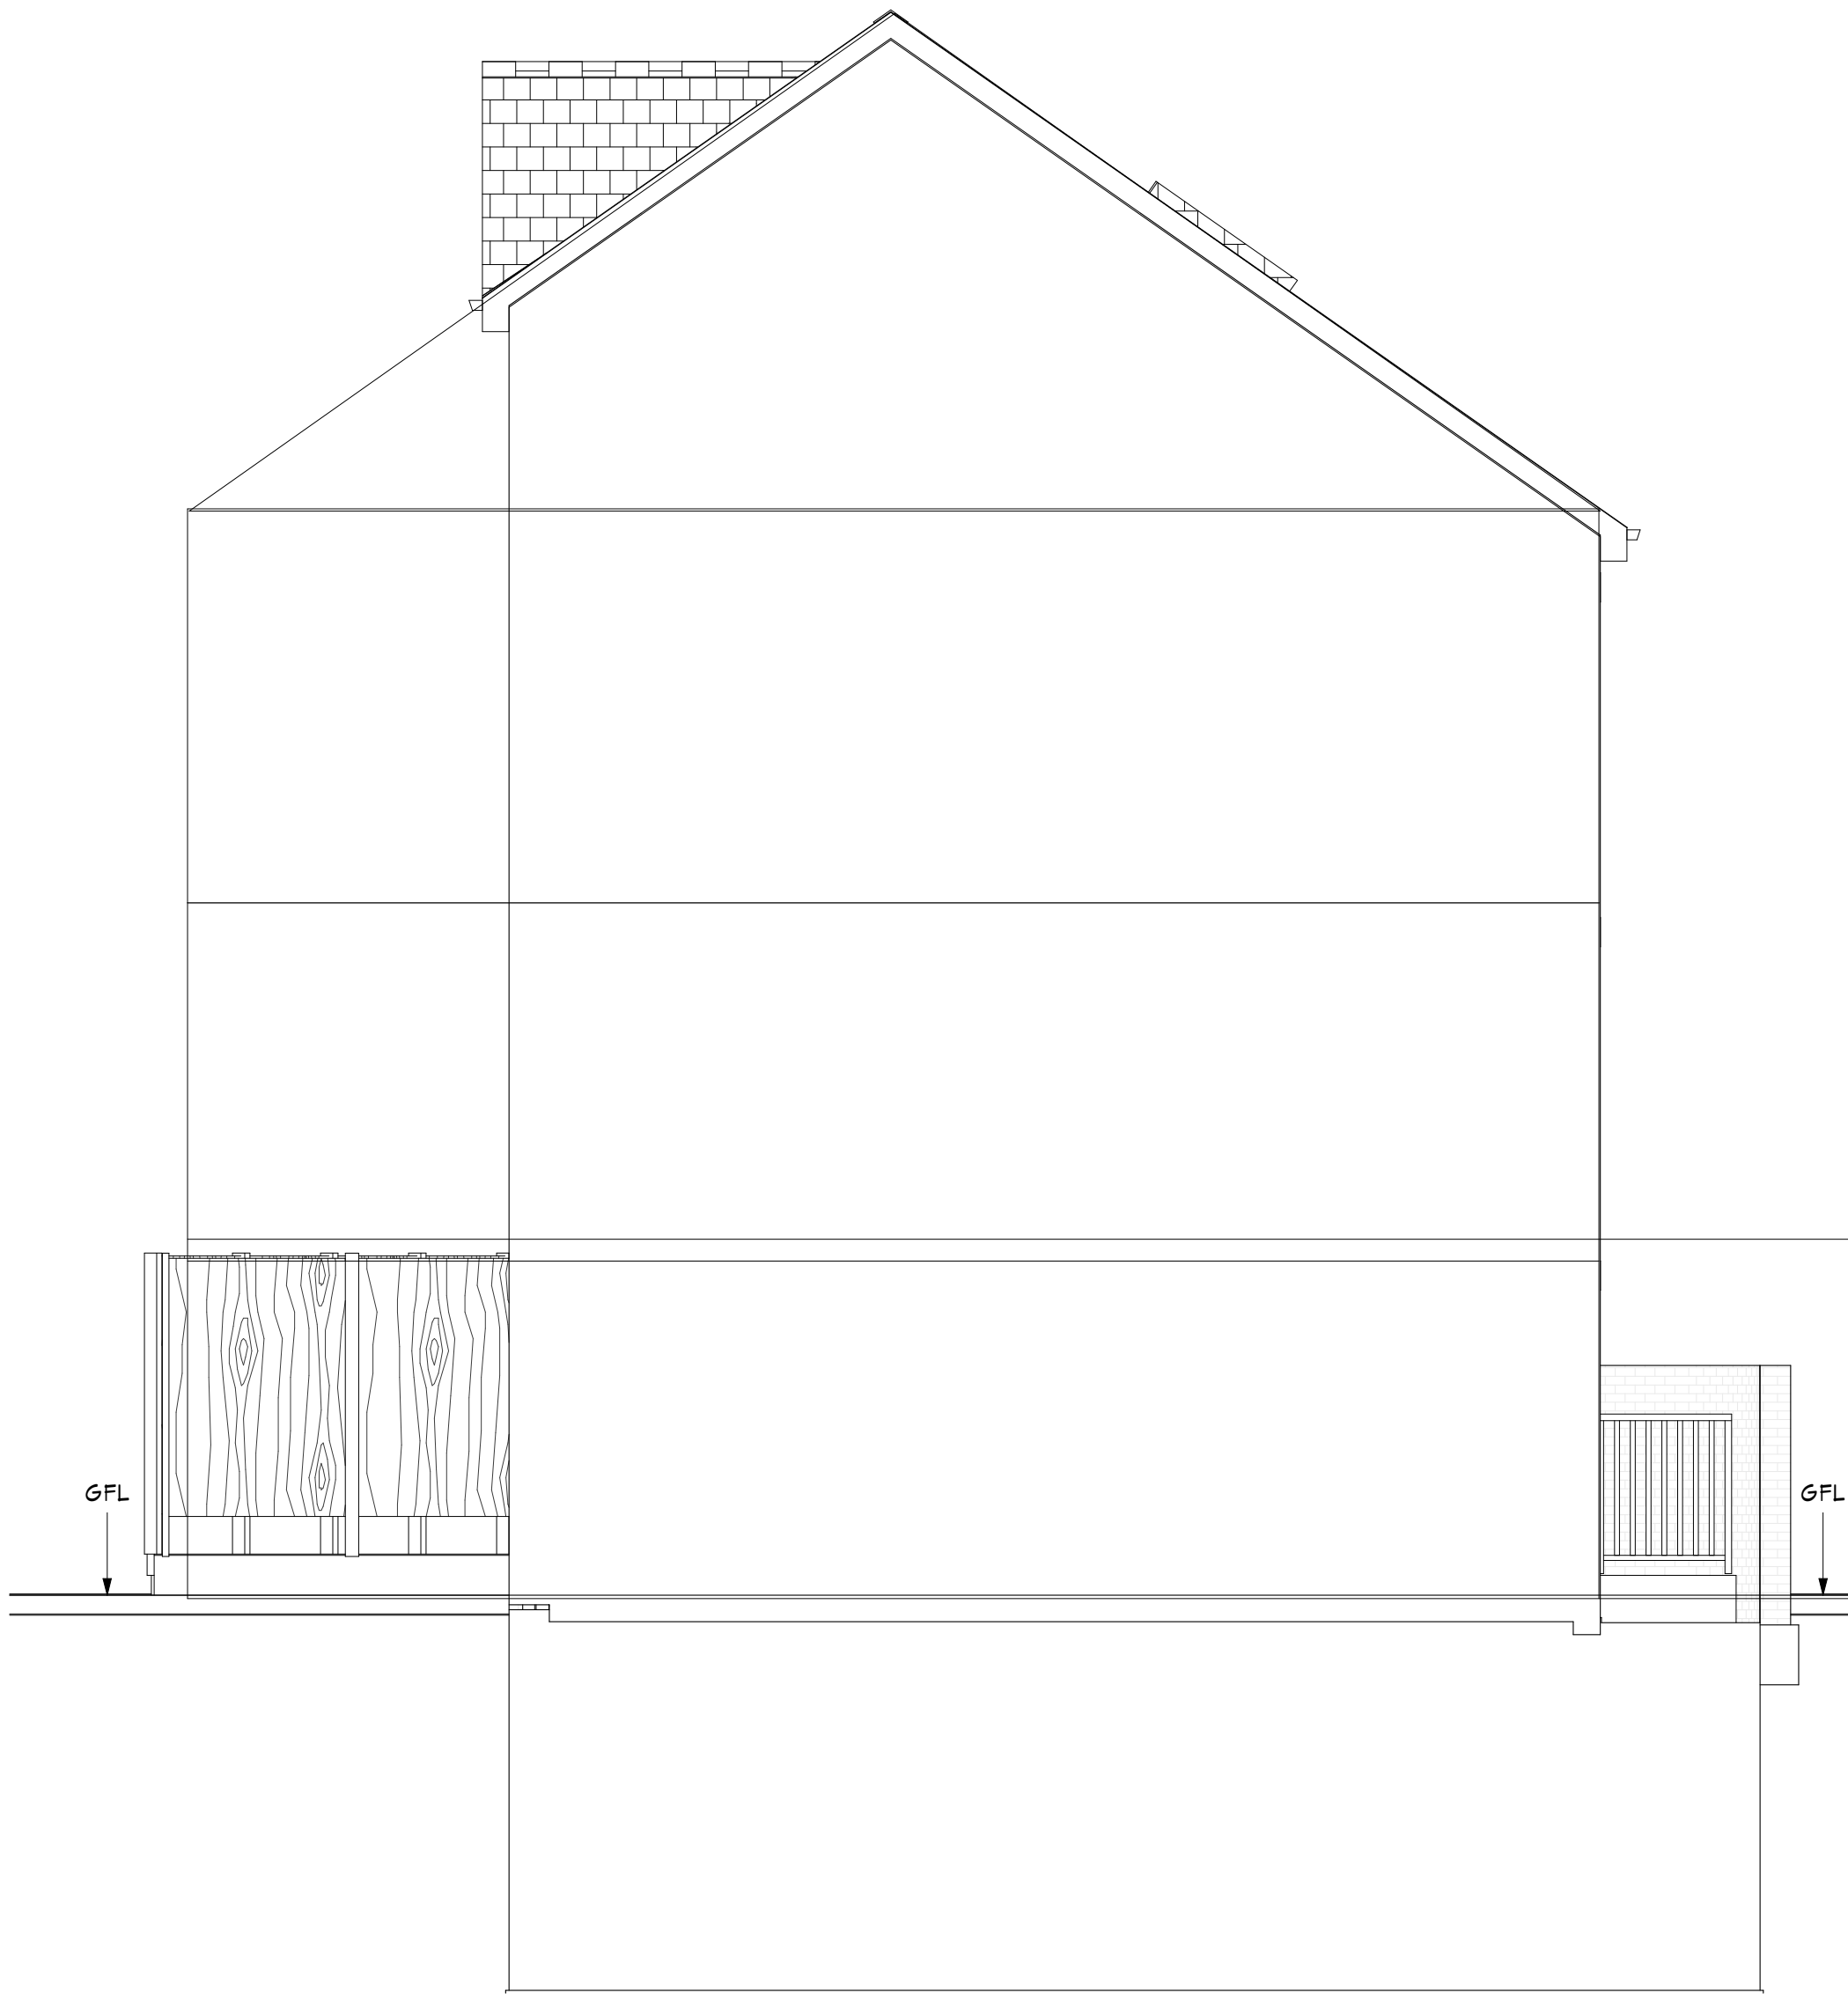

As Built Side Elevation (from no.1) - Scale 1: 50 @A1

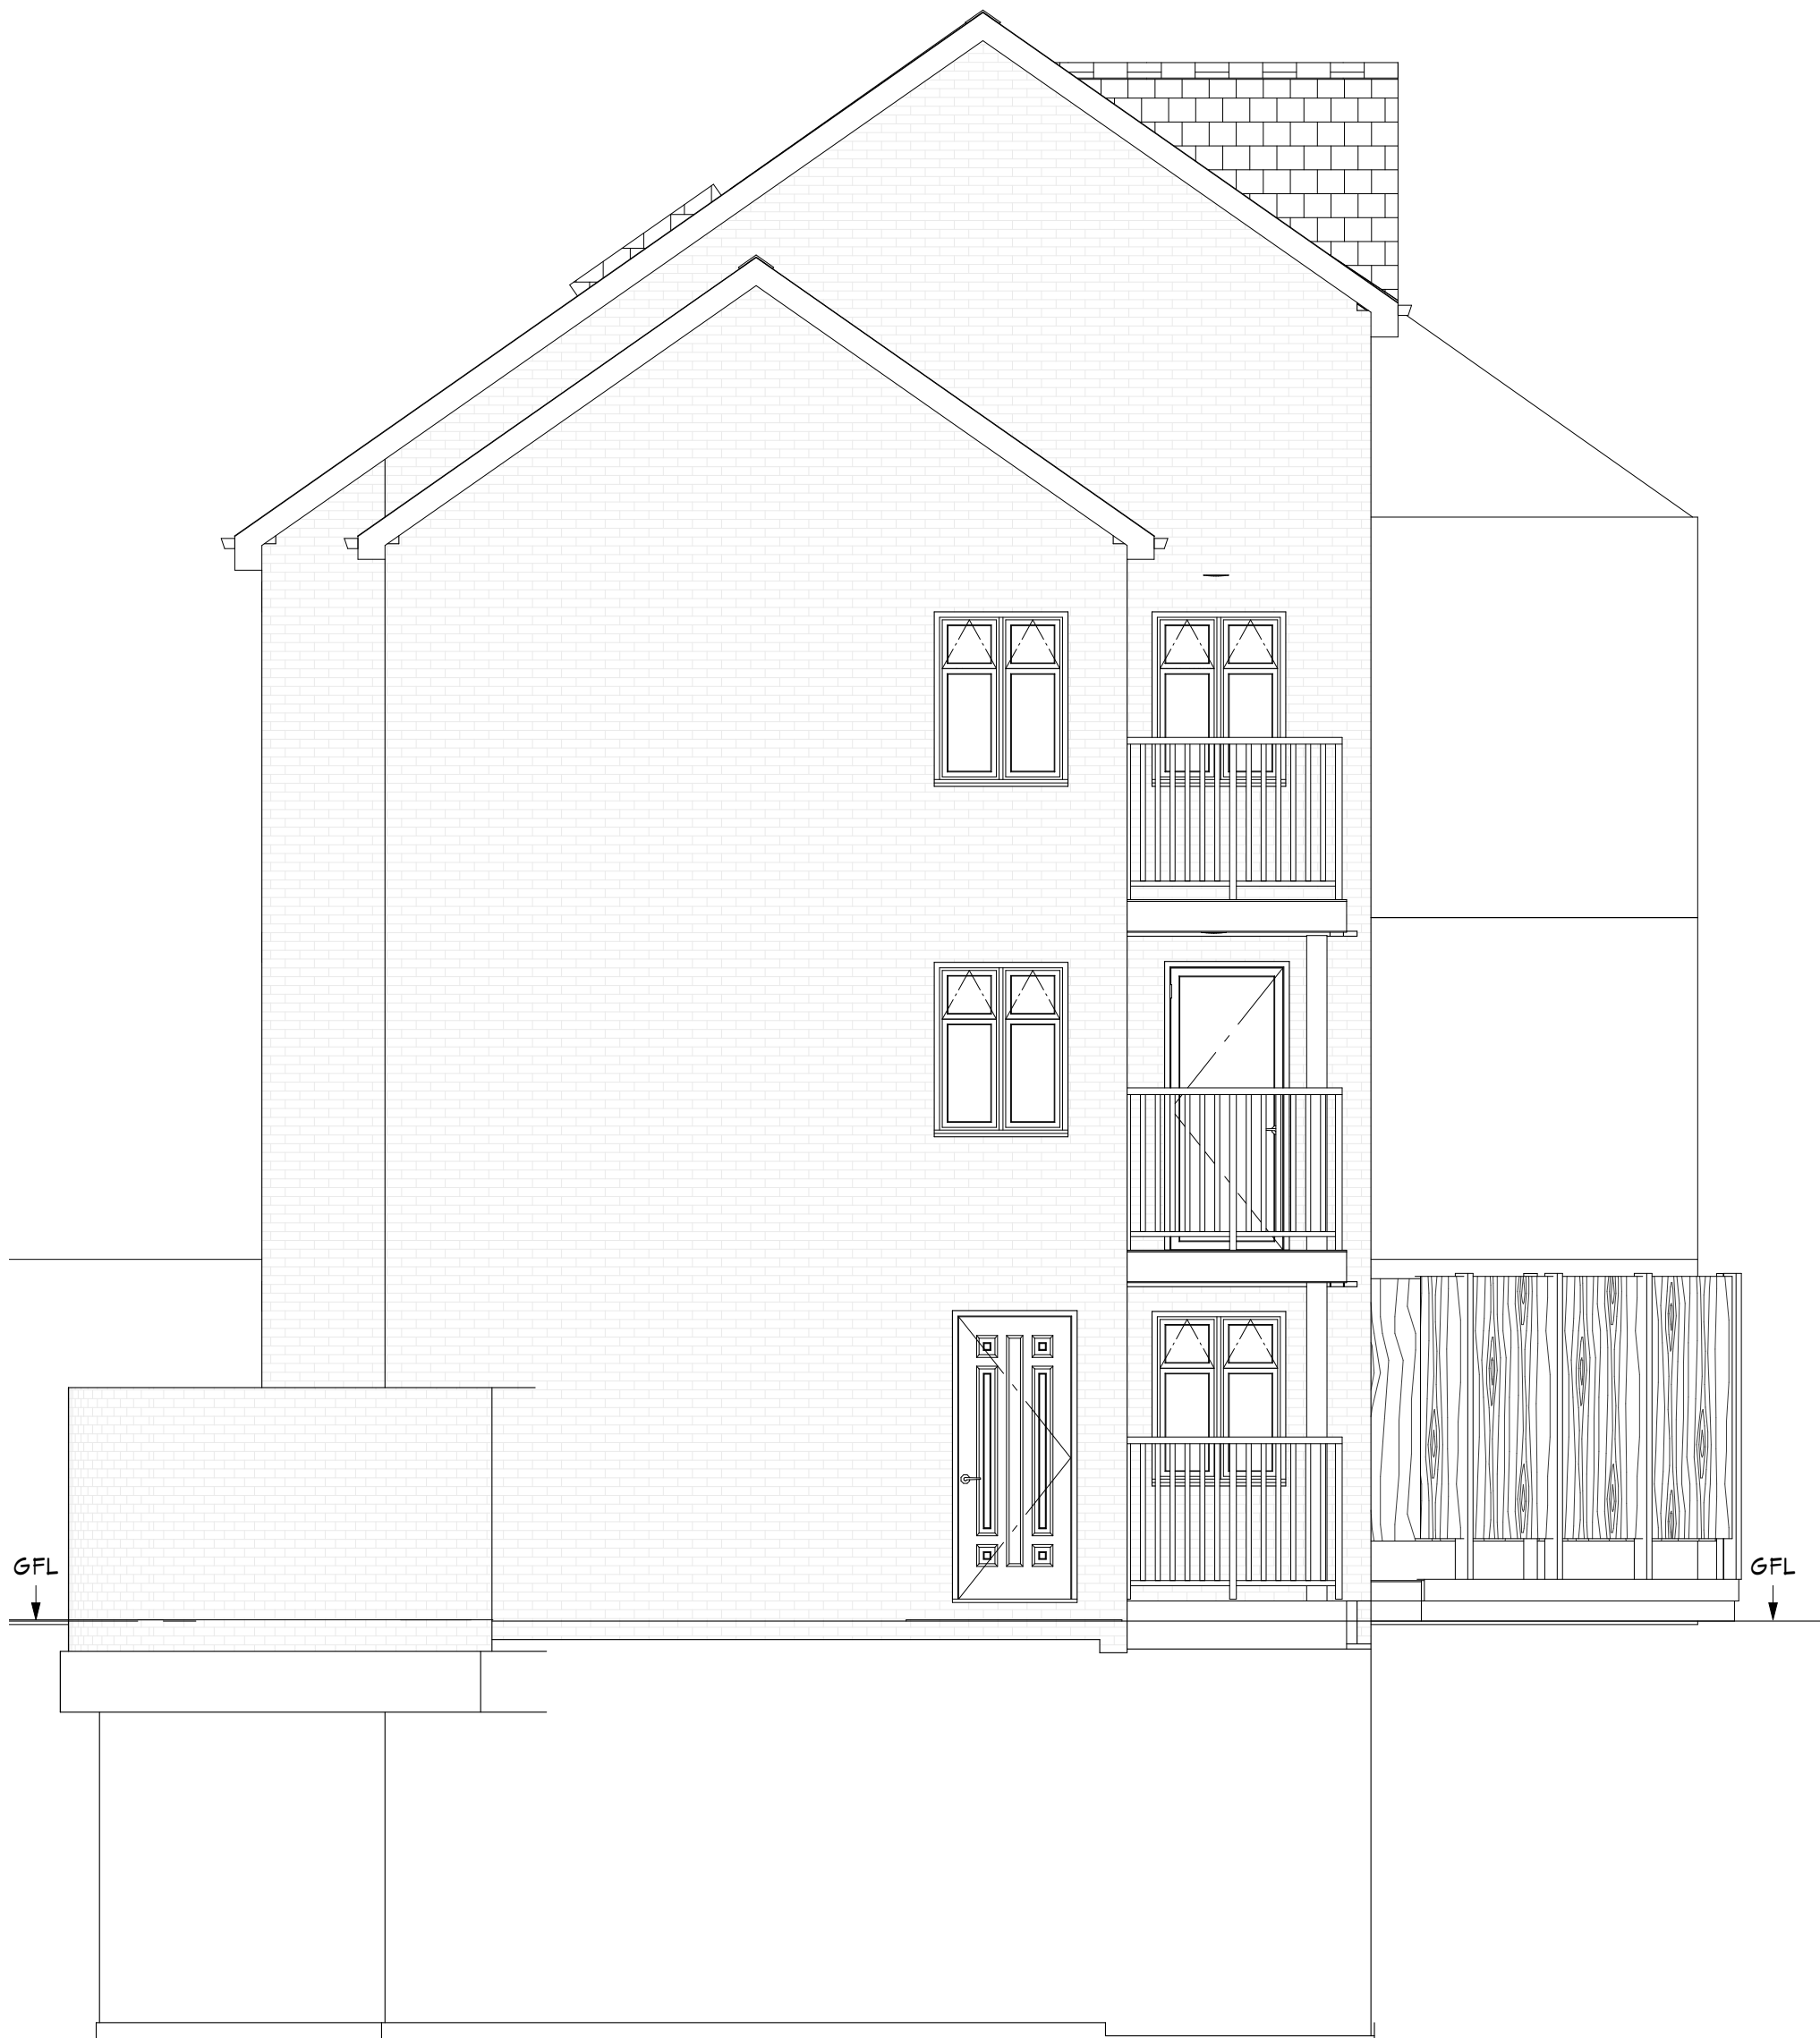

As Built Side Elevation (detached end) - Scale 1: 50 @A1

