

As-Built Section Elevations

Sheet #
SH-14


Drawn By:
SU

Date:
17/07/2023


Scale:
1: 100
@ A1
unless
stated

As Built Elevations:
1 Stonebridge Road, Seven Sisters, London, N15 5NY



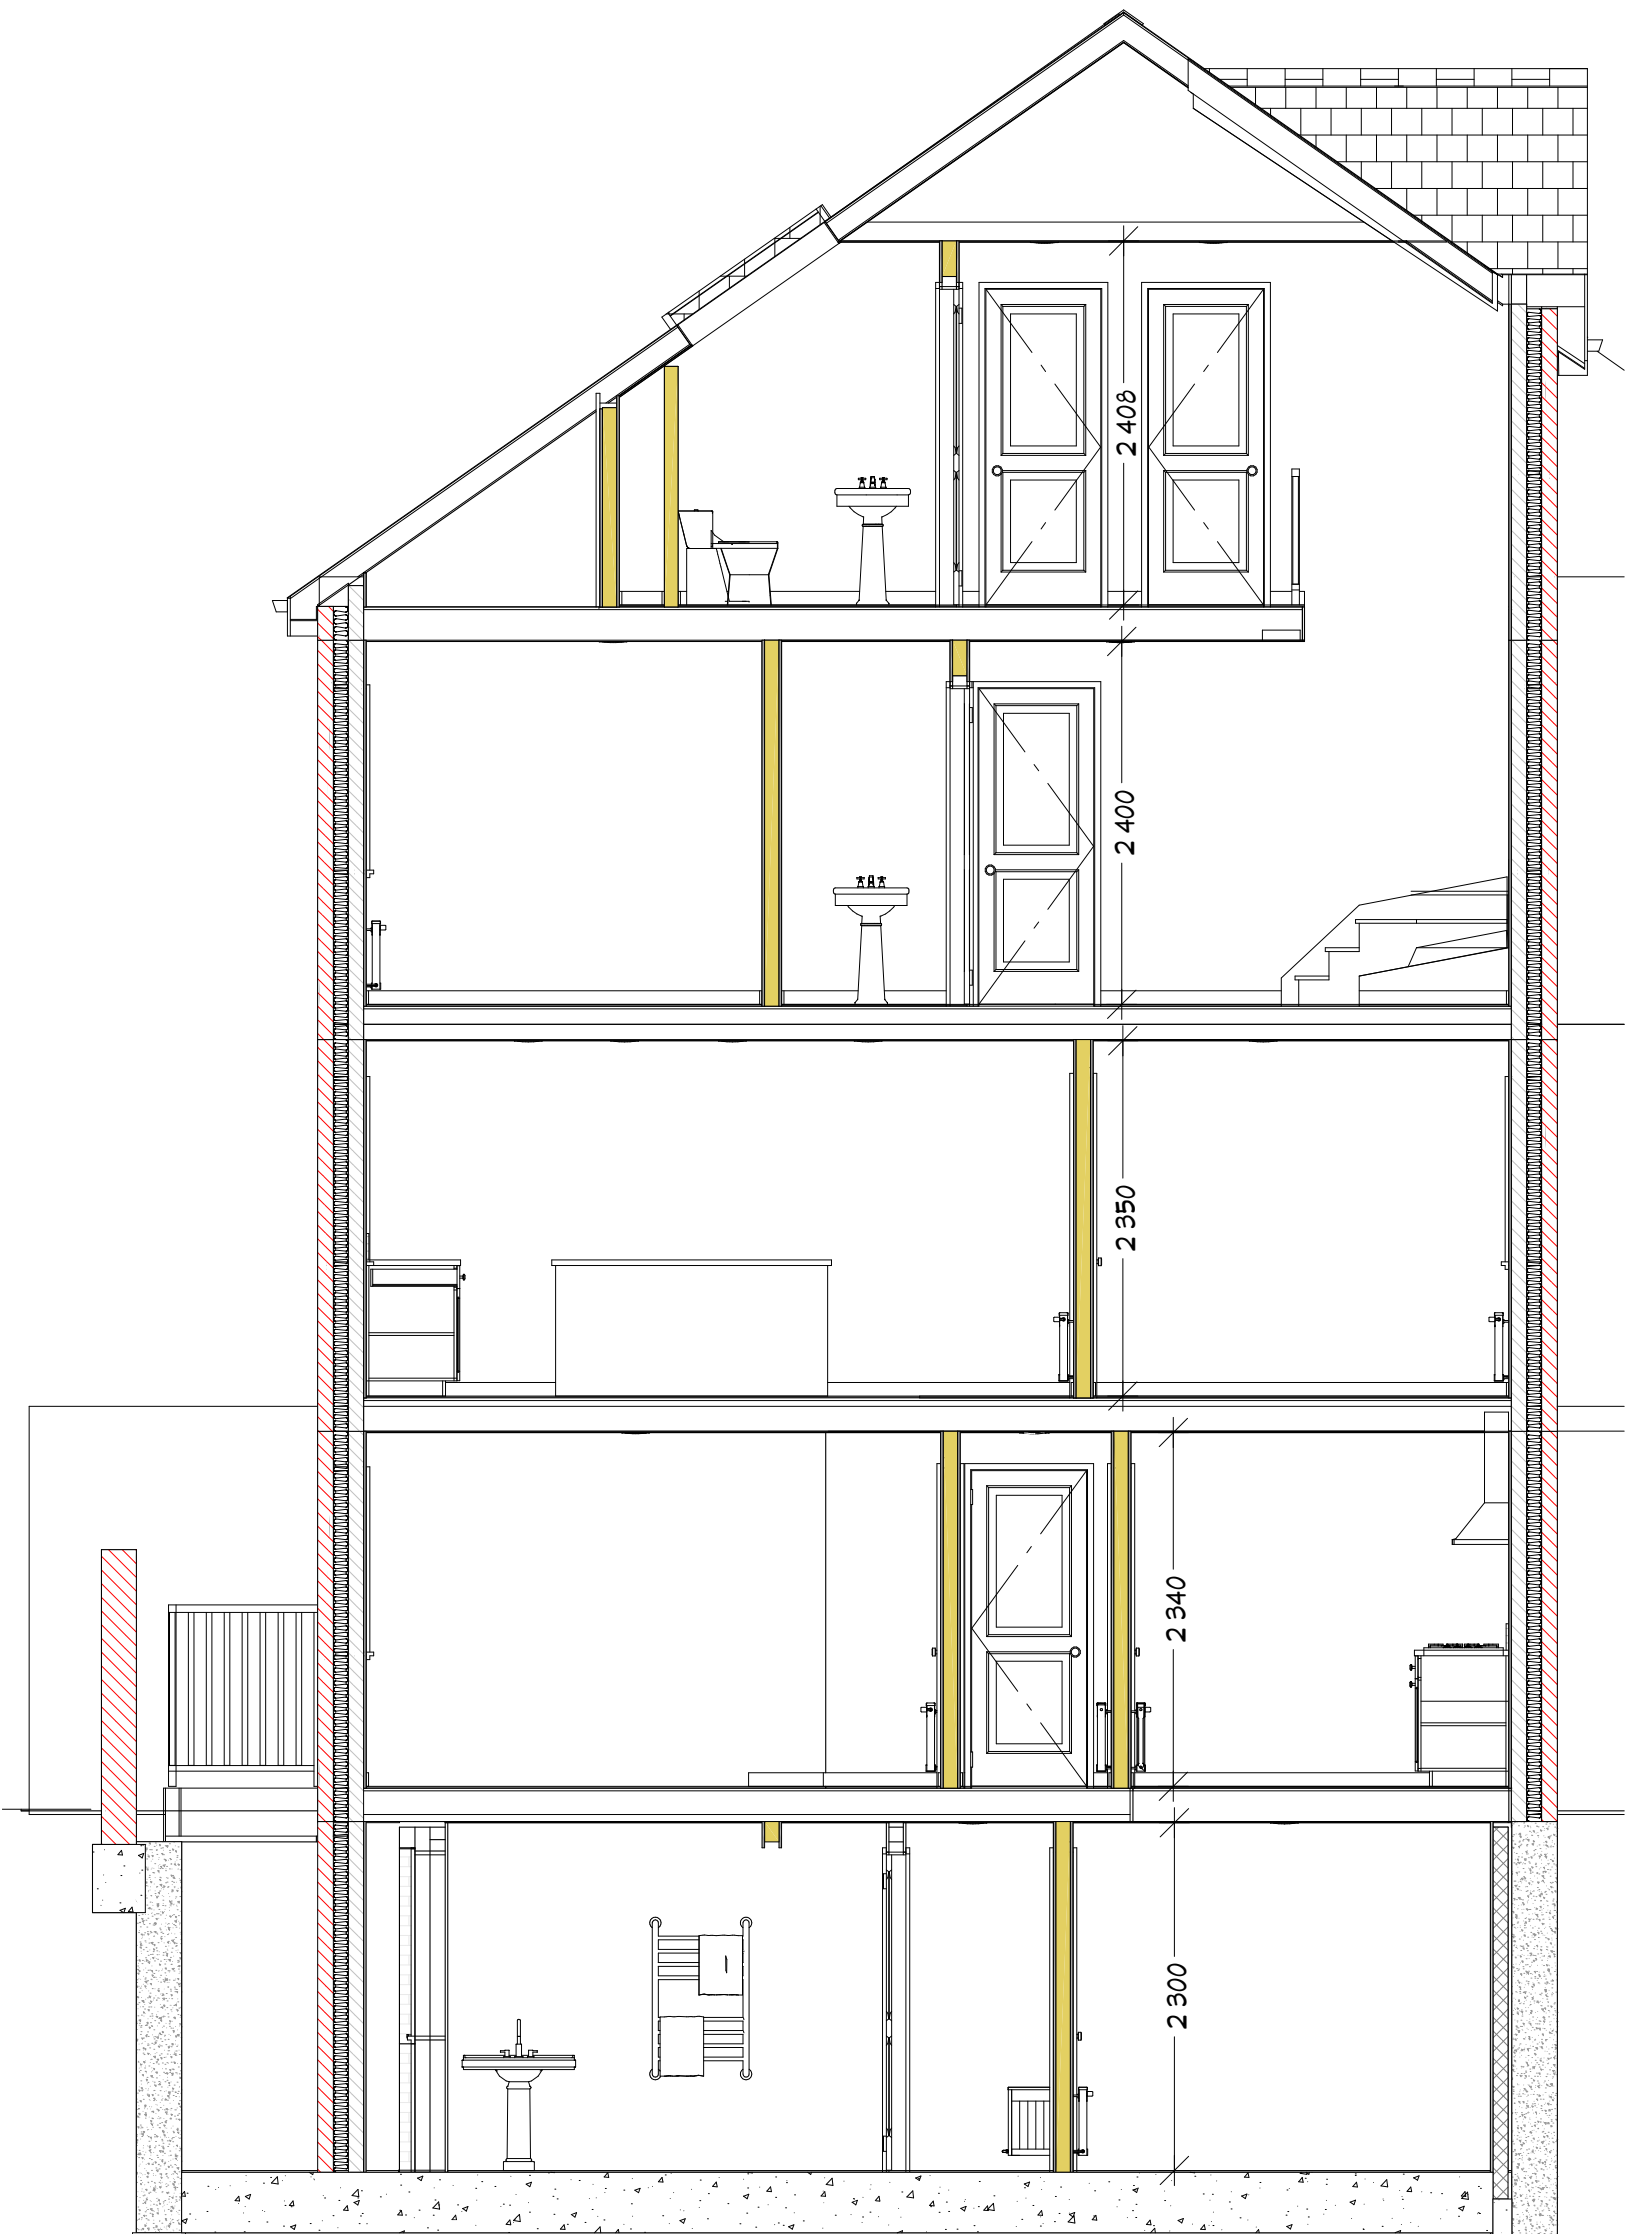

Section AA - Scale 1: 50 @A1

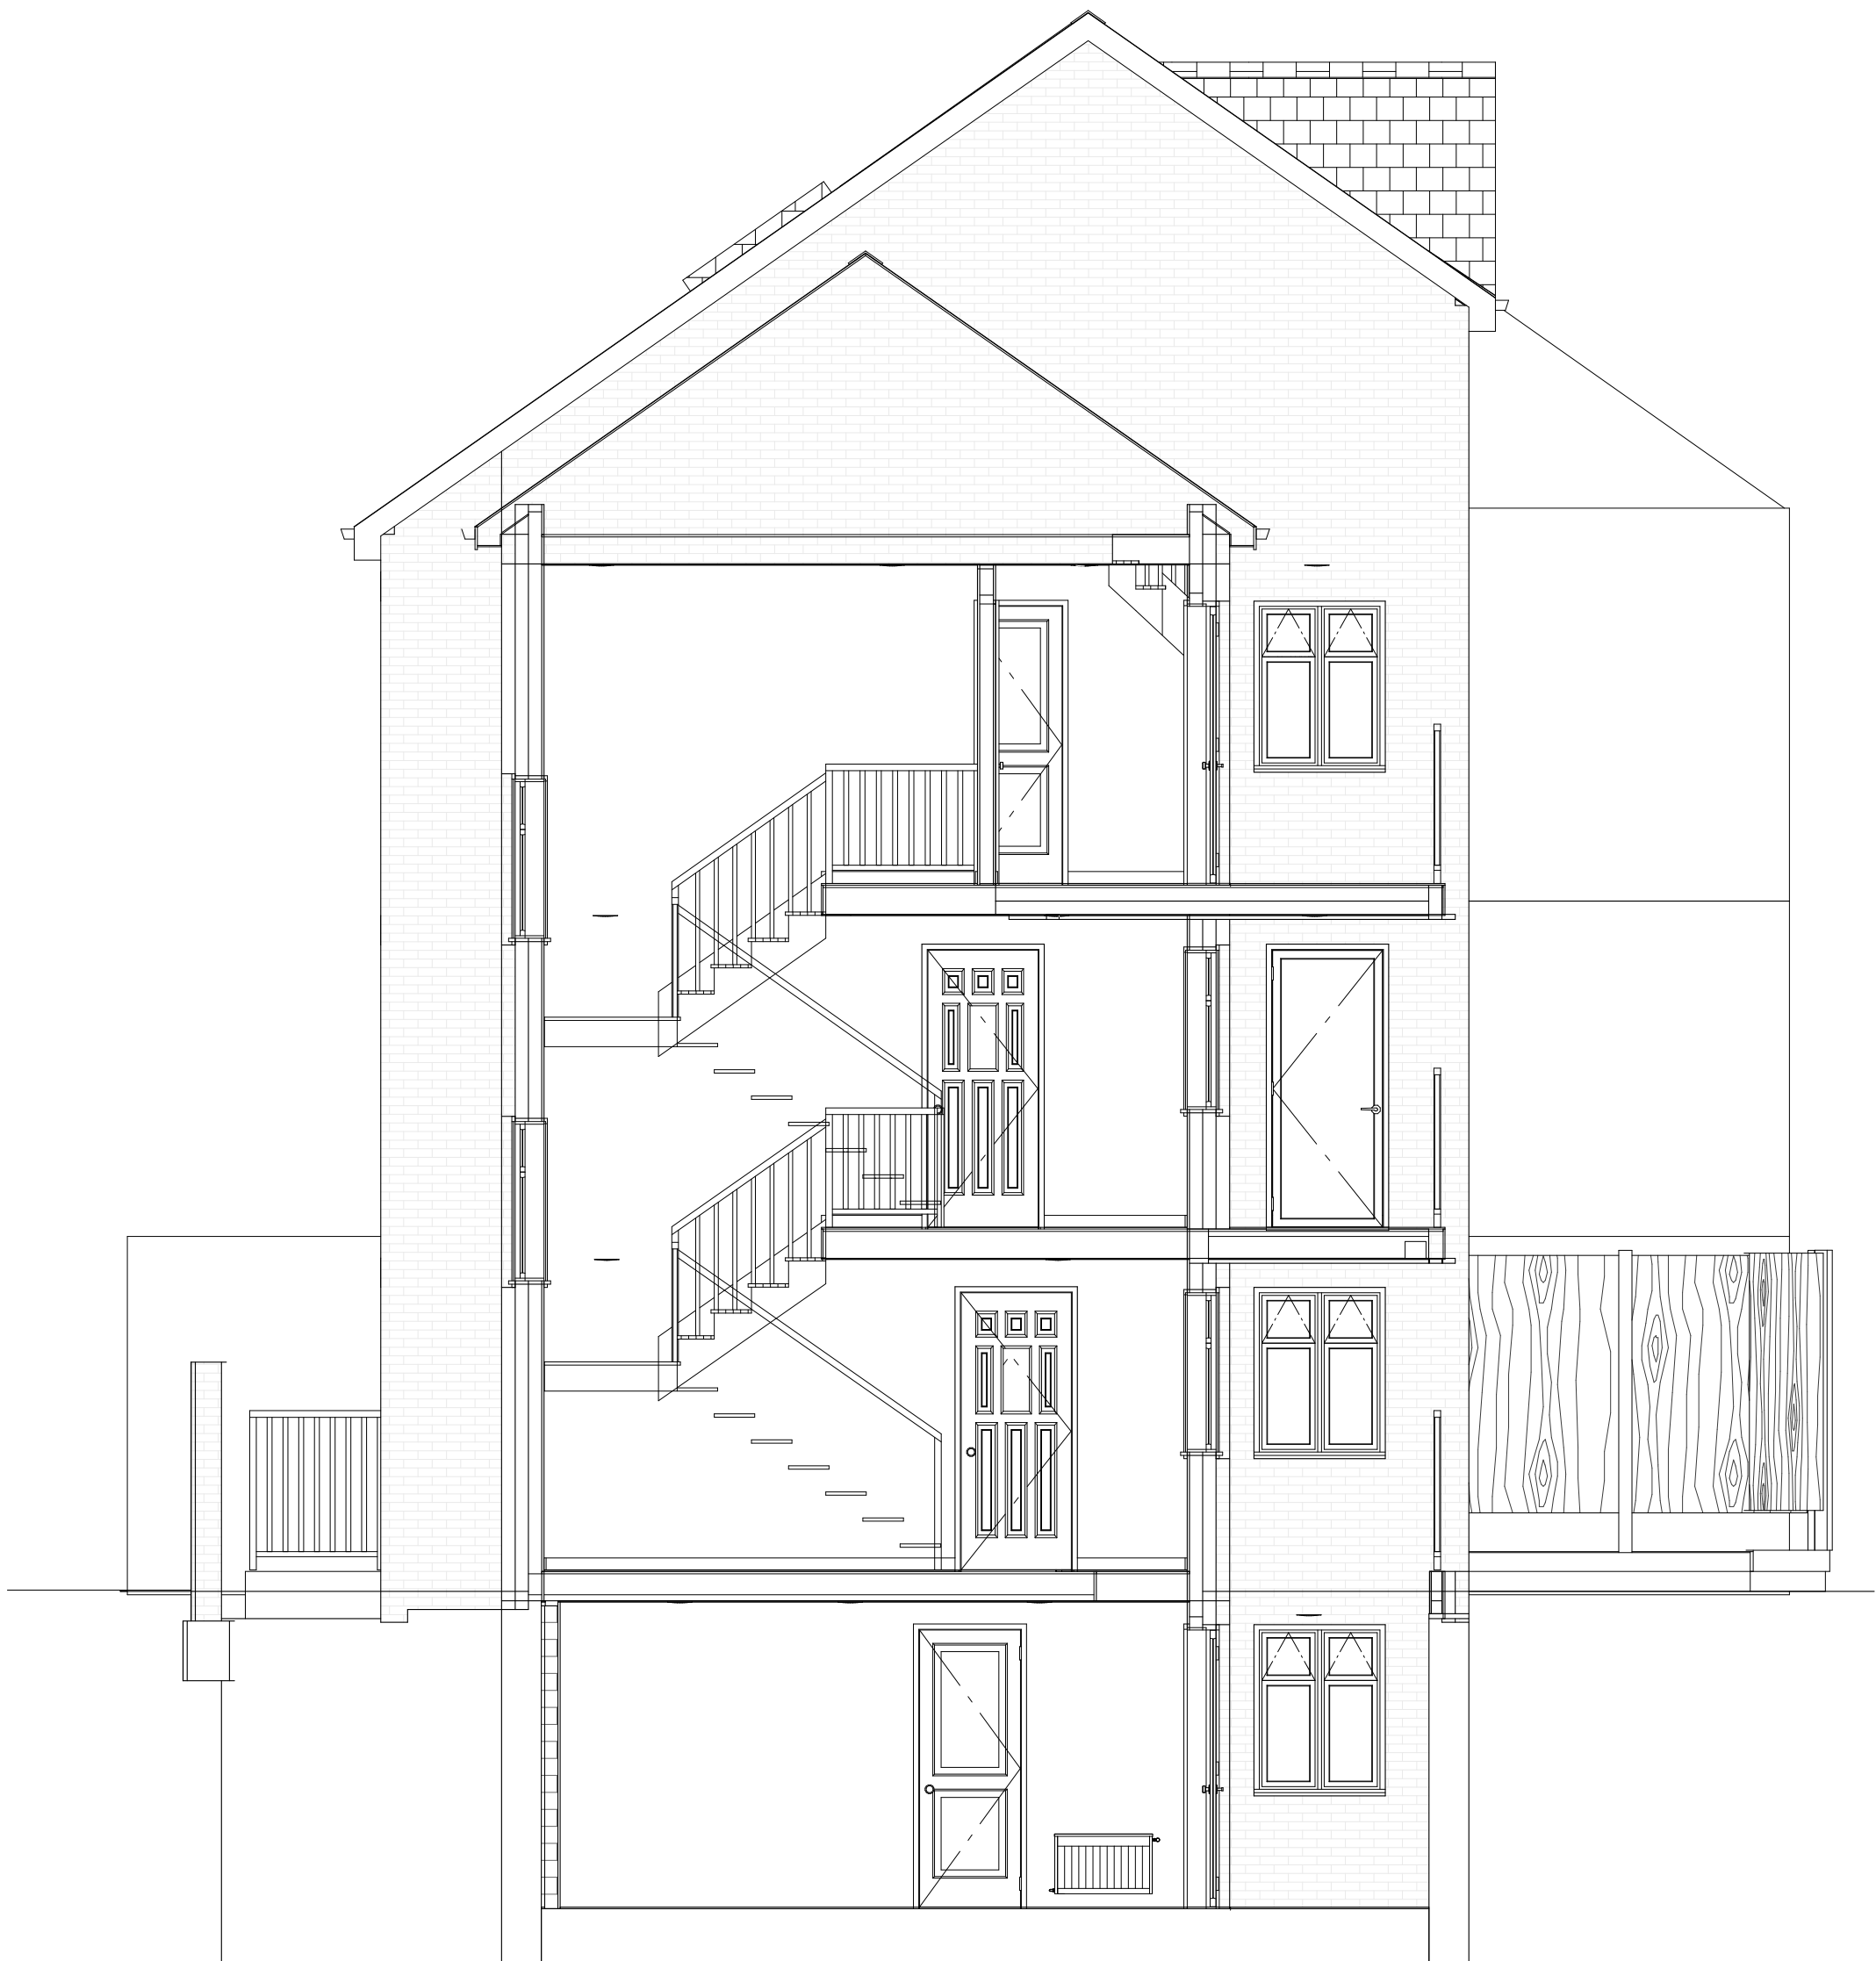

Section BB - Scale 1: 50 @A1

