



©2020 Cellnex
All rights reserved. No part of this publication may be reproduced, stored in a retrieval system or transmitted in any form or by any means (Electronic, Mechanical, Photocopying, Recording or otherwise), without the prior written consent of the Company.

NOTES

NOTE: ALL EQUIPMENT PAINTED TO MATCH BRICKS BY A SPECIALIST CONTRACTOR

NOTE: EXISTING GRILLAGE CUT TO ACCOMMODATE NEW TAILS AND BIRD NETTING INSTALLED ON SECTOR 1

CTIL(VF) 3No. 6-PAIR MULTICORE FIBRES, 6No. DC CABLES & 6No. 3-WAY BOB's (SHARED) RE-USED. CTIL(VF) 3No. 6-PAIR MULTICORE FIBRES INSTALLED

CTIL(VF) 3No. L2100 ERS I.D. No. 425950 WALL MOUNTED AT LOW LEVEL

CTIL(VF) 3No. L2600 ERS I.D. No. 425951 WALL MOUNTED AT LOW LEVEL

CTIL(VF) 3No. L800 ERS I.D. No. 425952 WALL MOUNTED AT LOW LEVEL

CTIL(VF) 3No. GU09 ERS I.D. No. 425948 WALL MOUNTED AT LOW LEVEL

CTIL 1No. 9-WAY OUTDOOR DB WITHIN IP65 RATED ENCLOSURE

CTIL(VF) 1No. GPS MODULE, I.D No. 425766 AT 12.5m POLED UP FROM STUB GANTRY POLE

CTIL(VF) 1No. CSC CABINET C/W GPS BASE BAND INSTALLED ON CONCRETE PLINTH REFRESHED FOR UPGRADE

CTIL(VF) 1No. RBS3101 CABINET INSTALLED ON EXISTING CONCRETE PLINTH

300 WIDE FEEDER CABLE TRAY INSTALLED ON EXTENSIS STRUTS AT 300 ARL

910 WIDE CROSS-SLIP MATTING

1100mm HIGH HANDRAIL INSTALLED ON PLINTH

ROOF ACCESS DOOR TO BE USED FOR ACCESS TO EQUIPMENT/ EMERGENCY ESCAPE ROUTE

ROOF ACCESS LADDER

100 CABLE TRAY FIXED TO PLANTROOM


EXHAUST PIPE

CTIL(VF) 1No. AIR 3227 ANTENNA AT 13.7m MEAN HEIGHT, BEARING 280° E.T.N. I.D.No. EQU900672563 INSTALLED ON STEELWORK


CTIL(VF) 1No. COMMScope RRZZVV-65B-R6H4 ANTENNA AT 13.7m MEAN HEIGHT, BEARING 280° E.T.N. ID No. 425764 FIXED TO STEELWORK.

CTIL(VF) 1No. COMMScope RRZZVV-65B-R6H4 ANTENNA AT 13.7m MEAN HEIGHT, BEARING 160° E.T.N. ID No. 425763 FIXED TO STEELWORK.

CTIL(VF) 1No. AIR 3227 ANTENNA AT 13.7m MEAN HEIGHT, BEARING 160° E.T.N. I.D.No. EQU900672562 INSTALLED ON STEELWORK

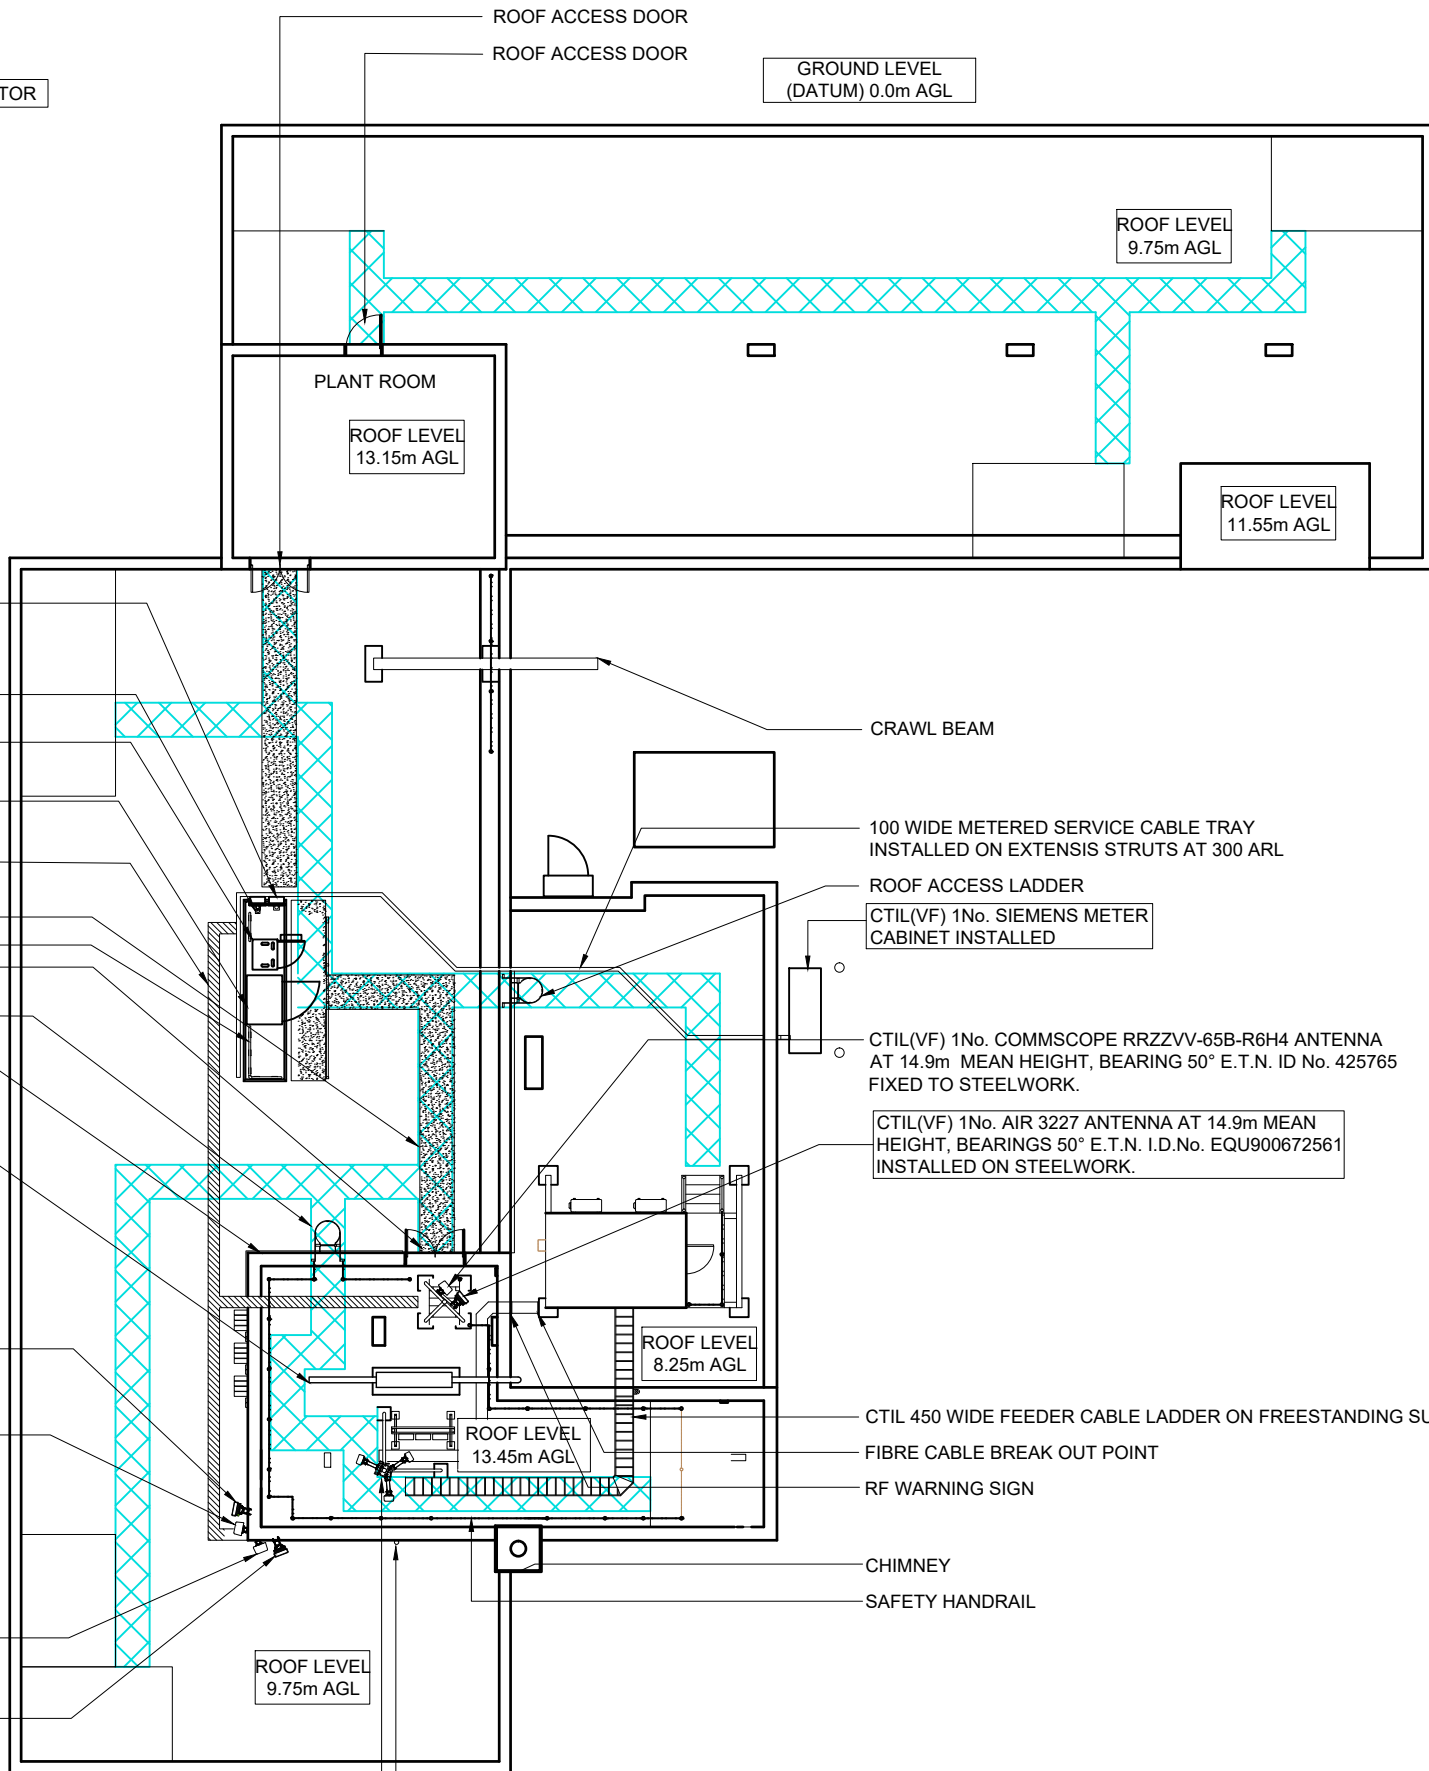

SITE PLAN
(AS BUILT)
SCALE 1:200

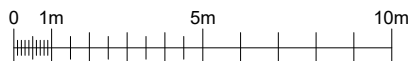

FEINT DETAILS INDICATE LOCATIONS RESERVED FOR OTHER PROPOSALS WHICH MAY BE THE SUBJECT OF SEPARATE APPLICATIONS

PROJECT No.	COM-0020406
CSID	14356228
VFID	1544_27
CSR	37098
CELL No.	1544VF

BT SKYLINE No. NZ0010				
24	PROJ No COM-0020406 MAJOR AMEND	20/07/23	HFC	HFC
23	PROJ No COM-0020406 PLANNING ISSUE	05/10/22	HFC	HFC
22	PROJ No COM-0018460 PLANNING ISSUE	10/03/22	GBC	GBC
21	PROJ No 239964 MINOR AMENDS	17/06/21	GBC	GBC
20	PROJ No 239964 PLANNING ISSUE	20/05/21	GBC	GBC
ISS	REVISION	DATE	DRN	APP



CELLNEX UK
R+, 4TH FLOOR, 2 BLA GRAVE STREET, READING, RG1 1AZ
Tel. 020 4526 8553

SITE No 166663
MUSWELL HILL ATE
GRAND AVENUE
LONDON
GREATER LONDON 1
N10 3AY

NGR TQ 28430 89360
OS GRID 528430 189360

TITLE
SITE PLAN
AS BUILT
CTIL (VF)

SCALE 1:200

DRAWN	IM	01/06/11
APPROVED	HFC	20/07/23

DRG No.	Sheet 3 of 3	Rev
166663-22-110-MD024		24