



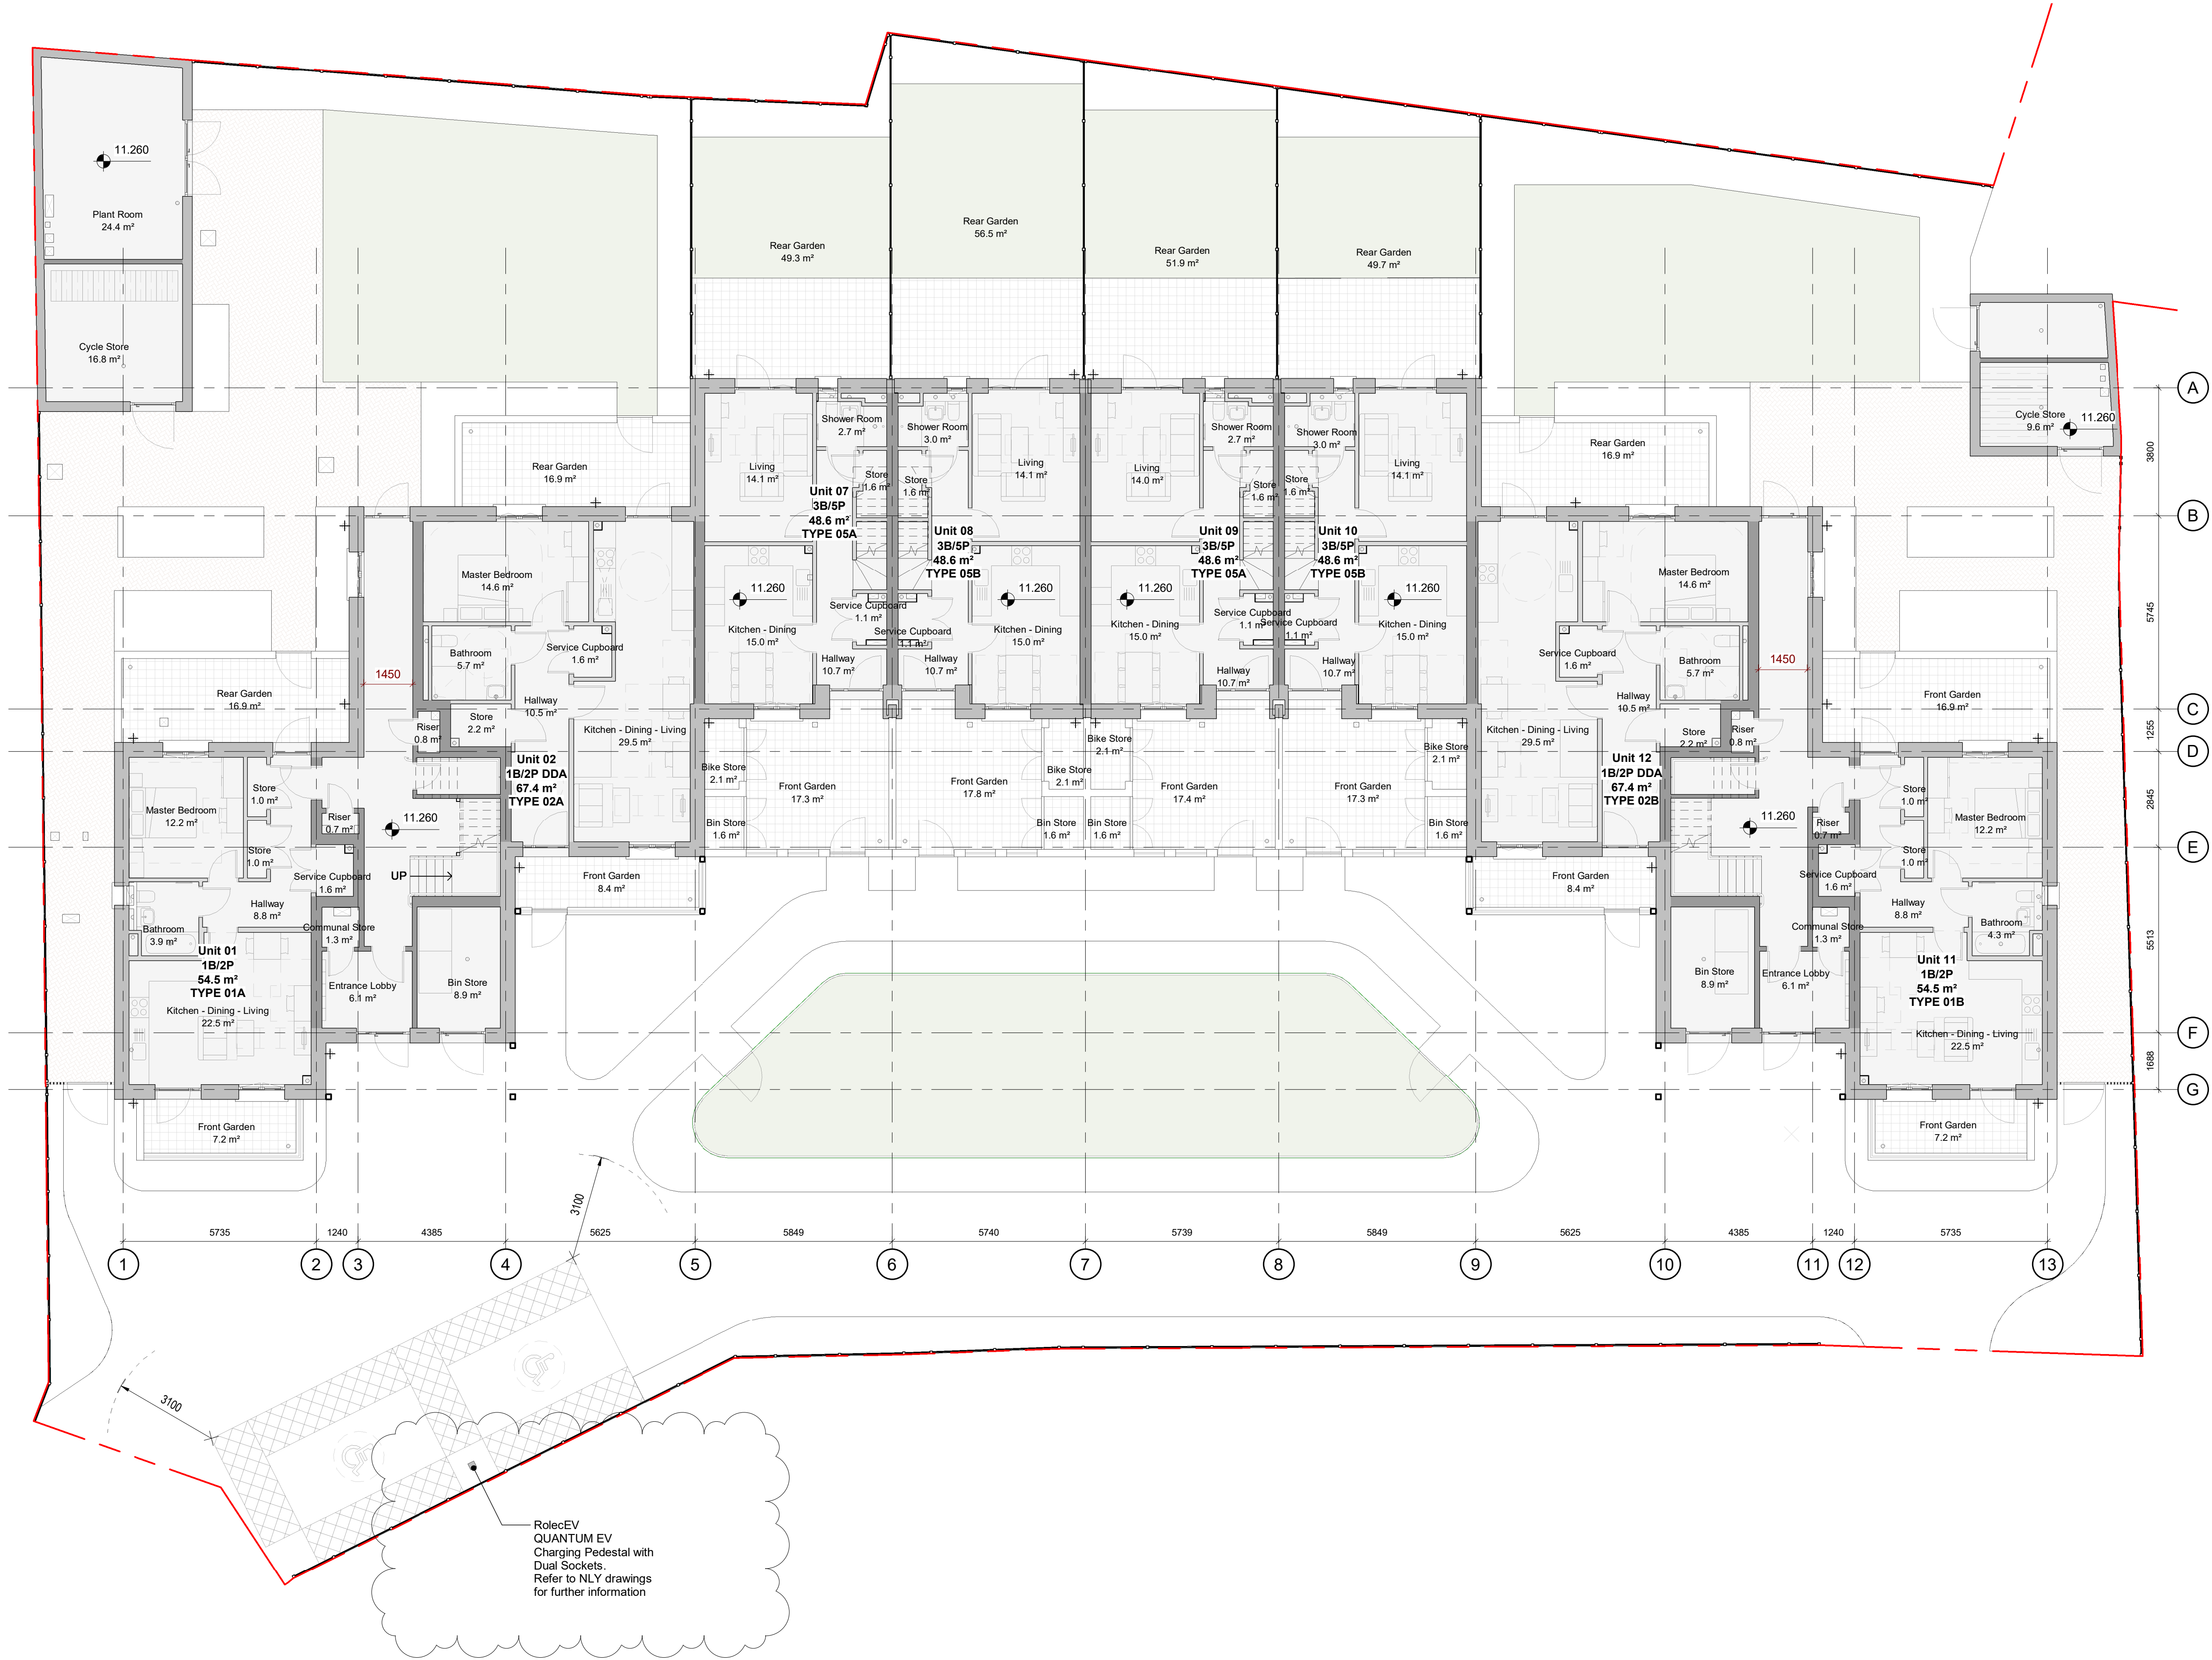

Copyright reserved

All dimensions to be checked on site before work commences.
Figured dimensions to be taken in preference to scaled dimensions.
If in doubt please ask.

KEY PLAN

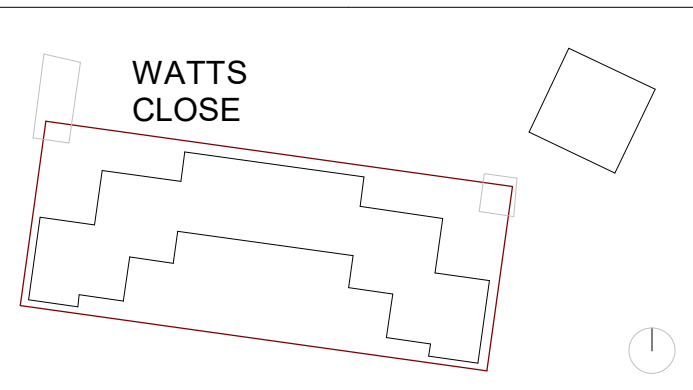

AB2 Revised as cloude
AB1 First Issue
Revision Description Date

STATUS

As Built

PROJECT

Watts Close

DRAWING

Watts Close Proposed GF GA Plan

DRAWN BY RC
CHECKED BY CB
DATE August'22
SCALE (@ A1) 1 : 100
PROJECT NUMBER 22015

DRAWING NUMBER WAT - DAR - WC - 00 - DR - A - 1210
REV AB2

Project Identifier Originator Zone Level Type Discipline Number Revision



Delta Architects
1 Batemans Row
London
EC2A 3HH

T 020 7613 5702

www.deltaarchitects.co.uk