
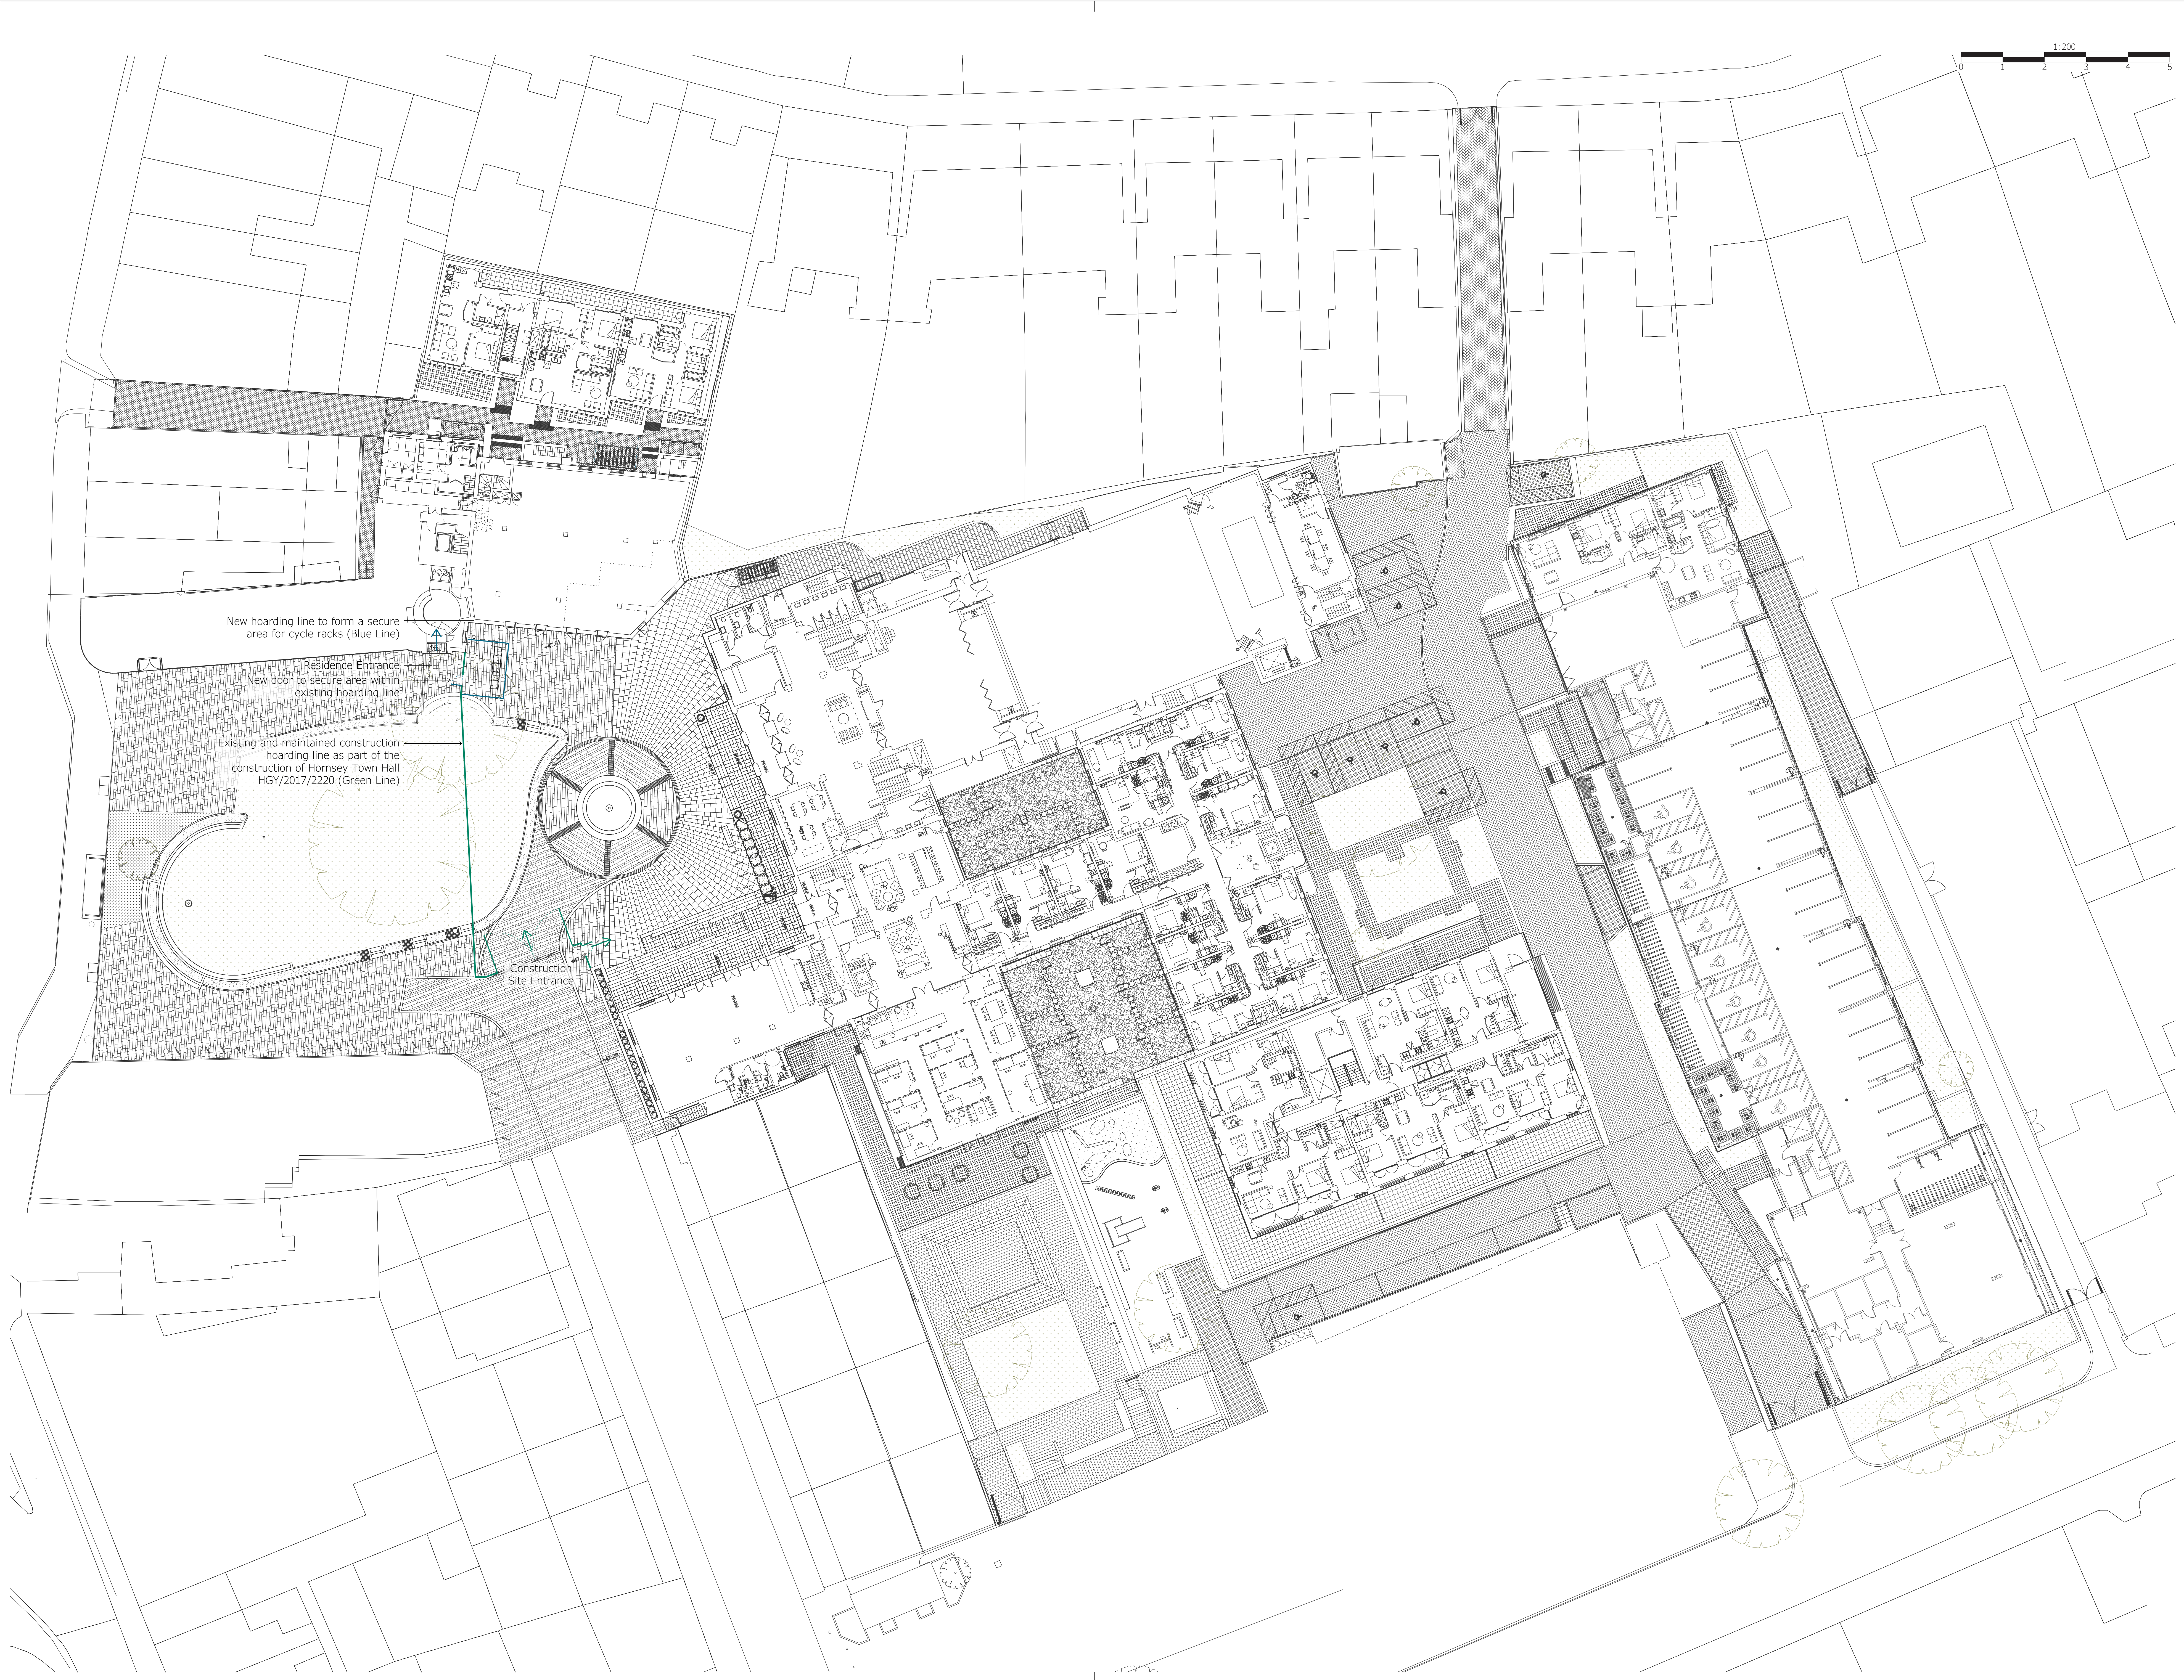


© Longlane Architects Ltd  
 No part of this drawing may be reproduced without written consent.  
 All contractors must visit site and be responsible for taking and checking all  
 dimensions relating to this work.  
 Do not scale from this drawing.

| REVISION NOTES |          |    |                            |
|----------------|----------|----|----------------------------|
| A              | 05.04.23 | WB | AS BUILT - FOR INFORMATION |

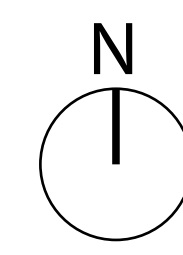

**Ardmore GROUP**  
 ARDMORE CONSTRUCTION LTD  
 6 WHARF STUDIOS,  
 25 WHARF ROAD,  
 LONDON, N1 7GR  
 TEL: 0205 344 0300  
 www.ardmoregroup.co.uk

**Longlane Architects**  
 5 Hornsey Street  
 London, SE1 3LE  
 office@longlanearchitects.co.uk

|                                                        |                             |    |
|--------------------------------------------------------|-----------------------------|----|
| AS BUILT                                               |                             |    |
| PROJECT<br>HORNSEY TOWN HALL                           |                             |    |
| DRAWING TITLE<br>LANDSCAPE<br>GENERAL ARRANGEMENT PLAN |                             |    |
| SCALE<br>1:200 @ A0                                    | DATE / DRAWN BY<br>16.03.23 | WB |
| DRAWING NUMBER<br>3670-KDS-TH-ZZ-DR-A-90-1000          |                             | AB |