


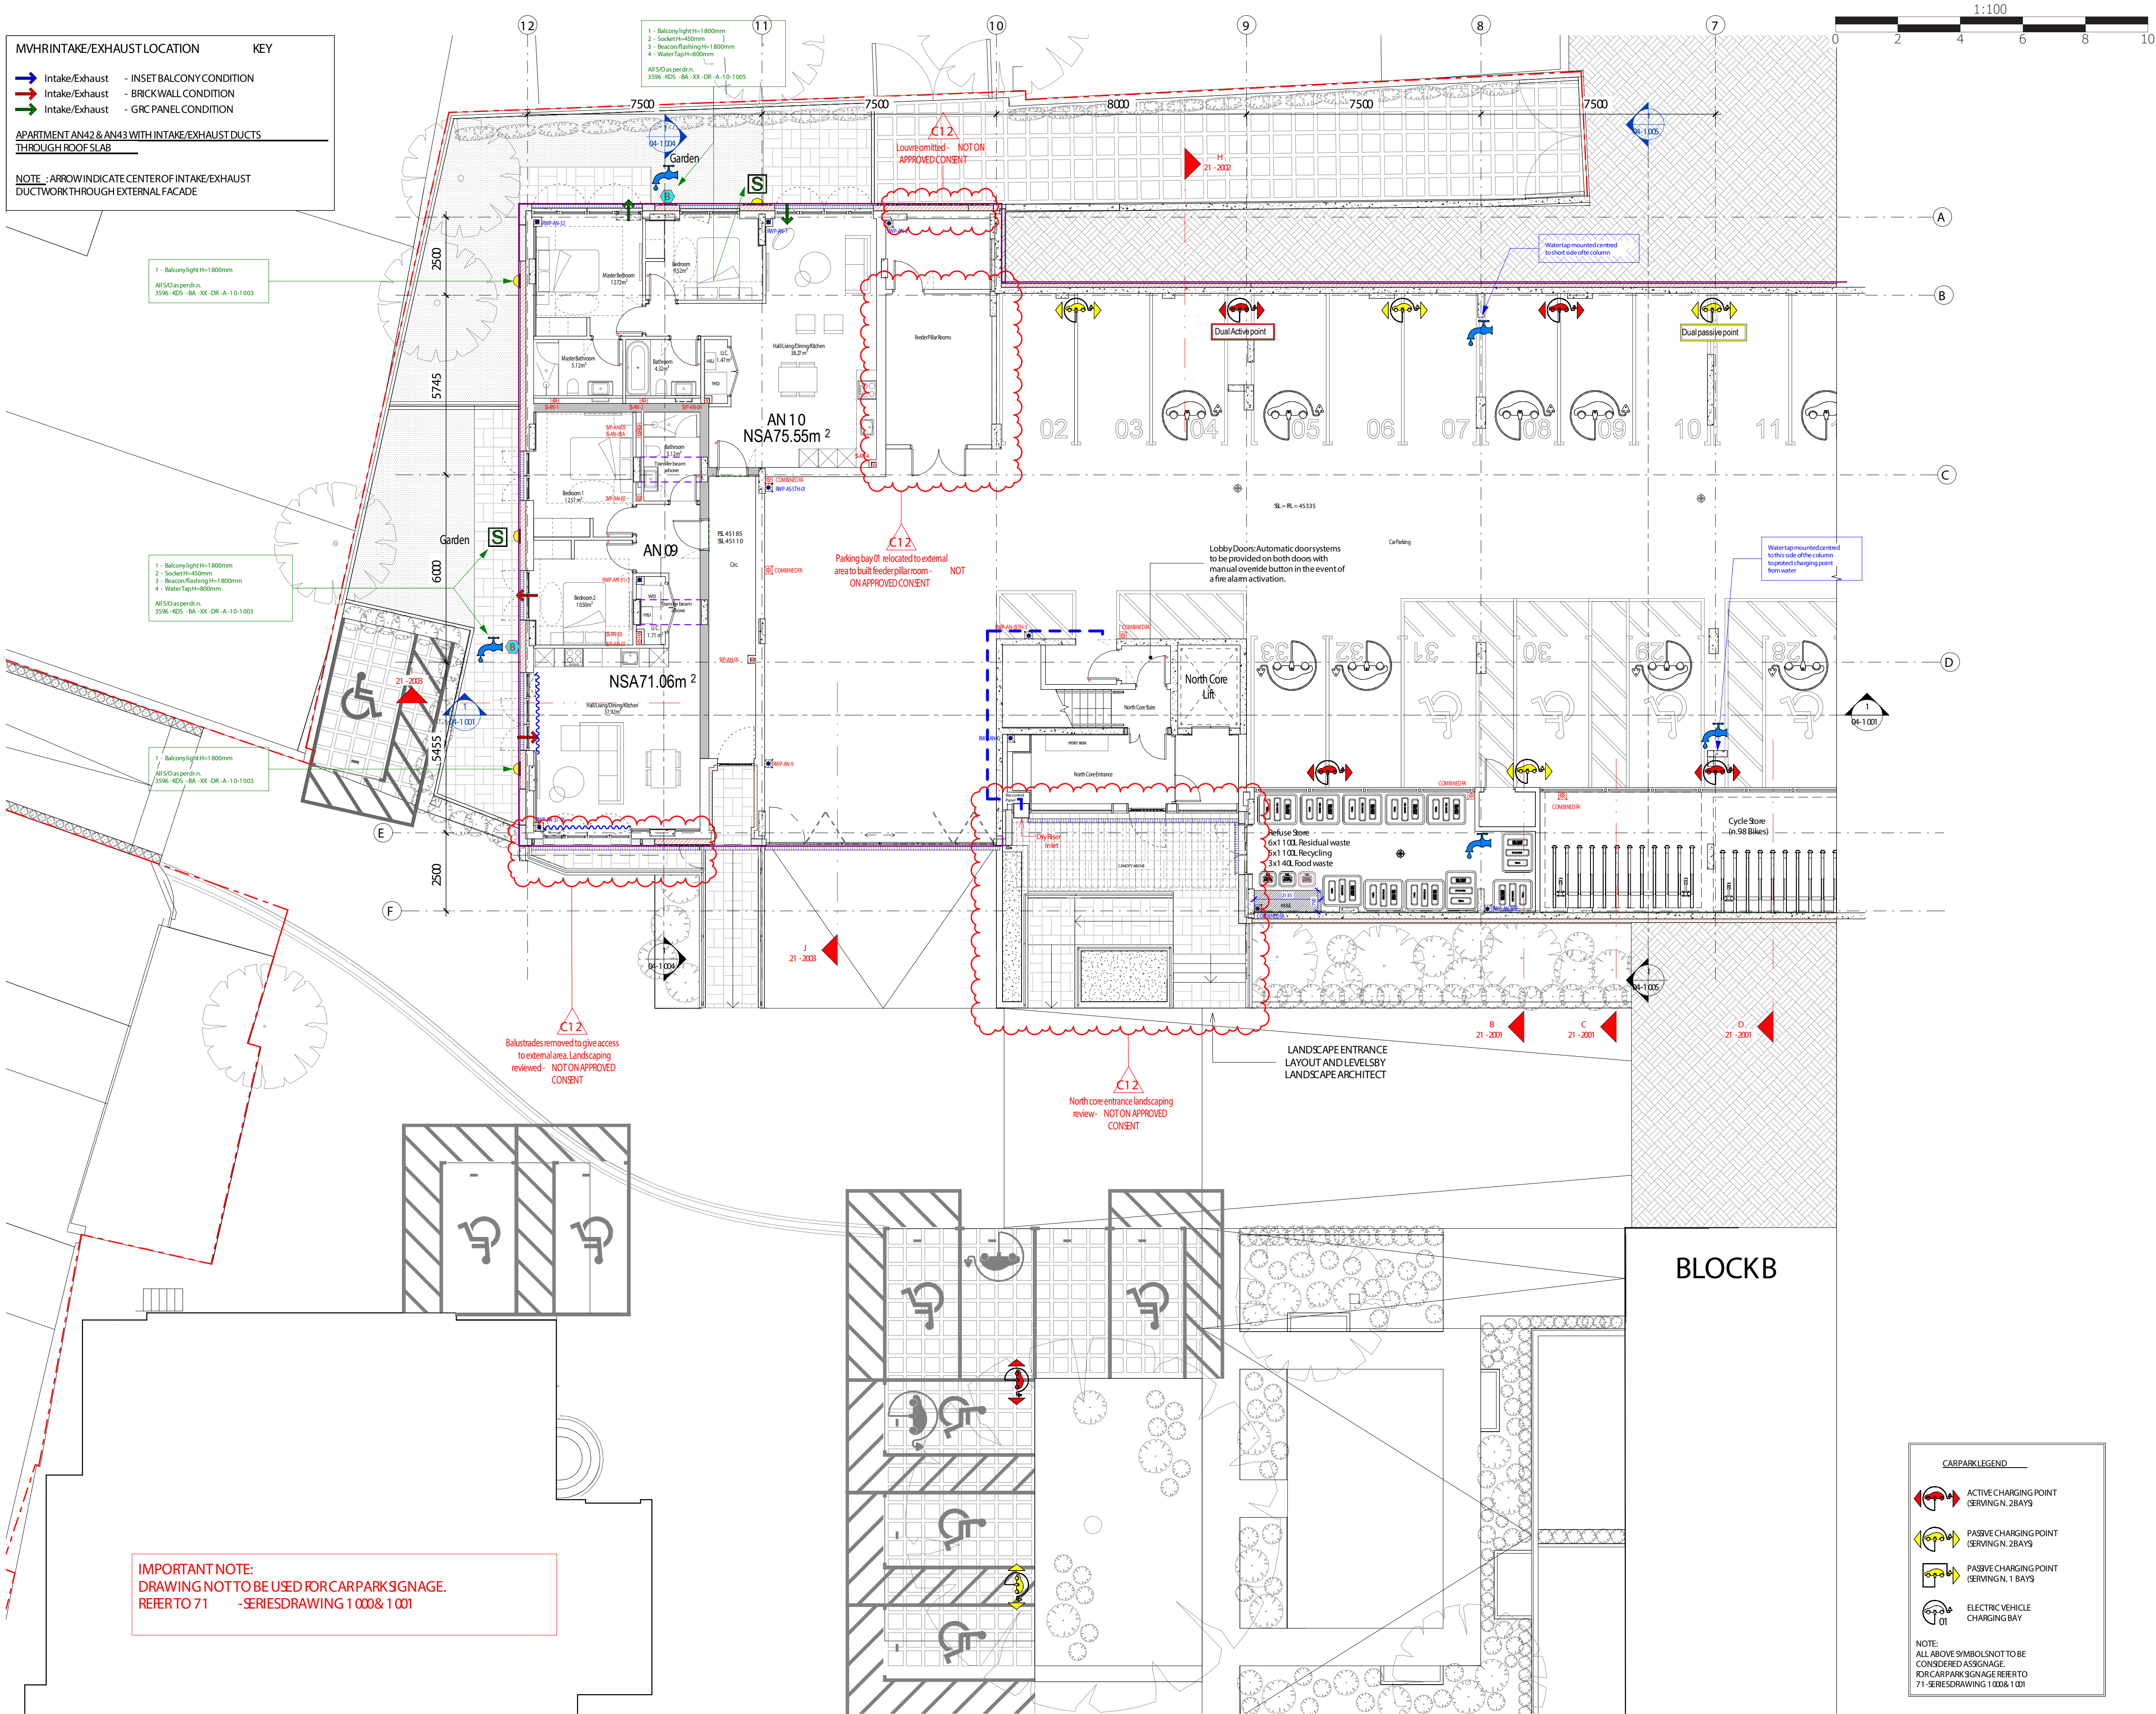

KDS& Associates Ltd

No part of this drawing may be reproduced without written consent. All contractors must visit site and be responsible for taking and checking all dimensions relating to this work. Do not scale from this drawing.

NO.	DESCRIPTION	DATE	NAME
C3	Issued for construction reviewed as clouded	22/06/20	IF
C4	GA plans updated as clouded. MVHR intake/exhaust location added	28/07/20	IF
C5	Windows configuration review. ACL instruction by email 04/09/20 & 29/09/20	01/10/20	IF
C6	Lower Ground floor review: feeder pillar room added. Car parking bay 1 omitted. Drawings reviewed as clouded	26/02/21	IF
C7	External Lights, flashing/beacon, sockets, water point reviewed	11/05/21	IF
C8	Electrical charging point review	31/01/22	IF
C9	Updated as clouded	15/03/22	IF
C10	Updated as highlighted	24/04/22	ZZK
C11	LAST CONSTRUCTION ISSUE FOR ASBUILT PURPOSES	18/07/22	IF
C12	LAST CONSTRUCTION ISSUE FOR ASBUILT PURPOSES Changes from approved consent scheme highlighted	16/08/22	IF

KEY:

- GRC PANELS AREA
- BRICK WALL AREA
- BALCONY/TERRACE PORCELAIN TILES
- GARDEN PAVERS
- GRASS
- GREEN ROOF
- PV PANELS
- STRUCTURE
- THRESHOLD CHANNEL DRAIN
- ELECTRICAL VEHICLE CHARGING POINT
- WATERPOINT (wall mounted tap)
- IP RATED SOCKET
- SOIL VENT PIPE
- SUB STACK
- RAIN WATER PIPE
- GULLY
- INDICATIVE FALL PREVENTION LATCHWAY SYSTEM TO SPECIALIST SUB - CONTRACTOR DESIGN REQUIREMENTS
- SL = STRUCTURAL SLAB LEVEL
- RL = FINISH SCREED LEVEL
- RL = FINISH FLOOR LEVEL
- SLAB EDGE
- TRANSFER BEAM / STEPPED SLAB ABOVE
- DRY RISER OR BET IN CEILING
- DRY RISER OR BET AT LOWER LEVEL
- BLINDS REQUIRED TO SATISFY OVERHEATING CRITERIA
- (W) indicates Wheelchair Units

NOTES

FOR STRUCTURE REVERT TO STRUCTURAL ENGINEER DRAWINGS

FOR EXTERNAL WORKS LAYOUT REVERT TO LANDSCAPE DRAWINGS

FOR ELECTRICAL AND MECHANICAL EQUIPMENT REVERT TO M&E DRAWINGS

WATER POINT AND IP RATED SOCKETS TO M&E

SOH WATERPOINTS ARE CONNECTED TO CATS WATER MEAN TERRACE AND GARDEN WATER POINTS ARE CONNECTED TO DOMESTIC WATER MEAN

NOTE 2:

FOR ALL BLOCK A CARPARK SIGNAGE, REVERT TO 71 SERIES

LOCATION - BLOCK A

Key Plan - Lower Ground floor

ARDMORE CONSTRUCTION LTD

6 WHARF STUDIOS,
28 WHARF ROAD,
LONDON, N1 7GR
TEL: 0208-344 0300
www.ardmoregroup.co.uk

KDS ASSOCIATES LTD

DESIGN ARCHITECTURE MANAGEMENT CONSULTANTS

101 The Blokhuis Foundry
150 Blokhuis Road
London SE18 8BA
Tel: 020 3355 0775
www.kdsassociates.co.uk

ASBUILT

PROJECT/DRAWING TITLE
Homsey Town Hall

DRAWING TITLE
RESIDENTIAL BLOCK A
GA Plan - Lower Ground floor North Core

DATE/DRAWN BY
08/09/17 IF

SCALE
1:100

PROJECT NO	ZONE	LEVEL	TYPE	ROLE	CLASS	DR. NO.	REV
3596-KDS	-BA-	B1-	DR-	A-	03-	1001	C12

CARPARK LEGEND

- ACTIVE CHARGING POINT (SERVING N. 2 BAYS)
- PASSIVE CHARGING POINT (SERVING N. 2 BAYS)
- PASSIVE CHARGING POINT (SERVING N. 1 BAYS)
- ELECTRIC VEHICLE CHARGING BAY

NOTE:

ALL ABOVE SYMBOLS NOT TO BE CONSIDERED ASSIGNAGE

FOR CARPARK SIGNAGE REVERT TO 71 - SERIES DRAWING 1 000 & 1 001