



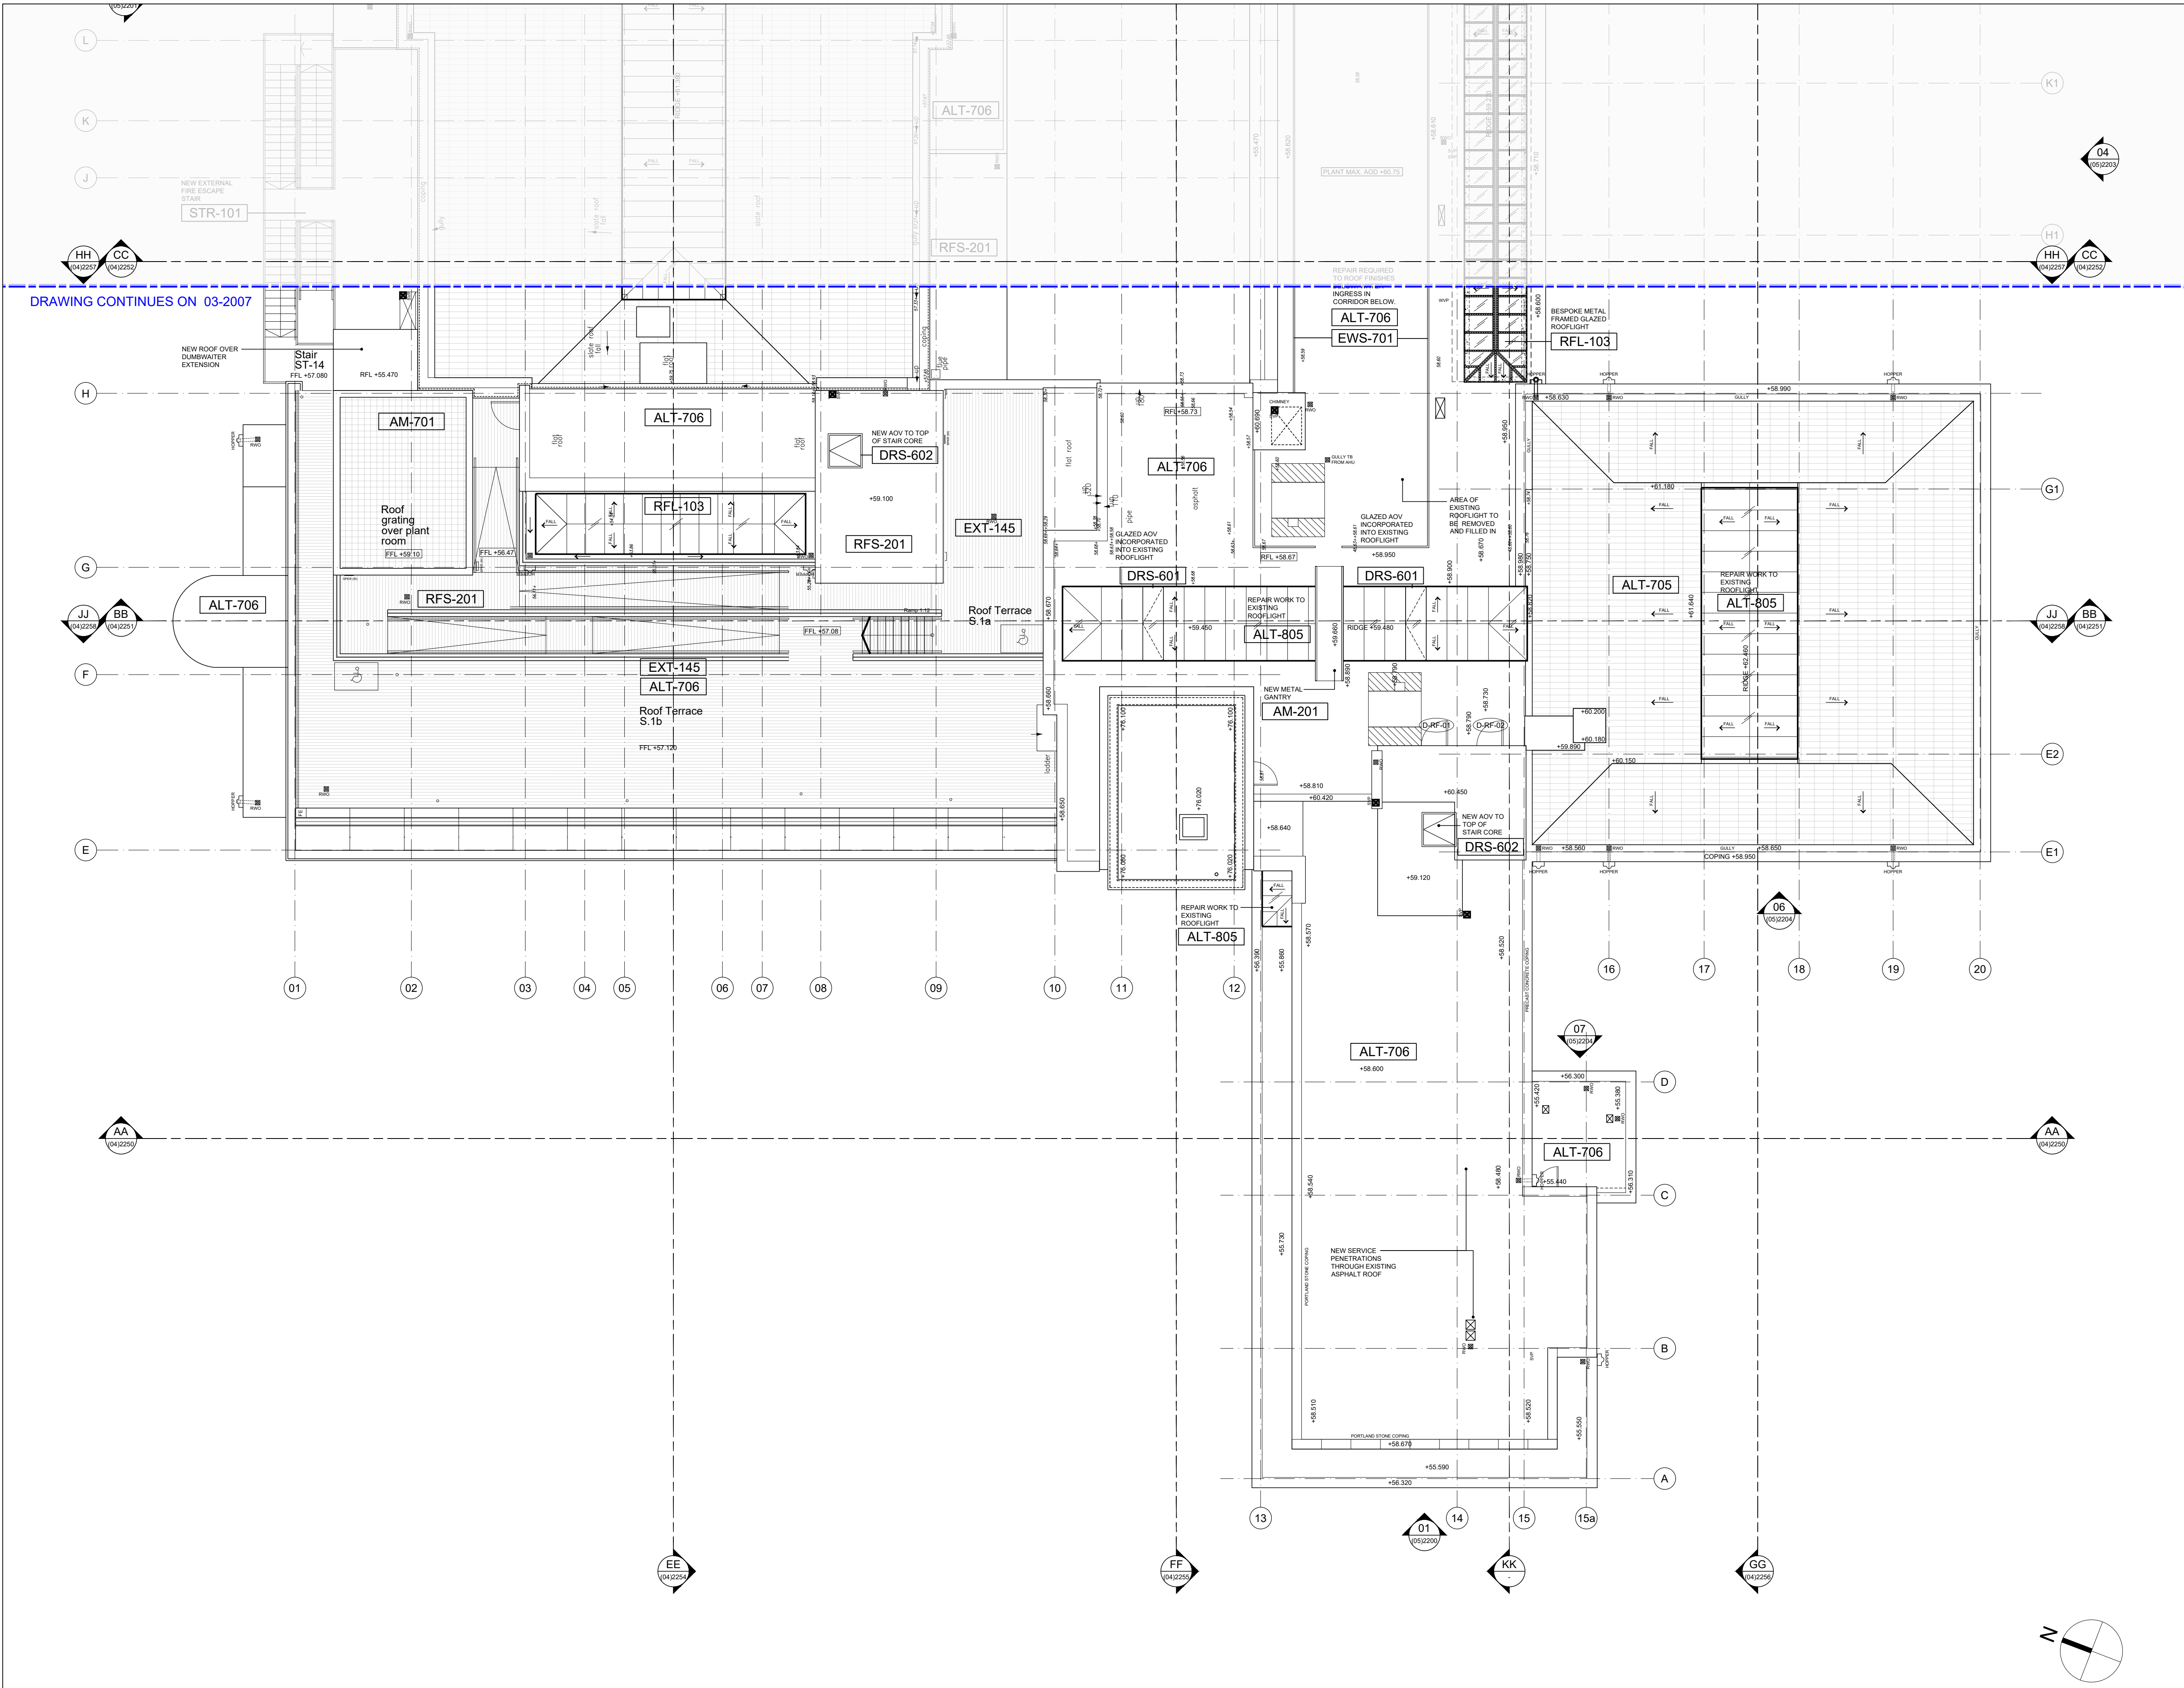

© KDS & Associates Ltd
No part of this drawing may be reproduced without written consent.
All contractors must visit site and be responsible for taking and checking all dimensions relating to this work.
Do not scale from this drawing.

REVISION NOTES			
P1	20.06.2019	JH	ISSUED FOR INFORMATION
C1	14.02.2020	JH	ISSUED FOR CONSTRUCTION
C2	26.10.2022	AC	REVISED ROOF TERRACE RAMP AND LEVELS
AB	13.05.2024	SP	FINAL CONSTRUCTION ISSUE

KEYPLAN

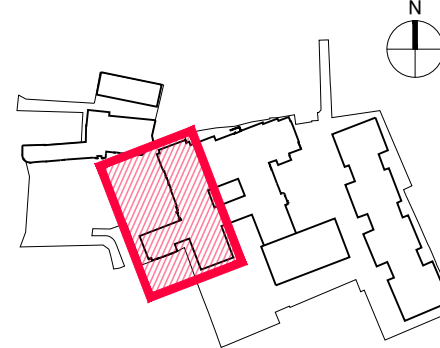

ARDMORE CONSTRUCTION LTD
6 WHARF STUDIOS,
25 WHARF ROAD,
LONDON, N1 7GR
TEL: 0208-344 0300
www.ardmoregroup.co.uk

KDS ASSOCIATES LTD
TECHNICAL • ARCHITECTURAL • MANAGEMENT • CONSULTANTS
101 THE BLACKFRIARS FOUNDRY
156 BLACKFRIARS ROAD
LONDON SE1 6EN
0203 355 0775
www.kdsassociates.co.uk

AS BUILT

PROJECT / DRAWING TITLE
**HORNSEY TOWN HALL
TOWN HALL & BROADWAY ANNEX
LONDON N8 9JJ**

DRAWING TITLE
**TOWN HALL PROPOSED PLAN
ROOF (WEST)**

DATE / DRAWN BY 20.06.19 JH	SCALE 1:100 @A1
PROJECT / DRAWING NO 3670-KDS-TH-RF-DR-A-03-2006	REV AB