


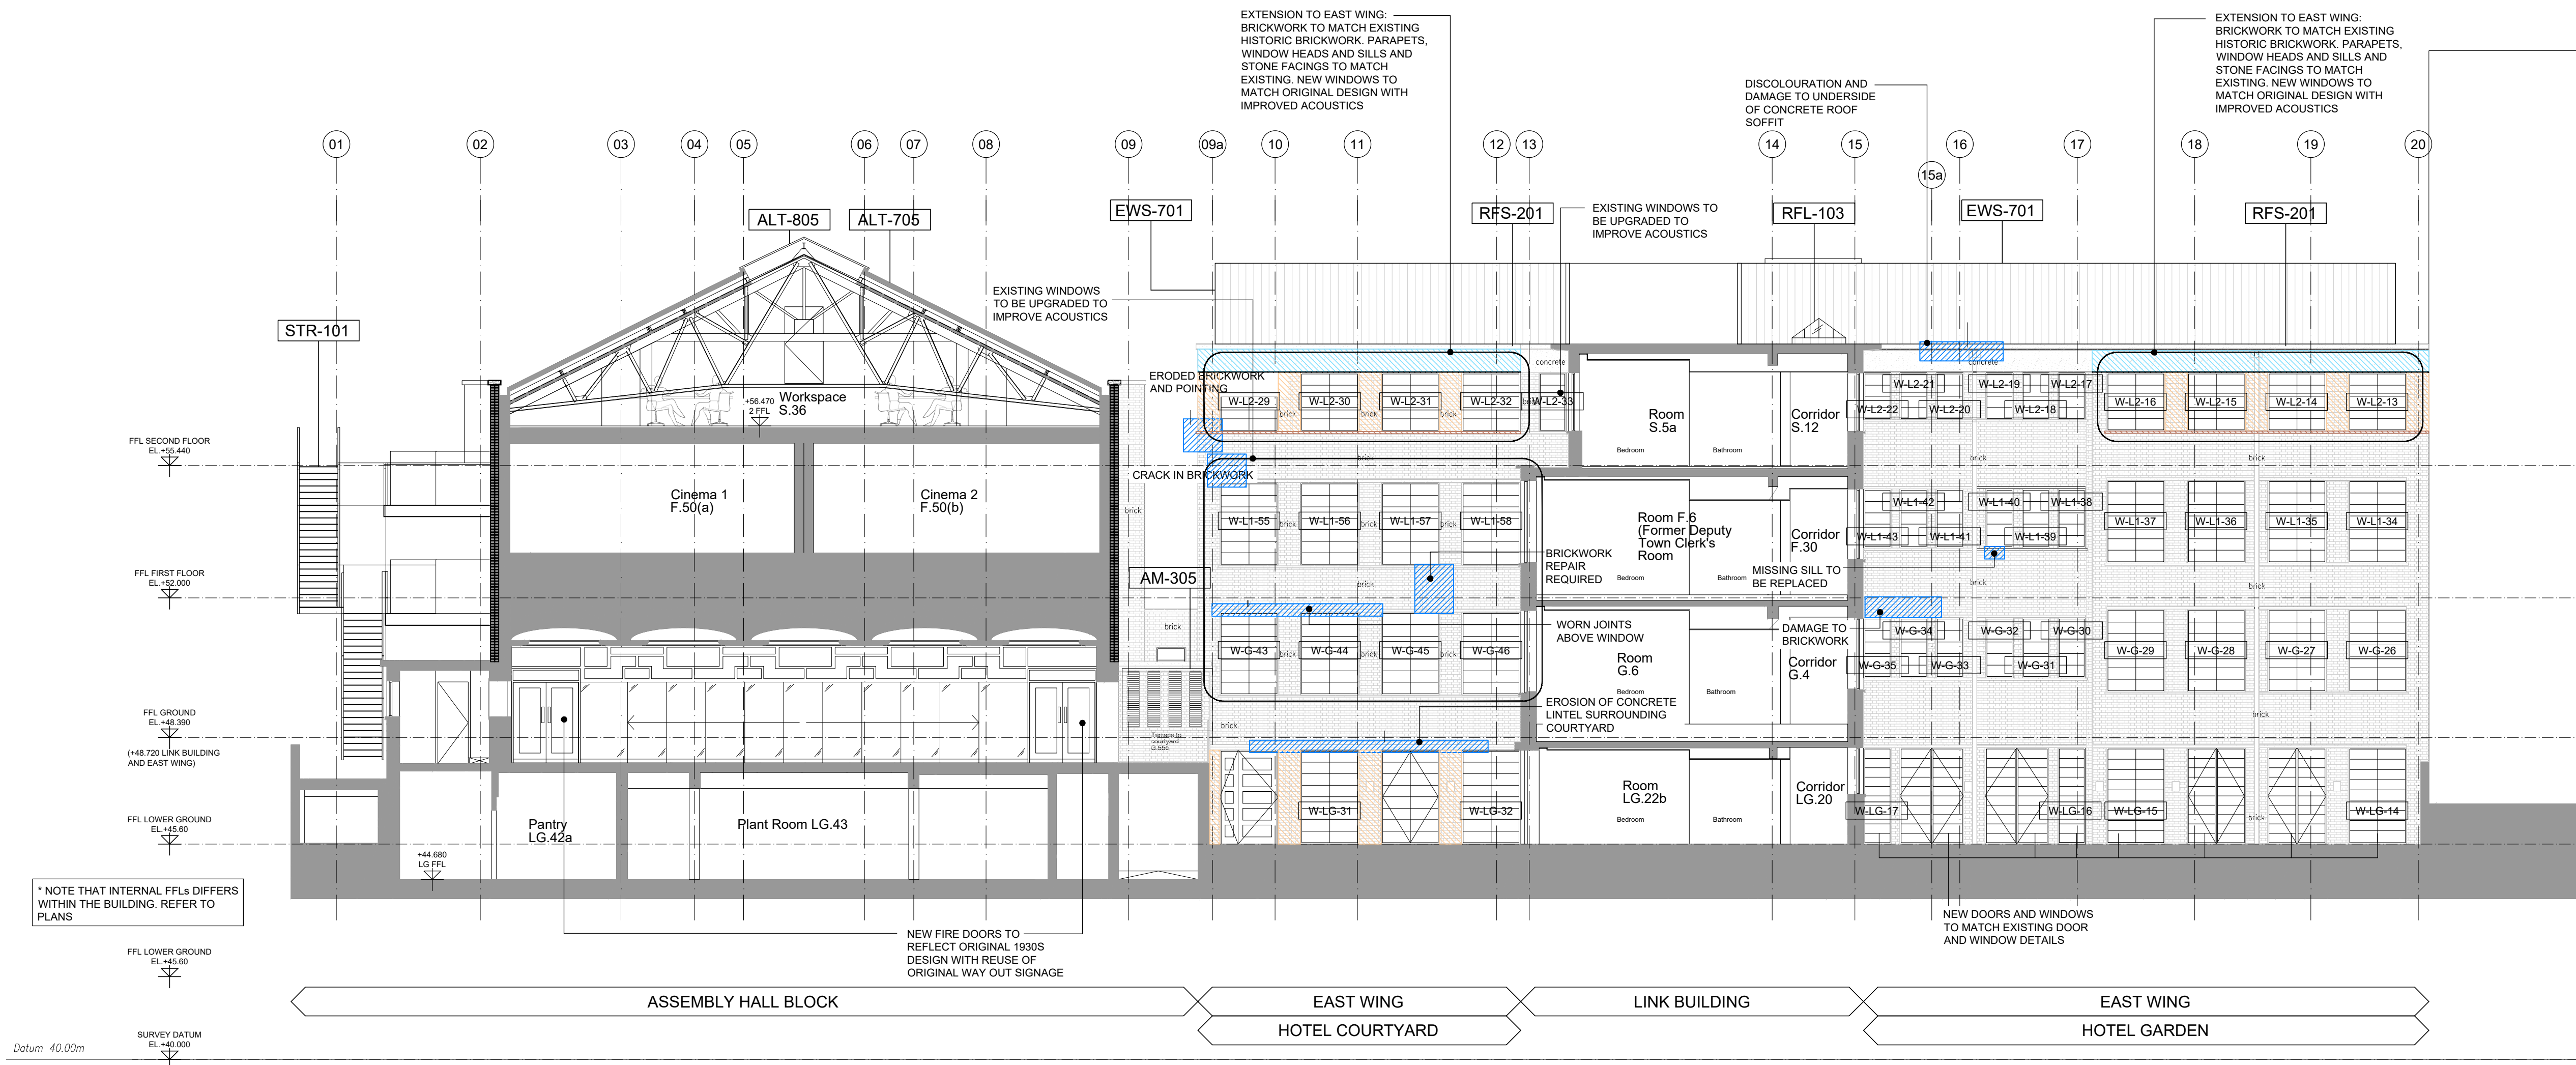

© KDS & Associates Ltd
No part of this drawing may be reproduced without written consent.
All contractors must visit site and be responsible for taking and checking all dimensions relating to this work.
Do not scale from this drawing.

REVISION NOTES
P1 01.07.2019 JH ISSUED FOR INFORMATION
C1 14.02.2020 JH ISSUED FOR CONSTRUCTION

KDS ASSOCIATES LTD
TECHNICAL • ARCHITECTURAL • MANAGEMENT • CONSULTANTS
101 THE BLACKFRIARS FOUNDRY
126 BLACKFRIARS ROAD
LONDON SE1 8EN
0203 355 0175
www.kdsassociates.co.uk

BASE DRAWING REVISION ABOVE BY KDS ASSOCIATES

REVISIONS BELOW BY LONGLANE ARCHITECTS

C2 16-06-2023 SP LIA TITLE BLOCK & NOTE - AS BUILT

KEY
* APPLICABLE ACROSS THE ENTIRE FACADE AND/OR ROOF
REFER TO MAKE SPECIFICATION DOCUMENT FOR FULL DESCRIPTION OF SPECIFICATION CODES


ALT-301	*
ALT-401	*
ALT-402	*
ALT-705	*
ALT-706	*
BRK-101	CWS-101
EWS-801	CWS-102
EWS-802	CWS-103
EWS-803	
EWS-804	
EWS-805	

INDICATES SPECIFIC AREAS OF CONCERN.
REFER TO ANNOTATIONS AND HUTTON + ROSTRON FACADE MASONRY CONDITION INVESTIGATION REPORT.

FOR EXTERNAL LIGHTING CODES. REFER TO SPECIALIST LIGHTING DESIGNER'S DOCUMENTATION

FOR EXTERNAL EMERGENCY AND/OR MAINTENANCE LIGHTING. REFER TO ELECTRICAL ENGINEER'S DOCUMENTATION

KEYPLAN

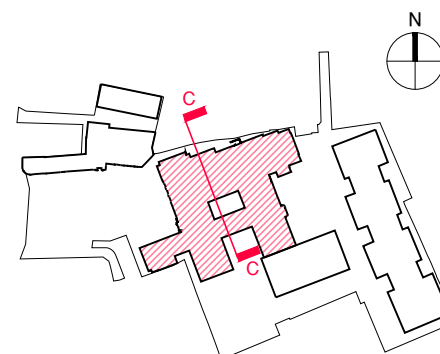

ARMORE CONSTRUCTION LTD
6 WHARF STUDIOS,
28 WHARF ROAD,
LONDON, N1 7GR
TEL: 0208-344 0300
www.armoregroup.co.uk



Longlane Architects
5 Tanner Street
London, SE1 8LE
office@longlane.co.uk

AS BUILT

PROJECT / DRAWING TITLE
HORNSEY TOWN HALL
TOWN HALL & BROADWAY ANNEX
LONDON N8 9JJ

DRAWING TITLE
TOWN HALL PROPOSED SECTION
SECTION CC

DATE / DRAWN BY
01.07.19 JH
SCALE
1:100 @ A1

PROJECT / DRAWINGS NO
3670-KDS-TH-ZZ-DR-A-04-2252
REV
C2