



Elevation FF'
Scale 1:20

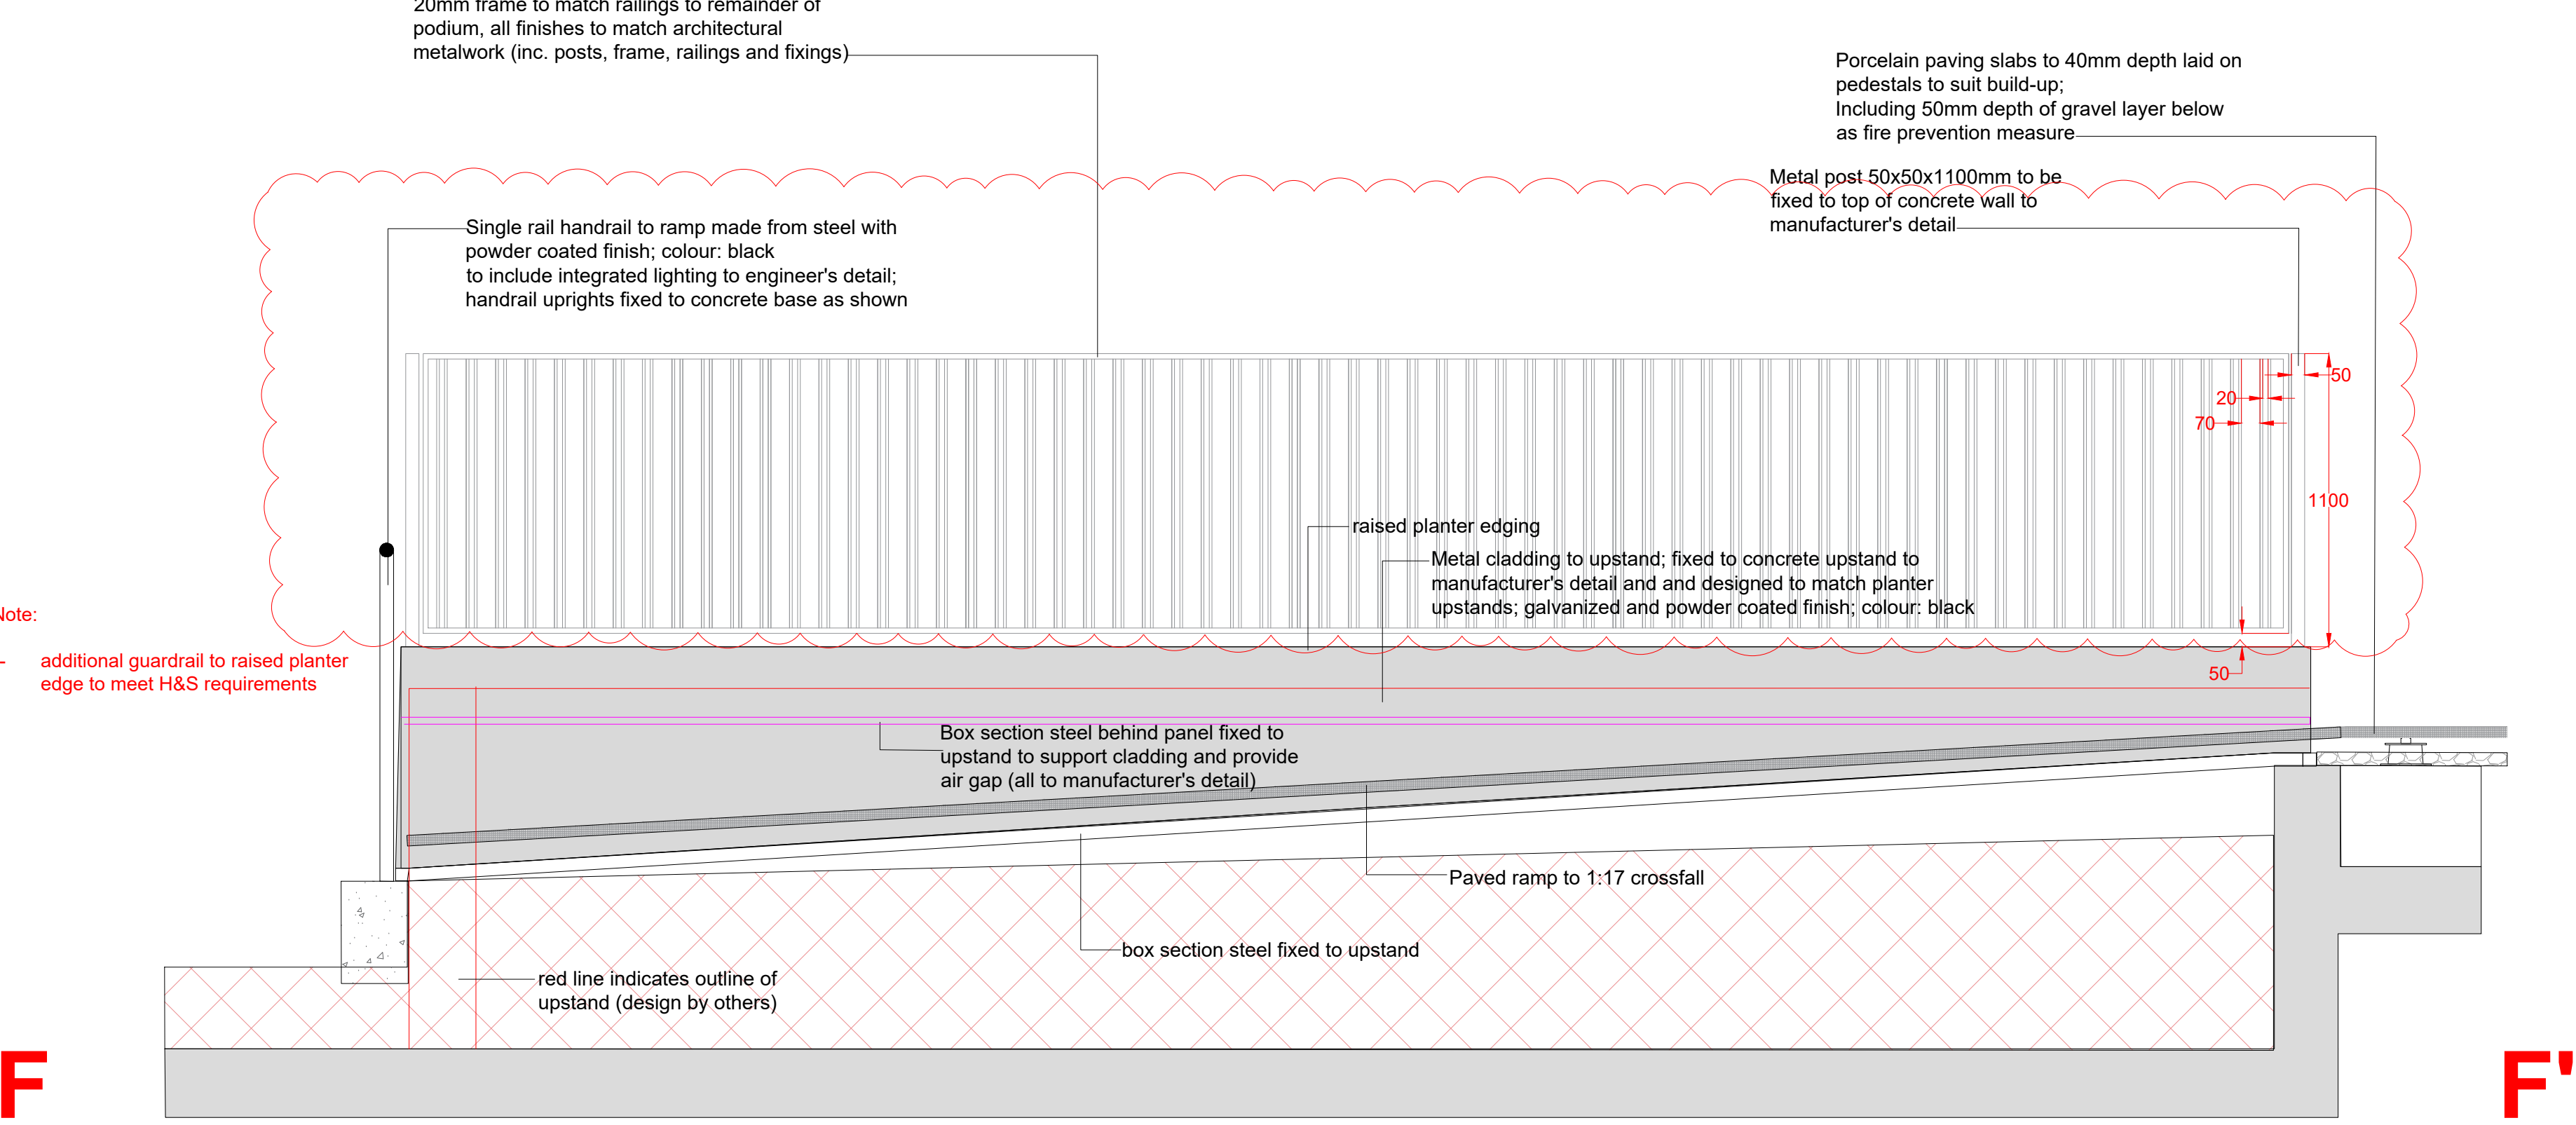

G

Elevation GG'
Scale 1:20


Section HH'
Scale 1:20

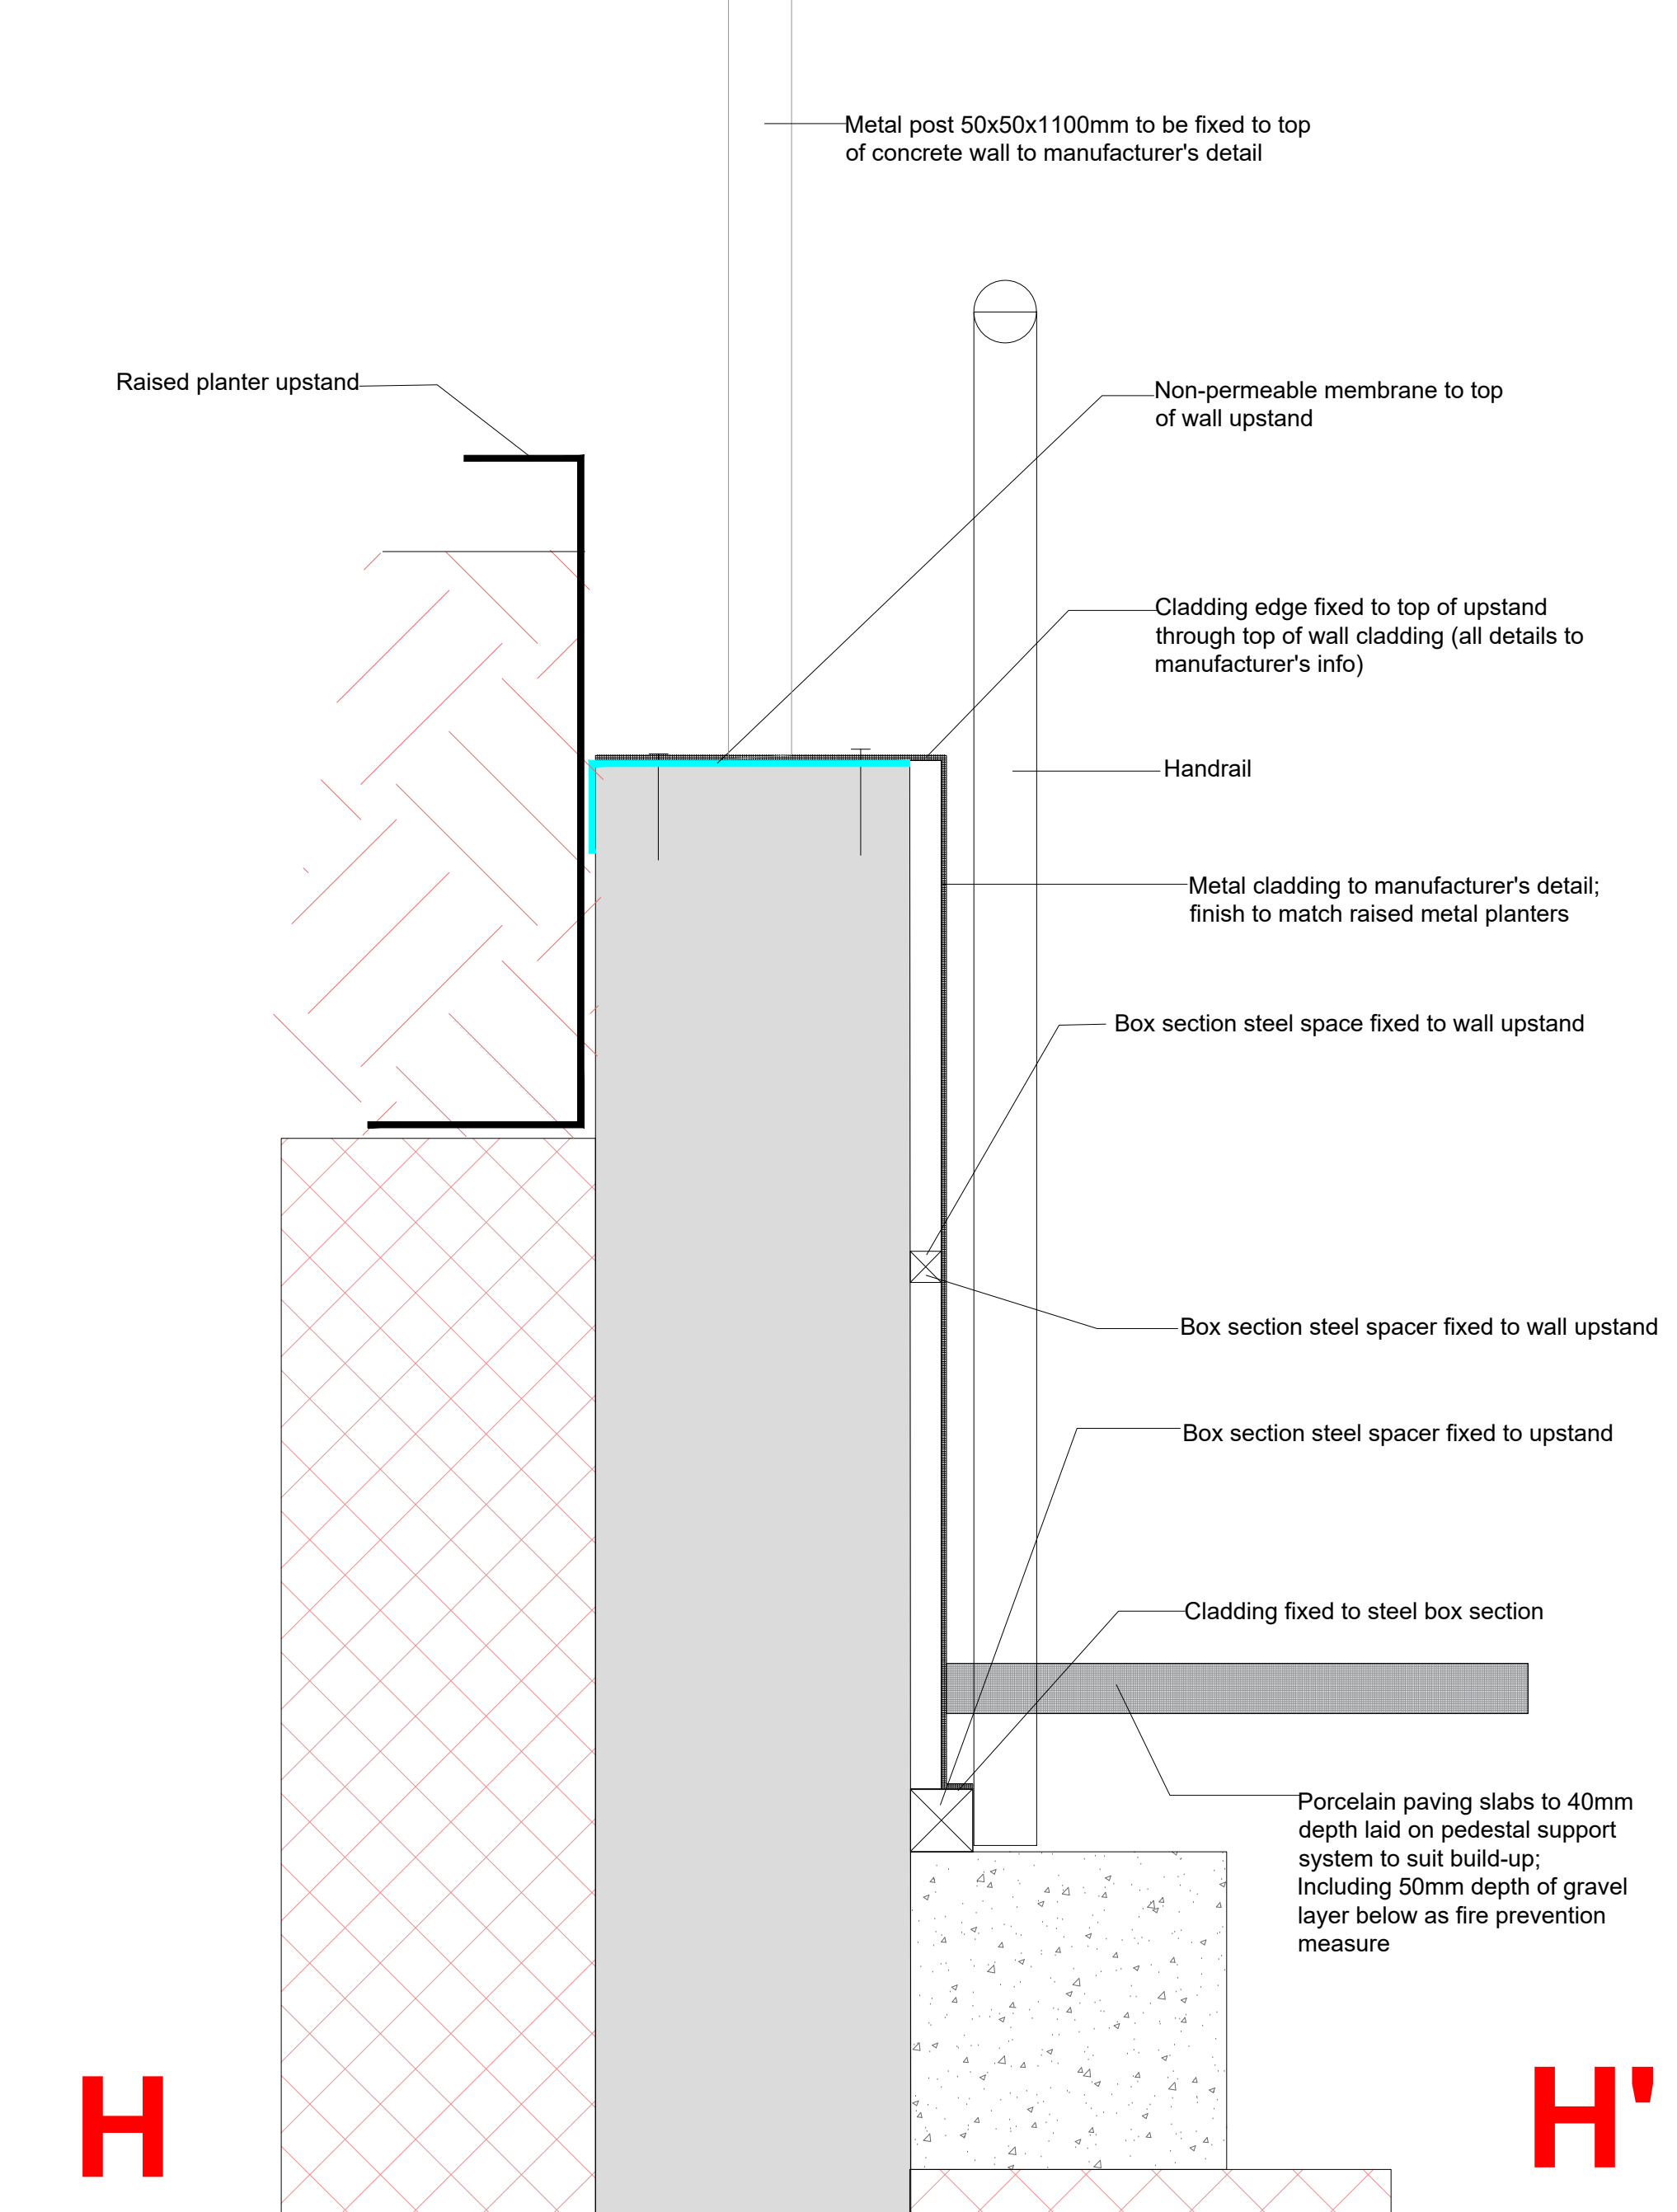

Note:
Changes introduced from Reform design have been marked on in red.

Note:
- additional guardrail to raised planter edge in lie with H&S requirements

drawing status	S4	
	FOR TENDER	
	FOR CONSTRUCTION	
	AS BUILT	

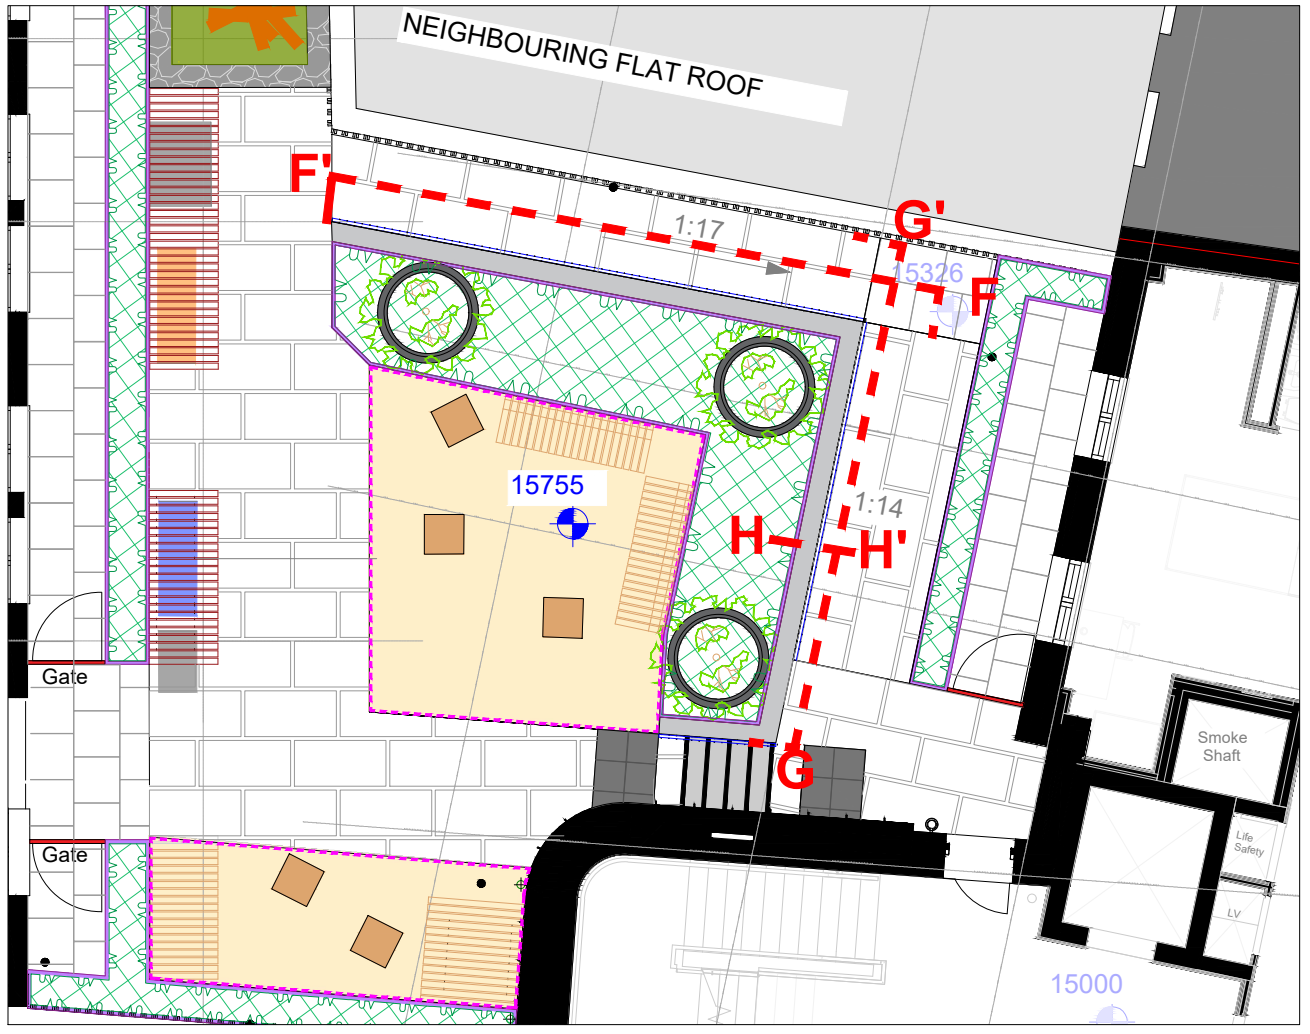

David Clarke
LANDSCAPE ARCHITECT

29 Uppertown Road, Gleno, Larne
Co. Antrim BT40 3EA
Tel: 07752805988 / 02890767875
Email: david@david-clarke.net

Client: McAleer & Rushe

Job: The Printworks
819-829, High Road, Tottenham
London N17 8ER

Title: Landscape Details Podium 3 of 3

Dwg Ref: 179-DCA-B2-01-DR-L-90020

Scale: as shown @ A1 Date: 24/03/2026

Drawn By: cs Rev: C01