

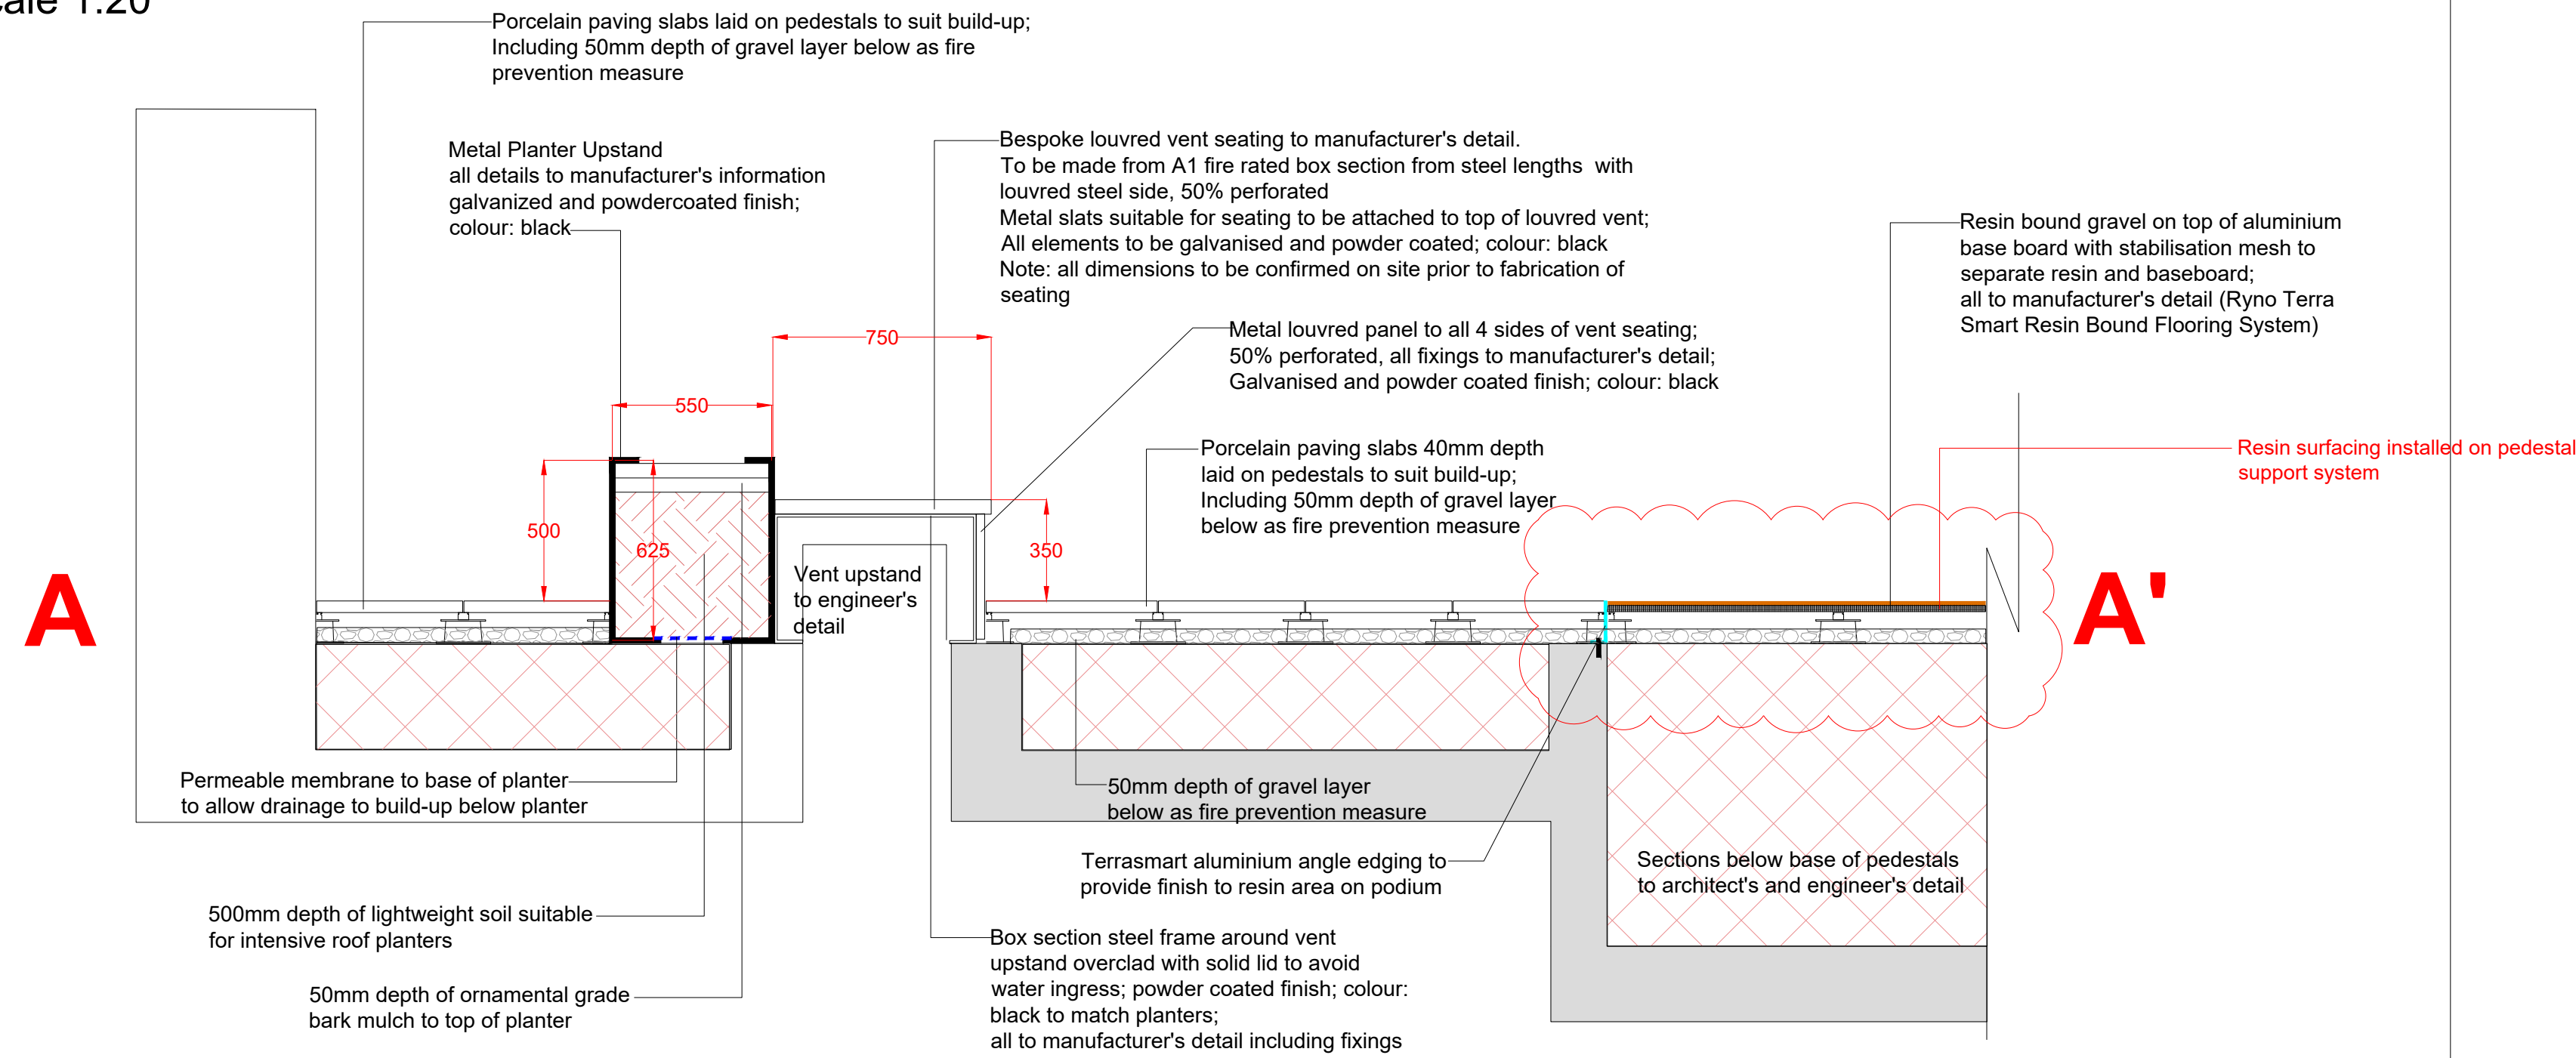


Section AA'
Scale 1:20

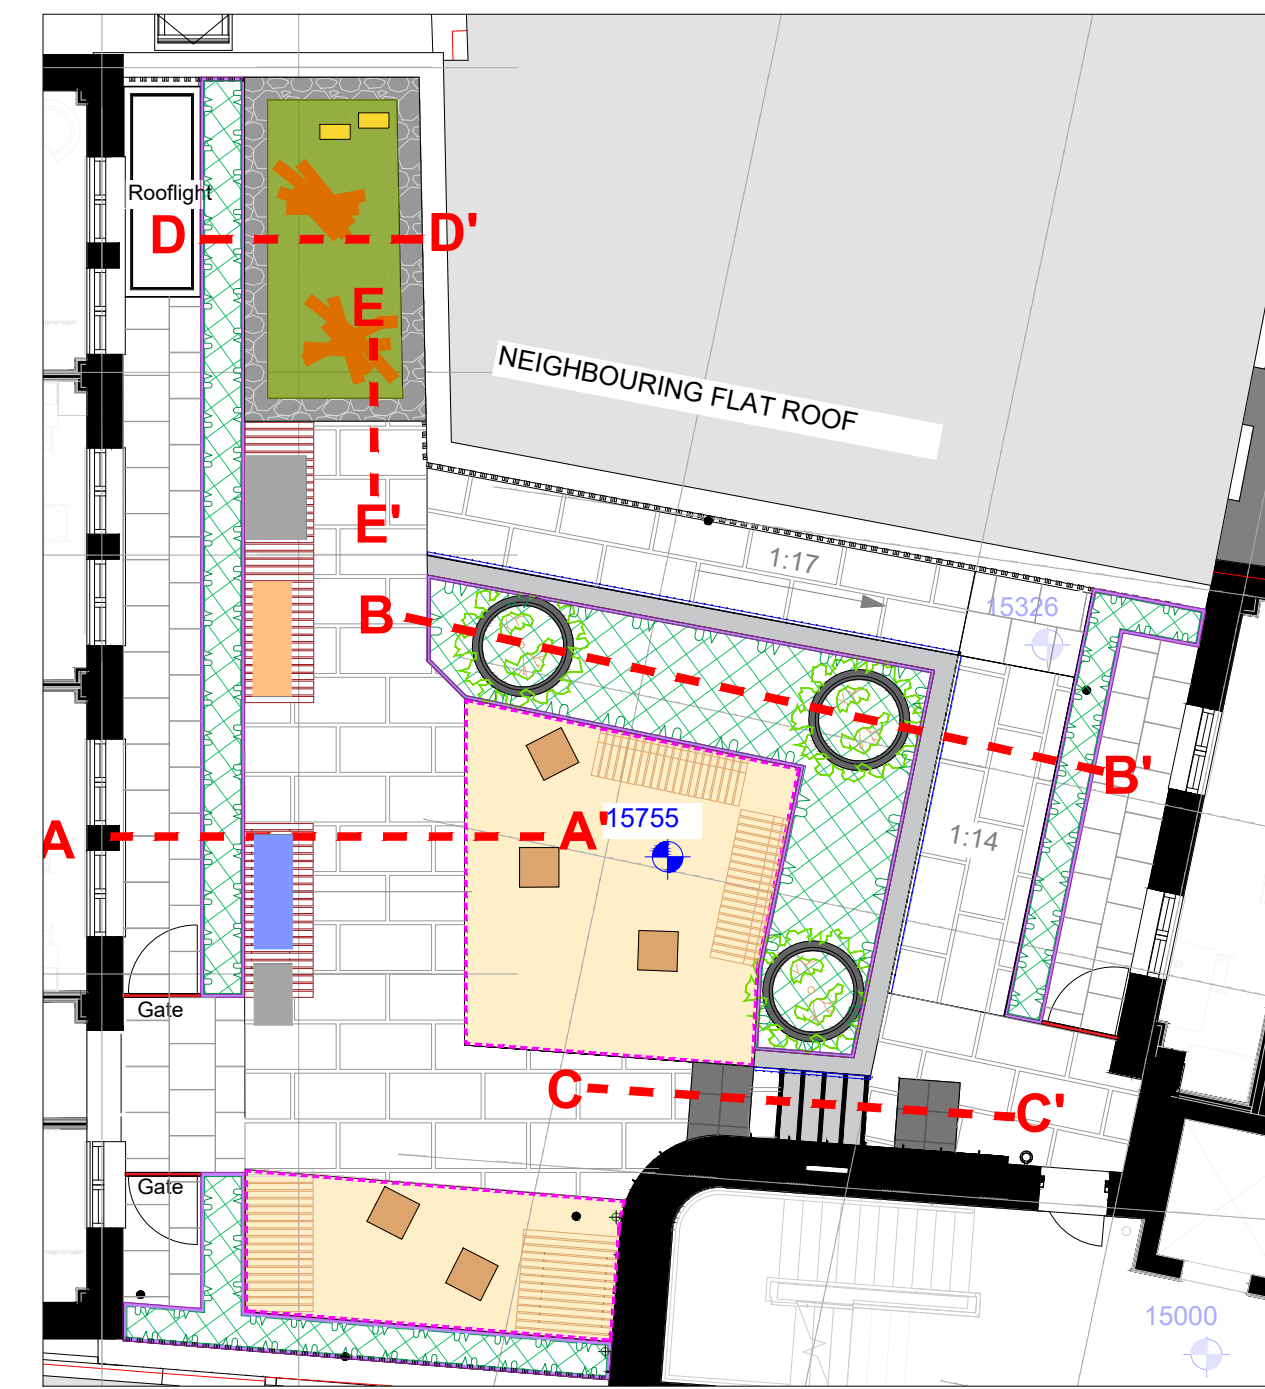

Section BB'
Scale 1:20

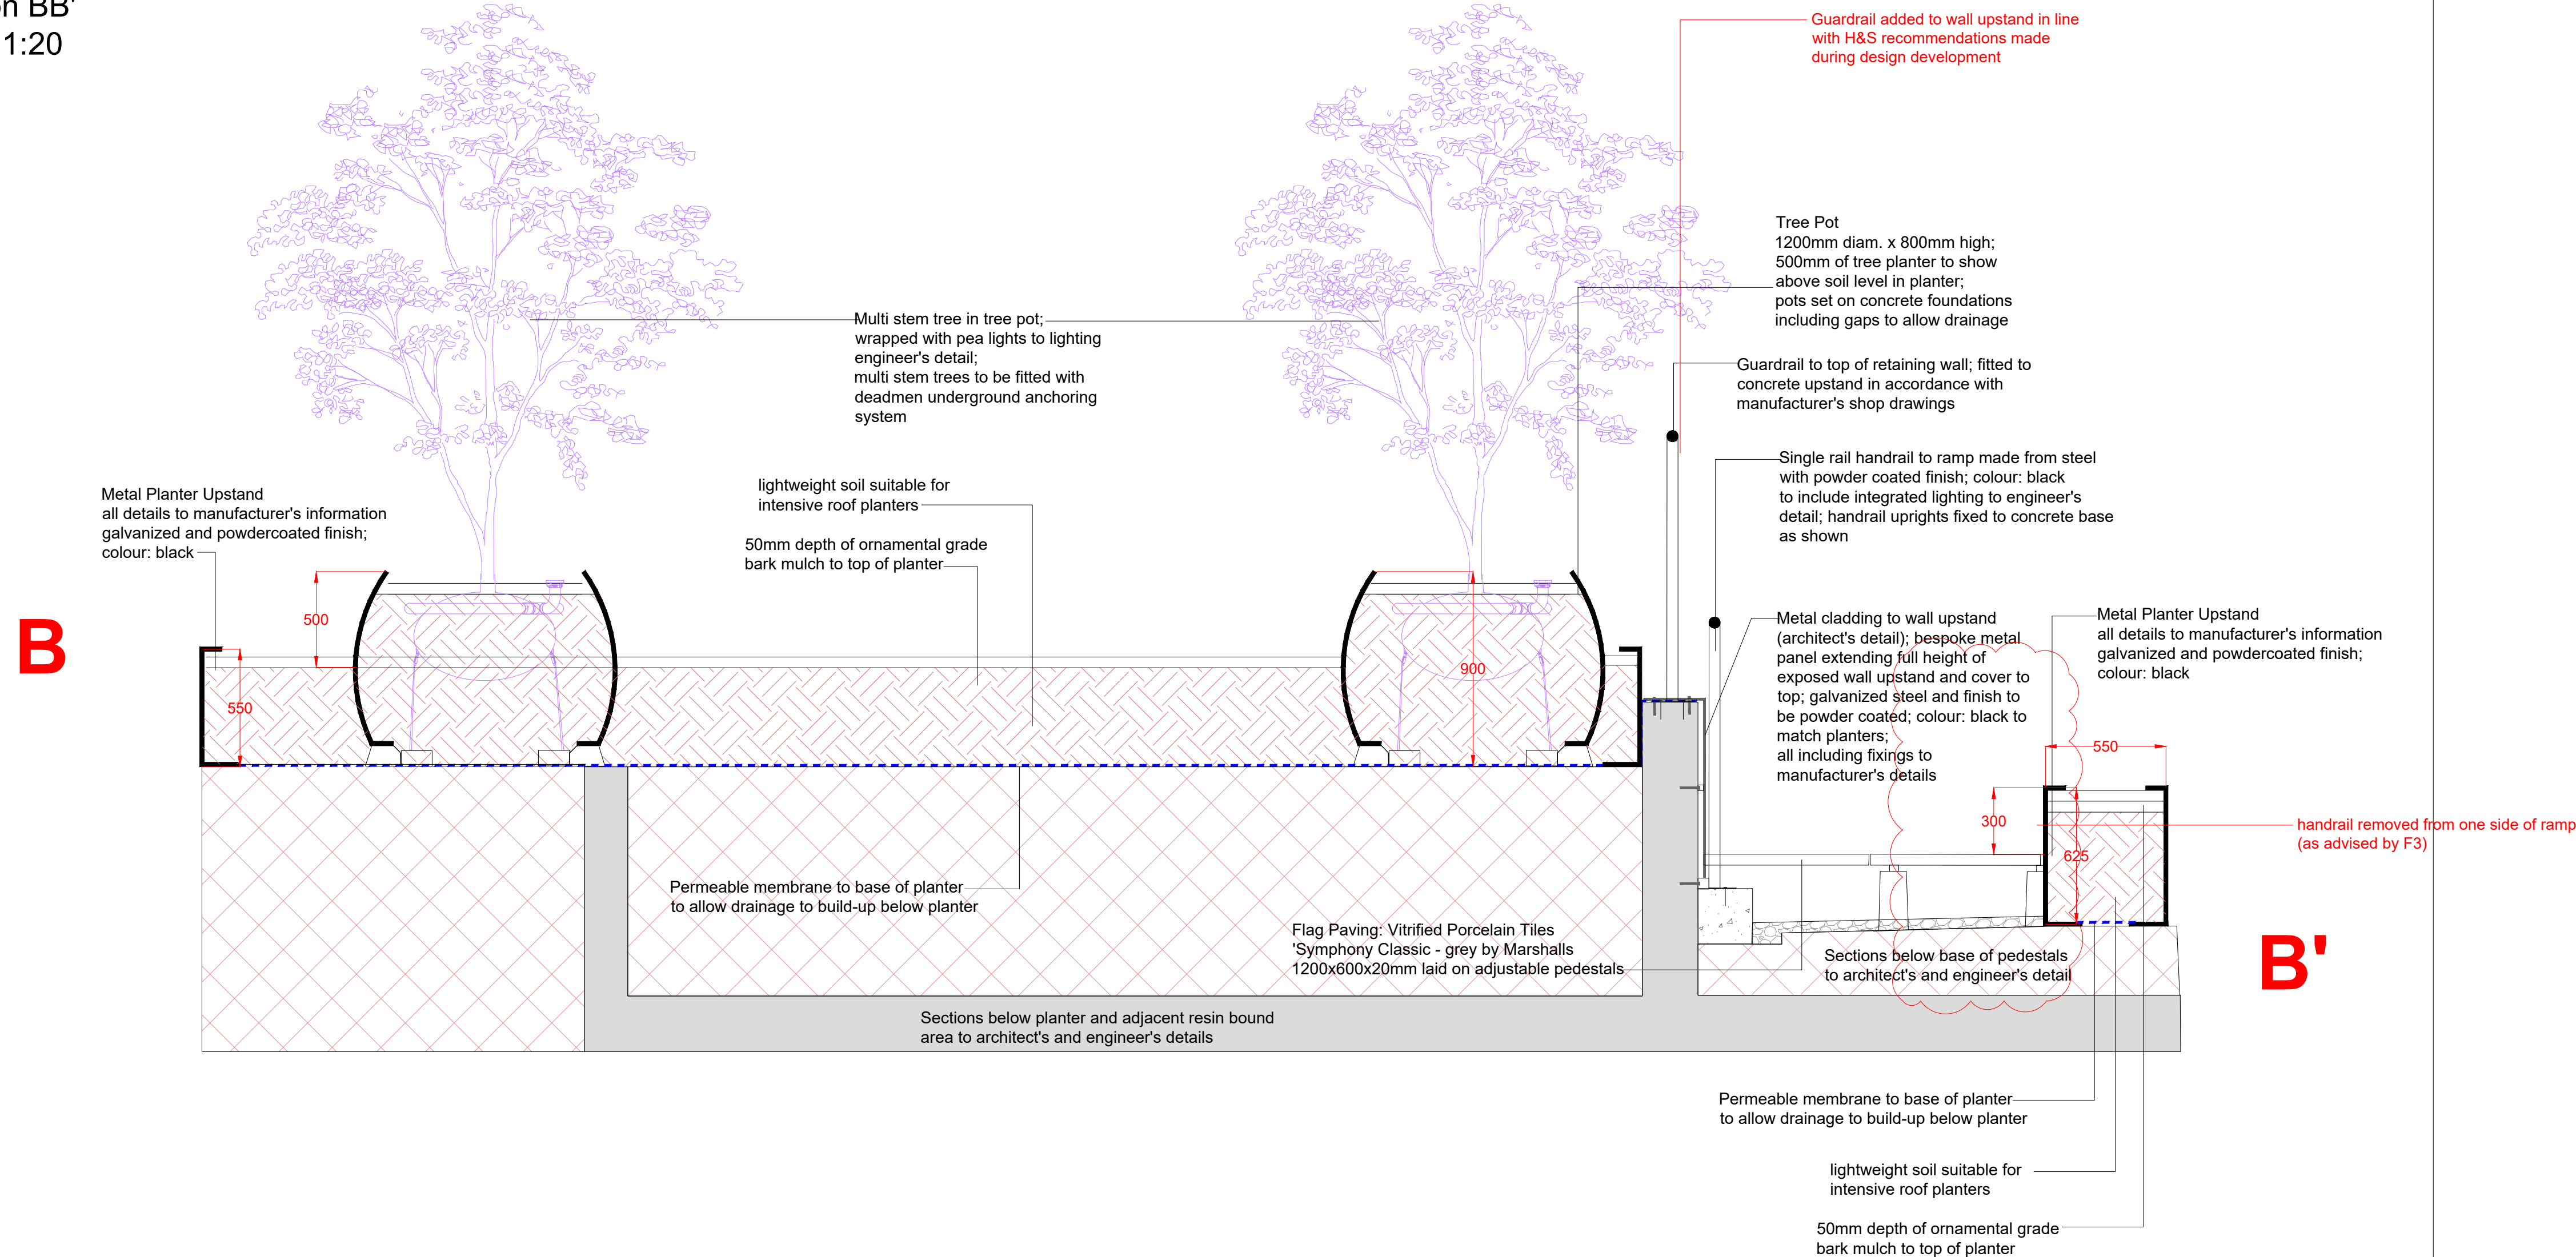

Note:

Changes introduced from Reform design have been
marked on in red.

Noted revisions are based on design development
and in conjunction with architect's and other design
team member's recommendations

drawing status	S4	
	FOR TENDER	
	FOR CONSTRUCTION	
	AS BUILT	



David Clarke
LANDSCAPE ARCHITECT

29 Uppertown Road, Gleno, Larne
Co. Antrim BT40 3EA
Tel: 07752805988 / 02890787875
Email: david@david-clarke.net

Client: McAleer & Rushe

Job: The Printworks
819-829, High Road, Tottenham
London N17 8ER

Title: Landscape Details Podium 1 of 3

Dwg Ref: 179-DCA-B2-01-DR-L-90014

Scale: as shown @ A1 Date: 24/03/2026

Drawn By: cs Rev: C01