

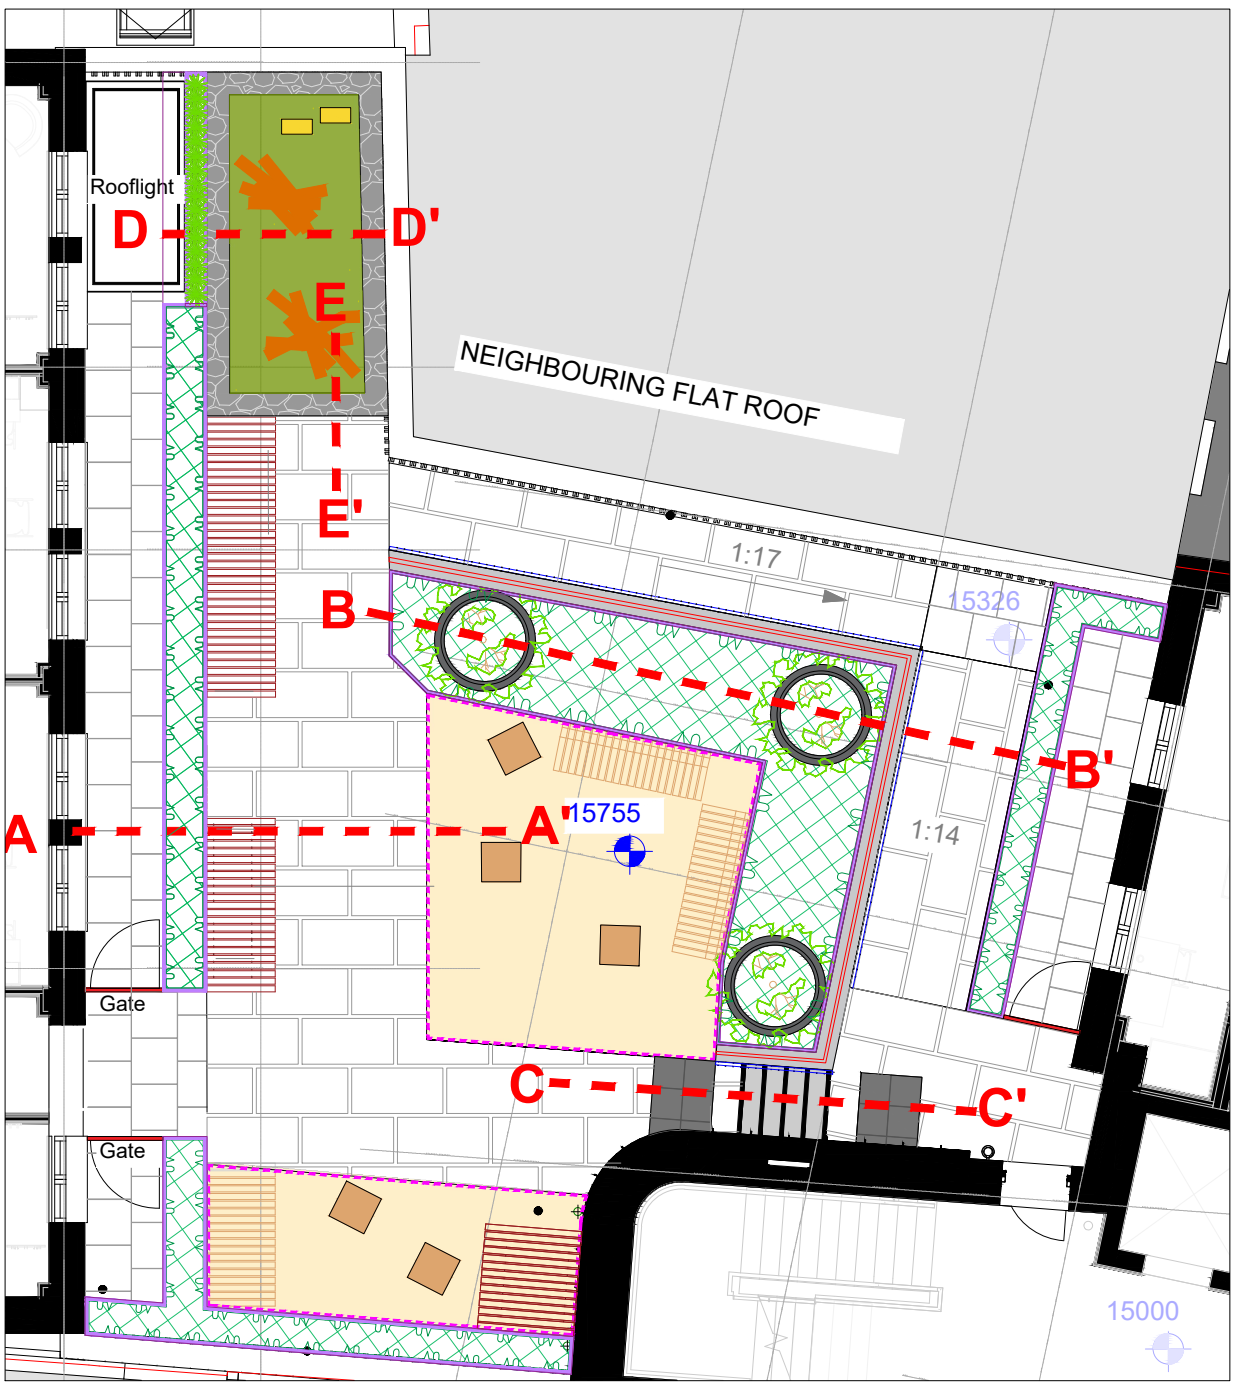



Section CC'
Scale 1:20

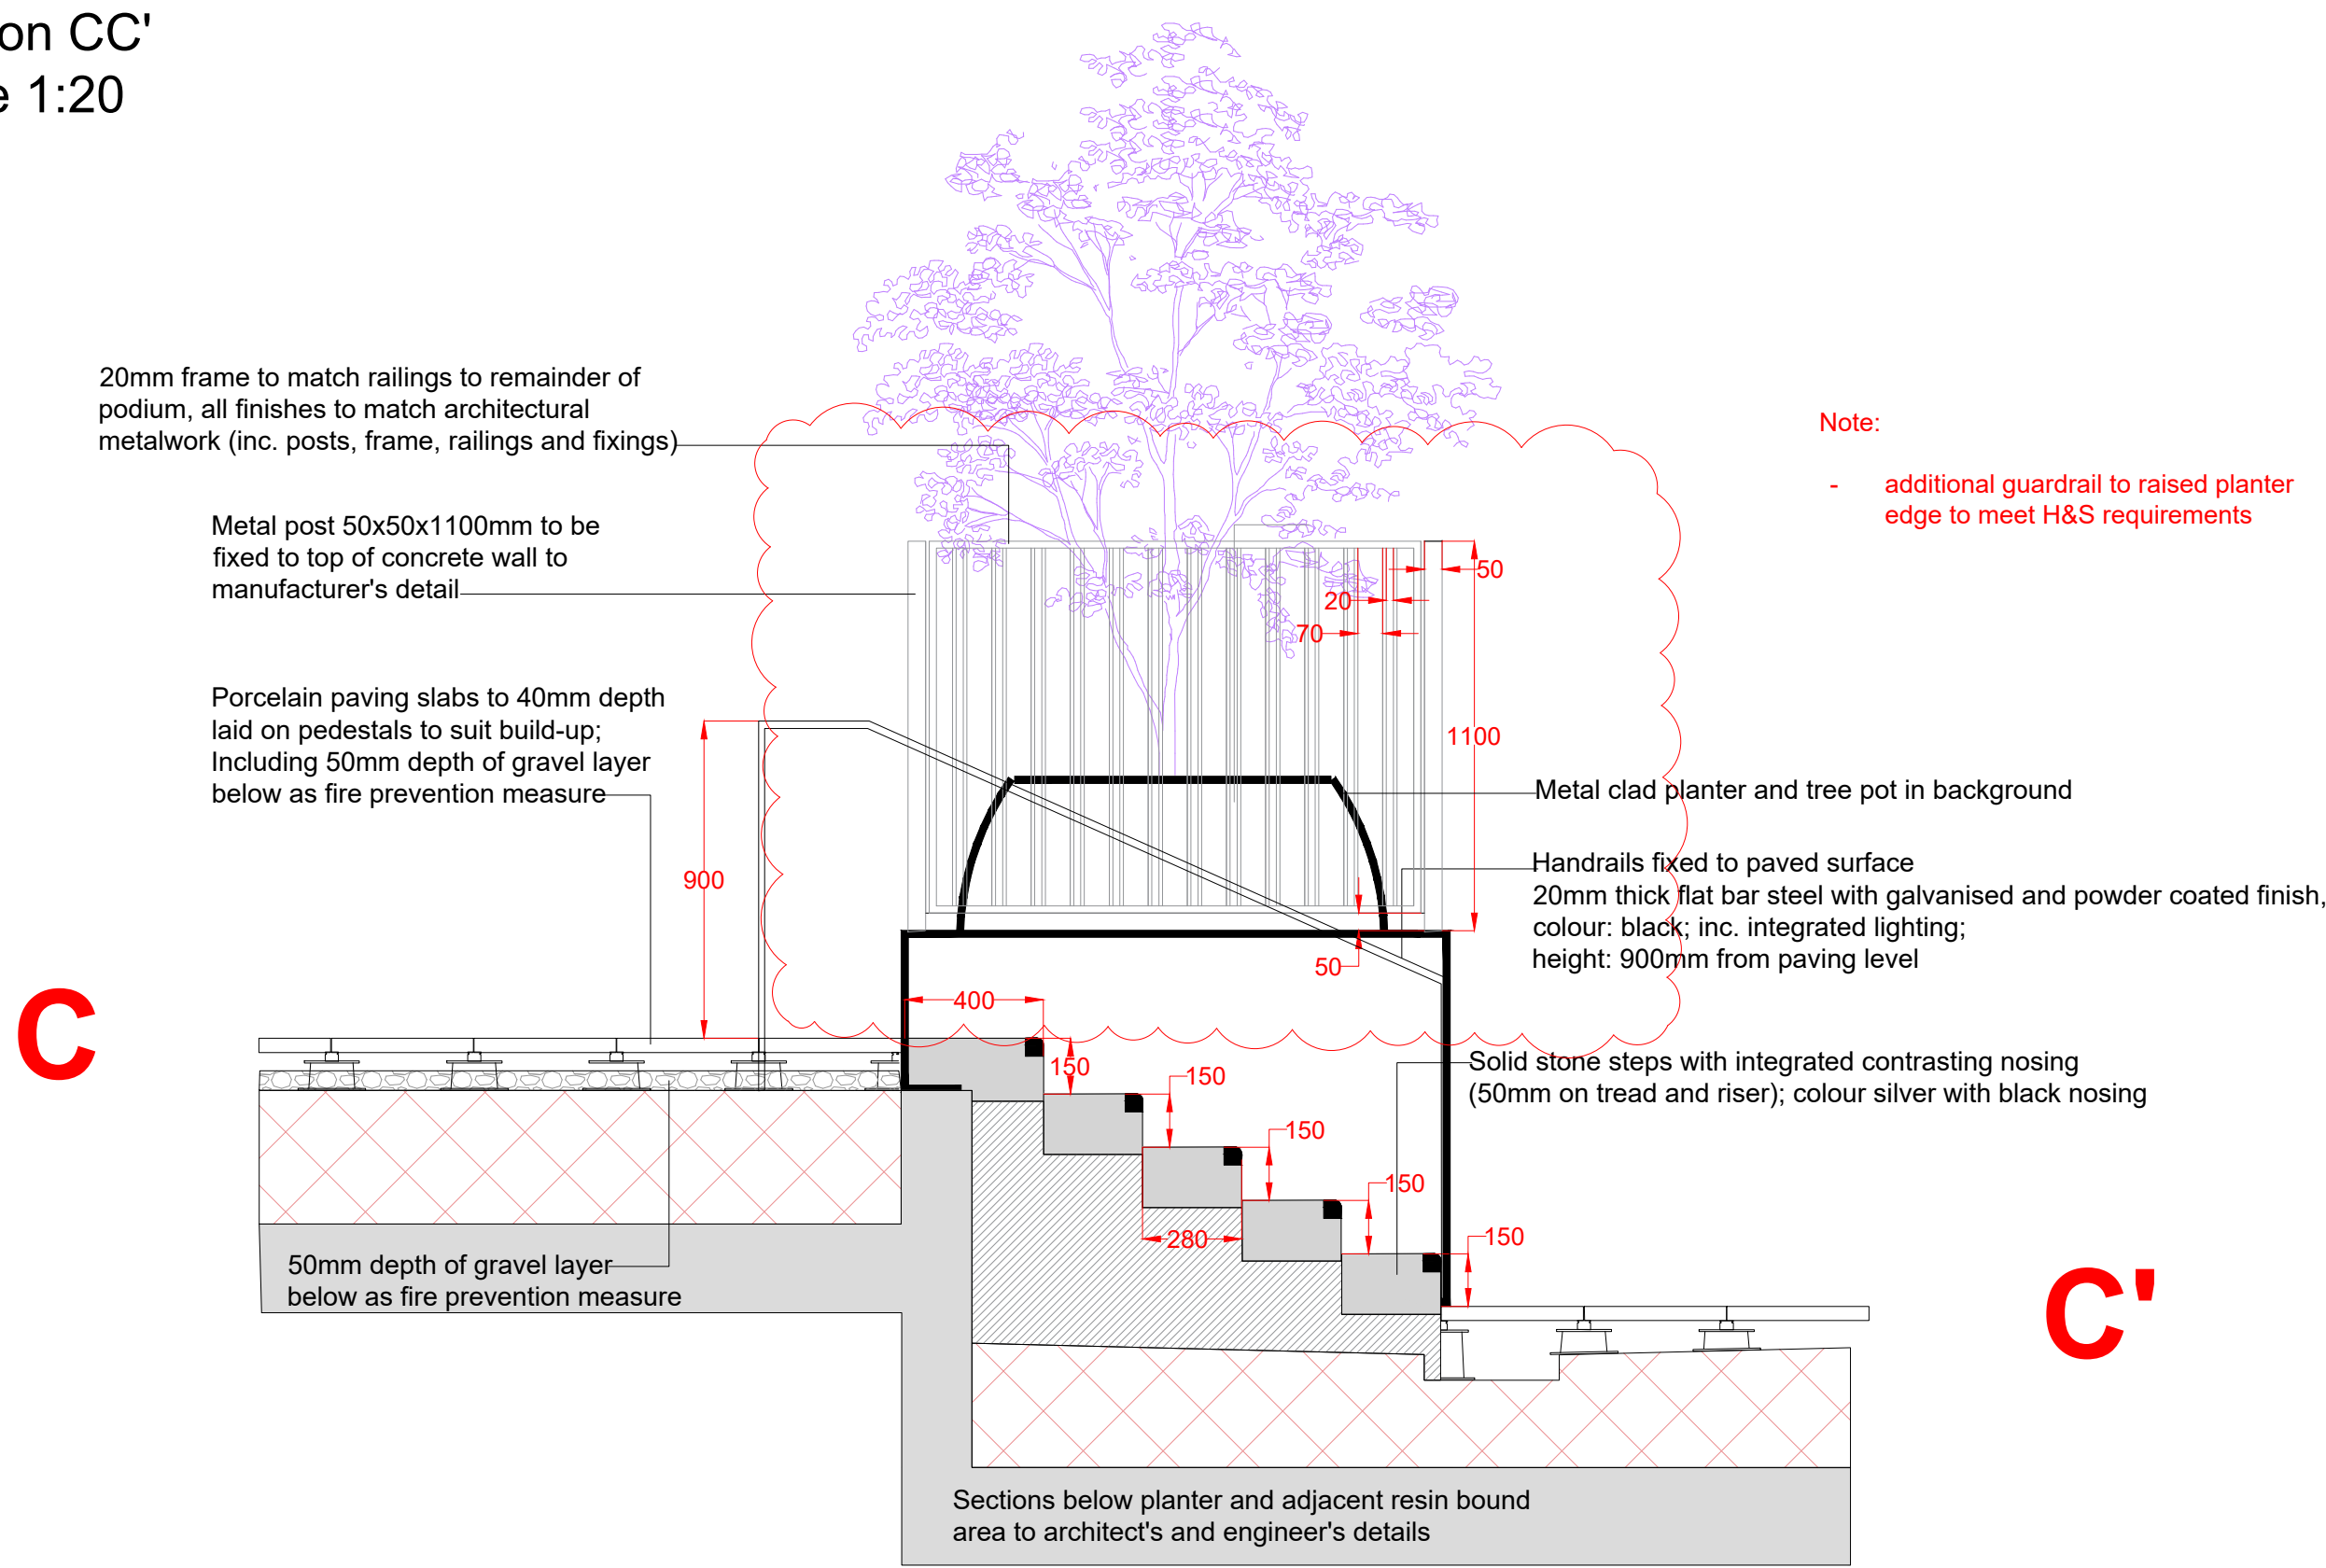

Section DD'
Scale 1:20

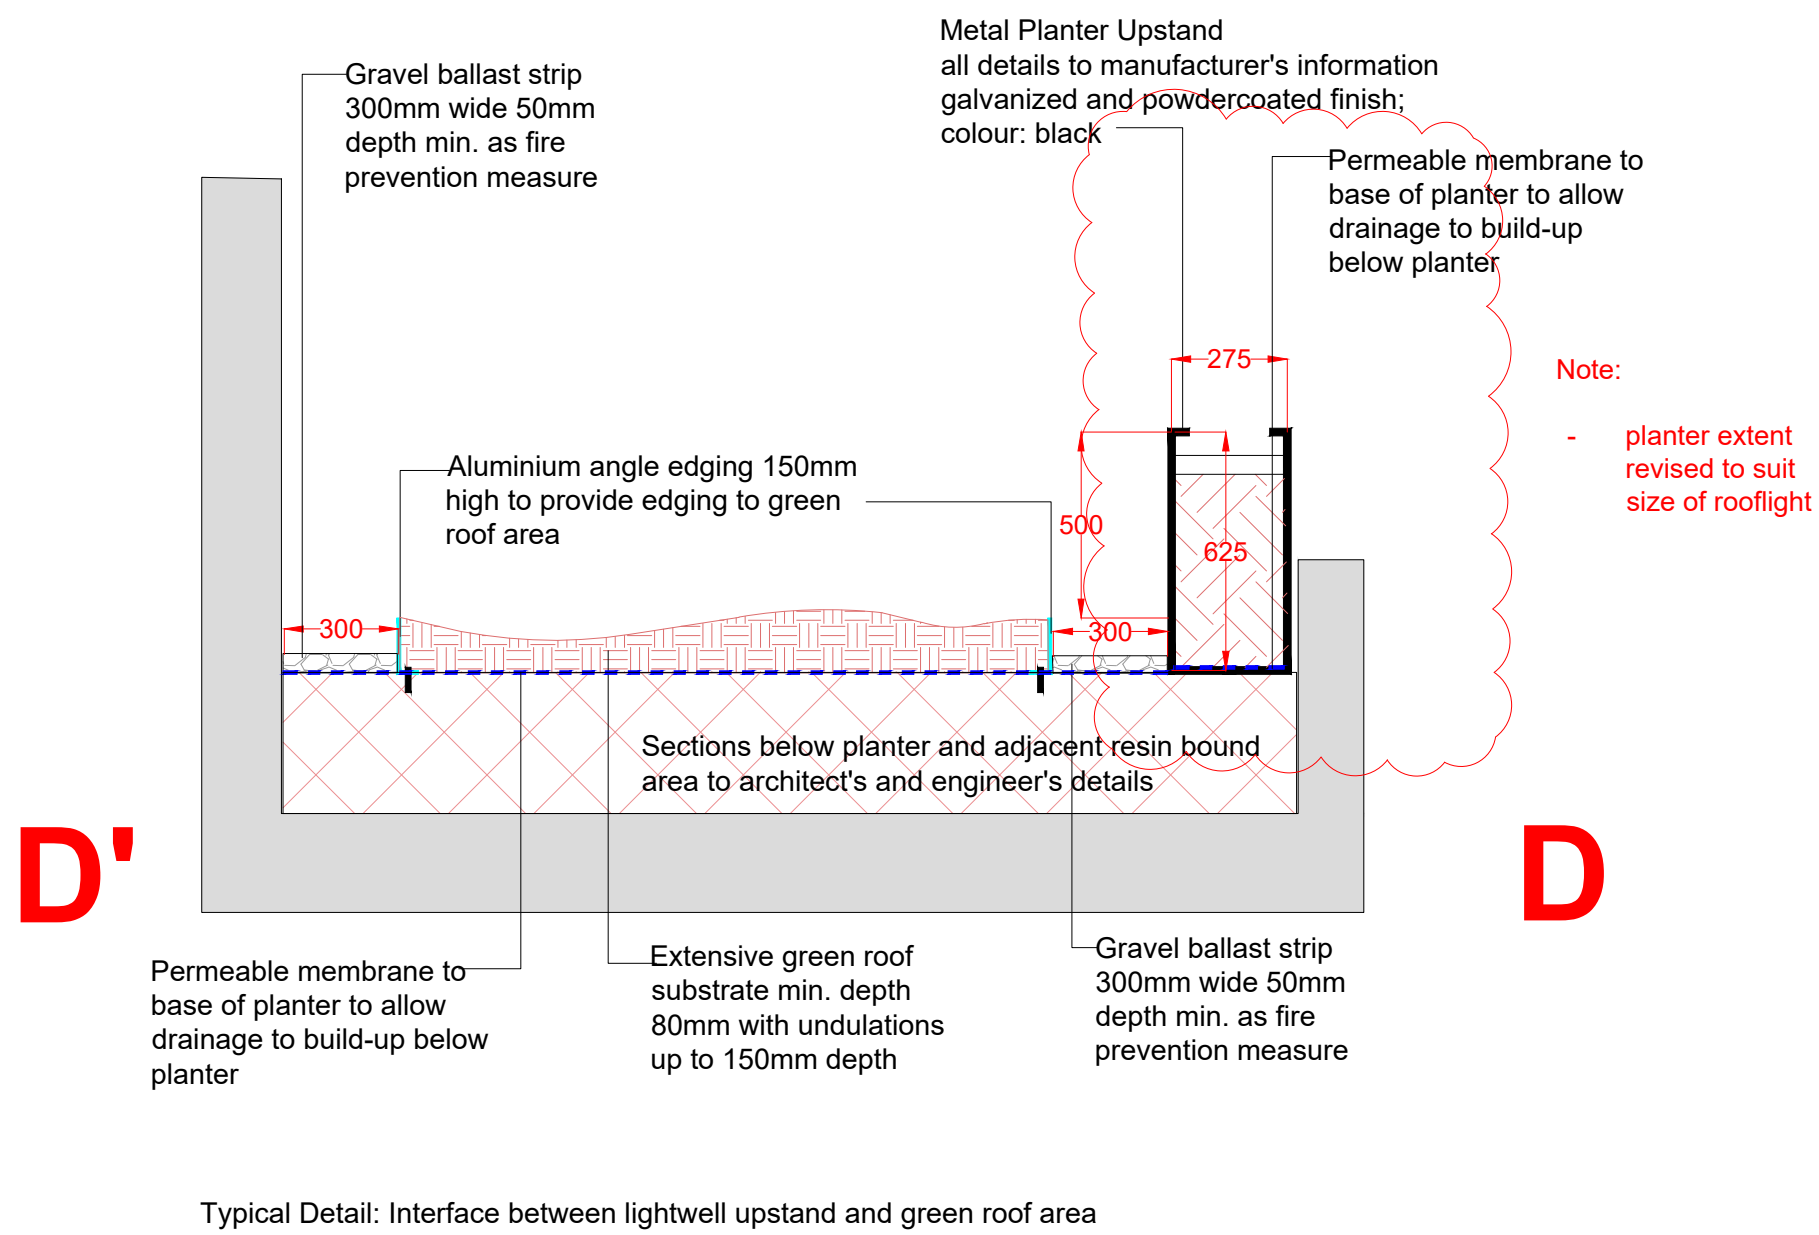

Section EE'
Scale 1:20

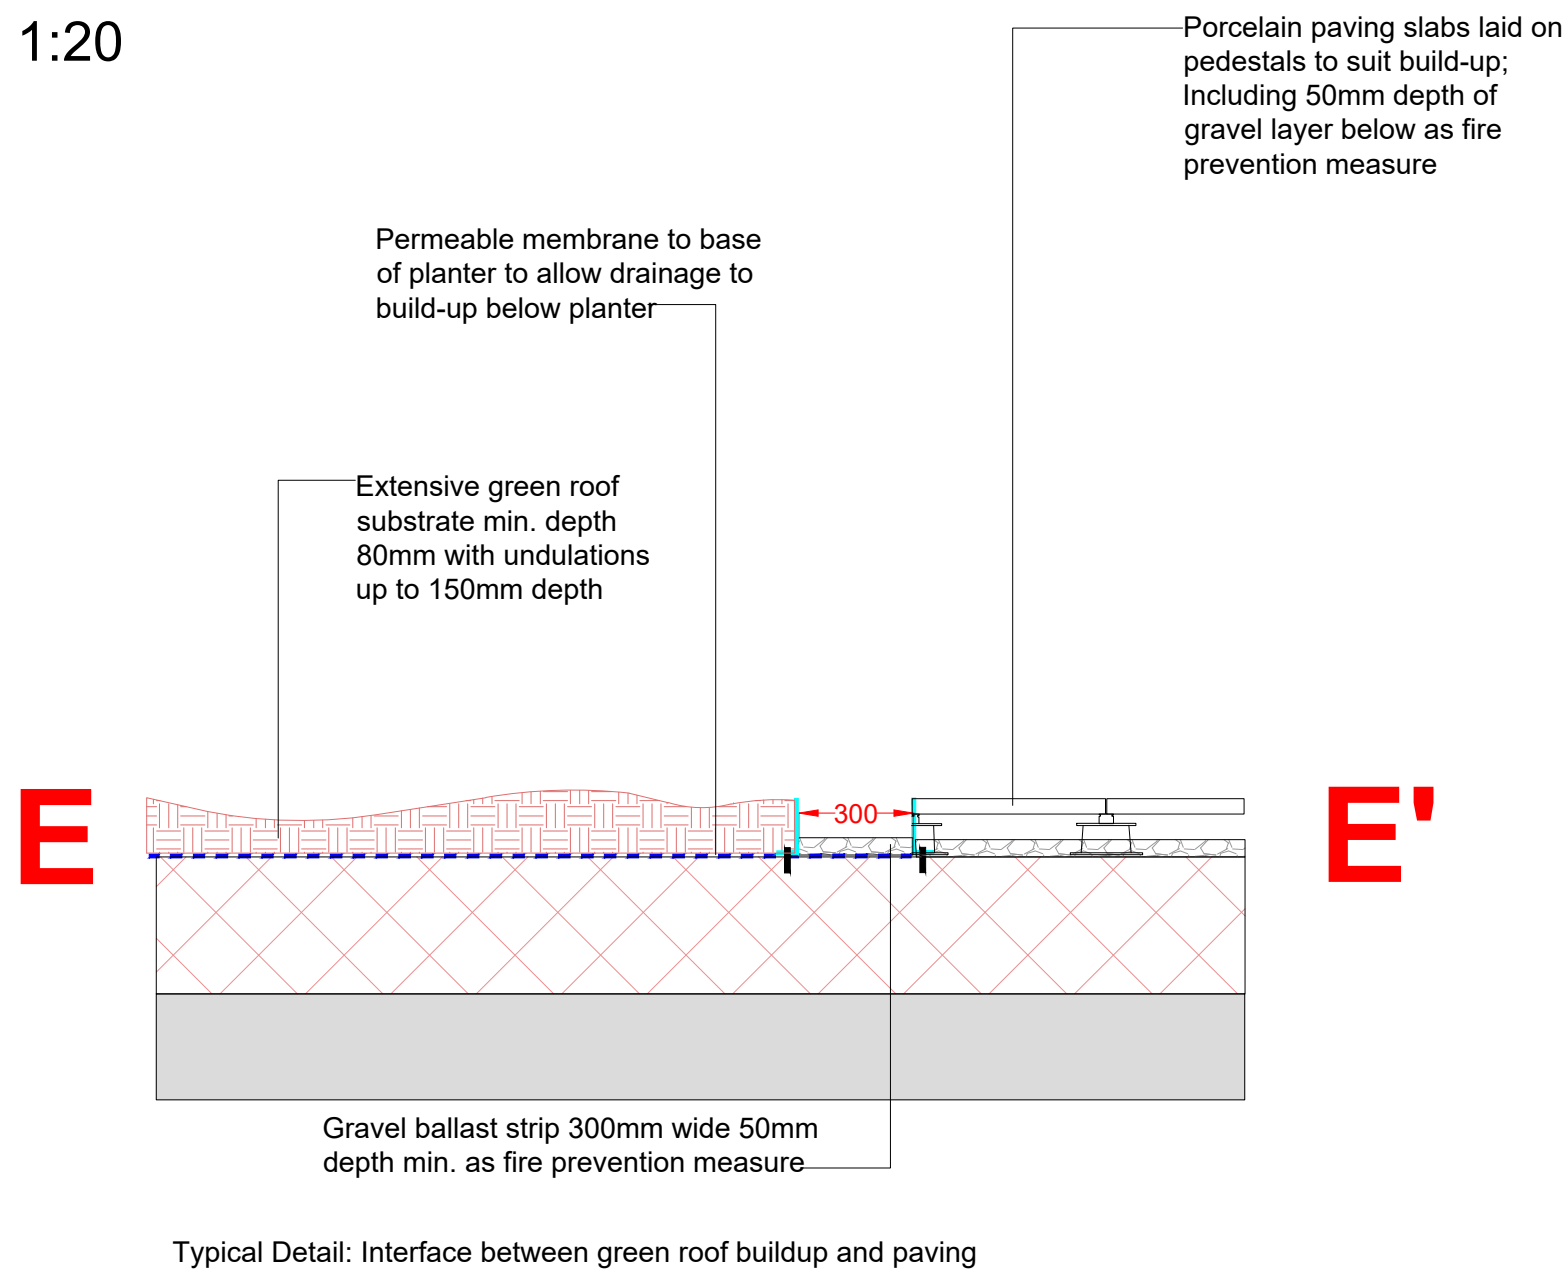

- Note:
- Changes introduced from Reform design have been marked on in red.
- Note:
- additional guardrail to raised planter edge in lie with H&S requirements
 - planter adjacent to rooflight adjusted to suit architectural design

drawing status	S4	
	FOR TENDER	
	FOR CONSTRUCTION	
	AS BUILT	



David Clarke
LANDSCAPE ARCHITECT

29 Uppertown Road, Gleno, Larne
Co. Antrim BT40 3EA
Tel: 01752805988 / 02890767875
Email: david@david-clarke.net

Client: McAleer & Rushe

Job: The Printworks
819-829, High Road, Tottenham
London N17 8ER

Title: Landscape Details Podium 2 of 3

Dwg Ref: 179-DCA-B2-01-DR-L-90019

Scale: as shown @ A1 Date: 24/03/2026

Drawn By: cs Rev: C01