






EXISTING/ AS BUILT
REAR ELEVATION (S)

(1 : 100)

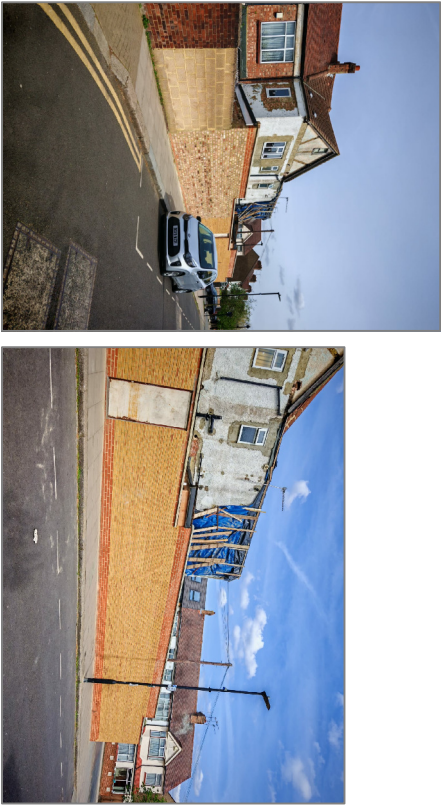

PRE-EXISTING REAR ELEVATION (S)

(1 : 100)

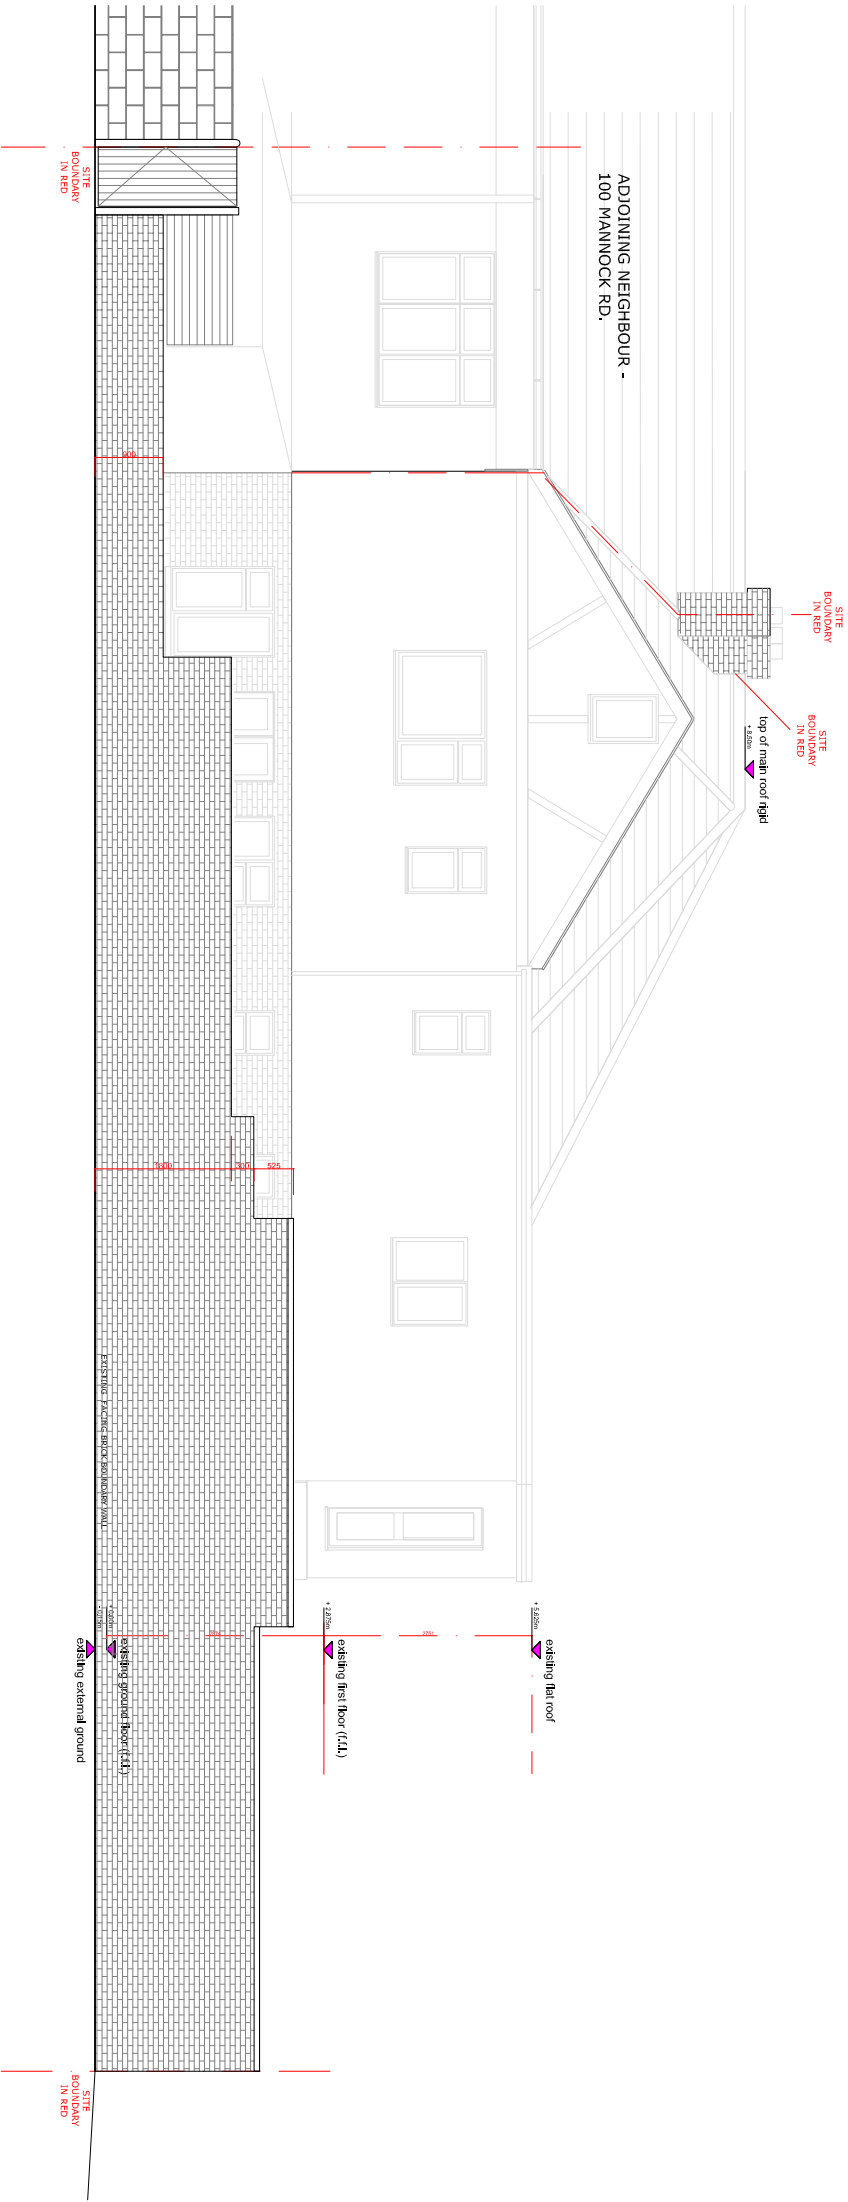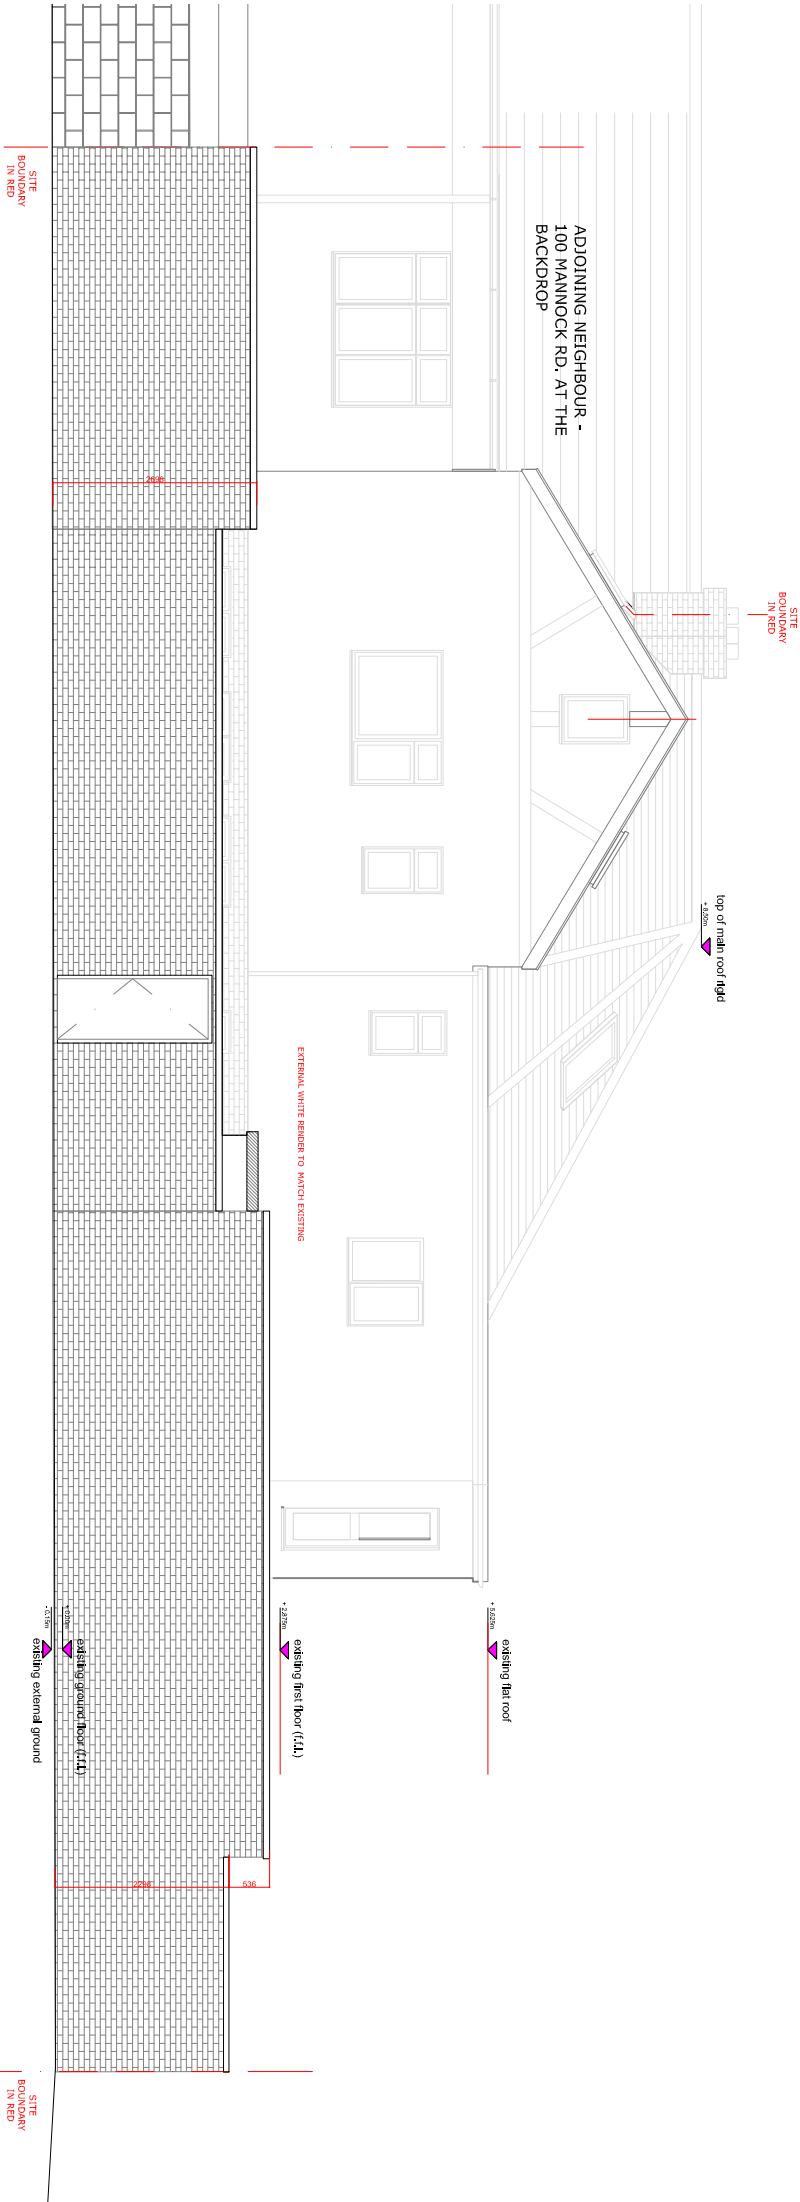

FILE PATH SHOWN IN MARGIN

GAVIN FUNG ARCHITECTS

16 BROWNLOW COURT, BROWNLOW ROAD,
LONDON N11 2BH

e: gavin.fung@yahoo.co.uk m: 0790 6126 474



DRAWING TITLE:
REAR ELEVATIONS (VIEWS ALONG DOWNHILLS PARK ROAD)

PROJECT TITLE:

PROPOSED NEW ROOF EXTENSION TO THE EXISTING PITCH ROOF WITH
A NEW LOFT ROOM CONVERSION, A NEW PORCH TO THE FRONT FACADE
AND TWO FLATS CONVERSION FROM THE EXISTING SINGLE DWELLING HOUSE
AT 102 MANNOCK ROAD, LONDON N22 6AA

DRAWING BY: GF SCALE: 1: 100 @ A3 DATE: DEC' 2025

DRAWING NUMBER: PROJECT STATUS | NUMBER | REV.
2503-FL PL 1011 —