



0 1 2 3 4 5m


1: 100

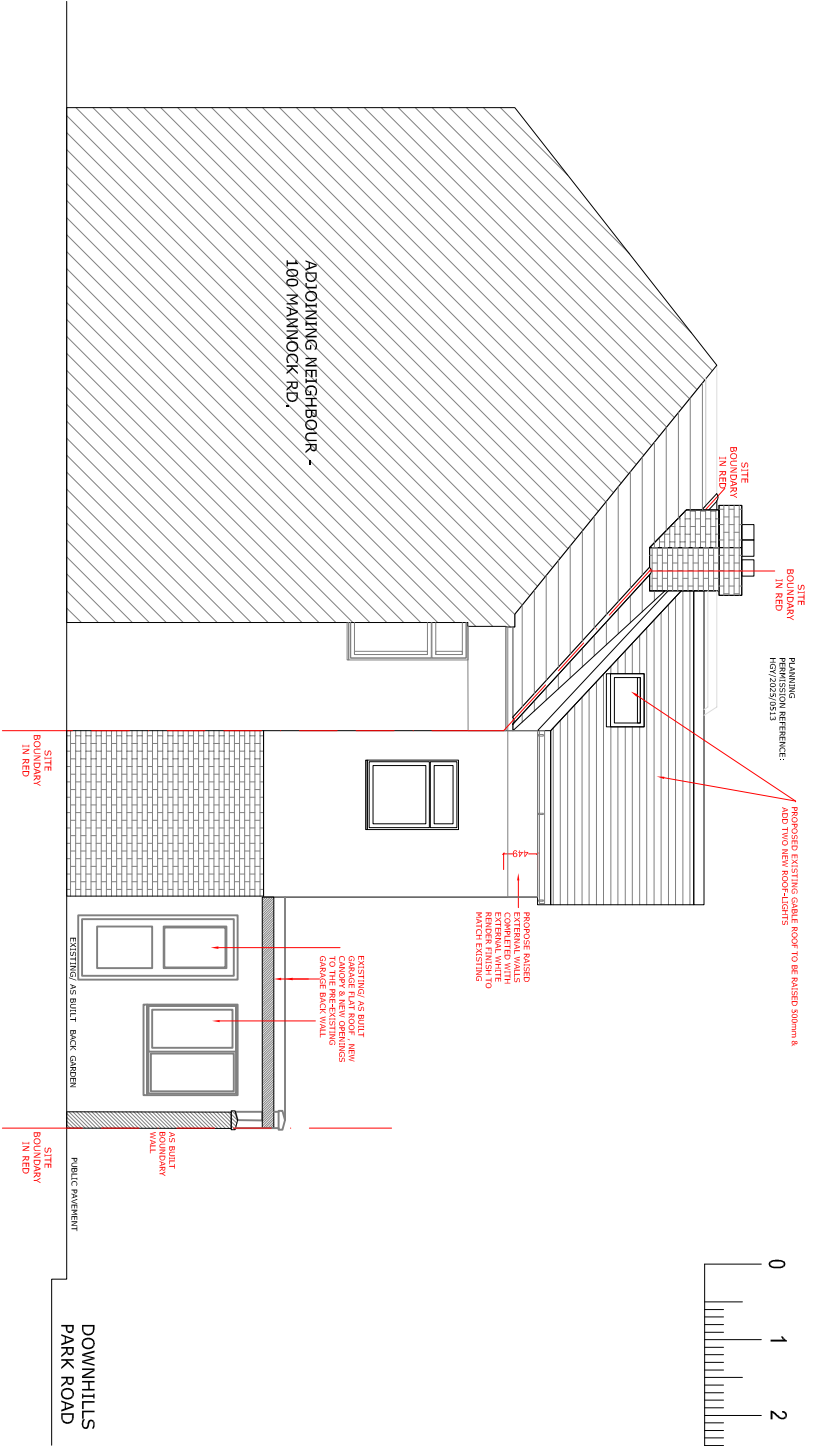

EXISTING/ AS BUILT SIDE ELEVATION (W) (1 : 100)

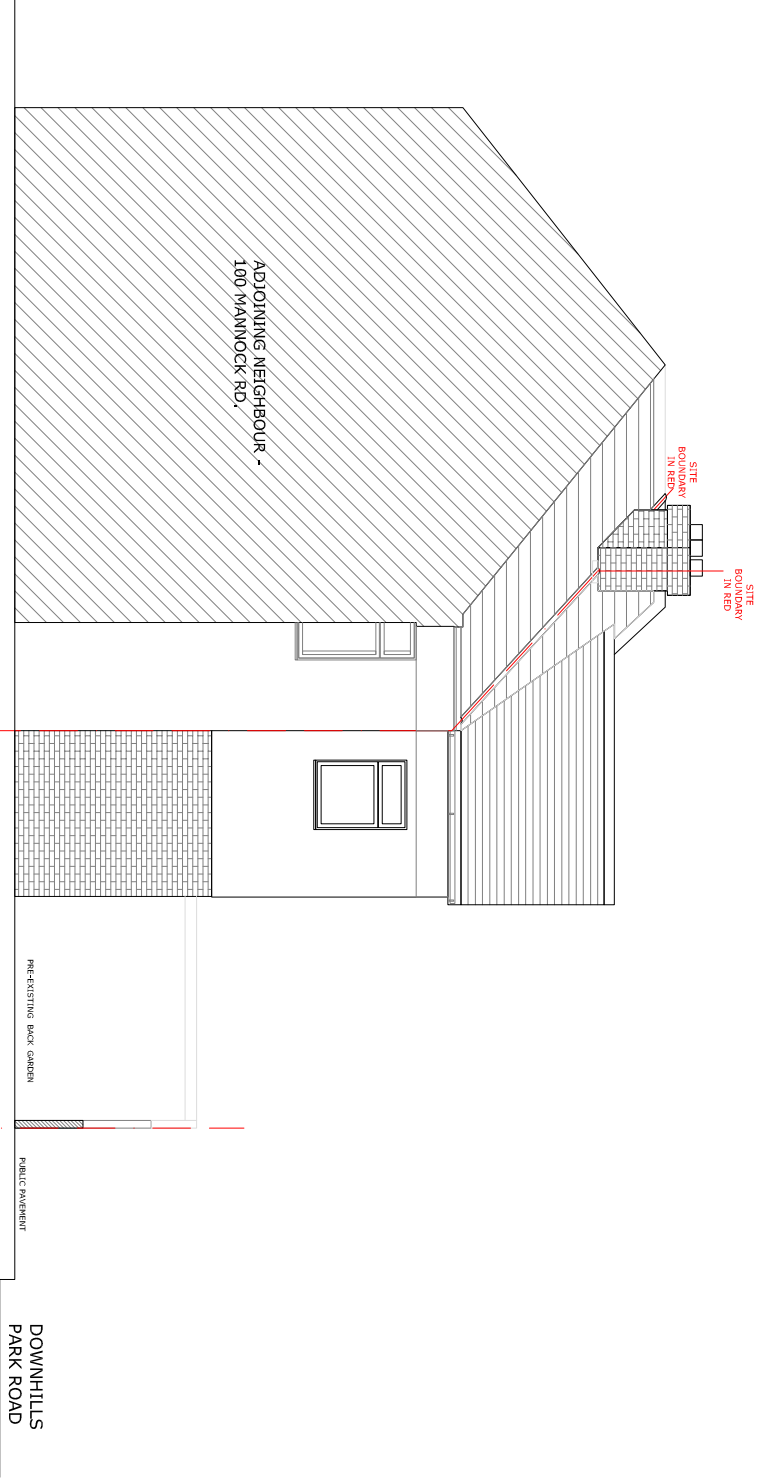

PRE-EXISTING SIDE ELEVATION (W) (1 : 100)

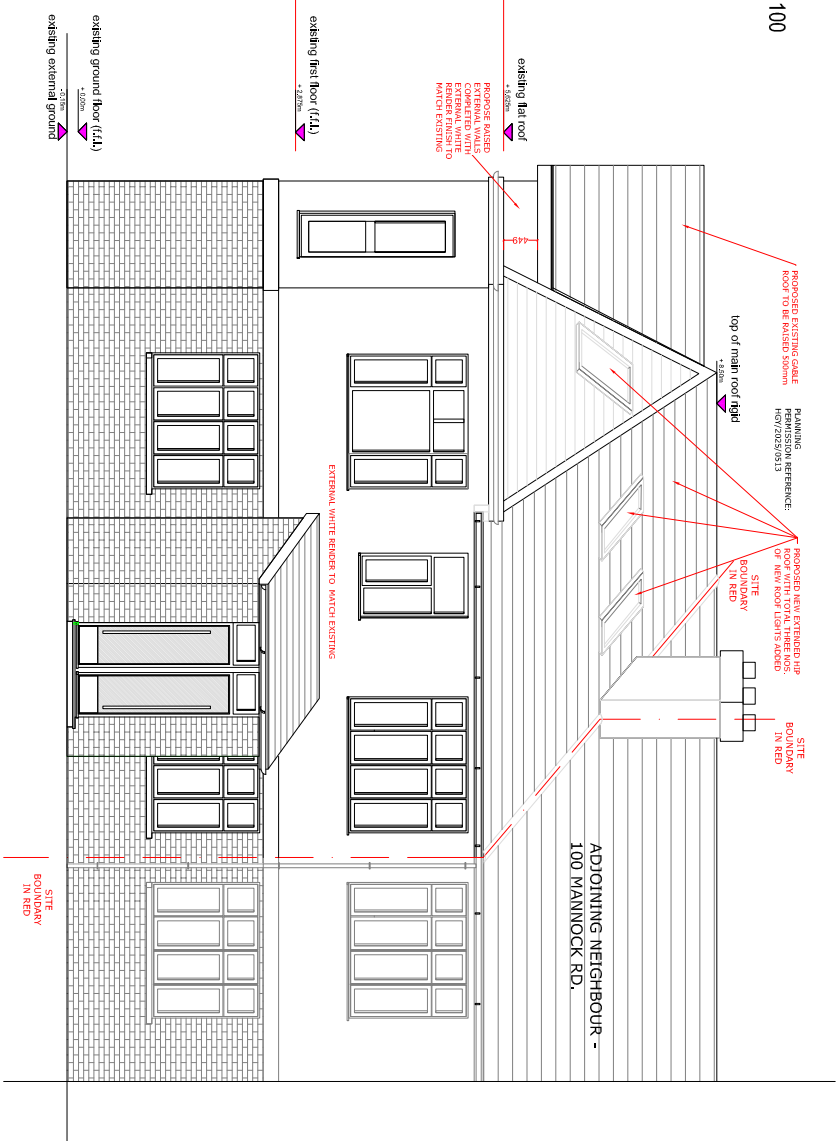

PROPOSED ELEVATION (1 : 100)
(VIEW FROM DOWNHILLS PARK RD.)



VIEWS FROM IVATT WAY TOWARDS DOWNHILLS PARK ROAD

FILE PATH SHOWN IN MARGIN

GAVIN FUNG ARCHITECTS

16 BROWNLOW COURT, BROWNLOW ROAD,
LONDON N11 2BH

e: gavin.fung@yahoo.co.uk m: 0790 6126 474



DRAWING TITLE:
SIDE ELEVATIONS (FACING 100 MANNOCK ROAD BACK GARDEN)

PROJECT TITLE:
PROPOSED NEW ROOF EXTENSION TO THE EXISTING PITCH ROOF WITH
A NEW LOFT ROOM CONVERSION, A NEW PORCH TO THE FRONT FACADE
AND TWO FLATS CONVERSION FROM THE EXISTING SINGLE DWELLING HOUSE
AT 102 MANNOCK ROAD, LONDON N22 6AA

DRAWING BY:	SCALE:	DATE:
GF	1: 100 @ A3	DEC' 2025
DRAWING NUMBER:	STATUS	NUMBER REV.
2503-FL	PL	1008 A