




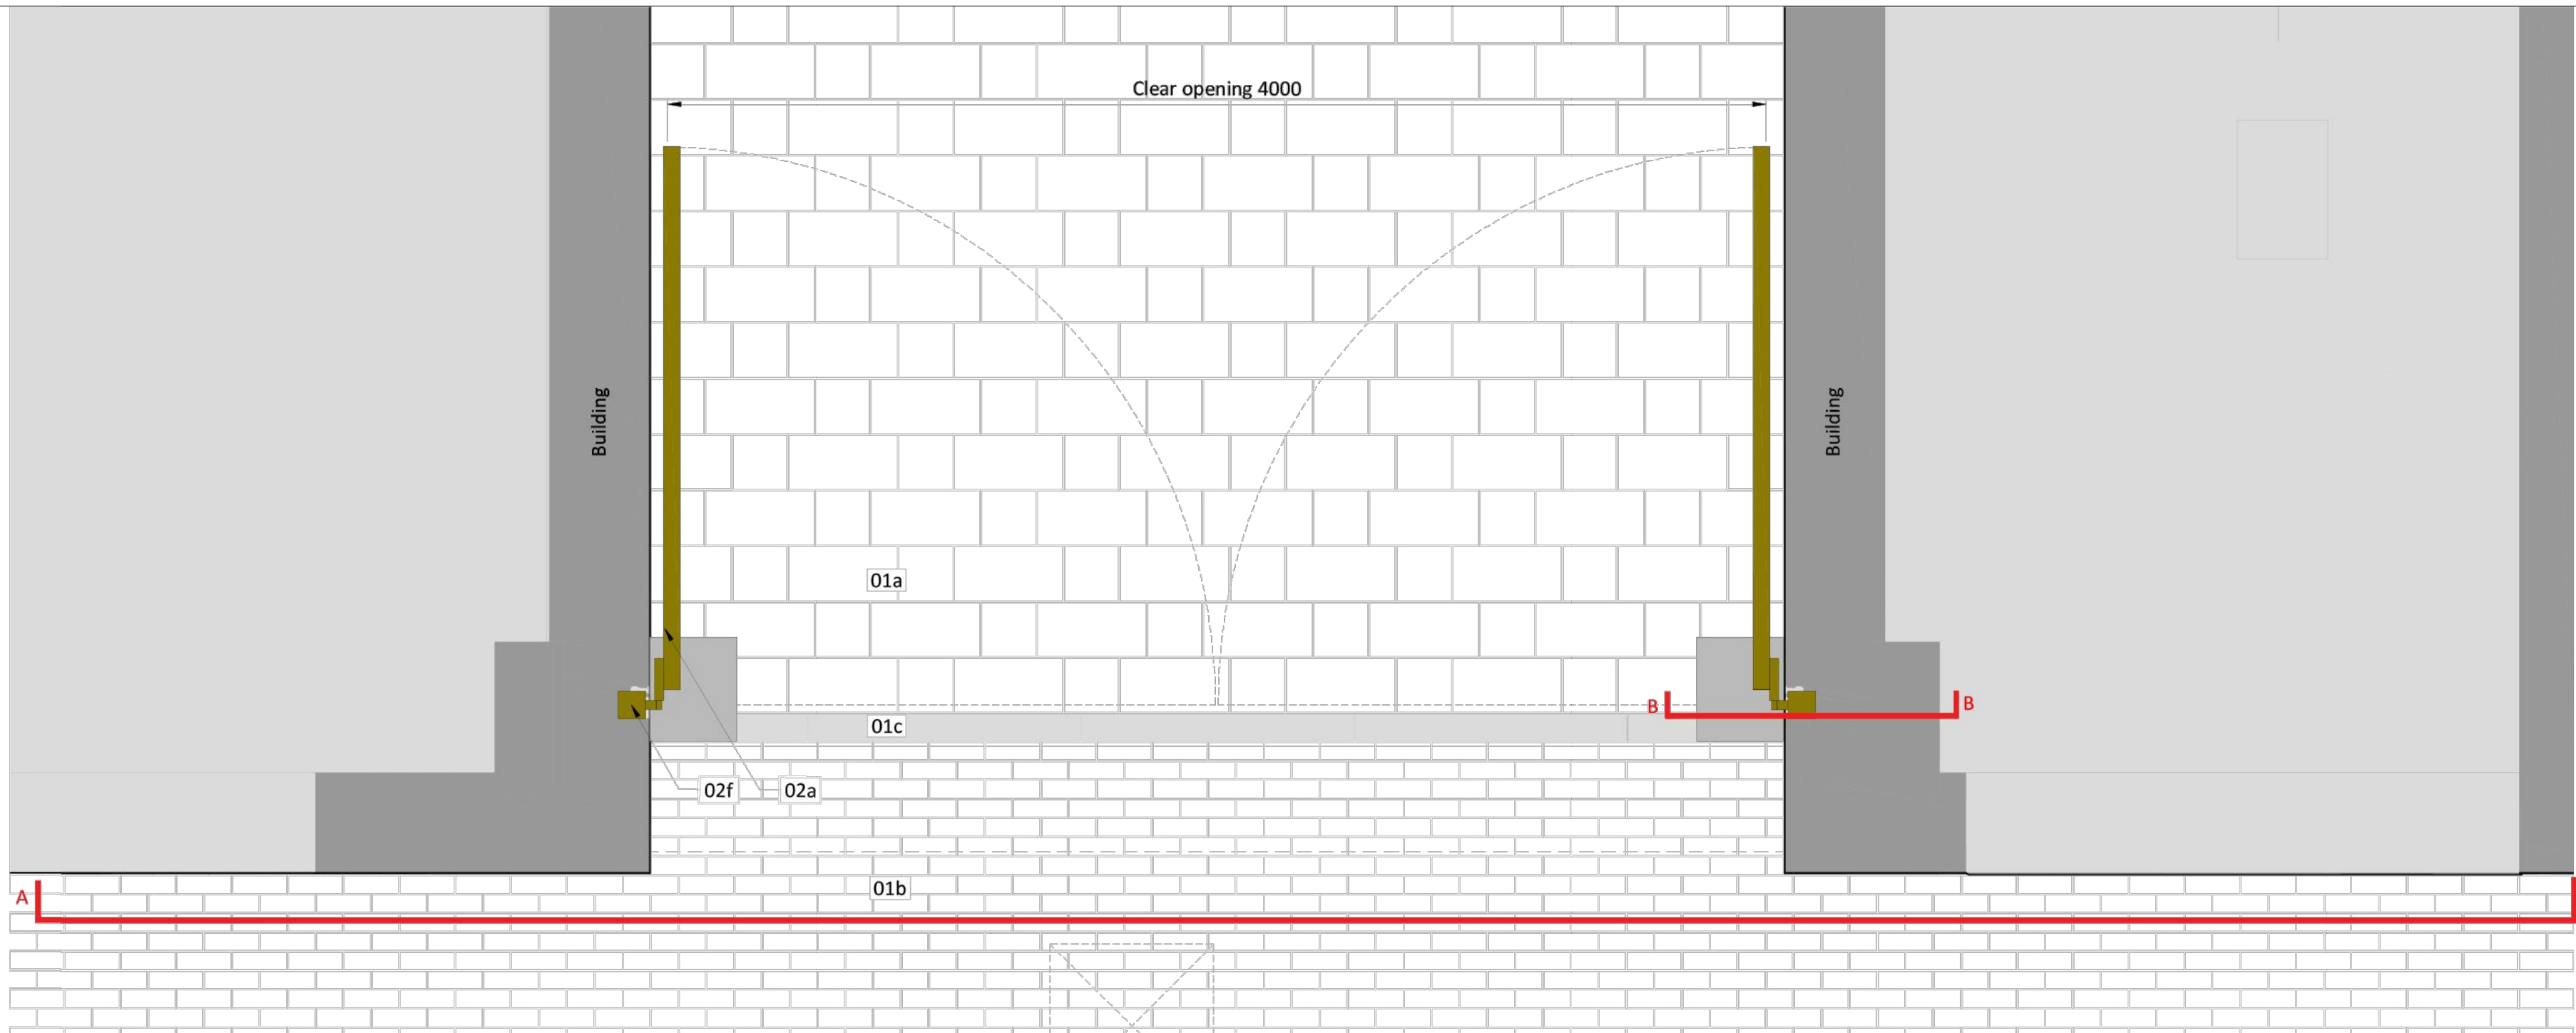

8009 Gate Plan 01 1:20

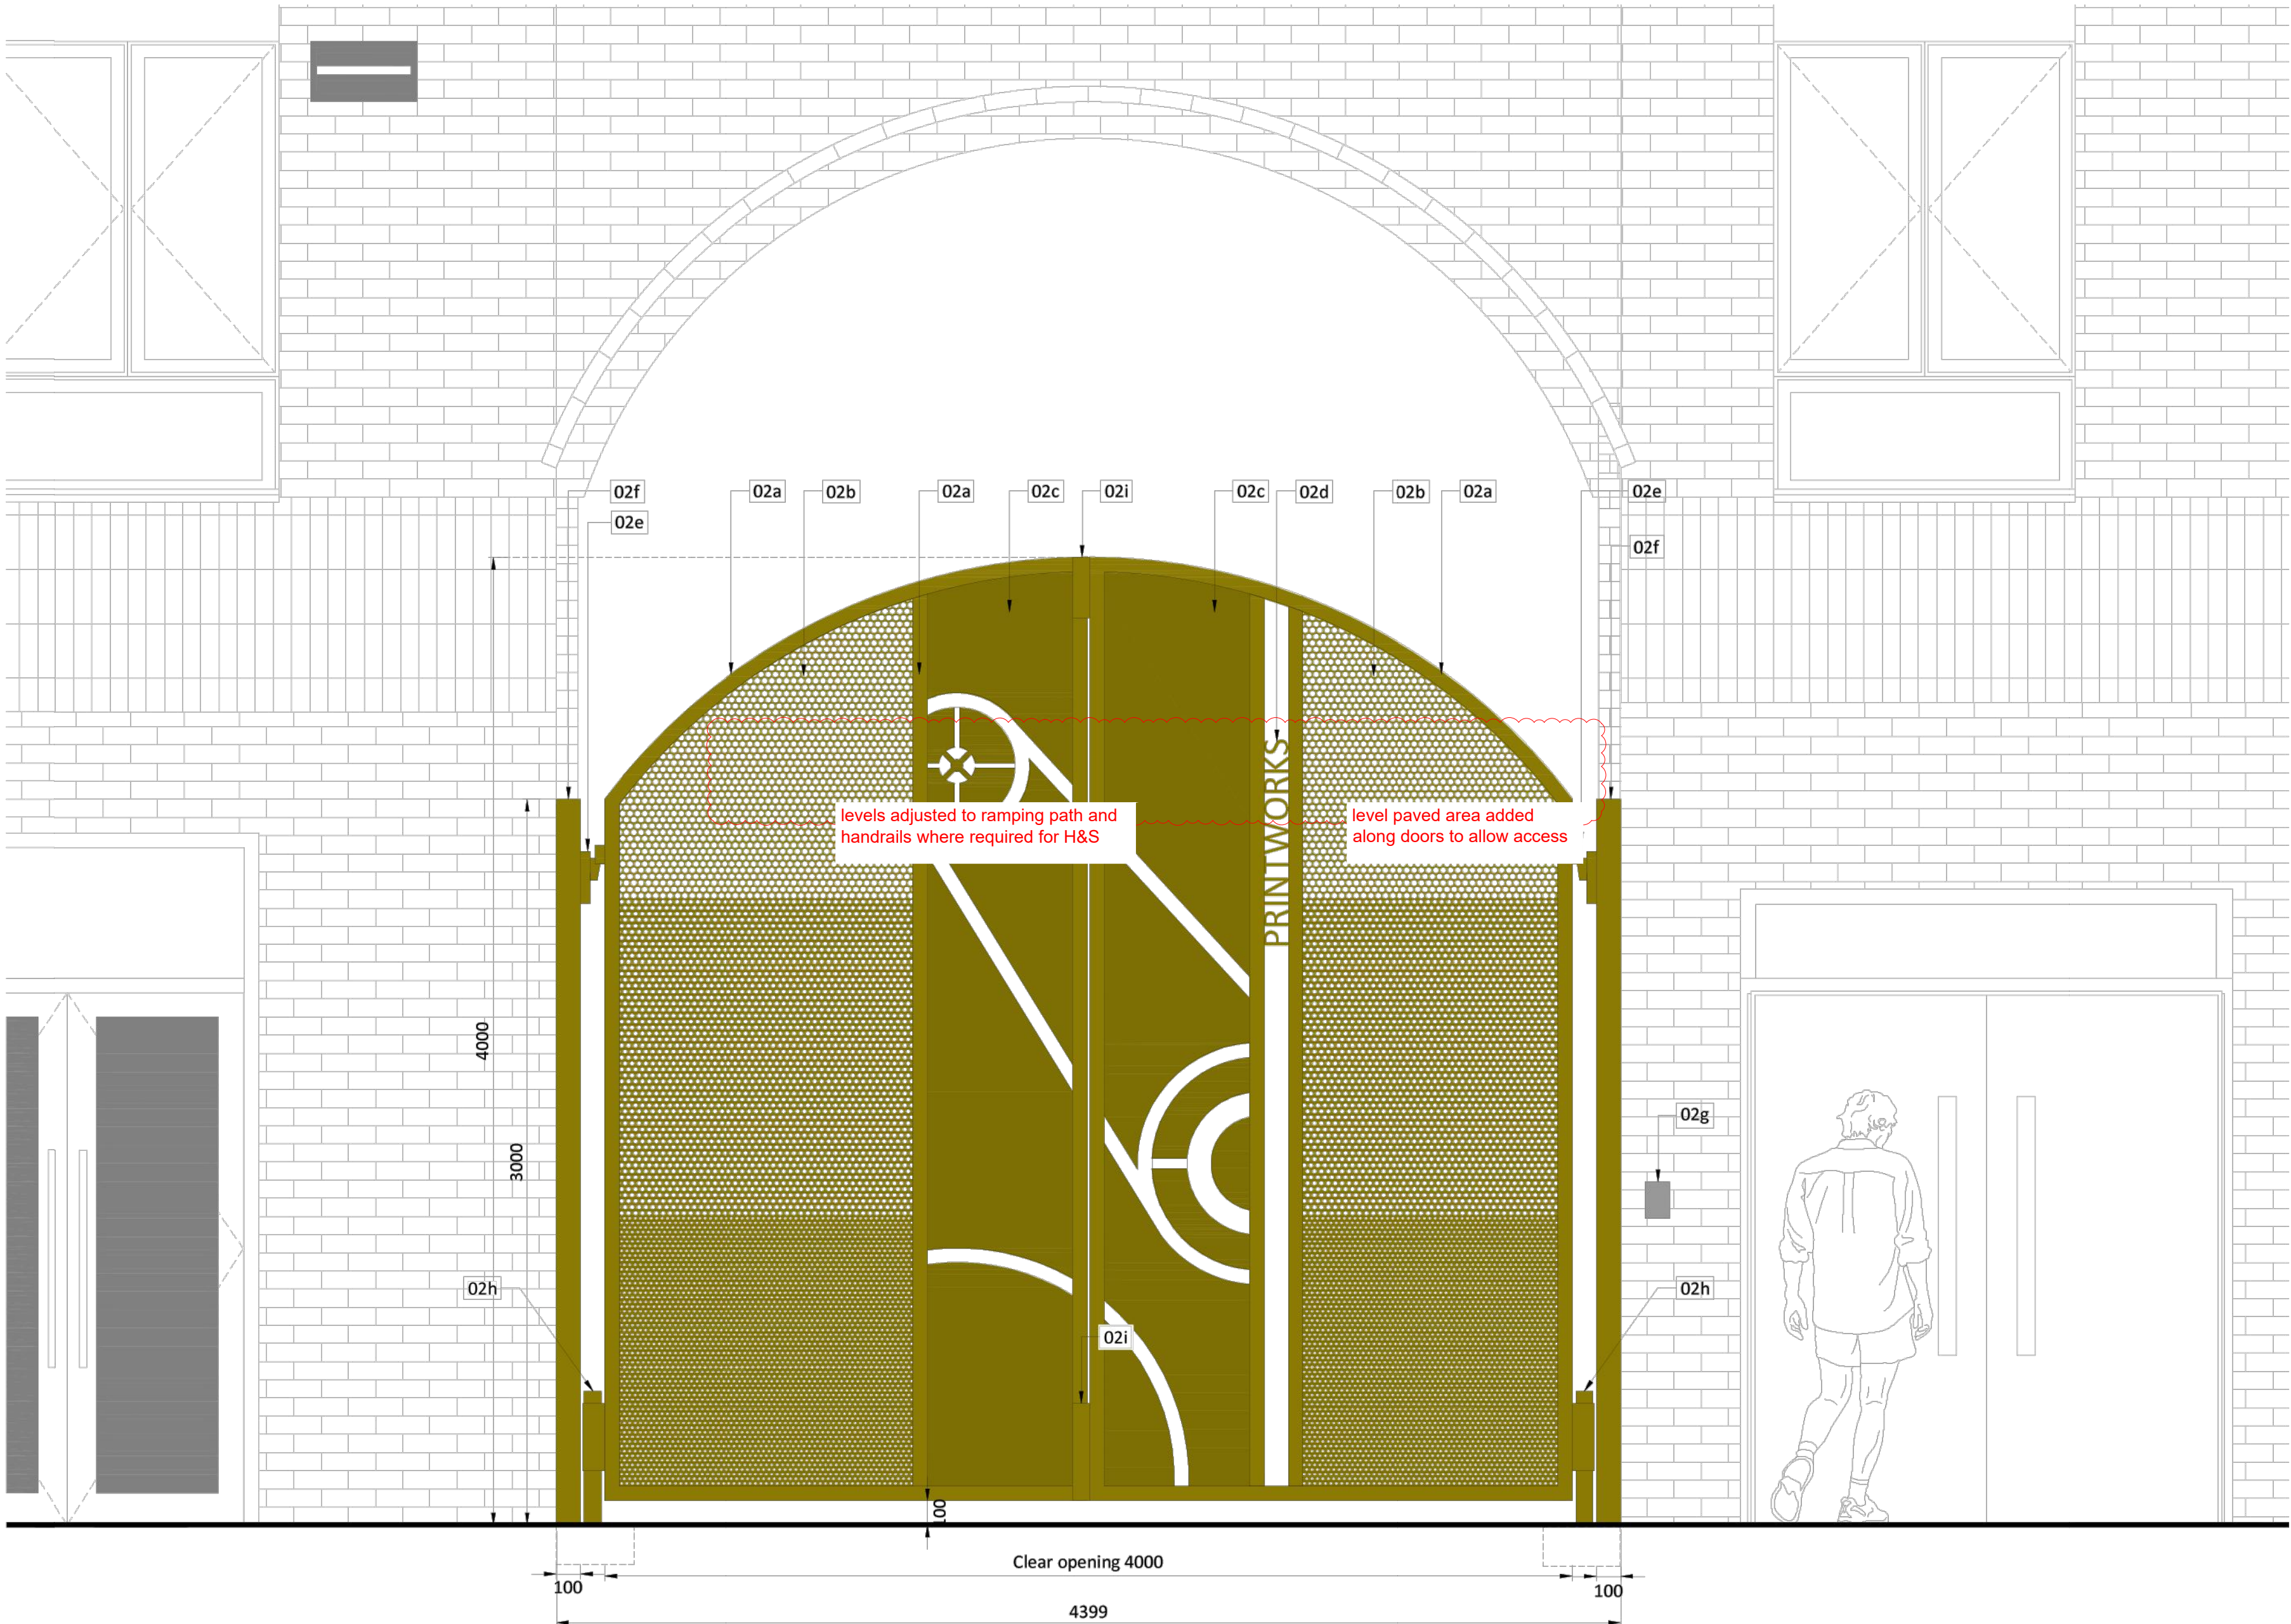

8009 Elevation AA 02 1:20

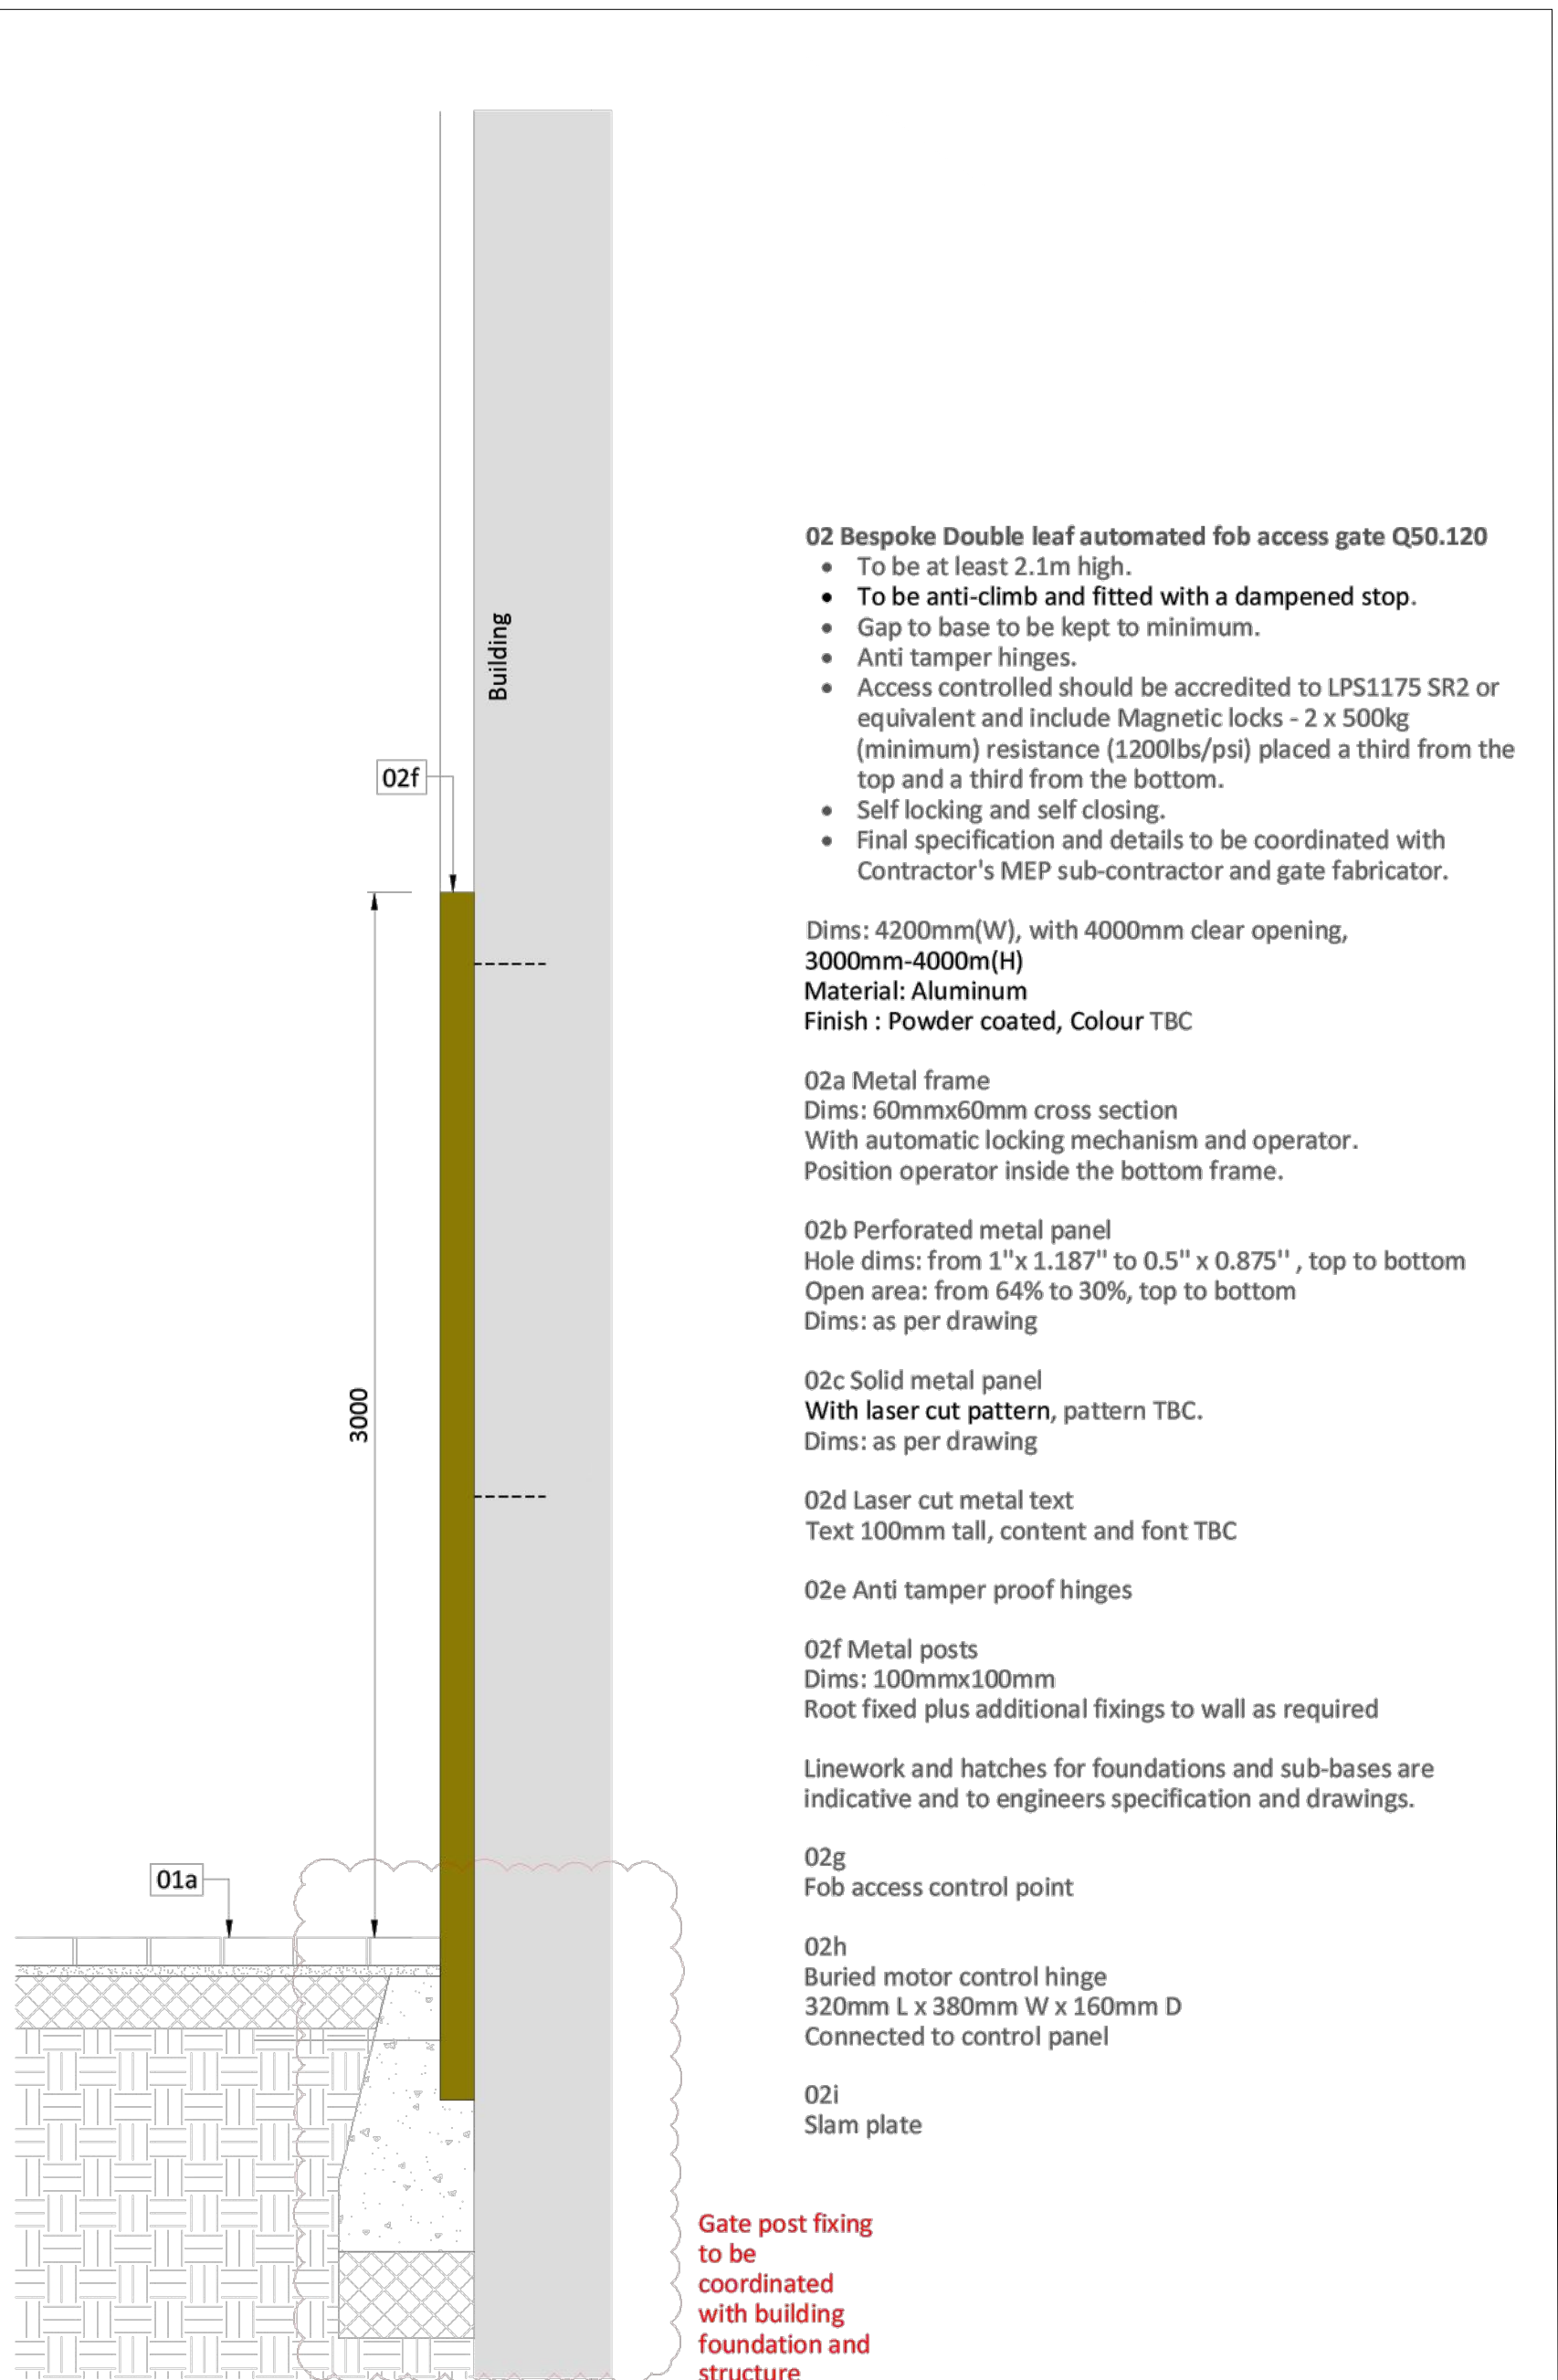

8009 Section BB 02 1:20

- 02 Bespoke Double leaf automated fob access gate Q50.120**
- To be at least 2.1m high.
 - To be anti-climb and fitted with a dampened stop.
 - Gap to base to be kept to minimum.
 - Anti tamper hinges.
 - Access controlled should be accredited to LPS1175 SR2 or equivalent and include Magnetic locks - 2 x 500kg (minimum) resistance (1200lbs/psi) placed a third from the top and a third from the bottom.
 - Self locking and self closing.
 - Final specification and details to be coordinated with Contractor's MEP sub-contractor and gate fabricator.

Dims: 4200mm(W), with 4000mm clear opening, 3000mm-4000m(H)
Material: Aluminum
Finish : Powder coated, Colour TBC

02a Metal frame
Dims: 60mmx60mm cross section
With automatic locking mechanism and operator.
Position operator inside the bottom frame.

02b Perforated metal panel
Hole dims: from 1"x 1.187" to 0.5" x 0.875" , top to bottom
Open area: from 64% to 30%, top to bottom
Dims: as per drawing

02c Solid metal panel
With laser cut pattern, pattern TBC.
Dims: as per drawing

02d Laser cut metal text
Text 100mm tall, content and font TBC

02e Anti tamper proof hinges

02f Metal posts
Dims: 100mmx100mm
Root fixed plus additional fixings to wall as required

Linework and hatches for foundations and sub-bases are indicative and to engineers specification and drawings.

02g Fob access control point

02h Buried motor control hinge
320mm L x 380mm W x 160mm D
Connected to control panel

02i Slam plate

Gate post fixing to be coordinated with building foundation and structure

Note: Drawing represents design intent only and all details to be confirmed by manufacturer's shop drawings.

drawing status	S4	
	FOR TENDER	
	FOR CONSTRUCTION	
	AS BUILT	



David Clarke
LANDSCAPE ARCHITECT

29 Uppertown Road, Gleno, Larne
Co. Antri mBT40 3EA
Tel: 07752805988 / 02890767875
Email: david@david-clarke.net

Client: McAleer & Rushe
Job: The Printworks
819-829, High Road, Tottenham
London N17 8ER
Title: GF Landscape Layout
Dwg Ref: 179-DCA-B1-00-DR-L-90004
Scale: 1:20 @ A1 Date: 26/03/2026
Drawn By: cs Rev: C01