
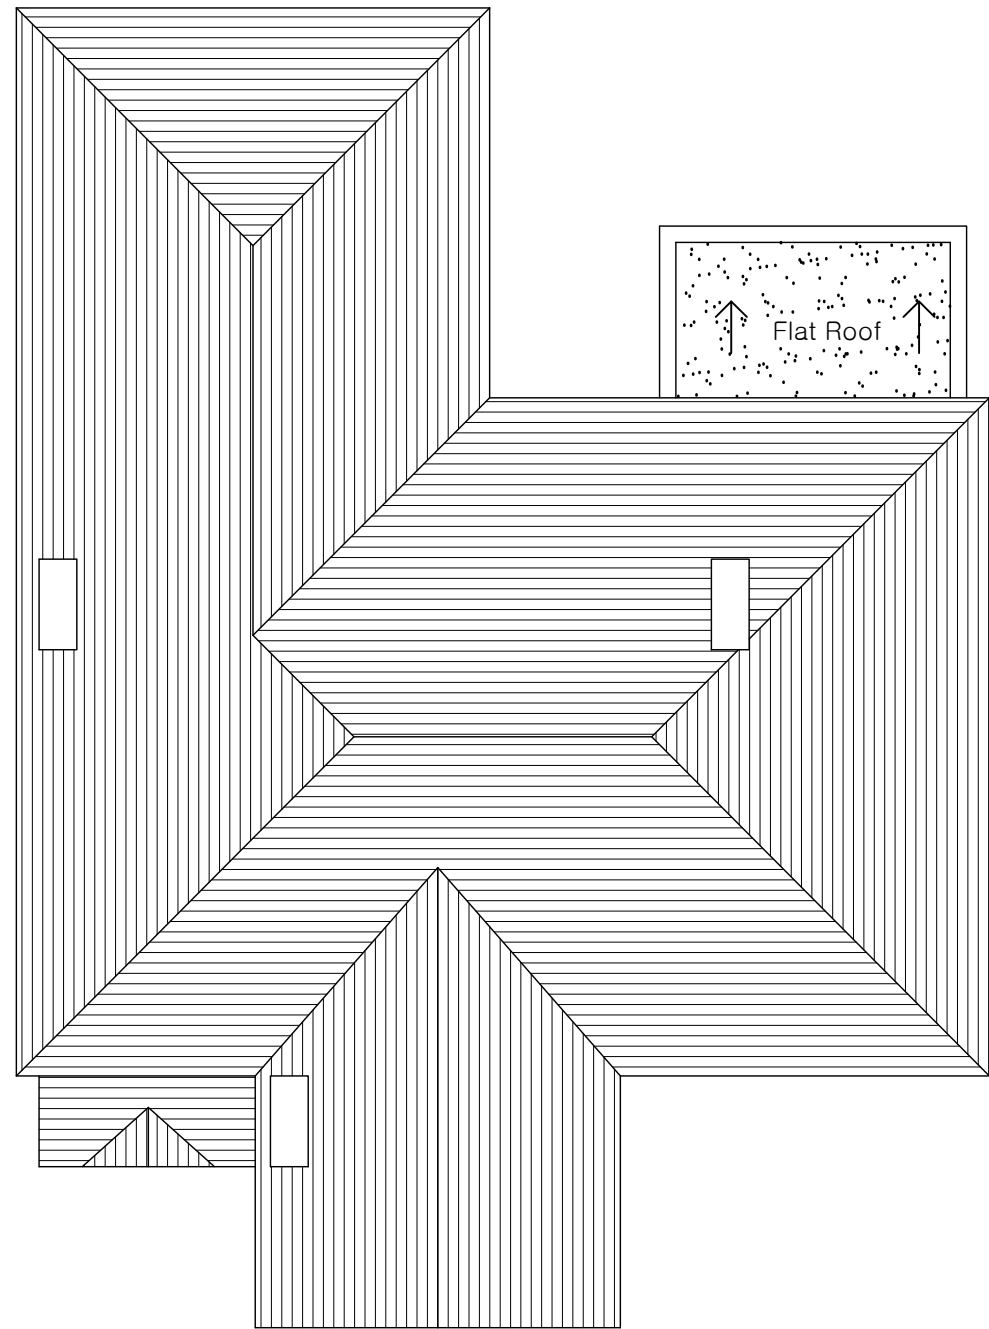


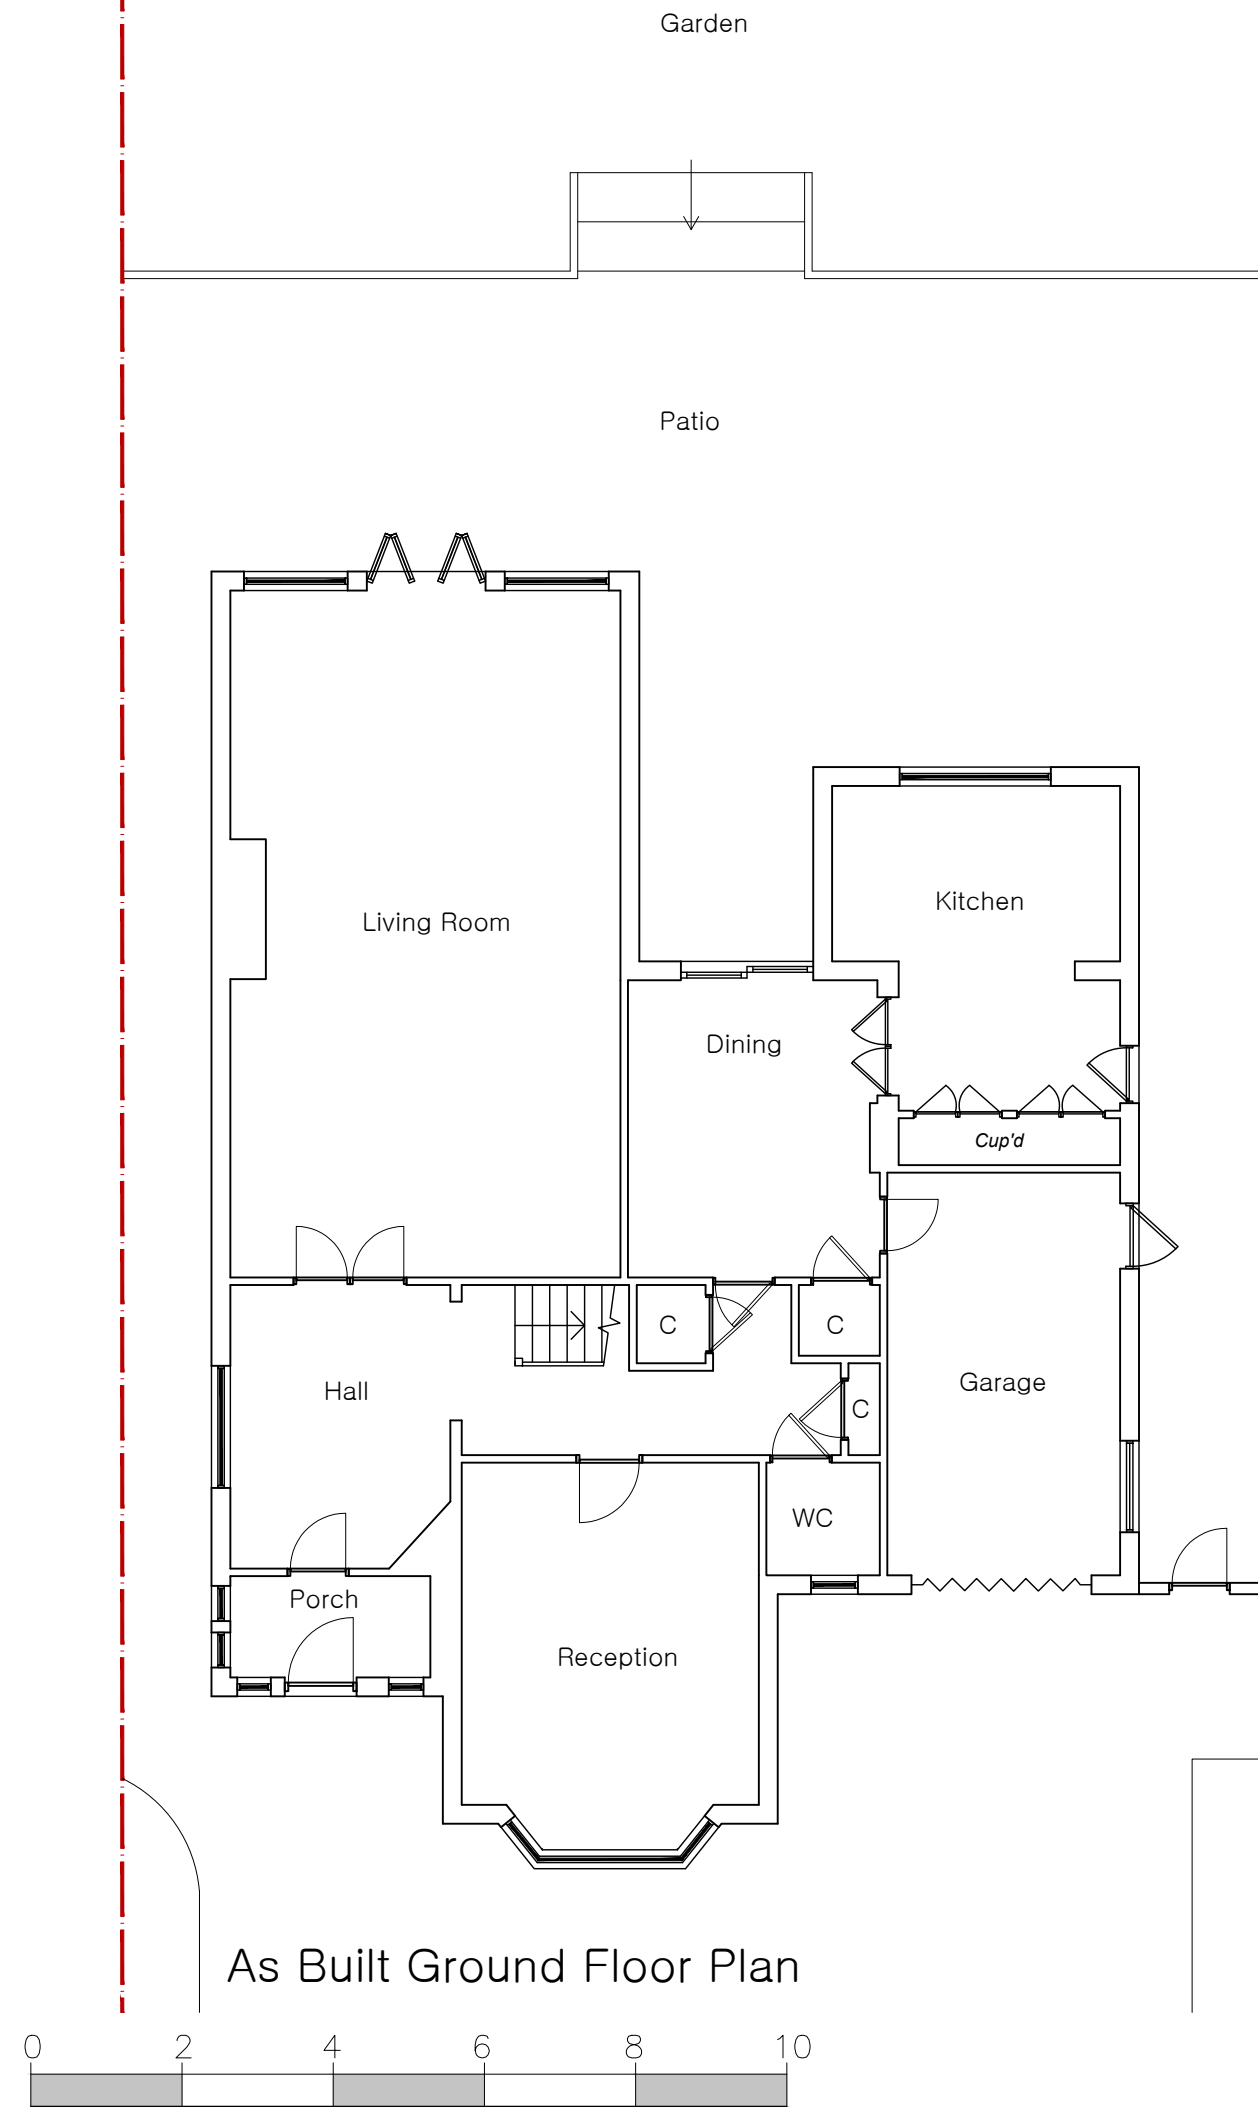

Issued: For Planning Consent Use Only.

Planning and Building Ltd can not guarantee that planning permission will be granted, however we shall endeavor to make any reasonable amendments required by the planning officer concerned to help with the application. The final outcome rests with the planning department and planning officer.
Commencement of works on site is subject to Planning Consent and Building Control Approval.
All manufacturers to confirm measurements on site prior to production.
All dimensions, setting out, site investigation and soil reports to be done by the contractor prior to construction. This drawing is subject to copyright and ownership of Planning and Building Ltd.
Do not reproduce this drawing without prior permission from Planning and Building Ltd.

Revision Details Date

info@planningandbuilding.co.uk
www.planningandbuilding.co.uk

Planning and Building

t. 0207 1128 766
f. 0207 1128 796

Project
13 Aylmer Road
London
N2 0BS

Drawing Title
As Built Plans

Date May 2026	Scale 1:100@A3	Drawn by GG
Drawing No 26/1027/PL-3	Revision -	