


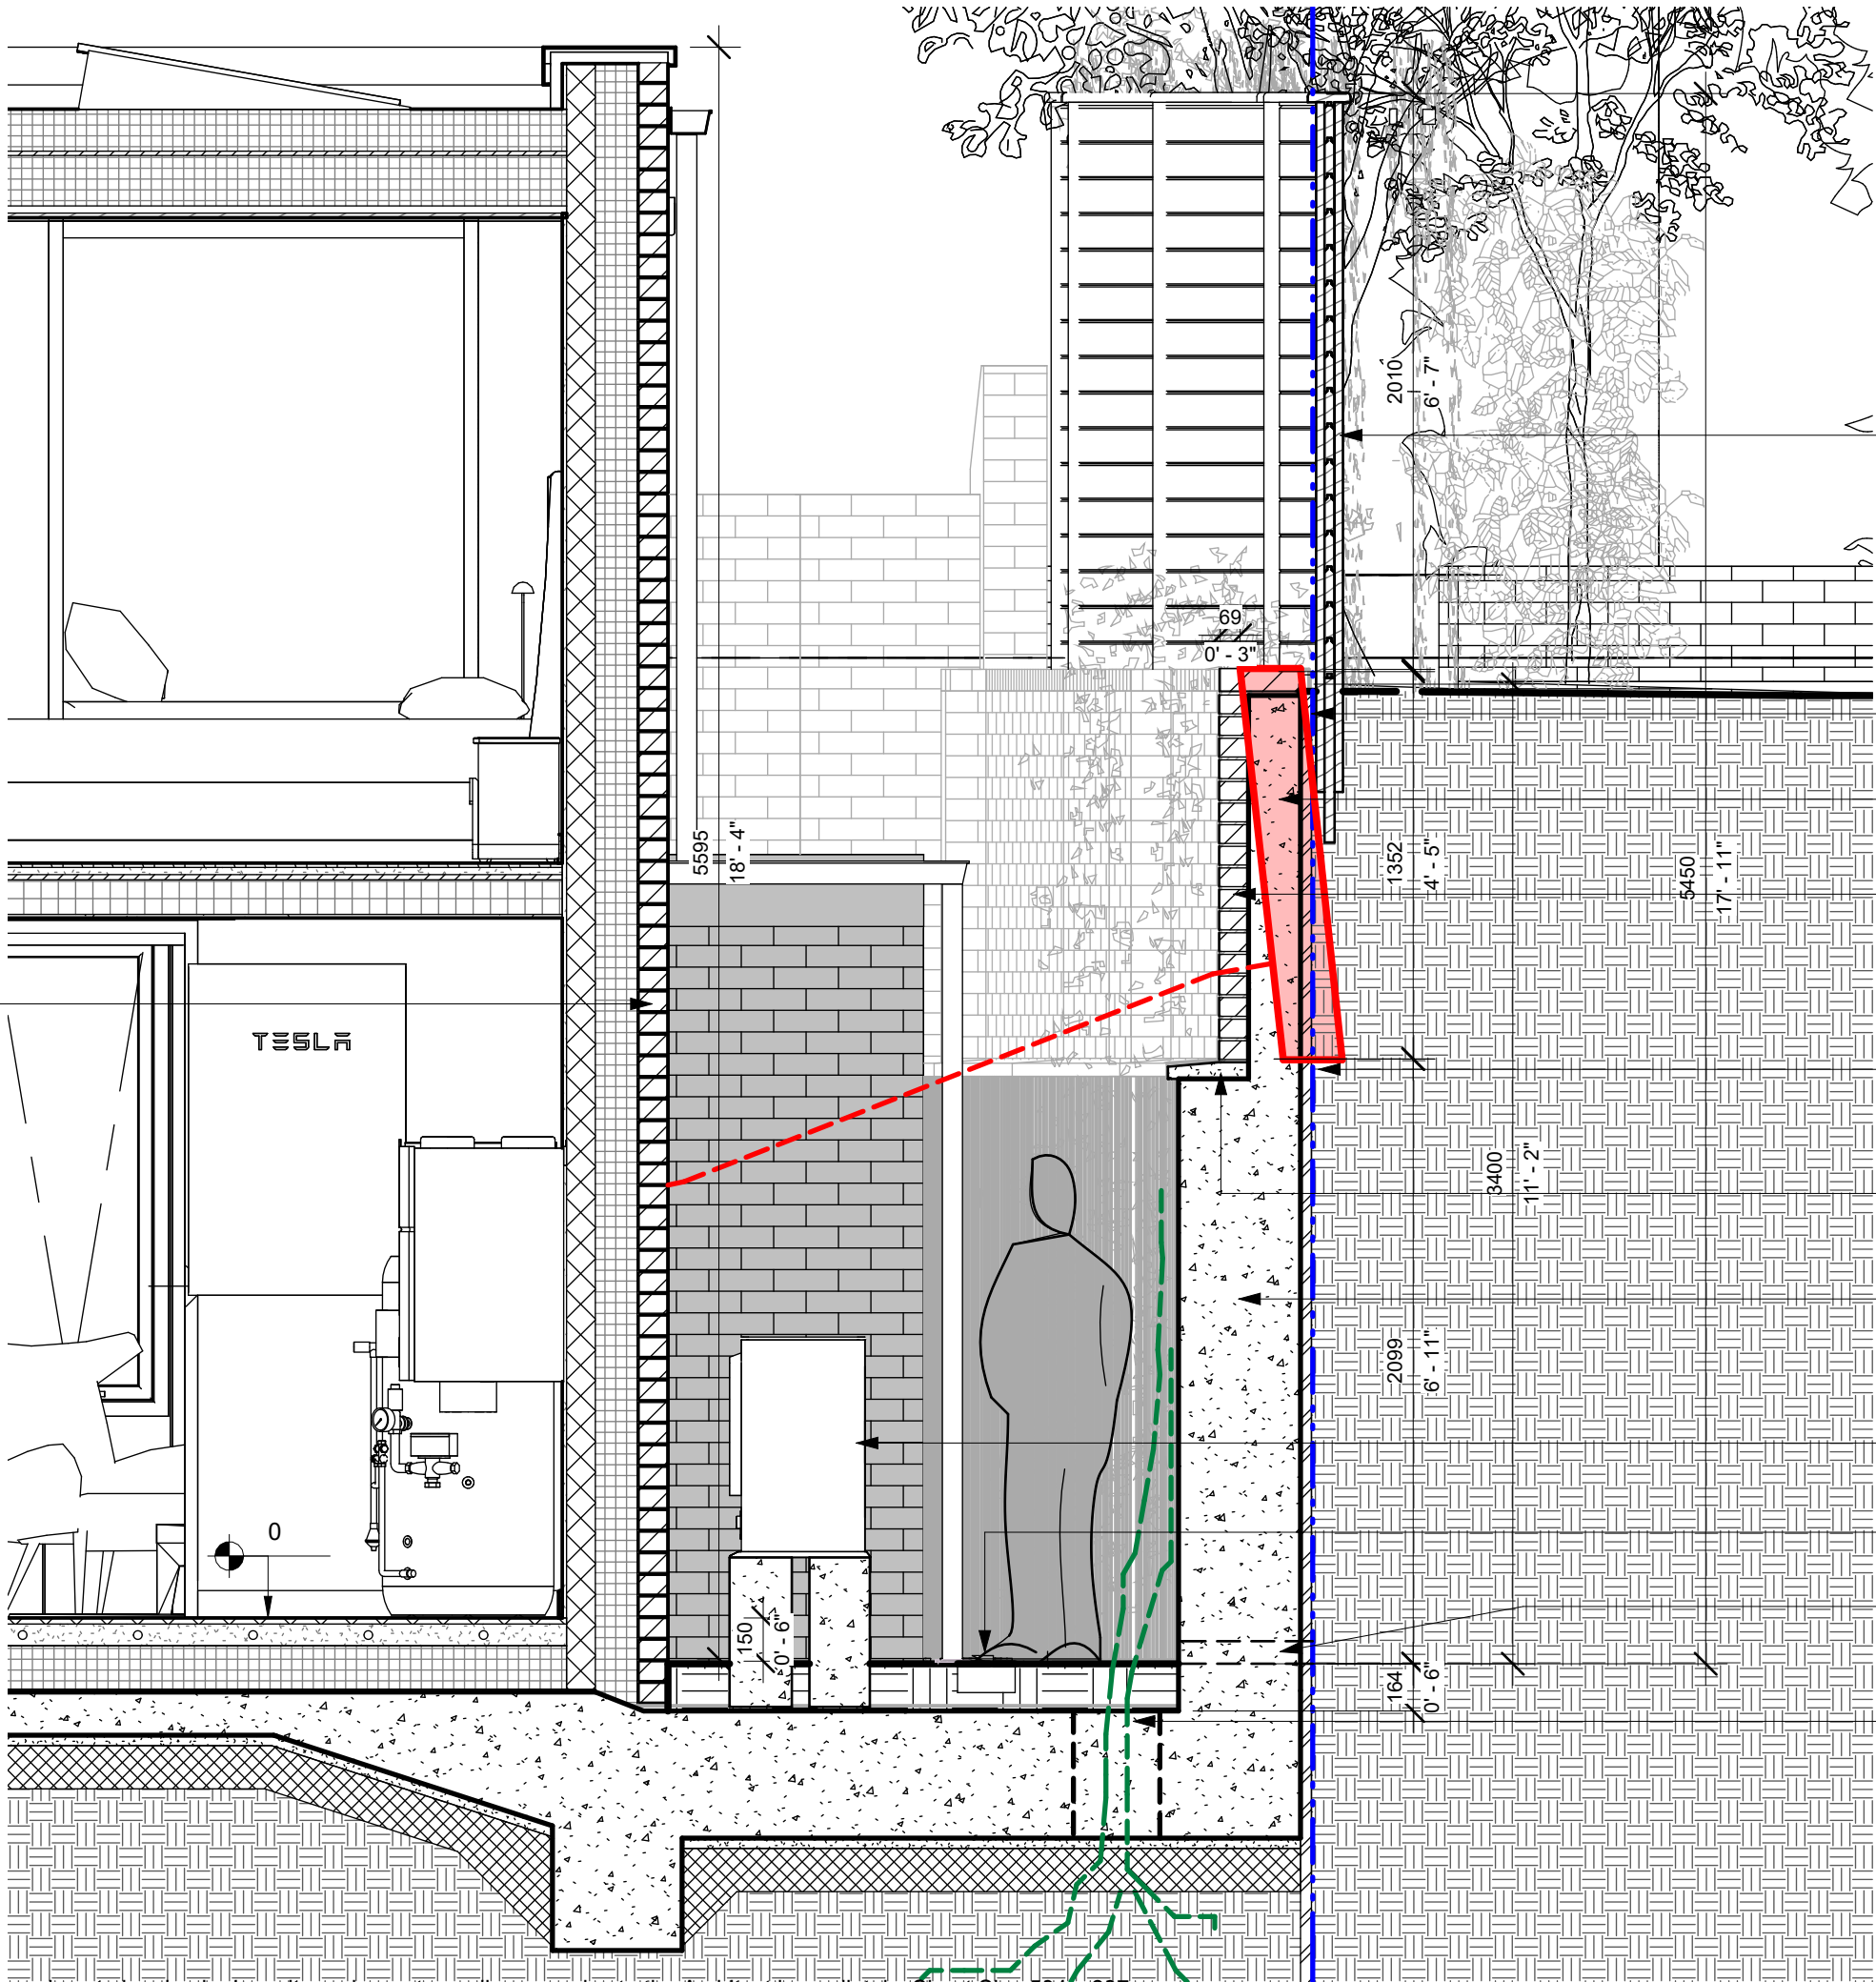

EXTERNAL WALL (SWL-EW3) WITH 102MM TINTED WINDERMERE GREY BRICKS EXTERNALLY

ACOUSTIC TIMBER FENCE (JACKSONS FENCING JACOUSTIC REFLECTIVE TIMBER FENCE OR EQUAL APPROVED)

ZONE FOR TRENCH SHEETS (TBC BY TEMPORARY WORKS DESIGNER)

LINE OF EXISTING UNSTABLE LEANING WALL AND SOIL SHOWN IN RED (TO BE DEMOLISHED)

RECLAIMED BRICKS FROM EXISTING WALL WITH ADDITIONAL RECLAIMED BRICKS TO MATCH (OR NEW BRICKS IF APPROPRIATE MATCH CANNOT BE FOUND) TO FACE RETAINING WALL. BRICKS TIED INTO CONCRETE WALL WITH APPROPRIATE FIXINGS.

ASSUMED BOUNDARY LINE BETWEEN PROPERTIES SHOWN IN BLUE AT CENTERLINE OF BASE OF EXISTING BOUNDARY WALL

GREY/BLUE PLINTH STONE COLOUR TO MATCH SOUTHWOOD HOUSE LOCALLY LISTED WEST FACING BOUNDARY WALL

REINFORCED CONCRETE RETAINING WALL WITH LOWER SECTION HAVING A TEXTURED, BAMBOO/REED-INSPIRED CONCRETE FINISH FORMED USING THE RECKLI 'FRIESLAND' FORMLINER

AIR SOURCE HEAT PUMP

WALL WASH EXTERNAL LIGHT FITTINGS

WEEP HOLES APPROXIMATELY EVERY 1.5M AT BOTTOM OF WALL FOR DRAINAGE

ALLOWANCE FOR SMALL OPENINGS IN RETAINING WALL TO PLANT WALL CLIMBERS

24/10/25 Rev P5 Issued for Planning Permission

05/12/25 Rev P6 Issued for Planning Permission
- Boundary wall & Timber fence amended

18/12/25 Rev P7 Issued for Planning Permission
- Boundary wall amended following further comments from Haringey Council

15/5/26 Rev P8 Issued for Non-Material Amendment (S.96A)

26/6/26 Rev P9 Issued for Non-Material Amendment (S.96A)
- Concrete finish annotation amended to Reckli 'Friesland' formliner; all else as approved (HGY/2025/2929)

PROPOSED BOUNDARY WALL DESIGN

PROPOSED ALTERATIONS TO NO. 86 SOUTHWOOD LANE

SCALE 1 : 25

NO.	REV.	D.	AA
SEC-11 P9		C.	AA
		DATE.	04/03/25

ARCHITECT: ANDREW ARDILL BSC(HONS), BARCH, RIBA, ARB CHARTERED ARCHITECT	SWL
---	-----