



Note: This drawing presents the building at 19 Truro Rd as built and fully developed with ground floor extension and loft conversion. The Rear first floor is as Existing as Section AA

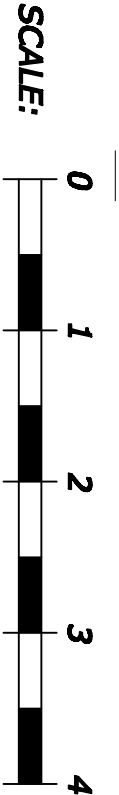

Existing Section AA

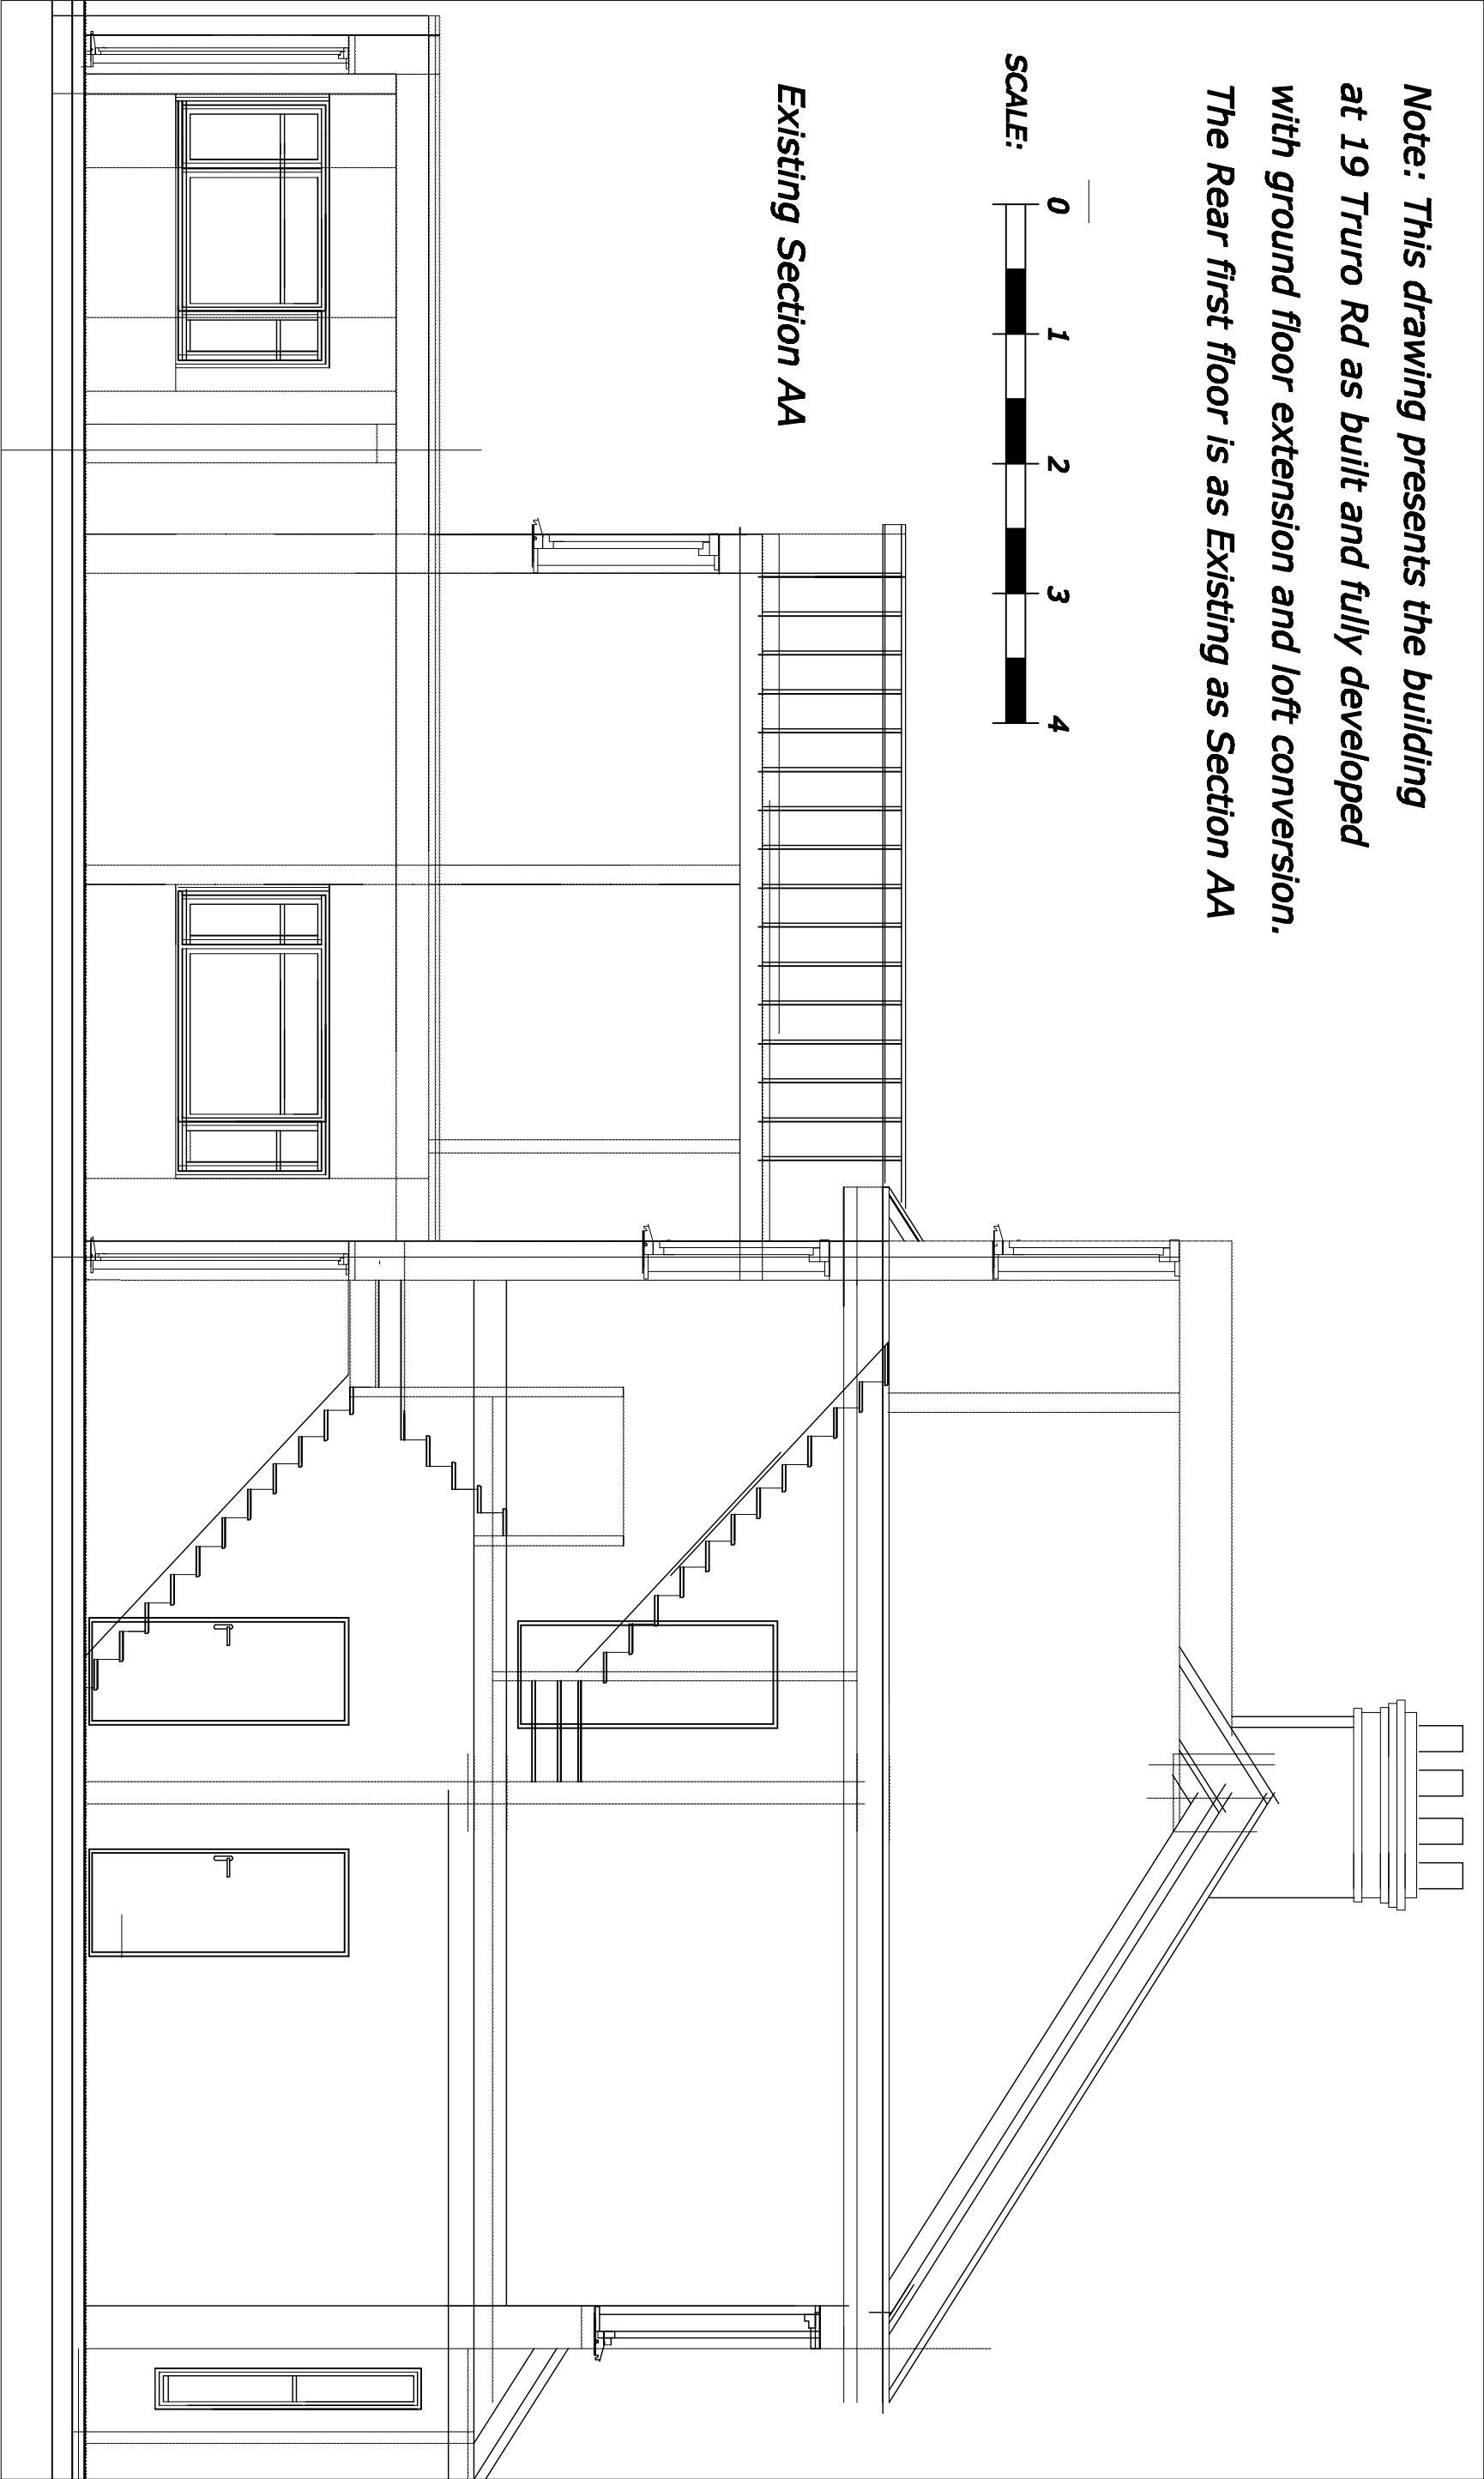

19 TRURO ROAD, LONDON N22 8EH

JV ARCHITECTS

GARDEN STUDIOS 71-75 SKELTON STREET
CONVENT GARDEN, LONDON WC2H 9JQ
TEL: 0208 340 5665

Proj. No. 2026/305/07 (18)

Scale: 1:50

Date: 21/9/26

Drawn by: JVA

REVISION

*



copyright.